



**Grid Solutions**  
A GE and Alstom joint venture

# 220kV/132kV GIS SUBSTATION GHAZI ROAD , LAHORE

## 132kV LINE RELAY PANEL SCHEMATIC DRAWINGS

DOC / DWG REVIEW CODE	
<input type="checkbox"/> A	Approved, Issue IFC.
<input type="checkbox"/> B	Approved with comments as noted, Issue IFC after incorporation of these comments.
<input type="checkbox"/> C	Revise and re-submit for approval.
<input type="checkbox"/> D	Rejected.
Signed .....	Date .....
Permission to proceed does not constitute acceptance of approval of design details, analysers, test methods or materials/ selected by the CONTRACTOR and does not relieve the CONTRACTOR from full compliance with AGREEMENT obligations.	


REFERENCE DRAWINGS					
SR. NO.	DRAWING TITLE				DOCUMENT NO.
1.	220kV / 132kV Metering & Protection SLD				P60194-E-SLMP-001
REVISION HISTORY					
REV	DATE	DRW. BY	CHK. BY	APR. BY	REVISION DESCRIPTION
0	20.11.2018	ASJ	MFT	NAH	AS BUILT
Scale NOT-TO-SCALE					Sheet size A3
Client					
 NATIONAL TRANSMISSION & DISPATCH COMPANY LIMITED (NTDC-WAPDA)					
Contractor					Manufacturer
 <b>Grid Solutions</b> A GE and Alstom joint venture					 <b>EPESOL</b> 71-B Garden Block, New Garden Town, Lahore, Pakistan
Project					
220kV / 132kV GIS SUBSTATION GHAZI ROAD , LAHORE					
Title					
132kV LINE RELAY PANEL (=E10+RP3) SCHEMATIC DRAWINGS					
Order no			Document no		
P-60194			P60194-E-ELR-SC-002		
Sheet type		Total sheets		Sheet no	
A		26		1	

	1	2	3	4	5	6	7	8							
	PAGE NO.	SHEET NAME	SHEET DESCRIPTION			ISSUE / REVISION									
						A	B	C	D	E	F	01	02	03	04
A B C D E F	01	A	Cover Sheet			X	X	X	X						
	02	AA	List Of Contents			X	X	X	X						
	03	AB	Symbol and Legends			X	X	X	X						
	04	AC1	Component List			X	X	X	X						
	05	AD	Panel View			X	X	X	X						
	06	AE	Bay Concept & Protection Logic			X	X	X	X						
	07	D	AC Supply Distribution Circuit			X	X	X	X						
	08	E	DC Supply Distribution Circuit			X	X	X	X						
	09	F	AC/DC Supply Failure Circuit			X	X	X	X						
	10	G	Relay Power Supply Circuit			X	X	X	X						
	11	H1	Line Differential Relay Protection CT/VT input			X	X	X	X						
	12	H2	O/C & E/F CT input			X	X	X	X						
	13	I1	Line Differential Relay input Circuit			X	X	X	X						
	14	I4	System Input Circuit			X	X	X	X						
	15	K1	Protection Trips Circuit			X	X	X	X						
	16	K11	Trips Circuit Supervision			X	X	X	X						
	17	NA1	System Alarm Circuit			X	X	X	X						
	18	NA2	System Alarm Circuit			X	X	X	X						
	19	PA2	Protection Inter Circuit			X	X	X	X						
	20	RA1	Annunciation Circuit			X	X	X	X						
	21	RA2	Event & Fault Recorder Circuit			X	X	X	X						
	22	RA3	SCADA Circuit			X	X	X	X						
	23	Z1	Component Diagram			X	X	X	X						
	24	Z2	Component Diagram			X	X	X	X						
	25	Z3	Component Diagram			X	X	X	X						
	26	Z4	Component Diagram			X	X	X	X						
All information contained in this document is the exclusive property of GE GRID SOLUTIONS and shall not be used, copied or communicated to third parties without its prior authorization.															
0	AS BUILT		20.11.2018	ASJ	Manufacturer	 EPESOL 7-E Garden Block, New Garden Town, Lahore, Pakistan	Contractor	 Grid Solutions A GE and Alstom joint venture	Client	NATIONAL TRANSMISSION & DISPATCH COMPANY LIMITED (NTDC-WAPDA)	Project	220KV/132KV GIS SUBSTATION GHAZI ROAD, LAHORE	Title	132KV LINE RELAY PANEL (=E10+RP3) LIST OF CONTANTS	Drawing no. P60194-E-ELR-SC-002
	REV.		DESCRIPTION	DATE	DRAWER								Project no. P-60194	Sheet type AA	Sheet no. 02

	SYMBOL	DESCRIPTION	SYMBOL	DESCRIPTION	SYMBOL	DESCRIPTION	SYMBOL	DESCRIPTION
A		CIRCUIT BREAKER		MINIATURE CIRCUIT BREAKER		AUXILIARY CONTACTOR NO+NC	21	DISTANCE
B		SWITCH/ISOLATOR		SELECTOR SWITCH		AMMETER	24	OVEREXCITATION
C		EARTHING		LIMITED SWITCH		VOLTMETER	25	SYCHROCHECK
D		GIS TERMINATION		HUMIDITY & TEMPERATURE CONTROLLER		POWER FACTOR METER	49	THERMAL OVERLOAD
E		SF6 TO AIR BUSHING		PANEL HEATER		DIGITAL PANEL METER	50/51	PHASE OVERCURRENT
F		LINE TRAP		THREE PIN SOCKET		ACTIVE POWER METER	50N/51N	EARTH FAULT
G		SURGE ARRESTOR		INDICATION LIGHT		REACTIVE POWER METER	50BF	CIRCUIT BREAKER FAILURE
H		CURRENT TRANSFORMER		PUSH BUTTON		ENERGY METER	64	RESTRICTED EARTH FAULT
I		COUPLING CAPACITOR VOLTAGE TRANSFORMER		AUXILIARY CONTACTOR COIL			67N	DIRECTIONAL EARTH FAULT
J		POWER TRANSFORMER		POWER SUPPLY AC/DC			68	POWER SWING BLOCKING
K		AUTO TRANSFORMER		TERMINAL			78	OUT OF STEP
L				OPTO CONTACTS			79	AUTO-RECLOSING
M				RELAY CONTACTS			85	COMMUNICATION FAILURE
N				HOOTER			87T	TRAFO DIFFERENTIAL
O				AC BELL			87C	LOW IMPEDANCE DIFFERENTIAL CONNECTION
P							87BB	LOW IMPEDANCE DIFFERENTIAL BUSBAR




All information contained in this document is the exclusive property of GE GRID SOLUTIONS and shall not be used, copied or communicated to third parties without its prior authorization.

0	AS BUILT	20.11.2018	ASJ	Manufacturer  EPESOL 71-B Garden Block, New Garden Town, Lahore, Pakistan	Contractor  Grid Solutions A GE and Alstom joint venture	Client  NATIONAL TRANSMISSION & DISPATCH COMPANY LIMITED (NTDC-WAPDA)	Project 220kV/132kV GIS SUBSTATION GHAZI ROAD, LAHORE	Title 132kV LINE RELAY PANEL (=E10+RP3) SYMBOLA AND LEGENDS	Drawing no. P60194-E-ELR-SC-002
REV.	DESCRIPTION	DATE	DRAWER						Project no. P-60194 Sheet type AB Sheet no. 03

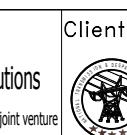	1	2	3	4	5	6	7	8			
	QTY.	DEVICE DESCRIPTION		DEVICE SPECIFICATIONS DEVICE TYPE ; TECHNICAL DATA / SPECIFICATIONS			DEVICE DESIGNITION	MANUFACTURER			
A	01	LINE DIFFERENTIAL PROTECTION RELAY		AGILE P543, Cortec: P543-91PC7M0820M  Supply: 110-250VDC / 100-240VAC, VT + CT (100-120V:1/5A) Inputs  16 Opto Inputs, 14 Relay Outputs			-F87	GE			
	01	OVER CURRENT PROTECTION RELAY		AGILE P14N, Cortec: P14N-B16A7C570A  08 Opto Inputs, 08 Relay Outputs			-F50	GE			
	02	TRIP CIRCUIT SUPERVISION		MVAX31, Cortec: MVAX31-S1DD0754A			-F94B-C	GE			
B	04	RESISTORS		4KΩ			-R94 B/C 1-2	GE			
	02	RESISTORS		1.5KΩ			-R94 B/C 3	GE			
	03	TEST BLOCK		MMLG01, Cortec: MMLG01-R1AA9002D			-XT87A,-XT87B,XT50	GE			
C	01	TRIPPING RELAY (SELF-RESETTING)		MVAJ101, Cortec: MVAJ101-RA0802A  Supply: 110-125VDC, 8 NO + 2 NC Contacts			-F94-1	GE			
	01	LOCKOUT RELAY (HAND/ELECTRICAL RESET)		MVAJ105, Cortec: MVAJ105-RA0802A  Supply: 110-125VDC, 8 NO + 2 NC Contacts			-F86L	GE			
	02	CONTROL MCB - PANEL LIGHT & HEATER		2-Pole, Ratings: 2A, 240VAC, 6kA @ 240VAC, 2 C/O Contacts, Ord: G62C02+CAH(2)			-F101, -F102	GE			
D	01	CONTROL ELCB - PANEL SOCKET		2-Pole, Ratings: 16A, 30mA, 240VAC, 10kA @ 240VAC, 2 C/O Contacts, Ord: DM100C16/030+CAH(2)			-F103	GE			
	04	CONTROL MCB - DC DISTRIBUTION		2-Pole, Ratings: 4A, 110VDC, 10kA @ 110VDC, 2 C/O Contacts, Ord: EP102UCC04+CAH(2)			-F201, -F202, -F203, -F204	GE			
	25	AUXILIARY CONTACTOR		Coil Voltage: 110VDC, DIODE, 4 C/O Contacts, Ord: PRC4M40DCJL			-KDCM, -KQ0.ON, -KQ1.ON, -KQ2.ON, -KQ9.ON, -KZ2/3T, -KQ0.ONC, -KQ0.OFC, -KVTB1, -KRT, -KYT, -K94B, -K94C, -KBT, -KZ1T, -KPSD, -KSOTF, -KPSS, -KPSR, -K87F, -KDC1, -KAC, -K50T, -K50F, -KDC2	GE			
E	01	AUXILIARY CONTACTOR - SUPPLY CHANGEOVER		Coil Voltage: 110VDC, 3 NO + 3 NC Contacts, Ord: MCRC022ATWJ+MARN211AT			-KDCO	GE			
	02	AUXILIARY CONTACTOR		Coil Voltage: 240VAC, 4 C/O Contacts, Ord: PRC4M40ANL			-KDC, -KACM	GE			
	01	SELECTOR SWITCH - AUTORECLOSER		YS-AK-2-2-44-D, 2-Postion (IN-OUT), 110VDC, KEYLOCKABLE TYPE, KEY RELEASE ON "OUT"			-S79	YONGSUNG			
F	01	PUSH BUTTON		Black Button, Spring Return, 2-Pole, Rating 12A, 110VDC Ord: YS-AP1-2-40-B-D-W			-S50	YONGSUNG			
	01	PANEL LIGHT WITH DOOR SWITCH		240VAC @ 50Hz, 5W, with Door Limit Sw. Ord: YSP3315GW-B + YS-T8-30-5W			-H100,-S100	YONGSUNG			
	01	THREE PIN SOCKET		1N+PE, 16A, 240VAC @ 50Hz			-X100	LEAR			
G	01	PANEL HEATER		240VAC @ 50Hz, 50W			-R100	ELAB			
	01	HUMIDITY & TEMPERATURE CONTROLLER		40-90%RH, 25-50°C, 230VAC @ 50Hz			-B100	ELAB			
	01	INDICATION LAMP - DC SUPPLY FAILURE		Type: Integrated LED, Color : RED , Supply : 240VAC @ 50Hz, Ord: YS-PL-2-AL-22-R-W			-H200	YONGSUNG			
H	0	AS BUILT		20.11.2018	ASJ	Manufacturer  EPE SOL 71-B Garden Block, New Garden Town, Lahore, Pakistan	Contractor  Grid Solutions A GE and Alstom joint venture	Client  NATIONAL TRANSMISSION & DISPATCH COMPANY LIMITED (NTDC-WAPDA)	Project 220kV/132kV GIS SUBSTATION GHAZI ROAD, LAHORE	Title 132kV LINE RELAY PANEL (=E10+RP3) COMPONENT LIST	Drawing no. P60194-E-ELR-SC-002
							Project no. P-60194				
	REV.	DESCRIPTION		DATE	DRAWER		Sheet type AC1				
I	1			2	3	4	5	6	7		
									8		

	1	2	3	4	5	6	7	8		
	QTY.	DEVICE DESCRIPTION	DEVICE SPECIFICATIONS DEVICE TYPE ; TECHNICAL DATA / SPECIFICATIONS			DEVICE DESIGNITION	MANUFACTURER			
A	12	TERMINAL BLOCKS FOR SYSTEM INPUT STATUS	CBD-4			-X8	CABUR			
	6	TERMINAL BLOCKS FOR PROTECTION INTER CIRCUIT	CBD-4			-X9	CABUR			
	4	TERMINAL BLOCKS FOR AC SUPPLY DISTRIBUTION	CBD-4			-XAC	CABUR			
B	19	TERMINAL BLOCKS FOR ANNUNCIATOR	CBD-4			-XAN	CABUR			
	2	TERMINAL BLOCKS FOR DC SUPPLY-1 DISTRIBUTION	CBD-4			-XDC1	CABUR			
	2	TERMINAL BLOCKS FOR DC SUPPLY-2 DISTRIBUTION	CBD-4			-XDC2	CABUR			
C	15	TERMINAL BLOCKS FOR EVENT RECORDER	CBD-4			-XEV	CABUR			
	3	TERMINAL BLOCKS FOR FAULT RECORDER	CBD-4			-XFR	CABUR			
	16	TERMINAL BLOCKS FOR SCADA	CBD-4			-XSC	CABUR			
D	7	TERMINAL BLOCKS FOR TRIP CIRCUIT-1	CBD-4			-XTC1	CABUR			
	7	TERMINAL BLOCKS FOR TRIP CIRCUIT-2	CBD-4			-XTC2	CABUR			
	2	TERMINAL BLOCKS FOR CONTROL	CBD-4			-X3	CABUR			
E	22	TERMINAL BLOCKS FOR LINE DIFFERENTIAL	CBD-4			-X6	CABUR			
	16	TERMINAL BLOCKS FOR CT	SCB-6			-X4	CABUR			
	16	TERMINAL BLOCKS FOR VT	SCB-6			-X4	CABUR			
F	8	TERMINAL BLOCKS FOR CT	SCB-6			-X5	CABUR			
	16	SPARE TERMINAL BLOCKS	CBD-4			-X1	CABUR			
<p>All information contained in this document is the exclusive property of GE GRID SOLUTIONS and shall not be used, copied or communicated to third parties without its prior authorization.</p>										
0	AS BUILT	20.11.2018	ASJ	Manufacturer  <b>EPESOL</b> 71-B Garden Block, New Garden Town, Lahore, Pakistan	Contractor  <b>Grid Solutions</b> A GE and Alstom joint venture	Client  <b>NATIONAL TRANSMISSION &amp; DISPATCH COMPANY LIMITED (NTDC-WAPDA)</b>	Project 220KV/132KV GIS SUBSTATION GHAZI ROAD, LAHORE	Title 132KV LINE RELAY PANEL (=E10+RP3) COMPONENT LIST	Drawing no. P60194-E-ELR-SC-002	
REV.	DESCRIPTION	DATE	DRAWER					Project no. P-60194	Sheet type AC1	Sheet no. 04a

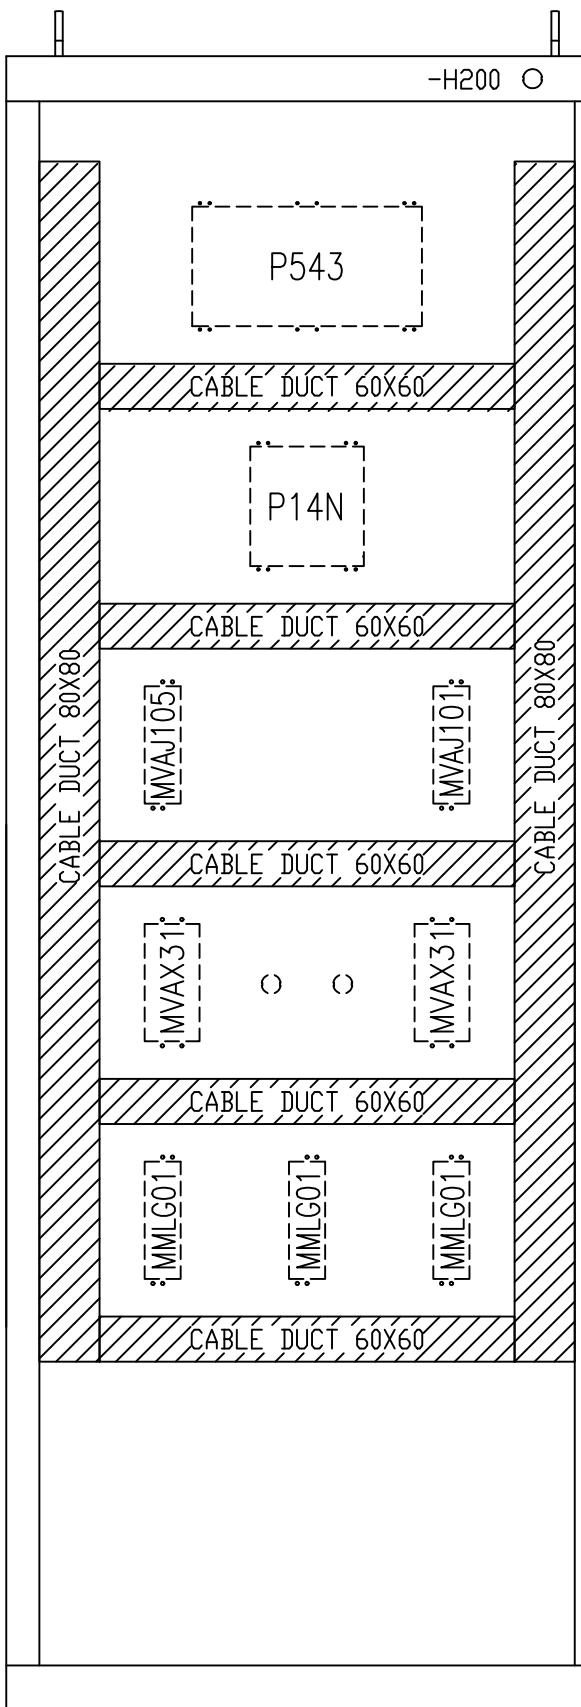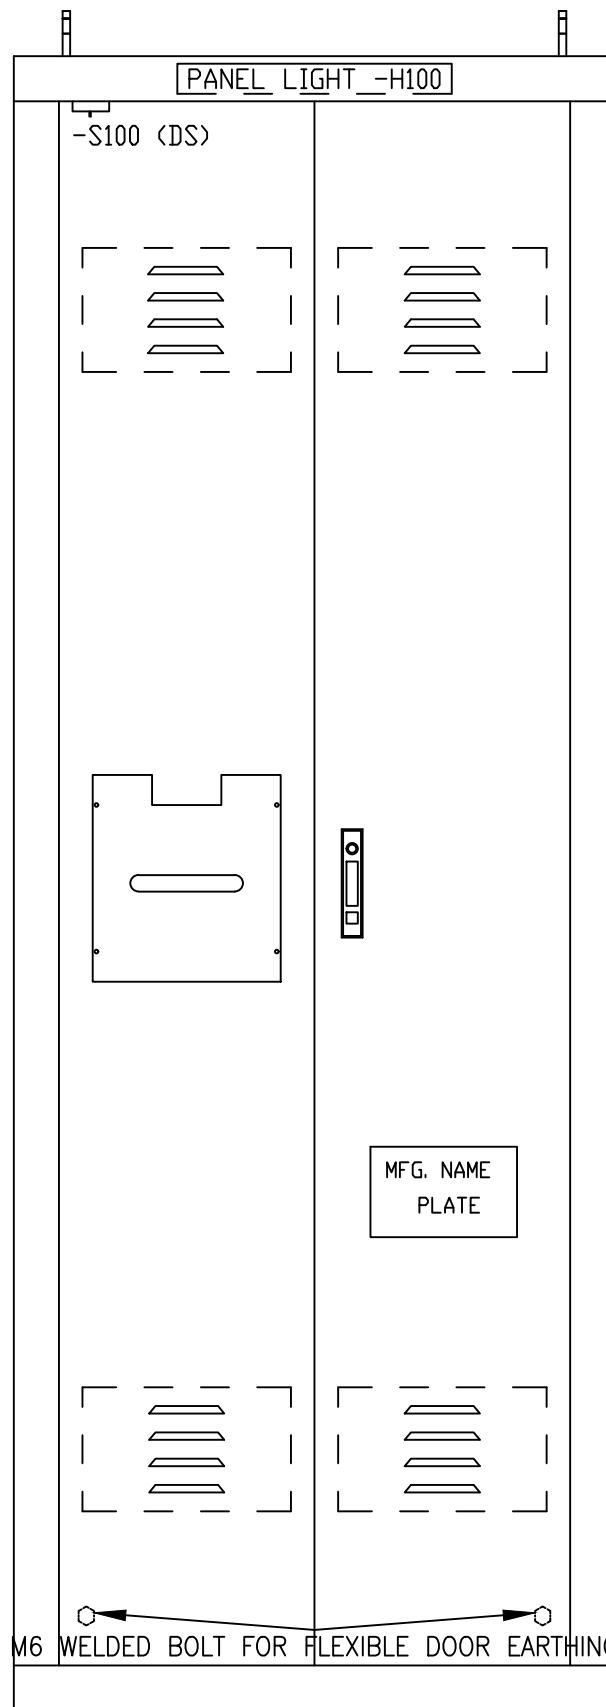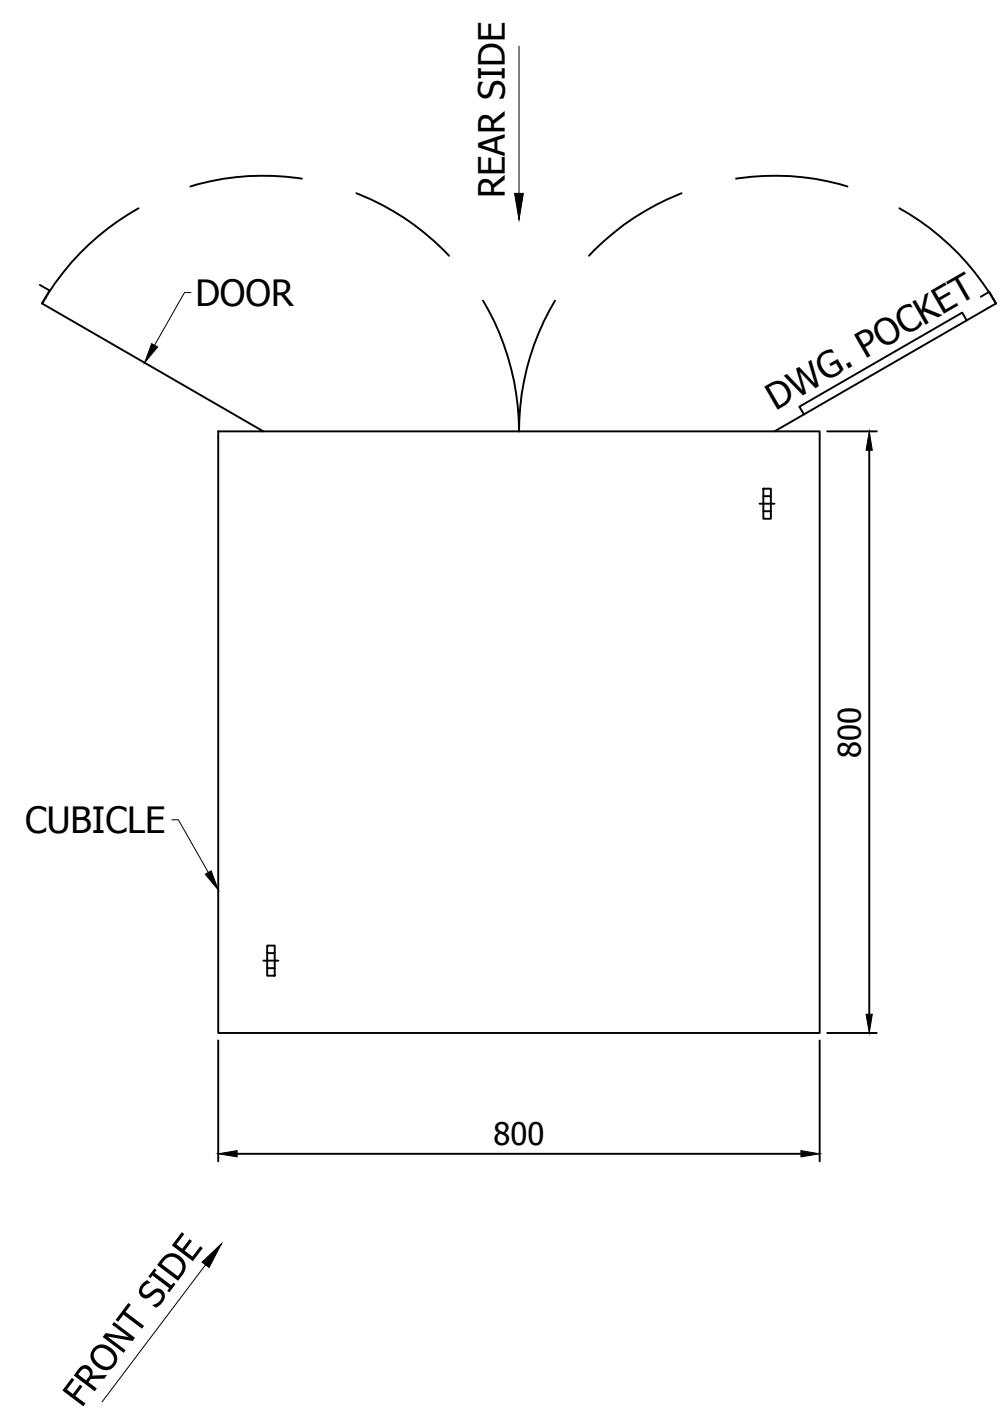


BACK VIEW WITHOUT DOORBACK VIEW WITH DOORTOP VIEW**NOTE:-**

- 1 - PANEL DIMENSION: 800 x 800 x 2200mm (WxDxH)
- 2 - COLOR : RAL 7032
- 3 - SHEET THICKNESS : 2-2.5 mm
- 4 - PROTECTION CLASS : IP-51 (INDOOR TYPE)
- 5 - ALL DOOR FITTED WITH 16mm EARTH STRAP & INSULATED WITH GREEN-YELLOW COLOUR.


All information contained in this document is the exclusive property of GE GRID SOLUTIONS and shall not be used, copied or communicated to third parties without its prior authorization.

0	AS BUILT	20.11.2018	ASJ	Manufacturer <b>EPE SOL</b> 71-B Garden Block, New Garden Town, Lahore, Pakistan	Contractor <b>GE</b> Grid Solutions A GE and Alstom joint venture	Client <b>NTDC-WAPDA</b> NATIONAL TRANSMISSION & DISPATCH COMPANY LIMITED	Project 220kV/132kV GIS SUBSTATION GHAZI ROAD, LAHORE	Title 132kV LINE RELAY PANEL (=E10+RP3) PANEL VIEW	Drawing no. P60194-E-ELR-SC-002
REV.	DESCRIPTION	DATE	DRAWER						Project no. P-60194

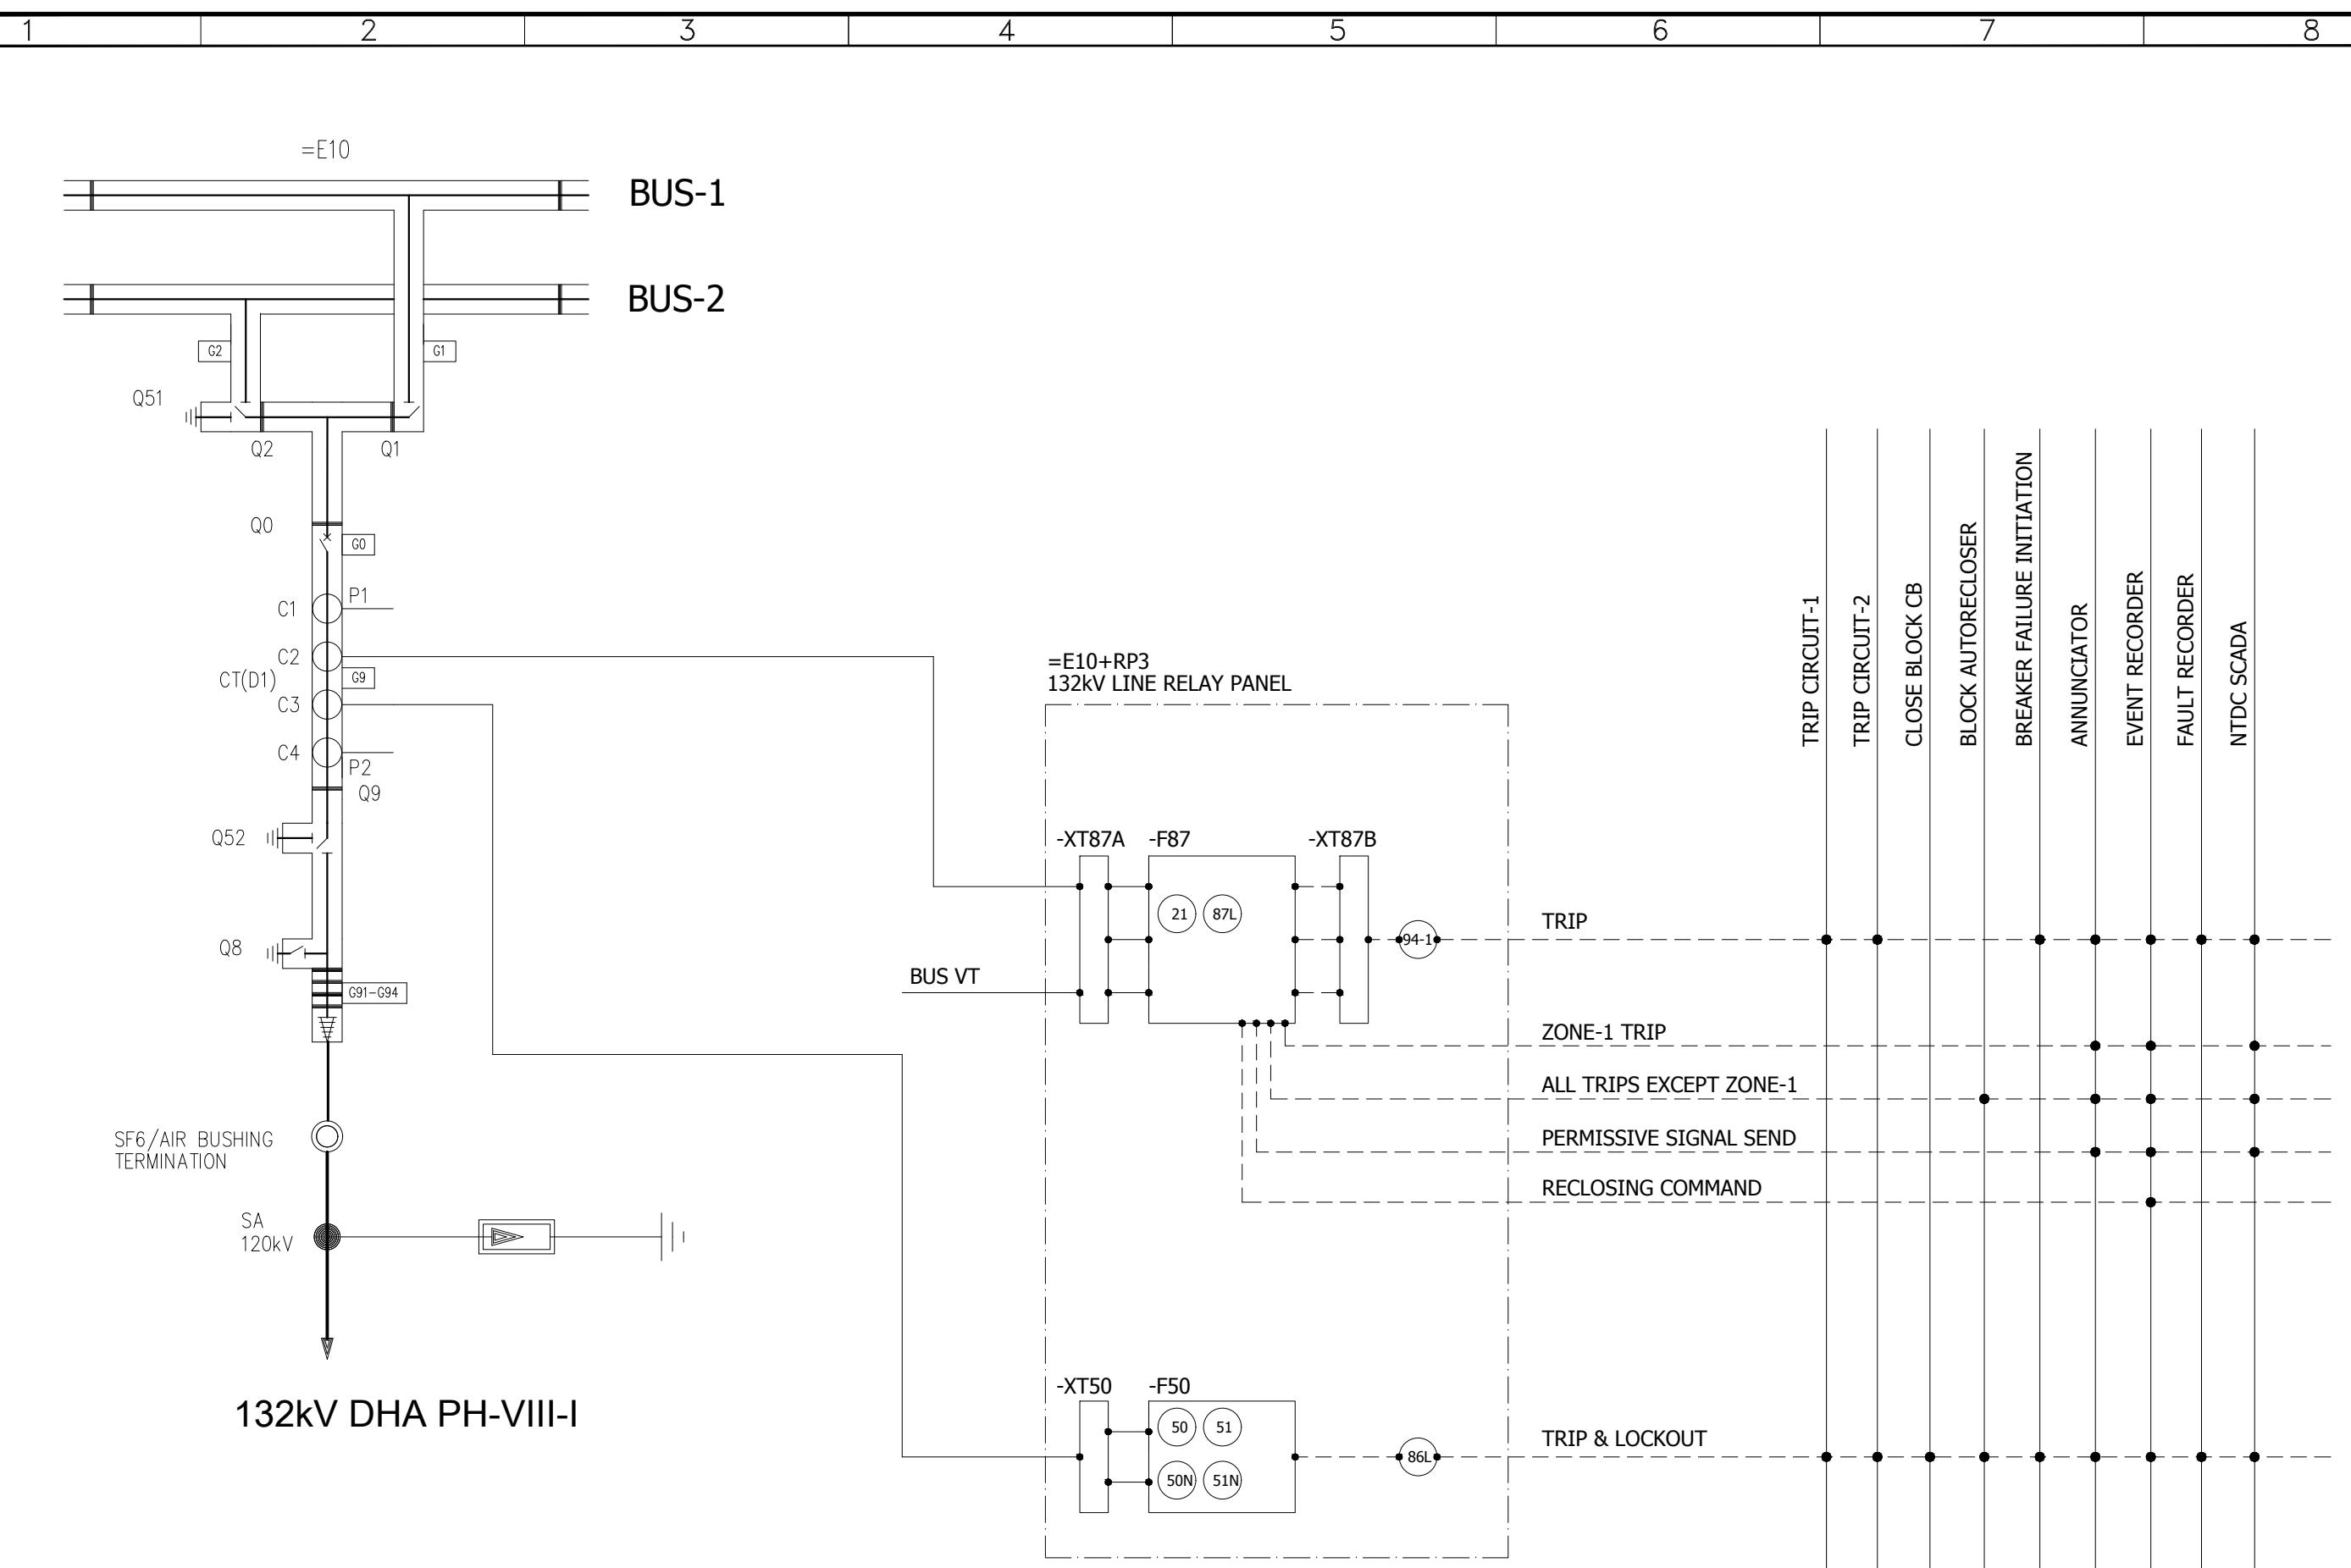

0	AS BUILT	20.11.2018	ASJ	Manufacturer <b>E P E S O L</b> 7a-B Garden Block, New Garden Town, Lahore, Pakistan	Contractor <b>Grid Solutions</b> A GE and Alstom joint venture	Client <b>NATIONAL TRANSMISSION &amp; DISPATCH COMPANY LIMITED (NTDC-WAPDA)</b>	Project 220kV/132kV GIS SUBSTATION GHAZI ROAD, LAHORE	Title 132kV LINE RELAY PANEL (=E10+RP3) BAY CONCEPT & PROTECTION LOGICS	Drawing no. P60194-E-ELR-SC-002
									Project no. P-60194
									Sheet type AE
	REV.	DESCRIPTION	DATE	DRAWER					Sheet no. 06

All information contained in this document is the exclusive property of GE GRID SOLUTIONS and shall not be used, copied or communicated to third parties without its prior authorization.

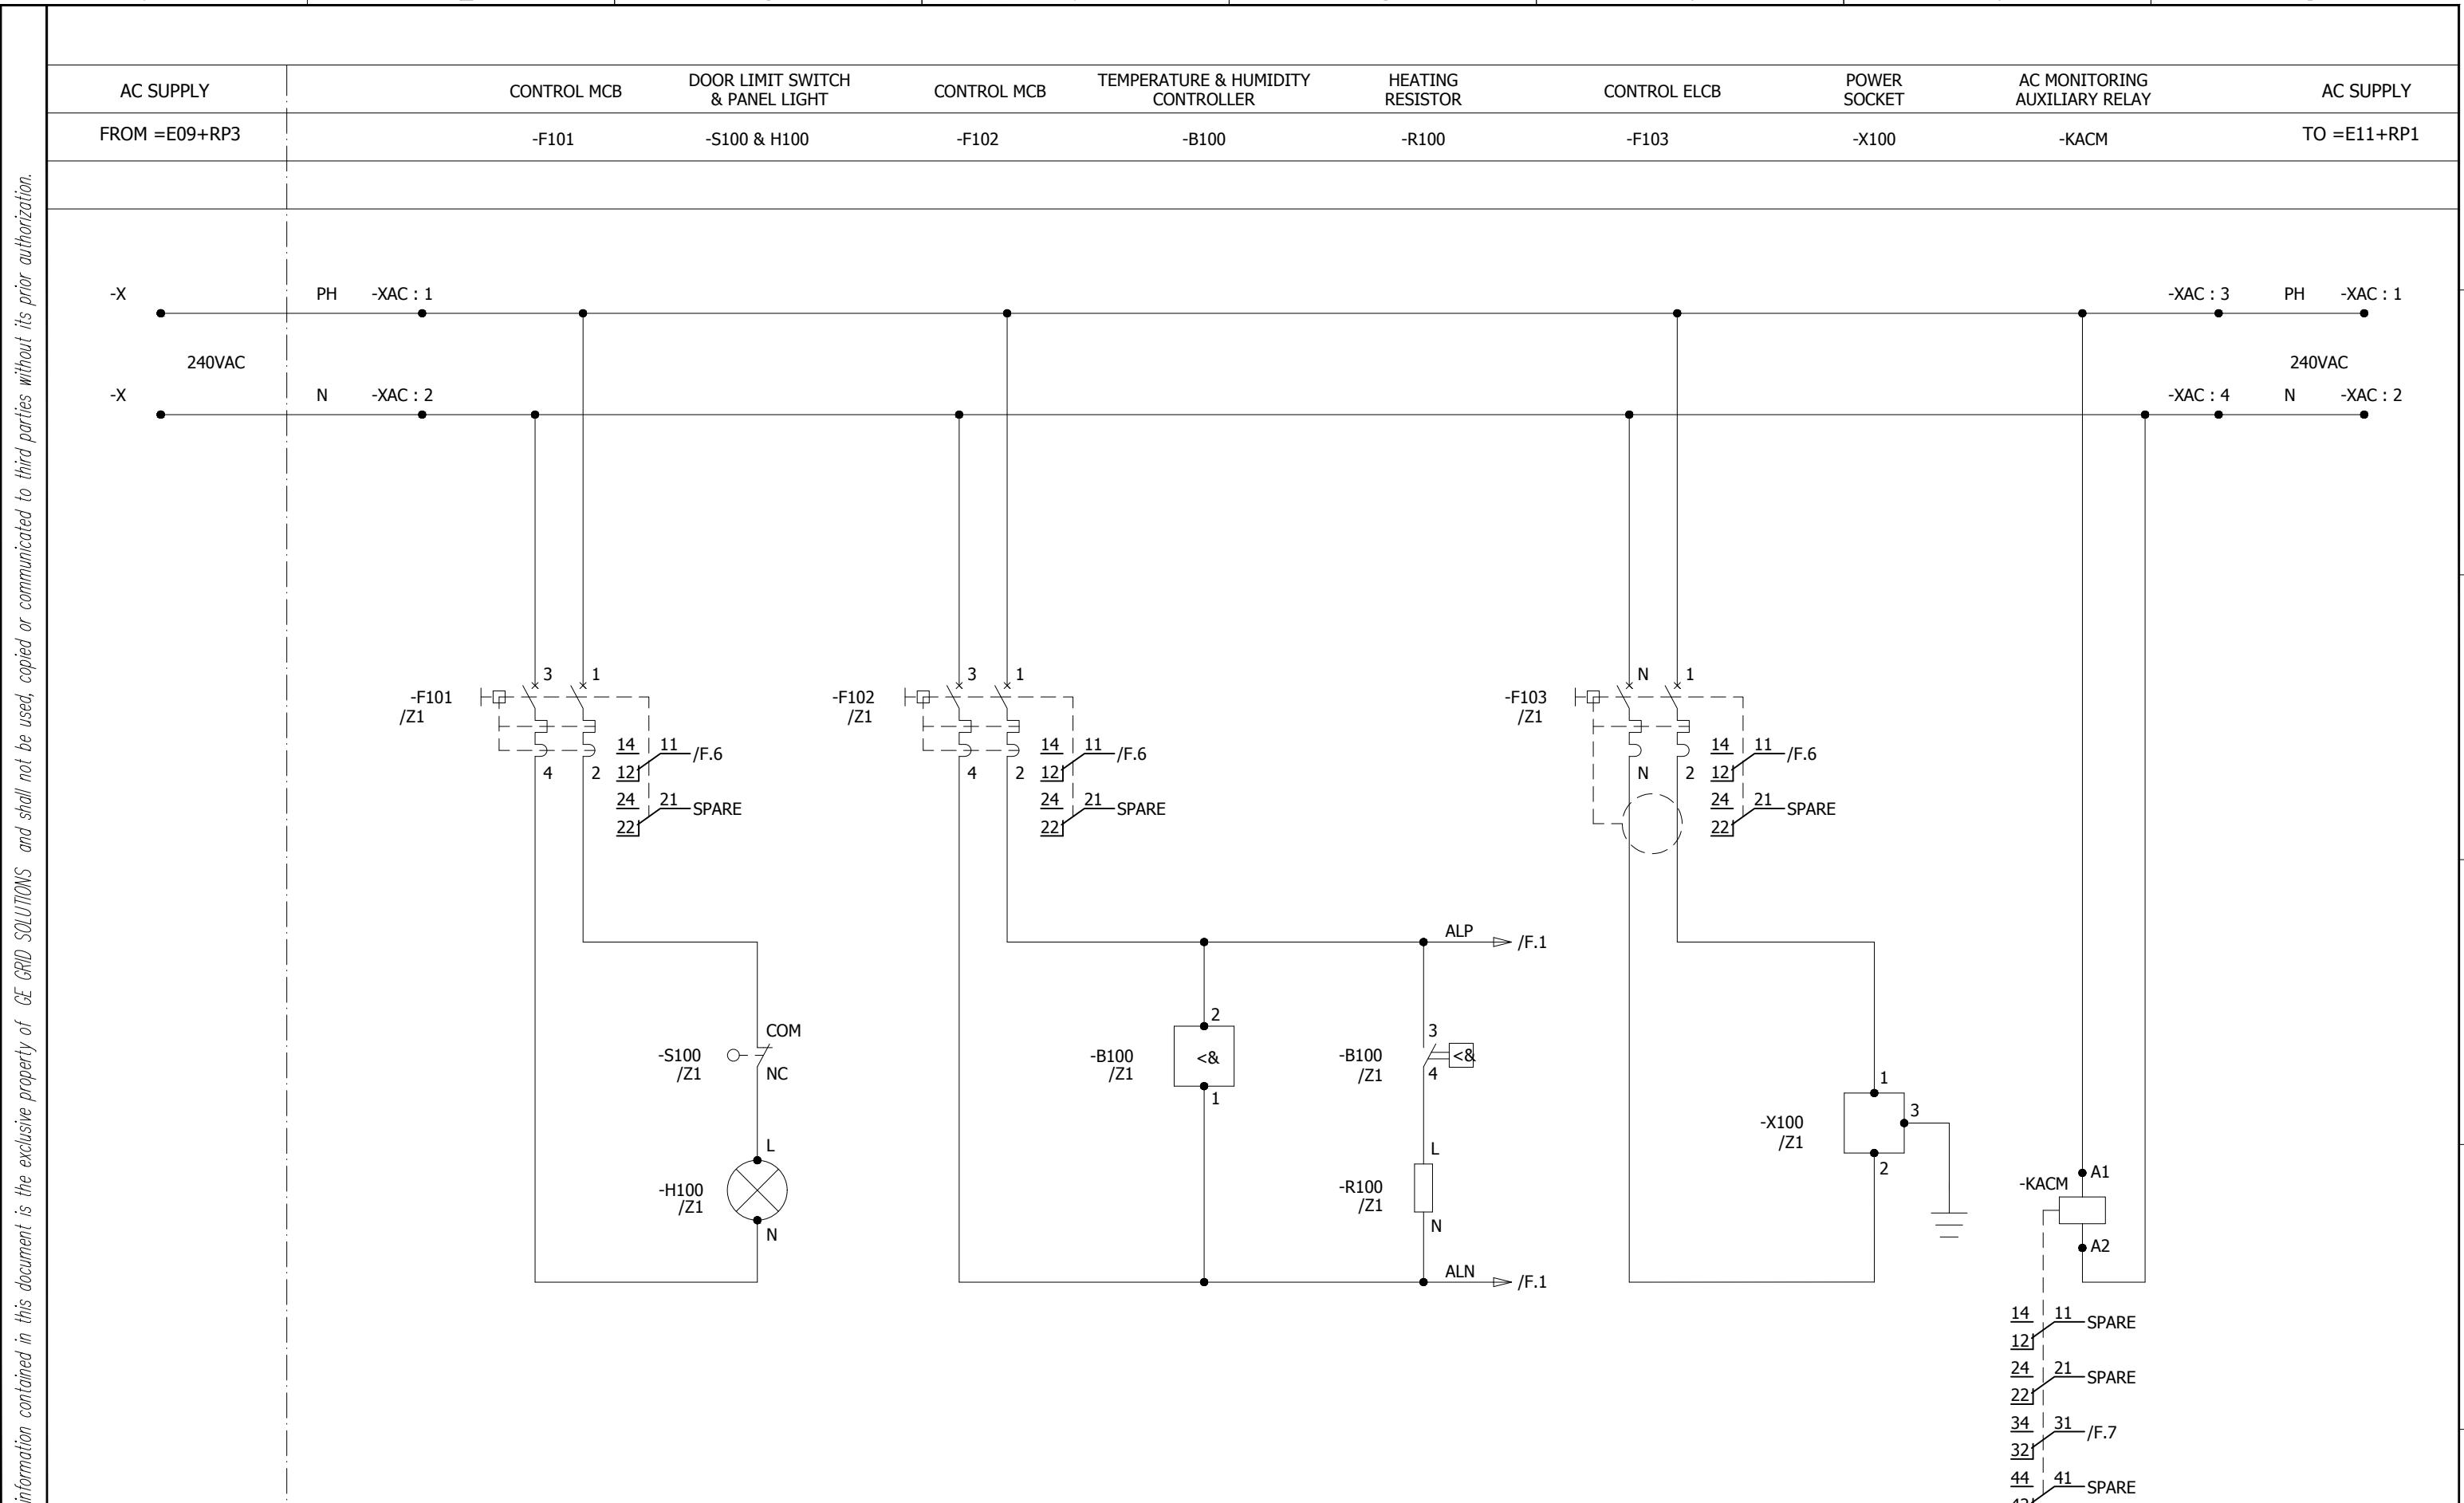

0	AS BUILT	20-11-2018	ASJ	Manufacturer  EPESOL 71-B Garden Block, New Garden Town, Lahore, Pakistan	Contractor  Grid Solutions A GE and Alstom joint venture	Client  NATIONAL TRANSMISSION & DISPATCH COMPANY LIMITED (NTDC-WAPDA)	Project 220kV/132kV GIS SUBSTATION GHAZI ROAD, LAHORE	Title 132kV LINE RELAY PANEL (=E10+RP3) AC SUPPLY DISTRIBUTION	Drawing no. P60194-E-ELR-SC-007		
REV.	DESCRIPTION	DATE	DRAWER						Project no. P-60194	Sheet type D	Sheet no. 07
1	2	3	4	5	6	7	8				




## 110V DC CIRCUIT FAULTY

## 240V AC CIRCUIT FAULTY


-KDC

-KAC


/D.5 ➤ ALP

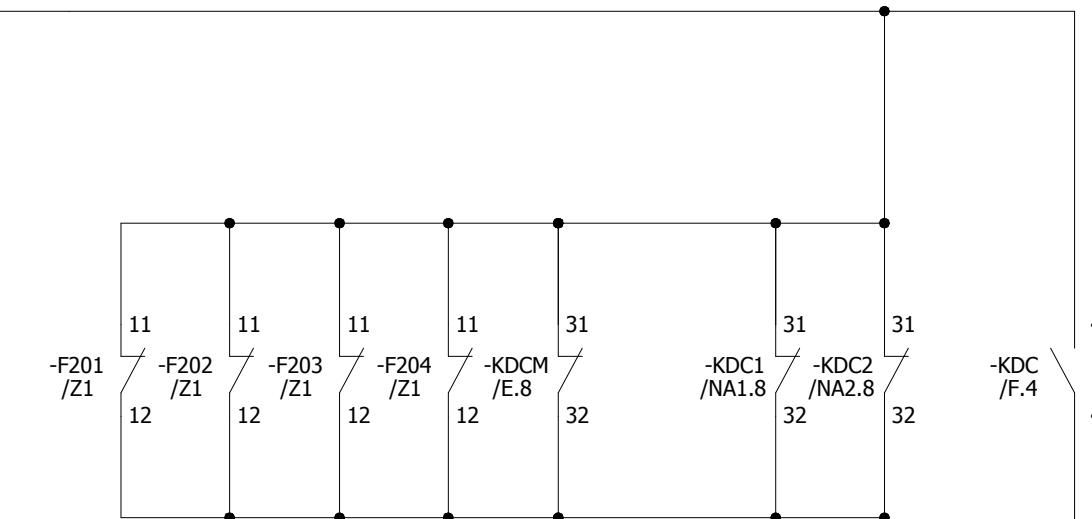


/E.7 ➤ AL+

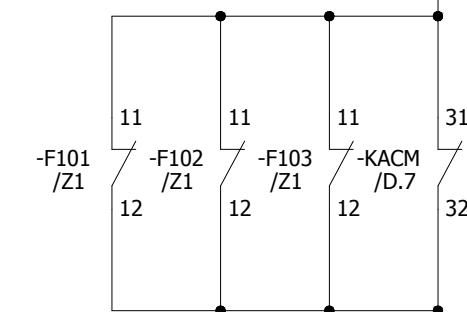

/D.5 ➤ ALN

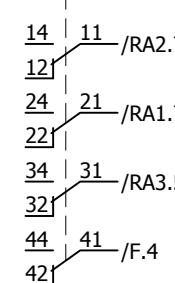

/E.7 ➤ AL-

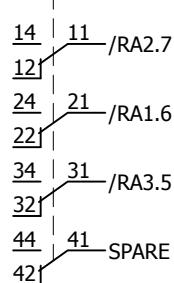

All information contained in this document is the exclusive property of GE GRID SOLUTIONS and shall not be used, copied or communicated to third parties without its prior authorization.

A

A

B

B

C

C

D

D

E

E

F

F


0	AS BUILT	20-11-2018	ASJ	Manufacturer  EPESOL 71-B Garden Block, New Garden Town, Lahore, Pakistan	Contractor  Grid Solutions A GE and Alstom joint venture	Client  NATIONAL TRANSMISSION & DISPATCH COMPANY LIMITED (NTDC-WAPDA)	Project 220KV/132KV GIS SUBSTATION GHAZI ROAD, LAHORE	Title 132KV LINE RELAY PANEL (=E10+RP3) AC/DC SUPPLY FAILURE CIRCUIT	Drawing no. P60194-E-ELR-SC-007	
REV.	DESCRIPTION	DATE	DRAWER					Project no. P-60194	Sheet type F	Sheet no. 09

## LINE DIFFERENTIAL PROTECTION

## OVERCURRENT PROTECTION

## RELAY SUPPLY

## RELAY SUPPLY

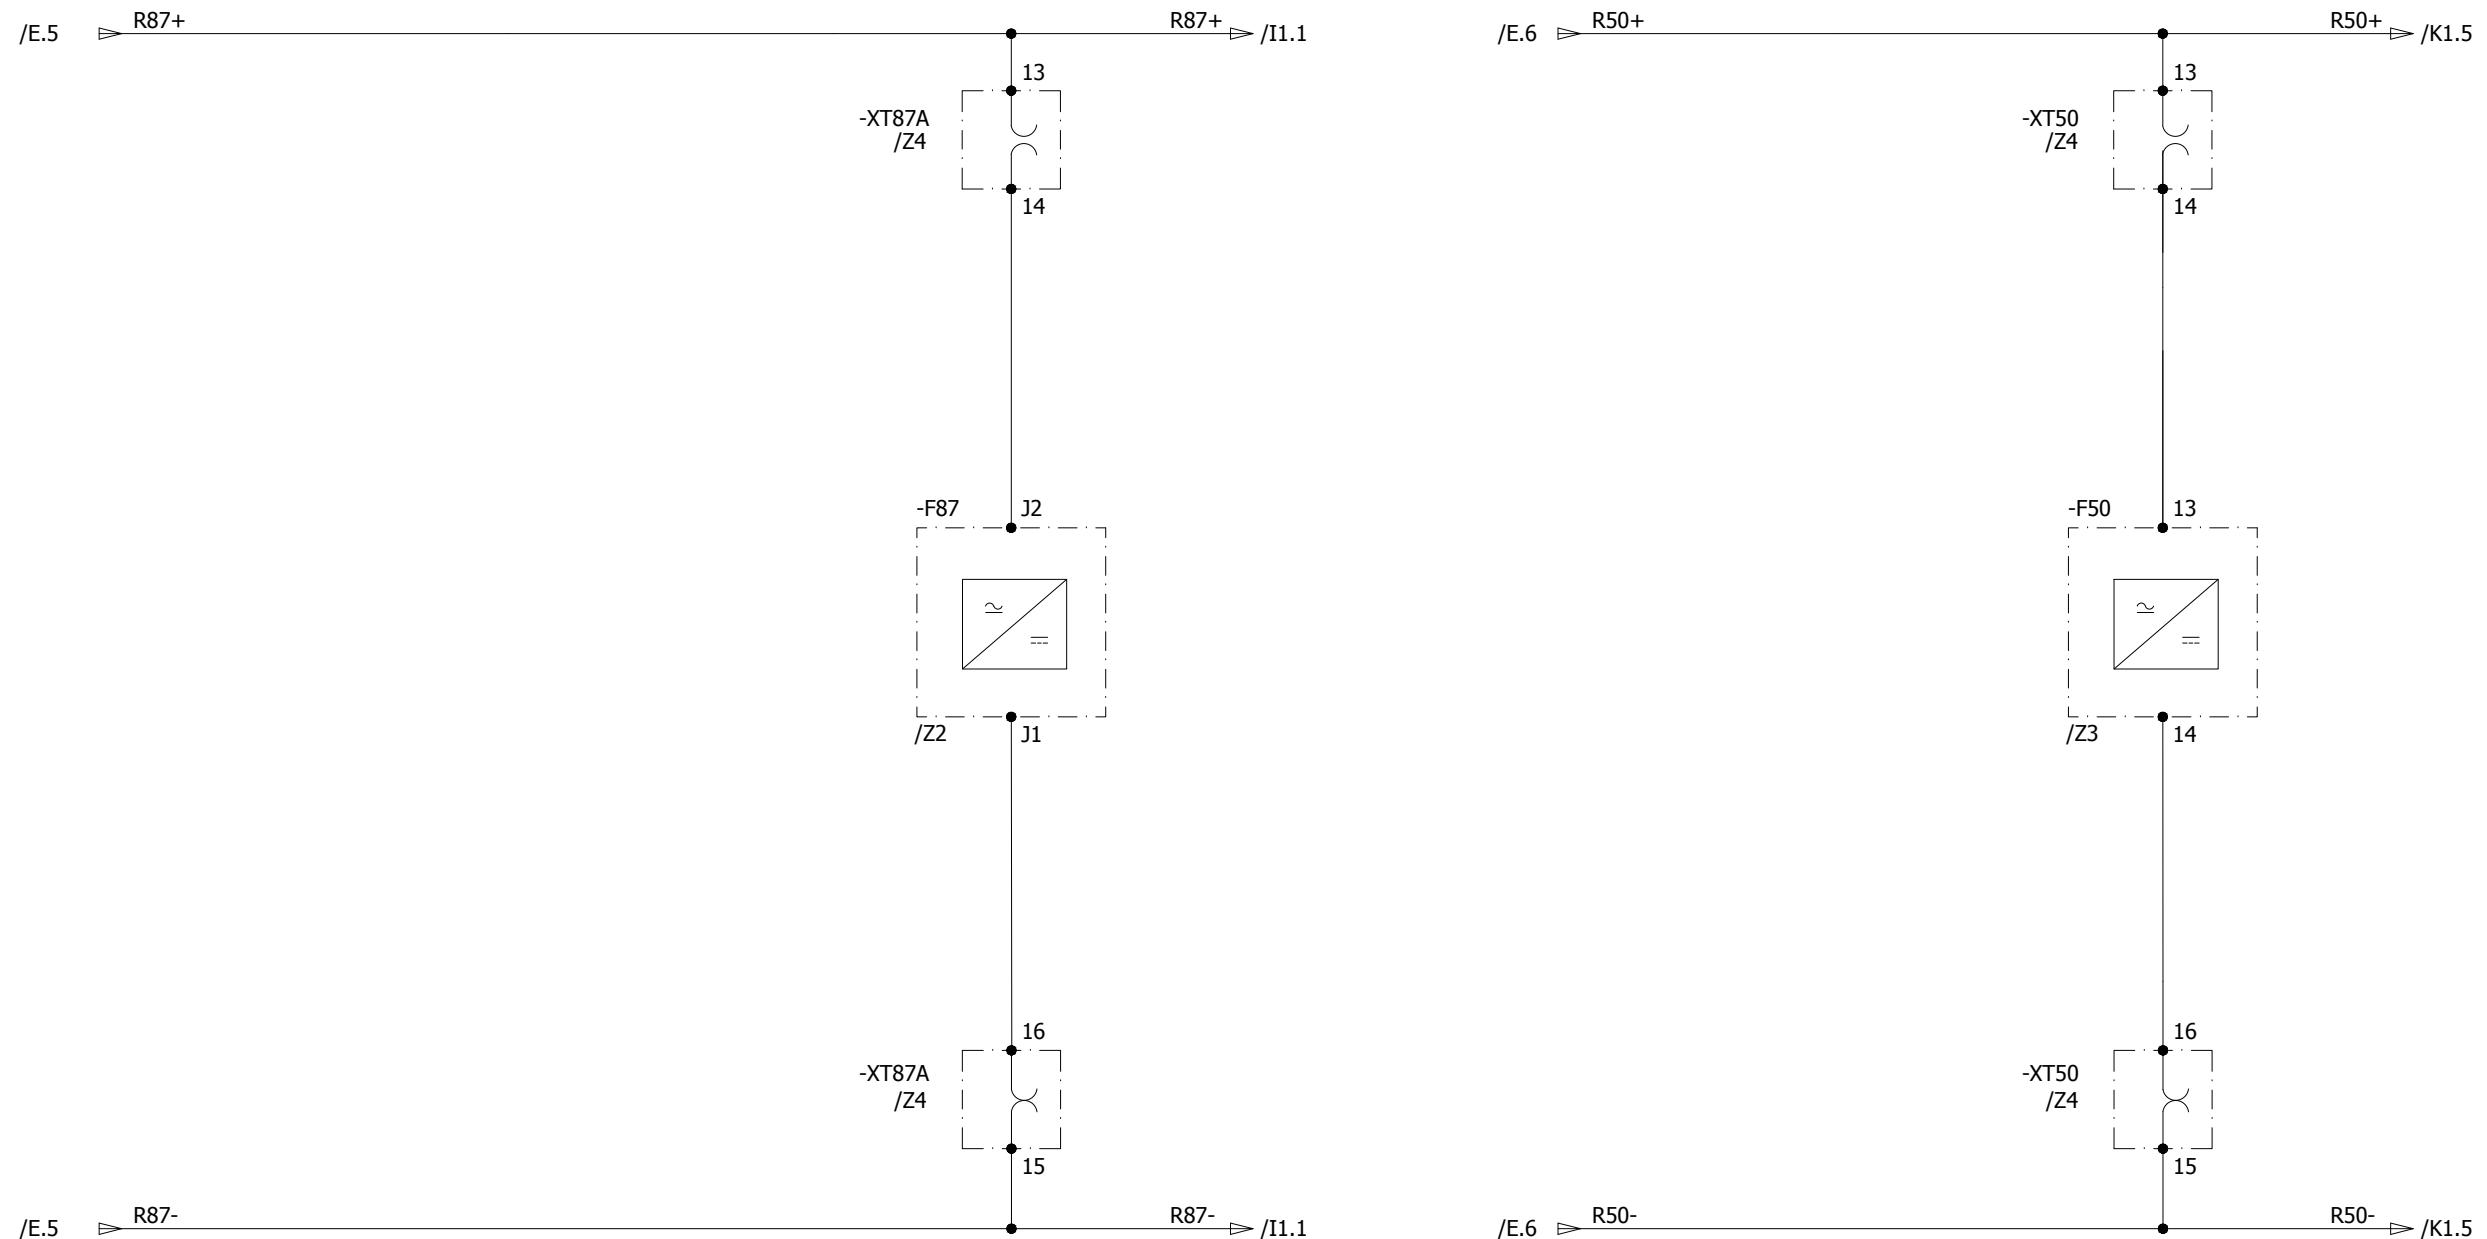

All information contained in this document is the exclusive property of GE GRID SOLUTIONS and shall not be used, copied or communicated to third parties without its prior authorization.

A

A

B

B

C

C

D

D

E

E

F

F

0	AS BUILT	20-11-2018	ASJ	Manufacturer  EPESOL 71-B Garden Block, New Garden Town, Lahore, Pakistan	Contractor  Grid Solutions A GE and Alstom joint venture	Client  NATIONAL TRANSMISSION & DISPATCH COMPANY LIMITED (NTDC-WAPDA)	Project 220kV/132kV GIS SUBSTATION GHAZI ROAD, LAHORE	Title 132kV LINE RELAY PANEL (=E10+RP3) RELAY POWER SUPPLY CIRCUIT	Drawing no. P60194-E-ELR-SC-007
REV.	DESCRIPTION	DATE	DRAWER						Project no. P-60194
									Sheet type G
									Sheet no. 10

TEST BLOCK

LINE DIFFERENTIAL PROTECTION  
RELAY

-XT87A


-F87

/Z4

/Z2

All information contained in this document is the exclusive property of GE GRID SOLUTIONS and shall not be used, copied or communicated to third parties without its prior authorization.

A

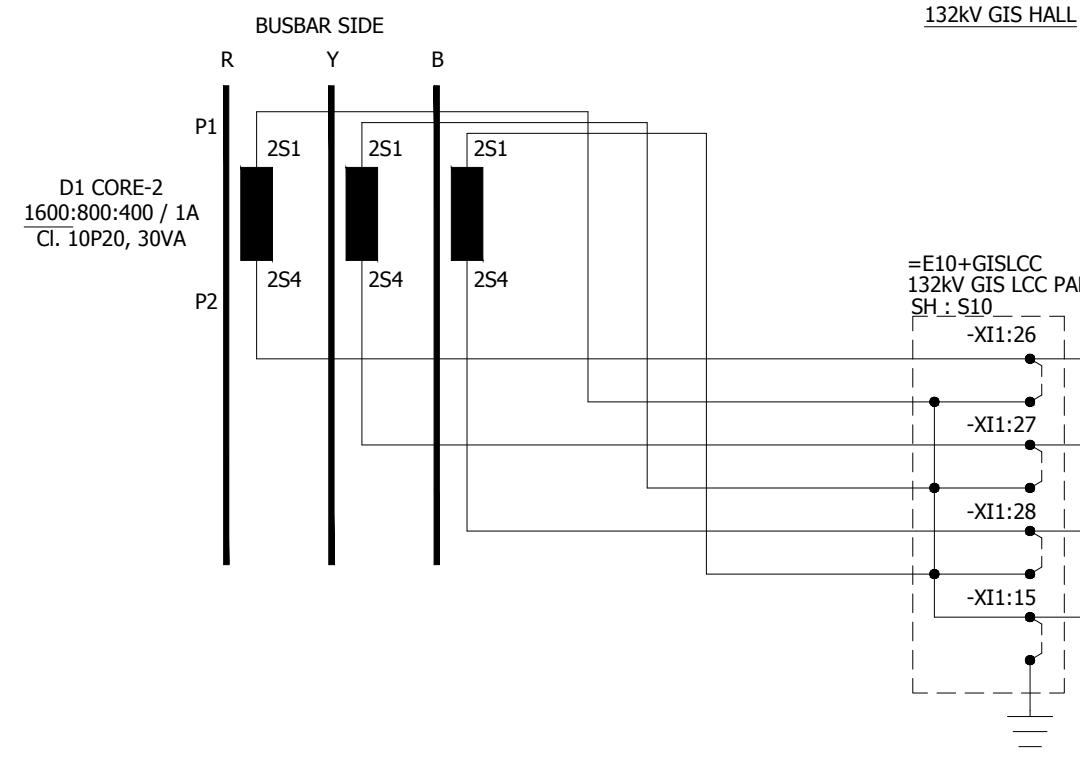


B

C


D

E

F

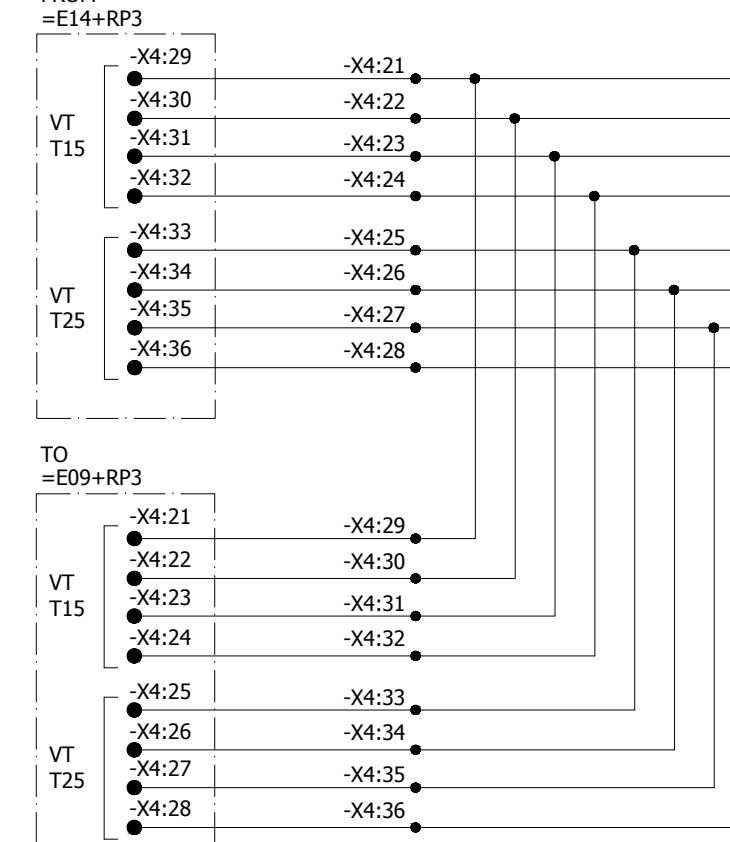

0	AS BUILT	20-11-2018	ASJ	Manufacturer  EPESOL 71-B Garden Block, New Garden Town, Lahore, Pakistan	Contractor  Grid Solutions A GE and Alstom joint venture	Client  NATIONAL TRANSMISSION & DISPATCH COMPANY LIMITED (NTDC-WAPDA)	Project 220kV/132kV GIS SUBSTATION GHAZI ROAD, LAHORE	Title 132kV LINE RELAY PANEL (=E10+RP3) LINE DIFFERENTIAL PROTECTION CT/VT CIRCUIT	Drawing no. P60194-E-ELR-SC-007	
REV.	DESCRIPTION	DATE	DRAWER					Project no. P-60194	Sheet type H1	Sheet no. 11

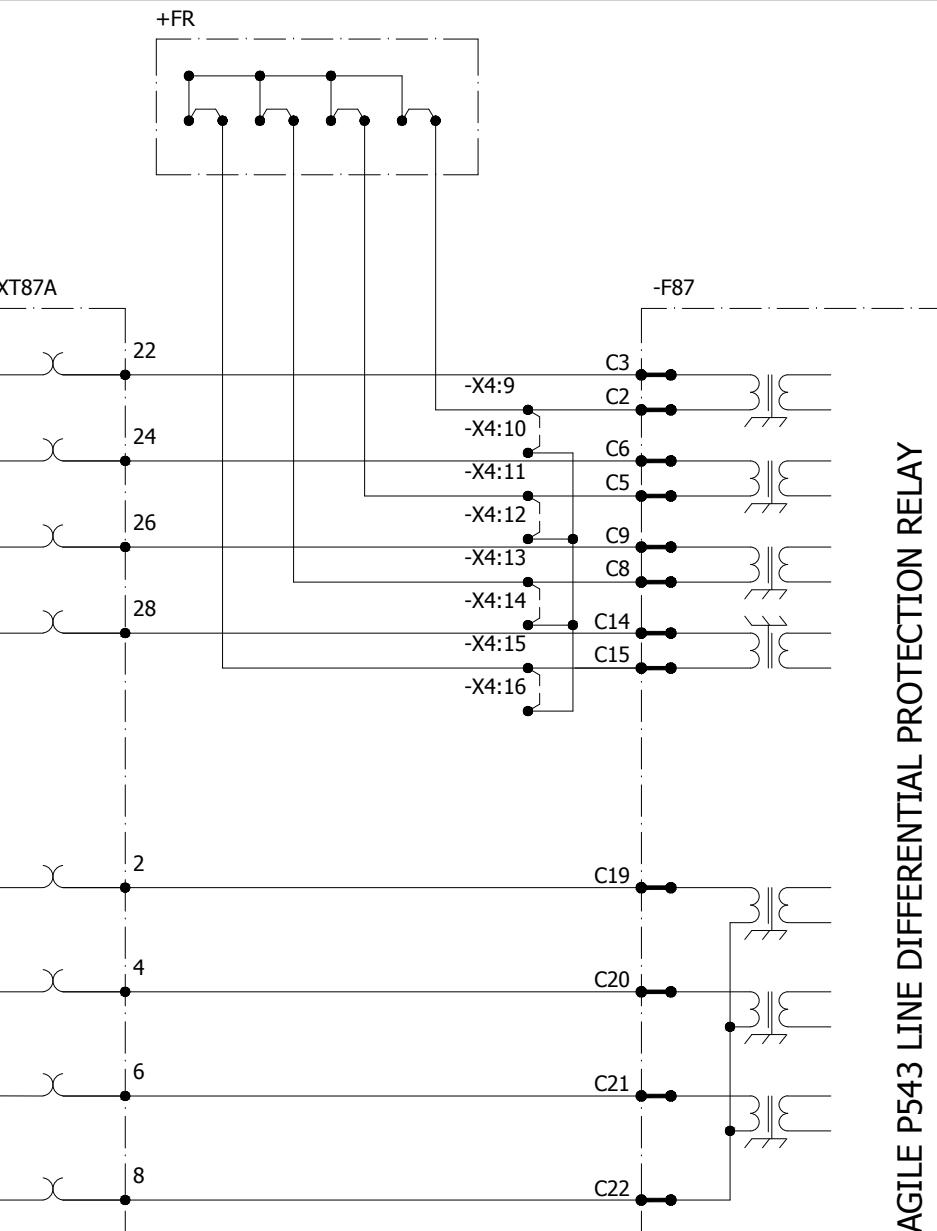

AGILE P543 LINE DIFFERENTIAL PROTECTION RELAY

A

C

D

E

F

TEST BLOCK

OVERCURRENT  
RELAY

-XT50

-F50


/Z4

/Z3

## 132kV GIS HALL


## CONTROL ROOM

All information contained in this document is the exclusive property of GE GRID SOLUTIONS and shall not be used, copied or communicated to third parties without its prior authorization.

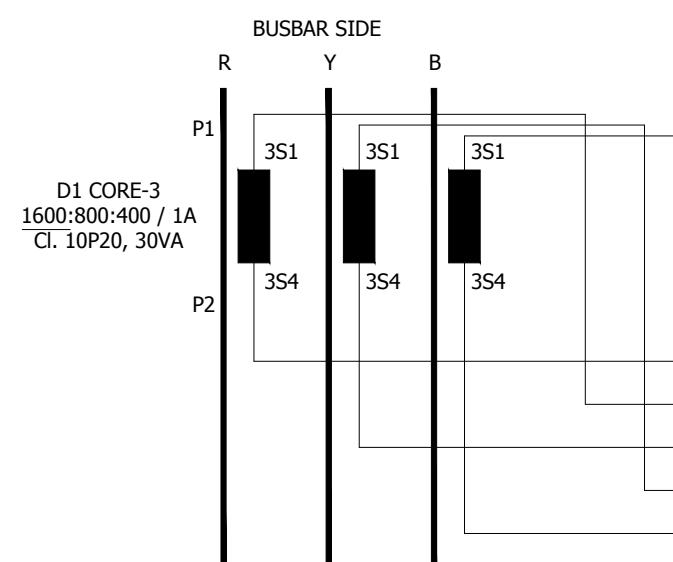

=E010+GISLCC  
132kV GIS LCC PANEL  
SH : S11  
-XI1:40  
-XI1:41  
-XI1:42  
-XI1:29

-X5:1  
-X5:2  
-X5:3  
-X5:4  
-X5:5  
-X5:6  
-X5:7  
-X5:8

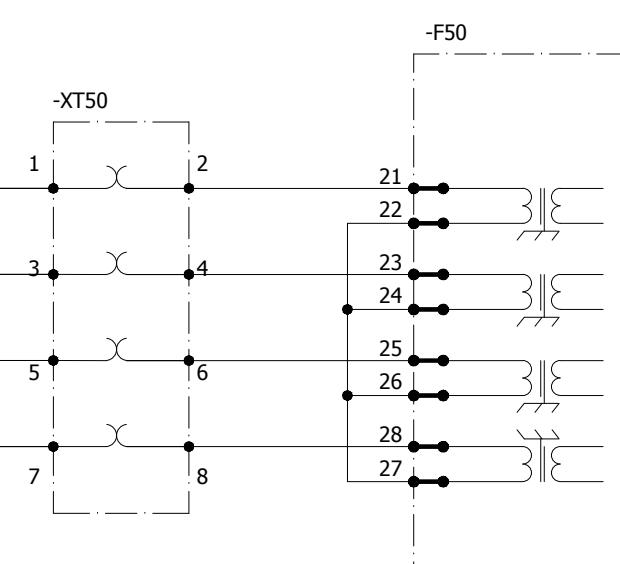

A

A

B

B

C

C

D

D

E

E


F

F

0	AS BUILT	20-11-2018	ASJ	Manufacturer  EPESOL 71-B Garden Block, New Garden Town, Lahore, Pakistan	Contractor  Grid Solutions A GE and Alstom joint venture	Client  NATIONAL TRANSMISSION & DISPATCH COMPANY LIMITED (NTDC-WAPDA)	Project 220kV/132kV GIS SUBSTATION GHAZI ROAD, LAHORE	Title 132kV LINE RELAY PANEL (=E10+RP3) O/C & E/F CT INPUTS	Drawing no. P60194-E-ELR-SC-007	
REV.	DESCRIPTION	DATE	DRAWER					Project no. P-60194	Sheet type H2	Sheet no. 12


## LINE DIFFERENTIAL PROTECTION RELAY

All information contained in this document is the exclusive property of GE GRID SOLUTIONS and shall not be used, copied or communicated to third parties without its prior authorization.

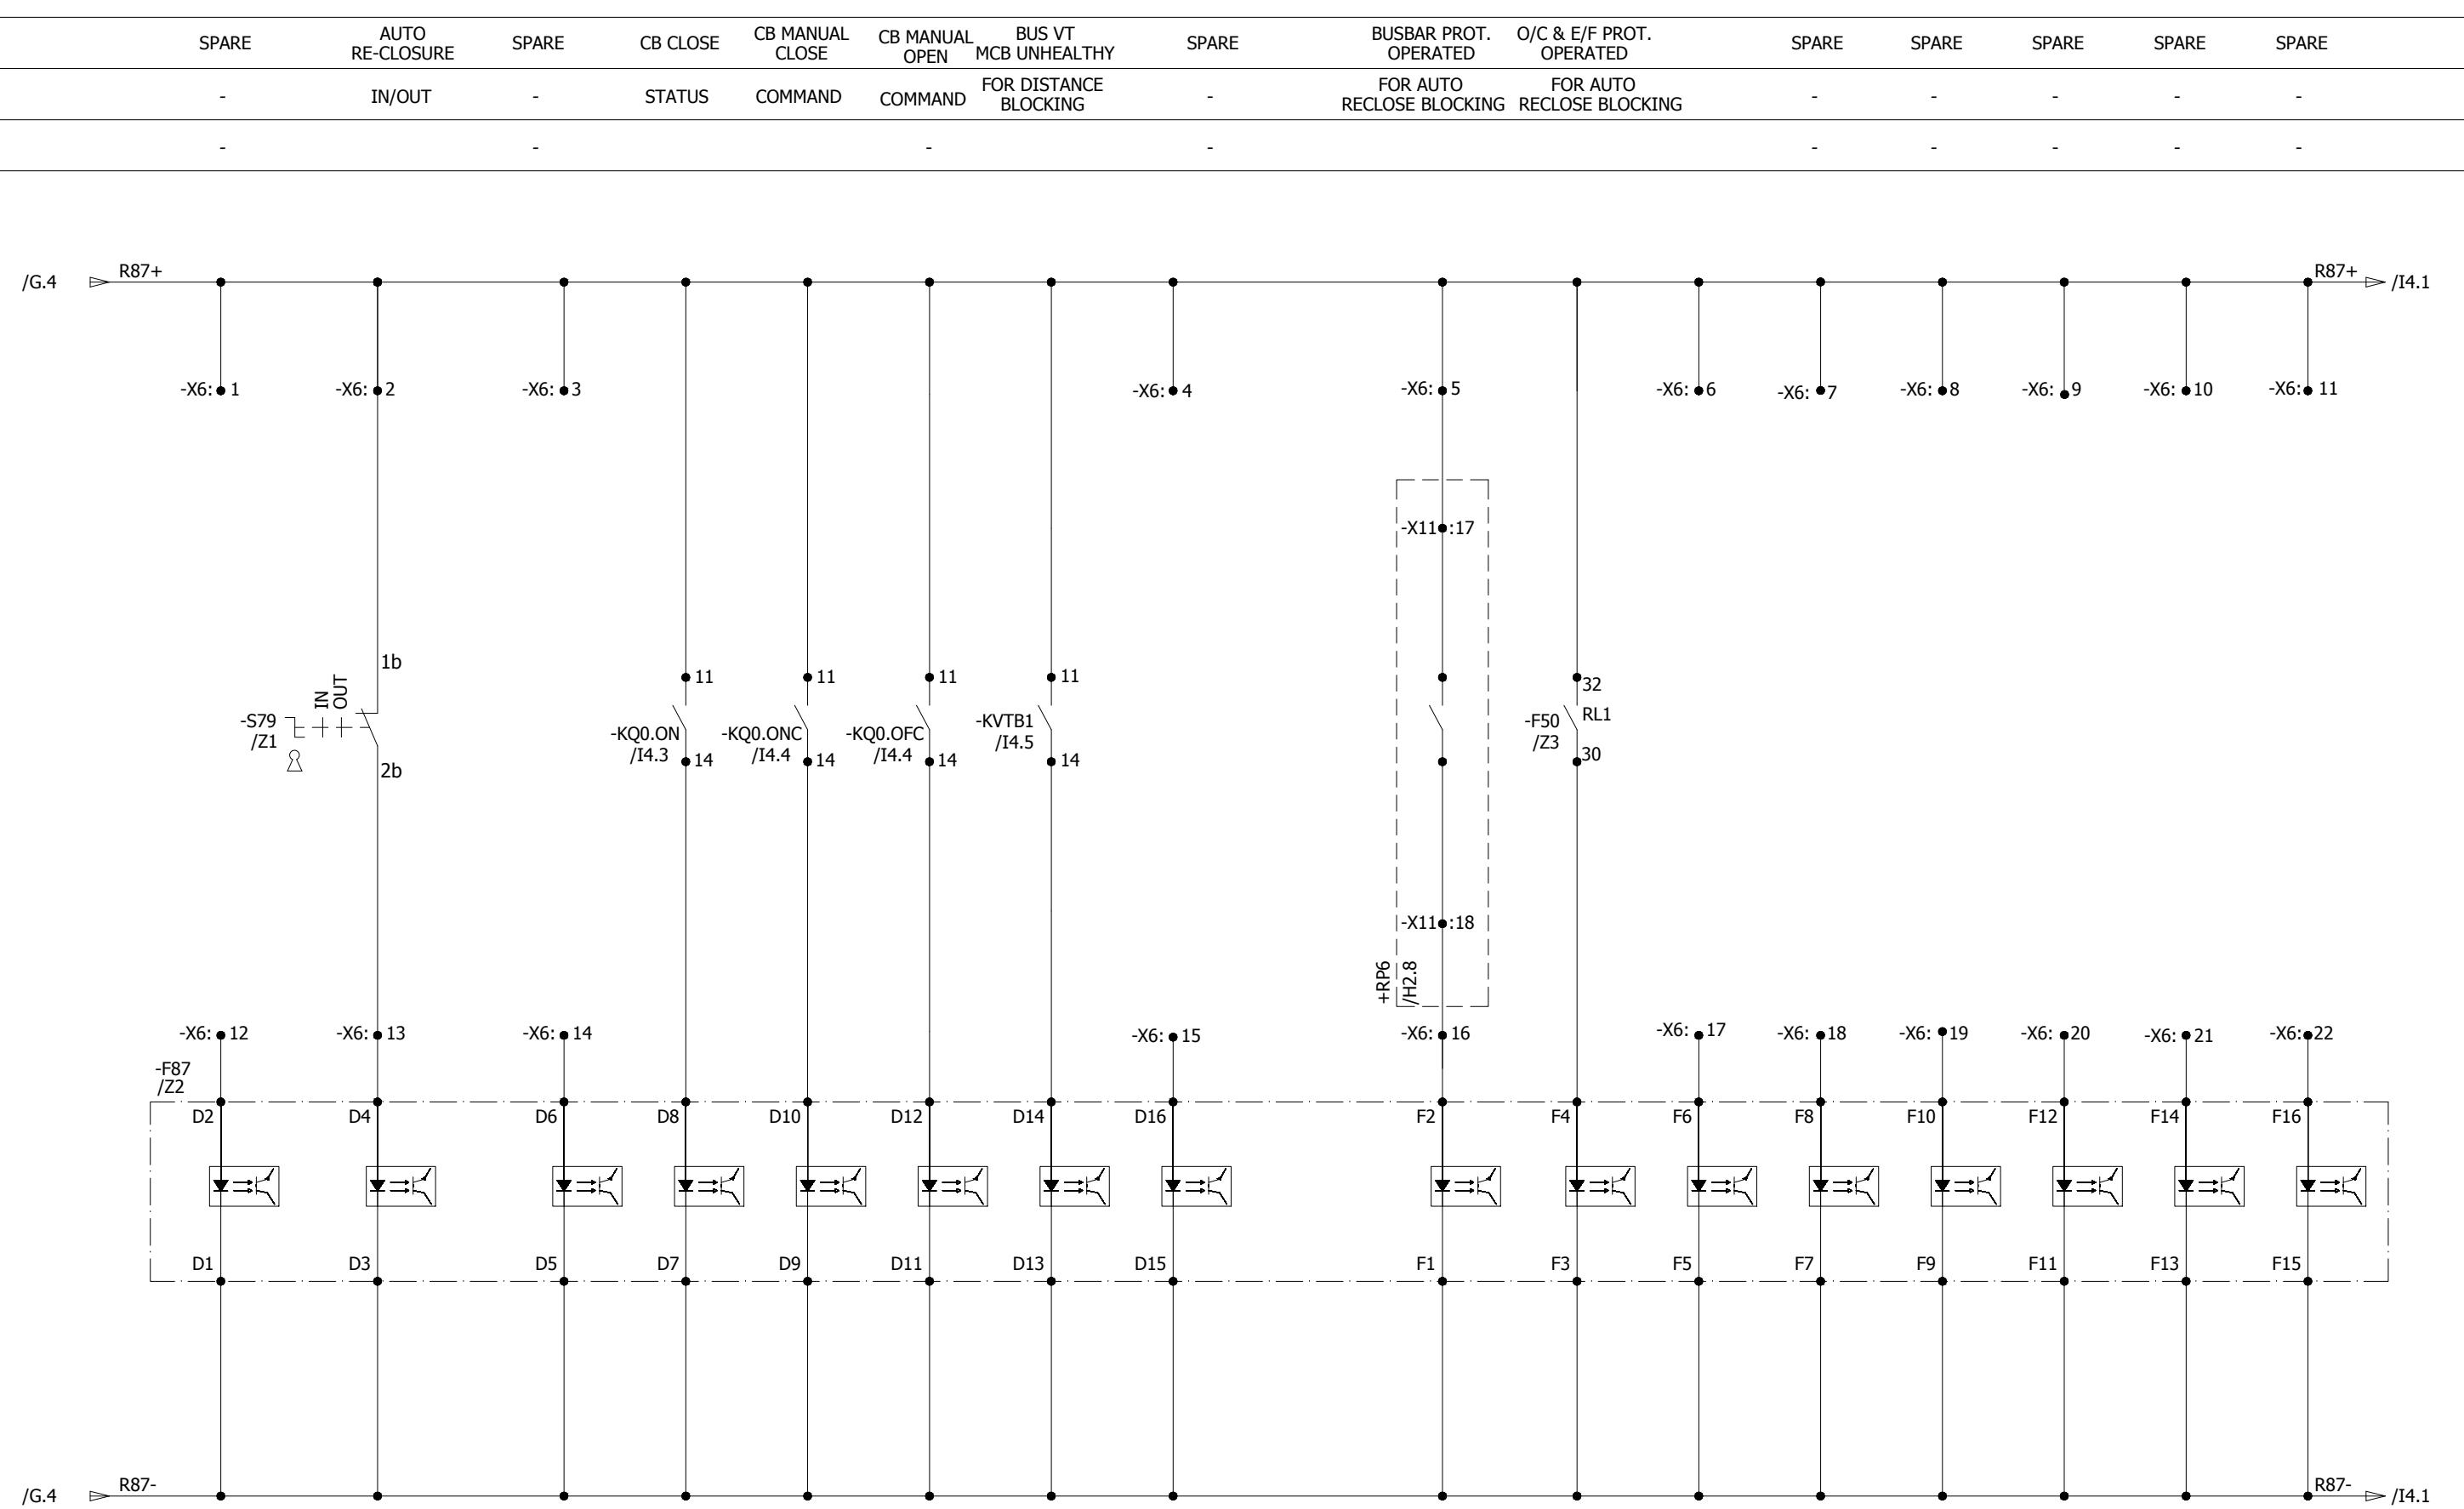

0	AS BUILT		20-11-2018	ASJ	Manufacturer  EPESOL 71-B Garden Block, New Garden Town, Lahore, Pakistan	Contractor  Grid Solutions A GE and Alstom joint venture	Client  NATIONAL TRANSMISSION & DISPATCH COMPANY LIMITED (NTDC-WAPDA)	Project 220KV/132KV GIS SUBSTATION GHAZI ROAD, LAHORE	Title 132KV LINE RELAY PANEL (=E10+RP3) LINE DIFFERENTIAL RELAY INPUTS	Drawing no. P60194-E-ELR-SC-007		
REV.	DESCRIPTION		DATE	DRAWER						Project no. P-60194	Sheet type I1	Sheet no. 13
1	2	3	4	5	6	7	8					

All information contained in this document is the exclusive property of GE GRID SOLUTIONS and shall not be used, copied or communicated to third parties without its prior authorization.

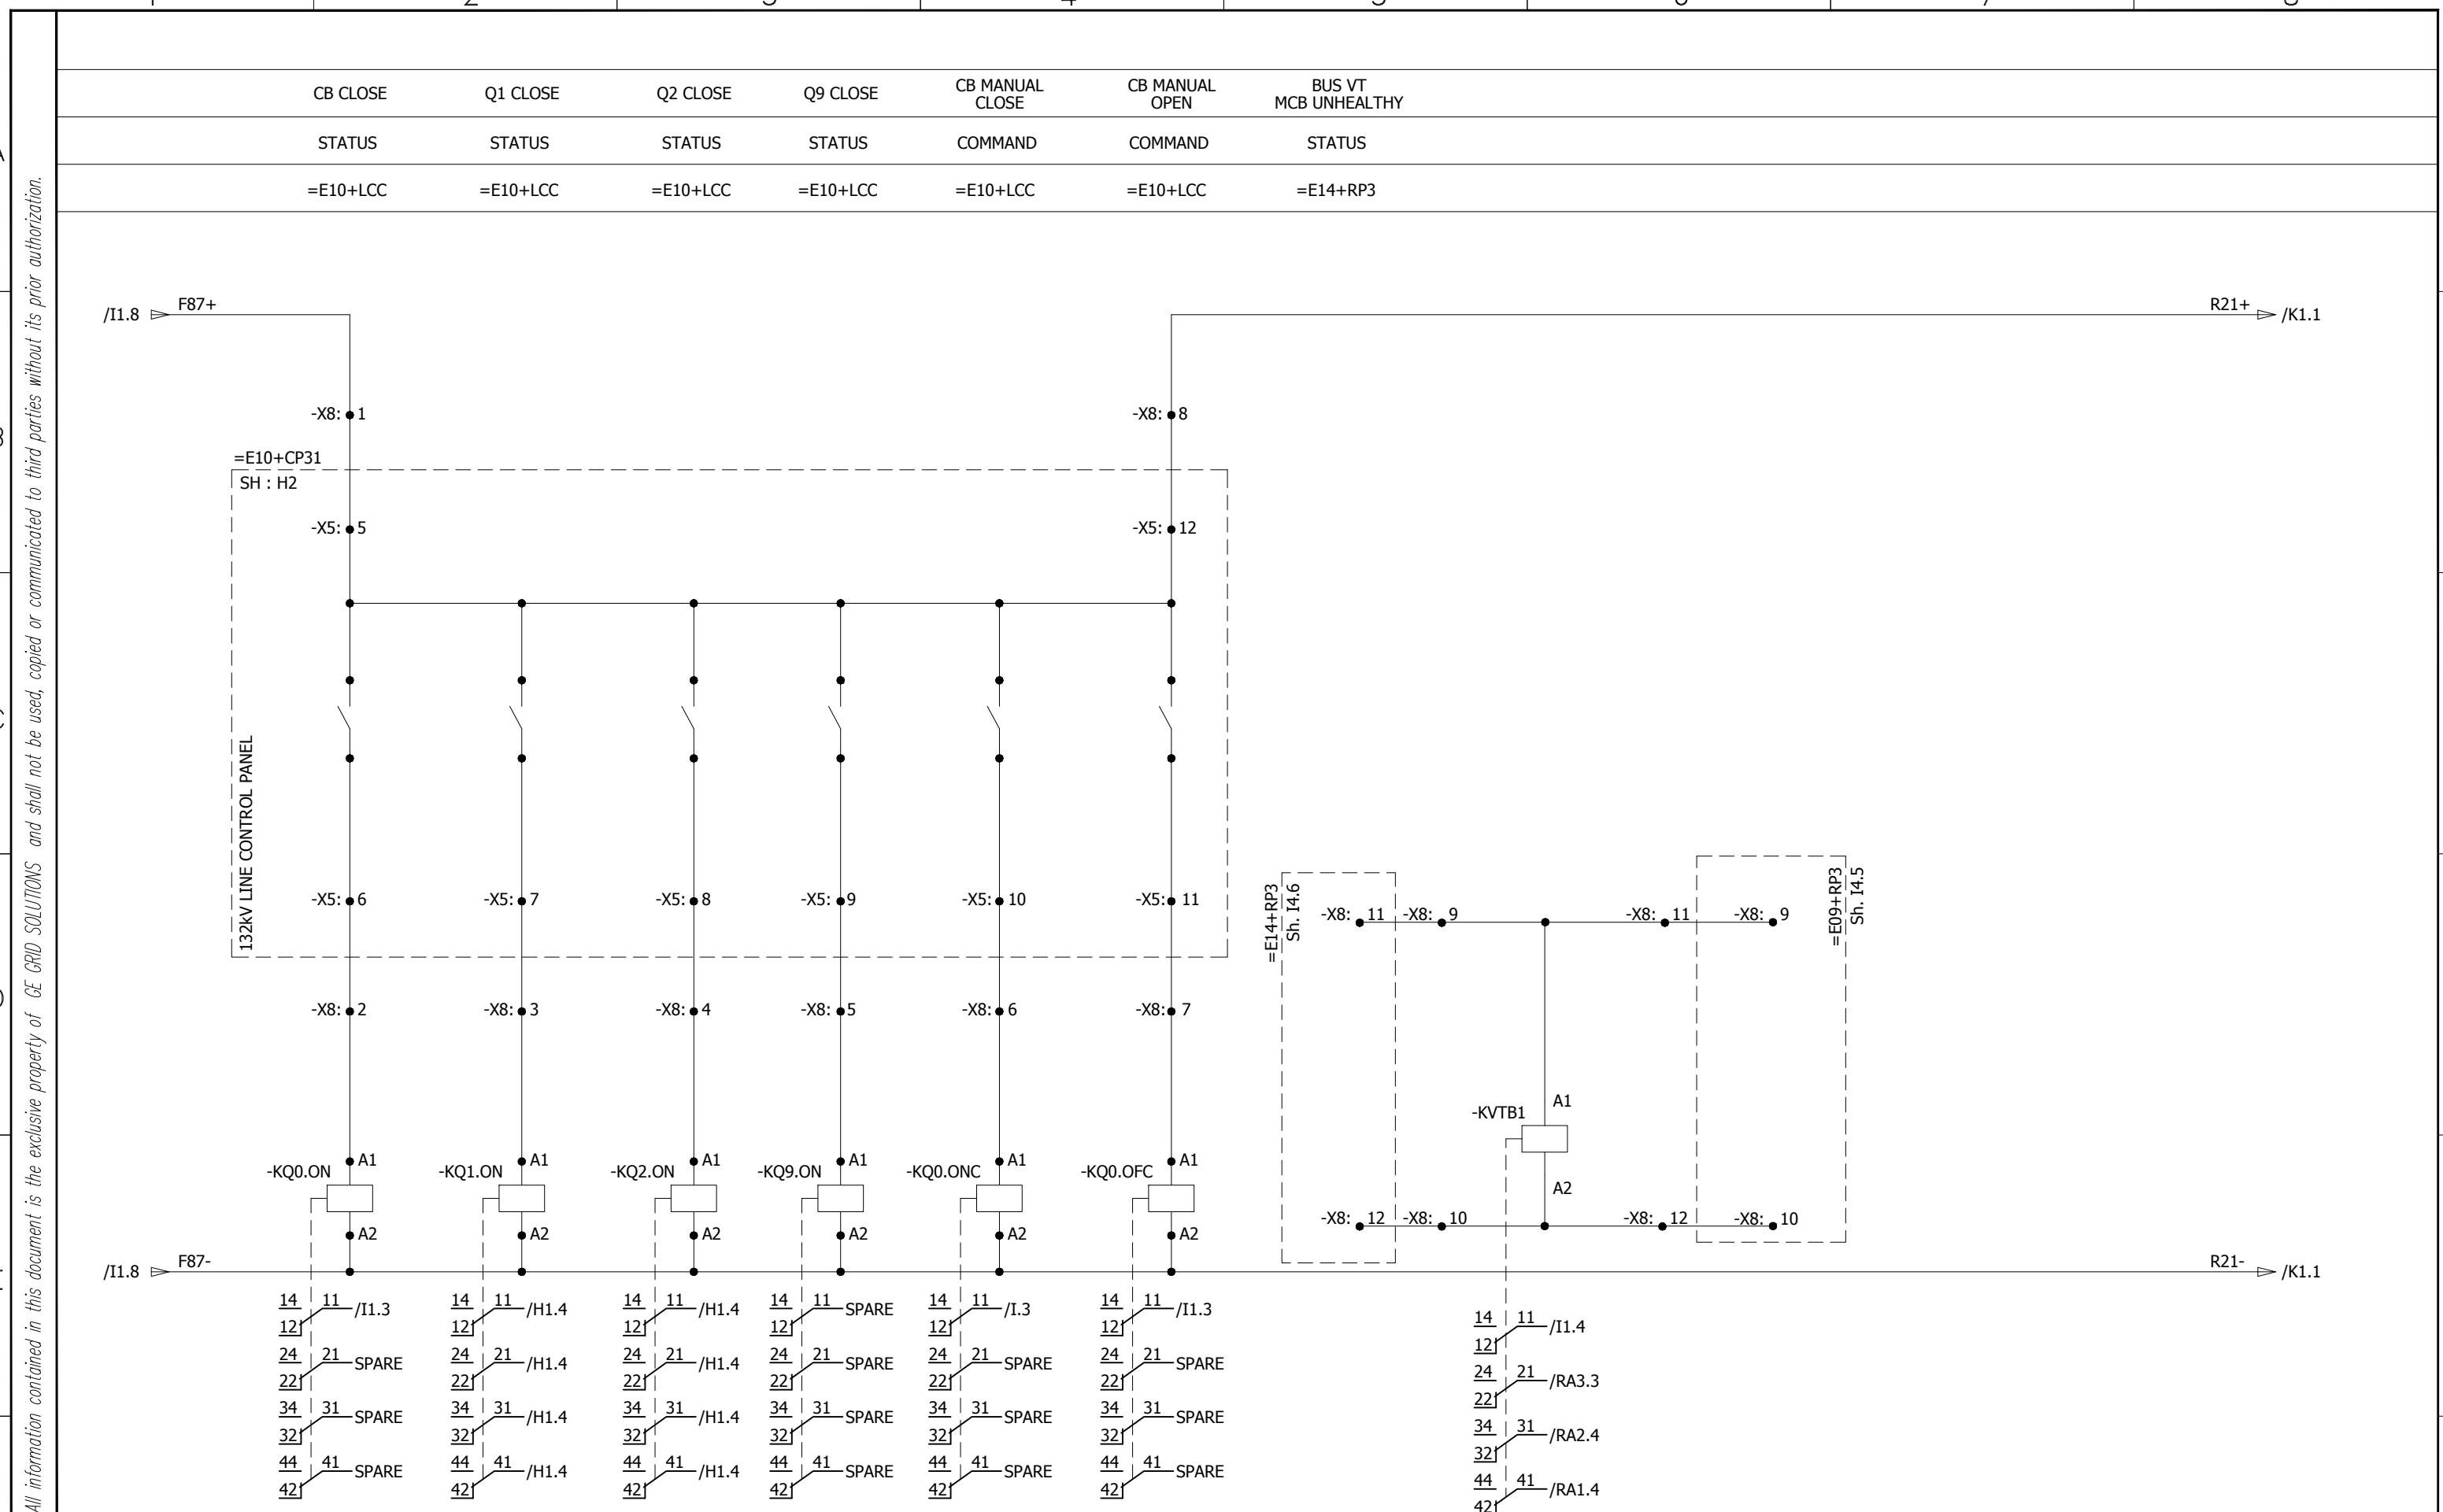


0	AS BUILT		20-11-2018	ASJ	Manufacturer  EPESOL 71-B Garden Block, New Garden Town, Lahore, Pakistan	Contractor  Grid Solutions A GE and Alstom joint venture	Client  NATIONAL TRANSMISSION & DISPATCH COMPANY LIMITED (NTDC-WAPDA)	Project 220kV/132kV GIS SUBSTATION GHAZI ROAD, LAHORE	Title 132kV LINE RELAY PANEL (=E10+RP3) SYSTEM INPUTS	Drawing no. P60194-E-ELR-SC-007	
REV.	DESCRIPTION		DATE	DRAWER					Project no. P-60194	Sheet type I4	Sheet no. 14
1	2	3	4	5	6	7	8				

## LINE DIFFERENTIAL PROTECTION GENERAL TRIP



O/C &amp; E/F PROTECTION TRIP    TRIP RELAY RESET

All information contained in this document is the exclusive property of GE GRID SOLUTIONS and shall not be used, copied or communicated to third parties without its prior authorization.

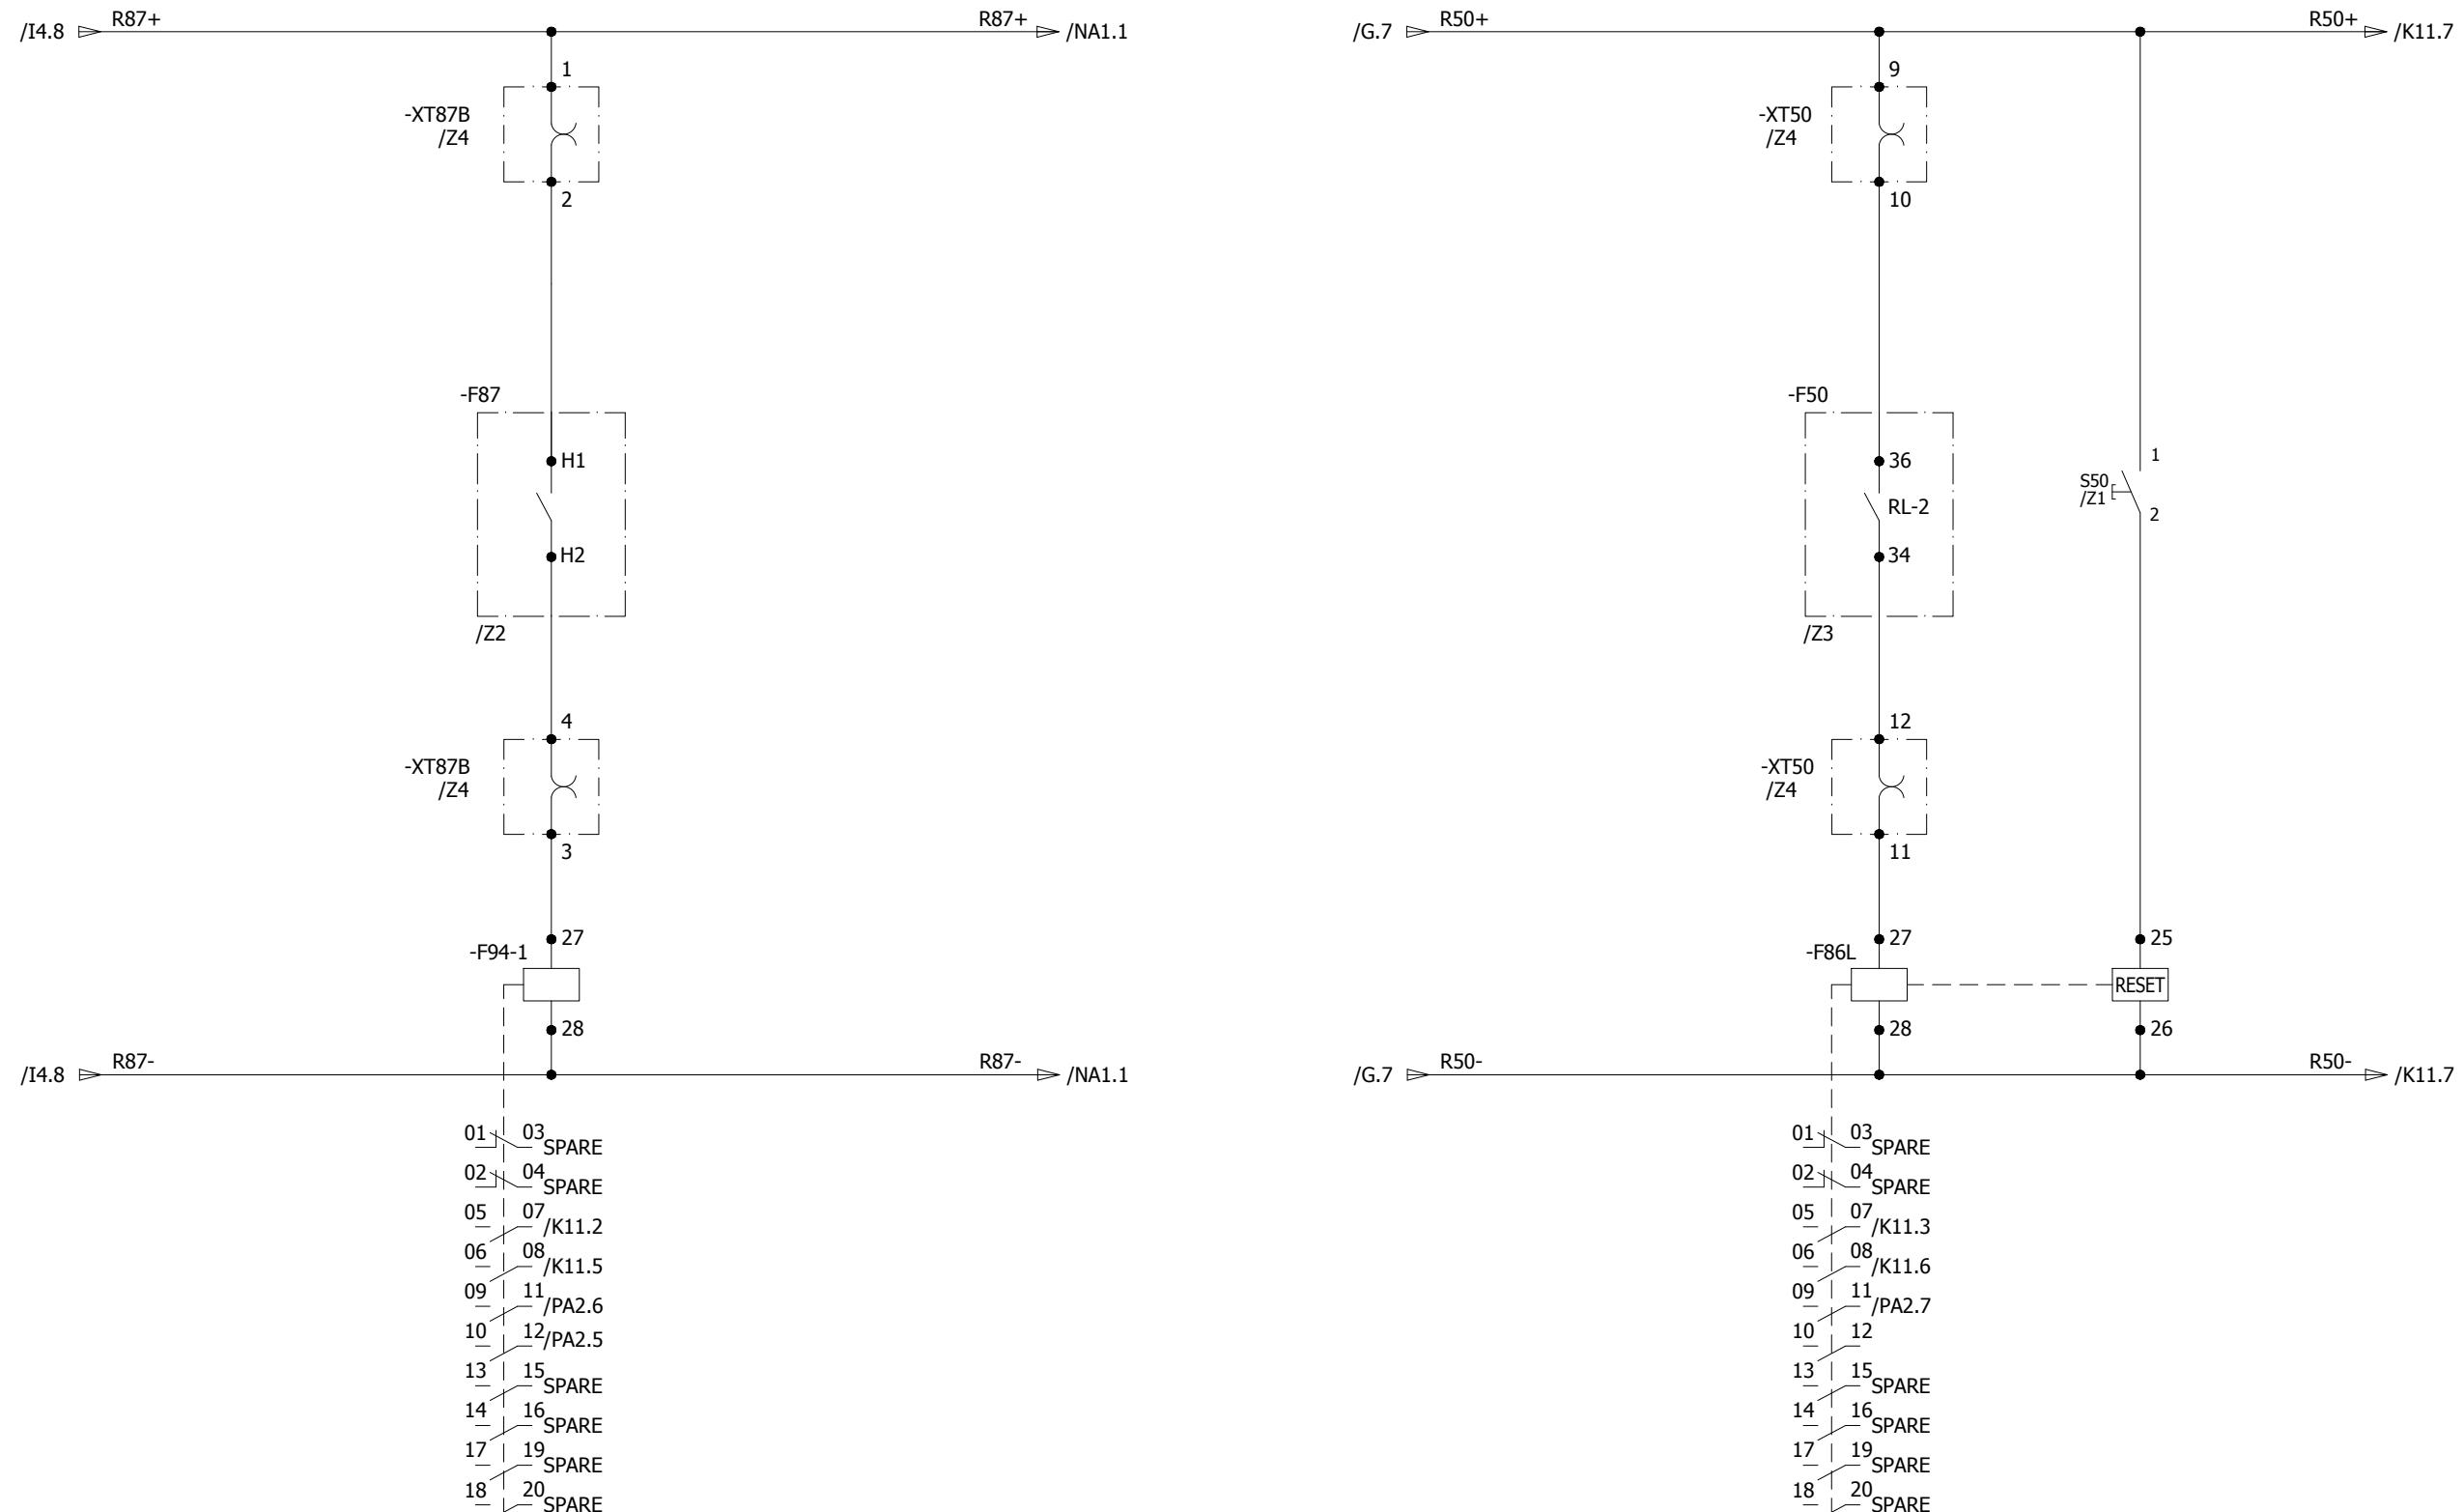

0	AS BUILT	20-11-2018	ASJ	Manufacturer  EPEPSOL 71-B Garden Block, New Garden Town, Lahore, Pakistan	Contractor  Grid Solutions A GE and Alstom joint venture	Client  NATIONAL TRANSMISSION & DISPATCH COMPANY LIMITED (NTDC-WAPDA)	Project 220kV/132kV GIS SUBSTATION GHAZI ROAD, LAHORE	Title 132kV LINE RELAY PANEL (=E10+RP3) PROTECTION TRIPS	Drawing no. P60194-E-ELR-SC-007		
REV.	DESCRIPTION	DATE	DRAWER						Project no. P-60194	Sheet type K1	Sheet no. 15
1	2	3	4	5	6	7	8				

1 2 3 4 5 6 7 8

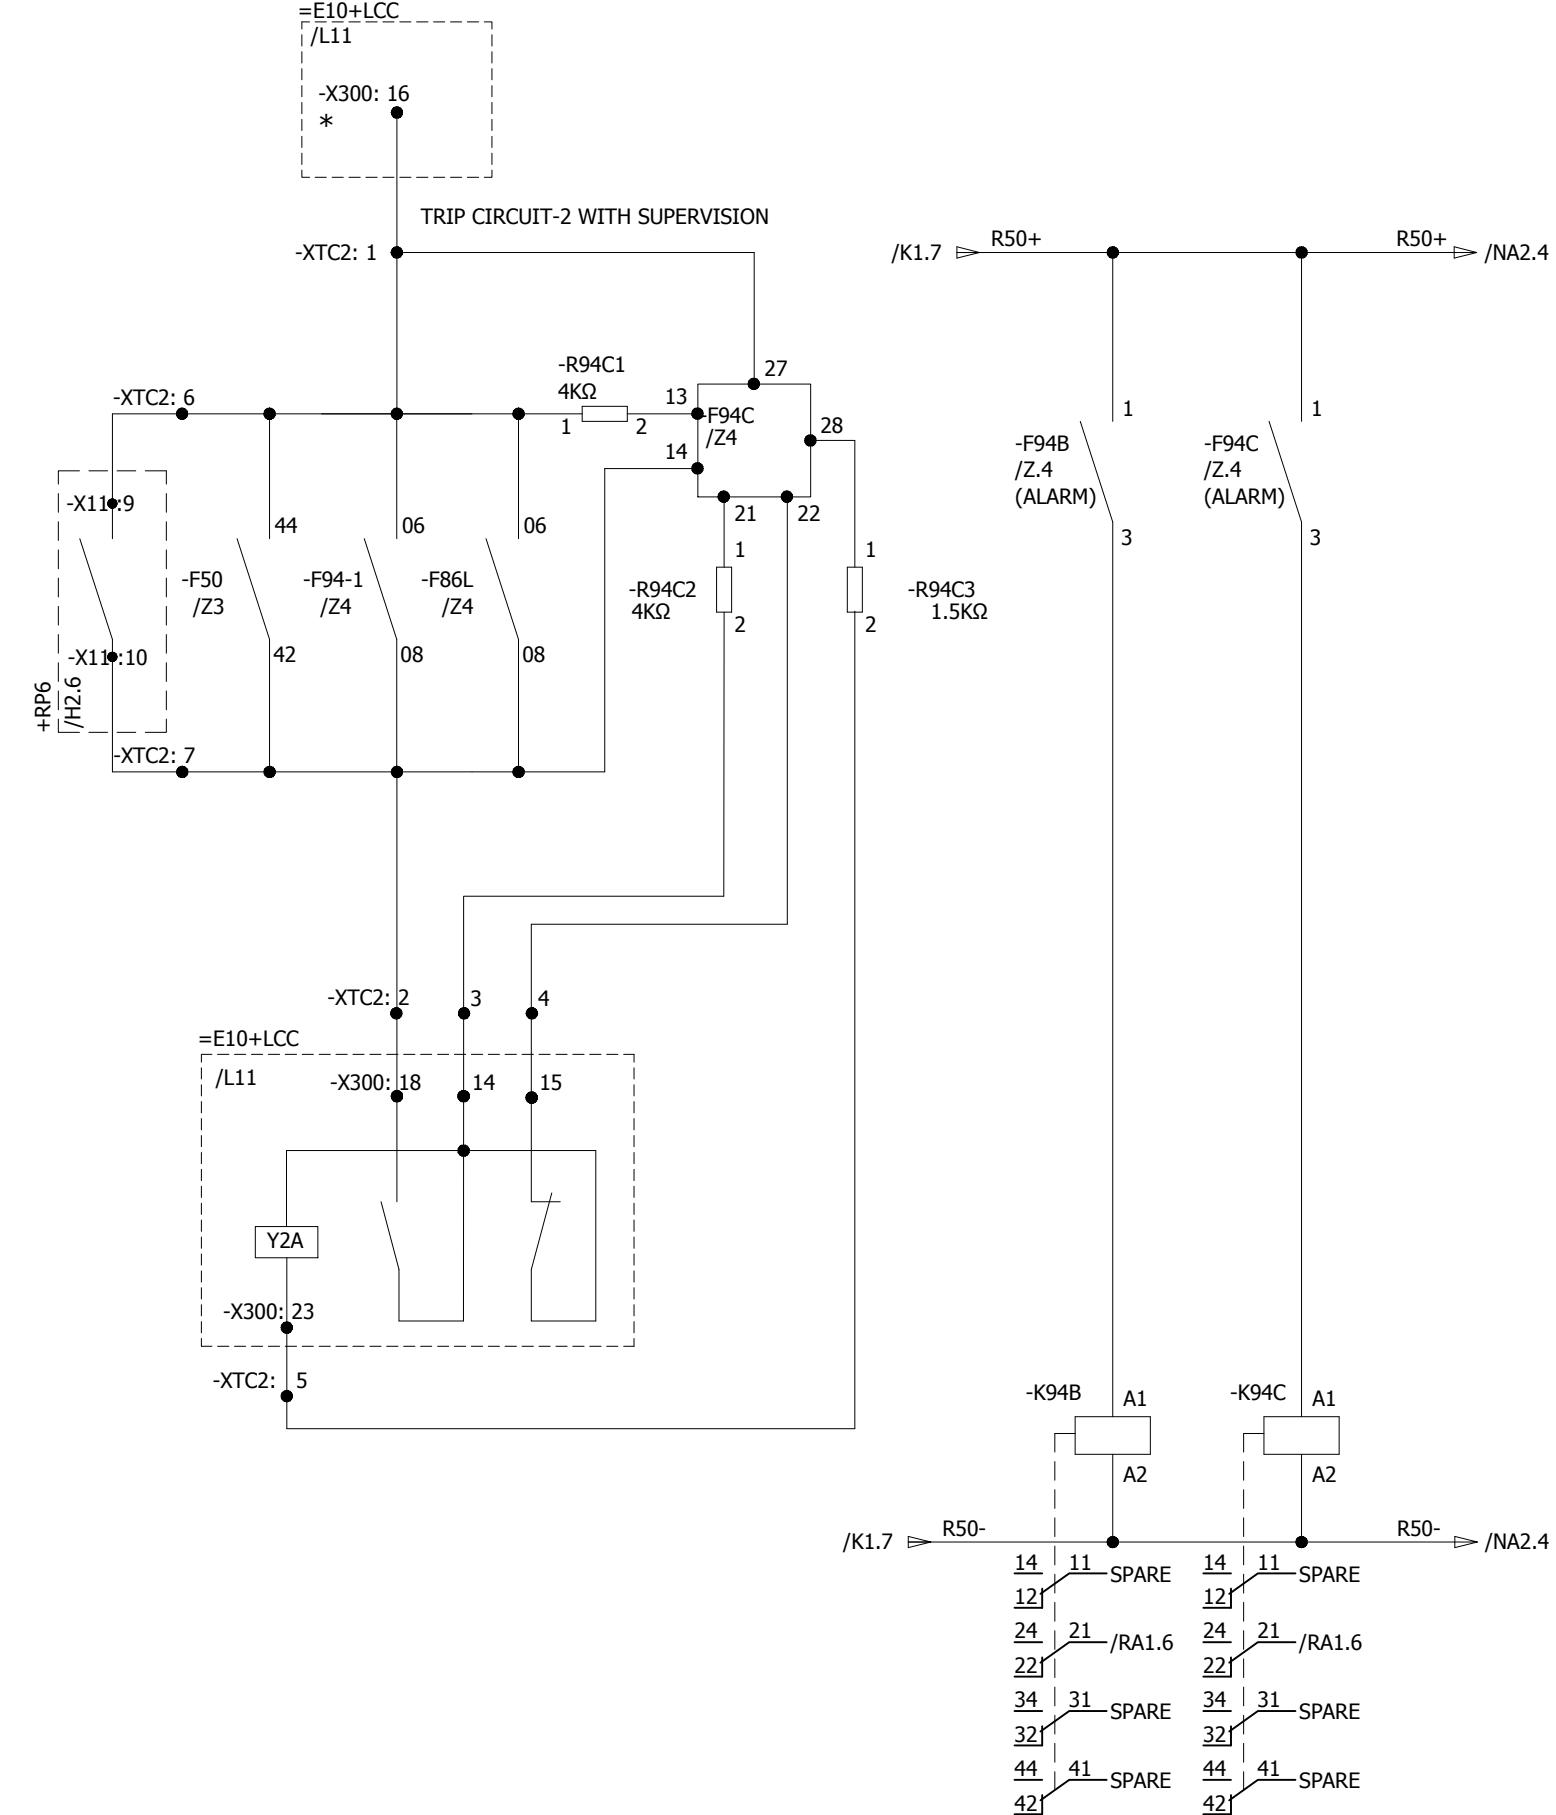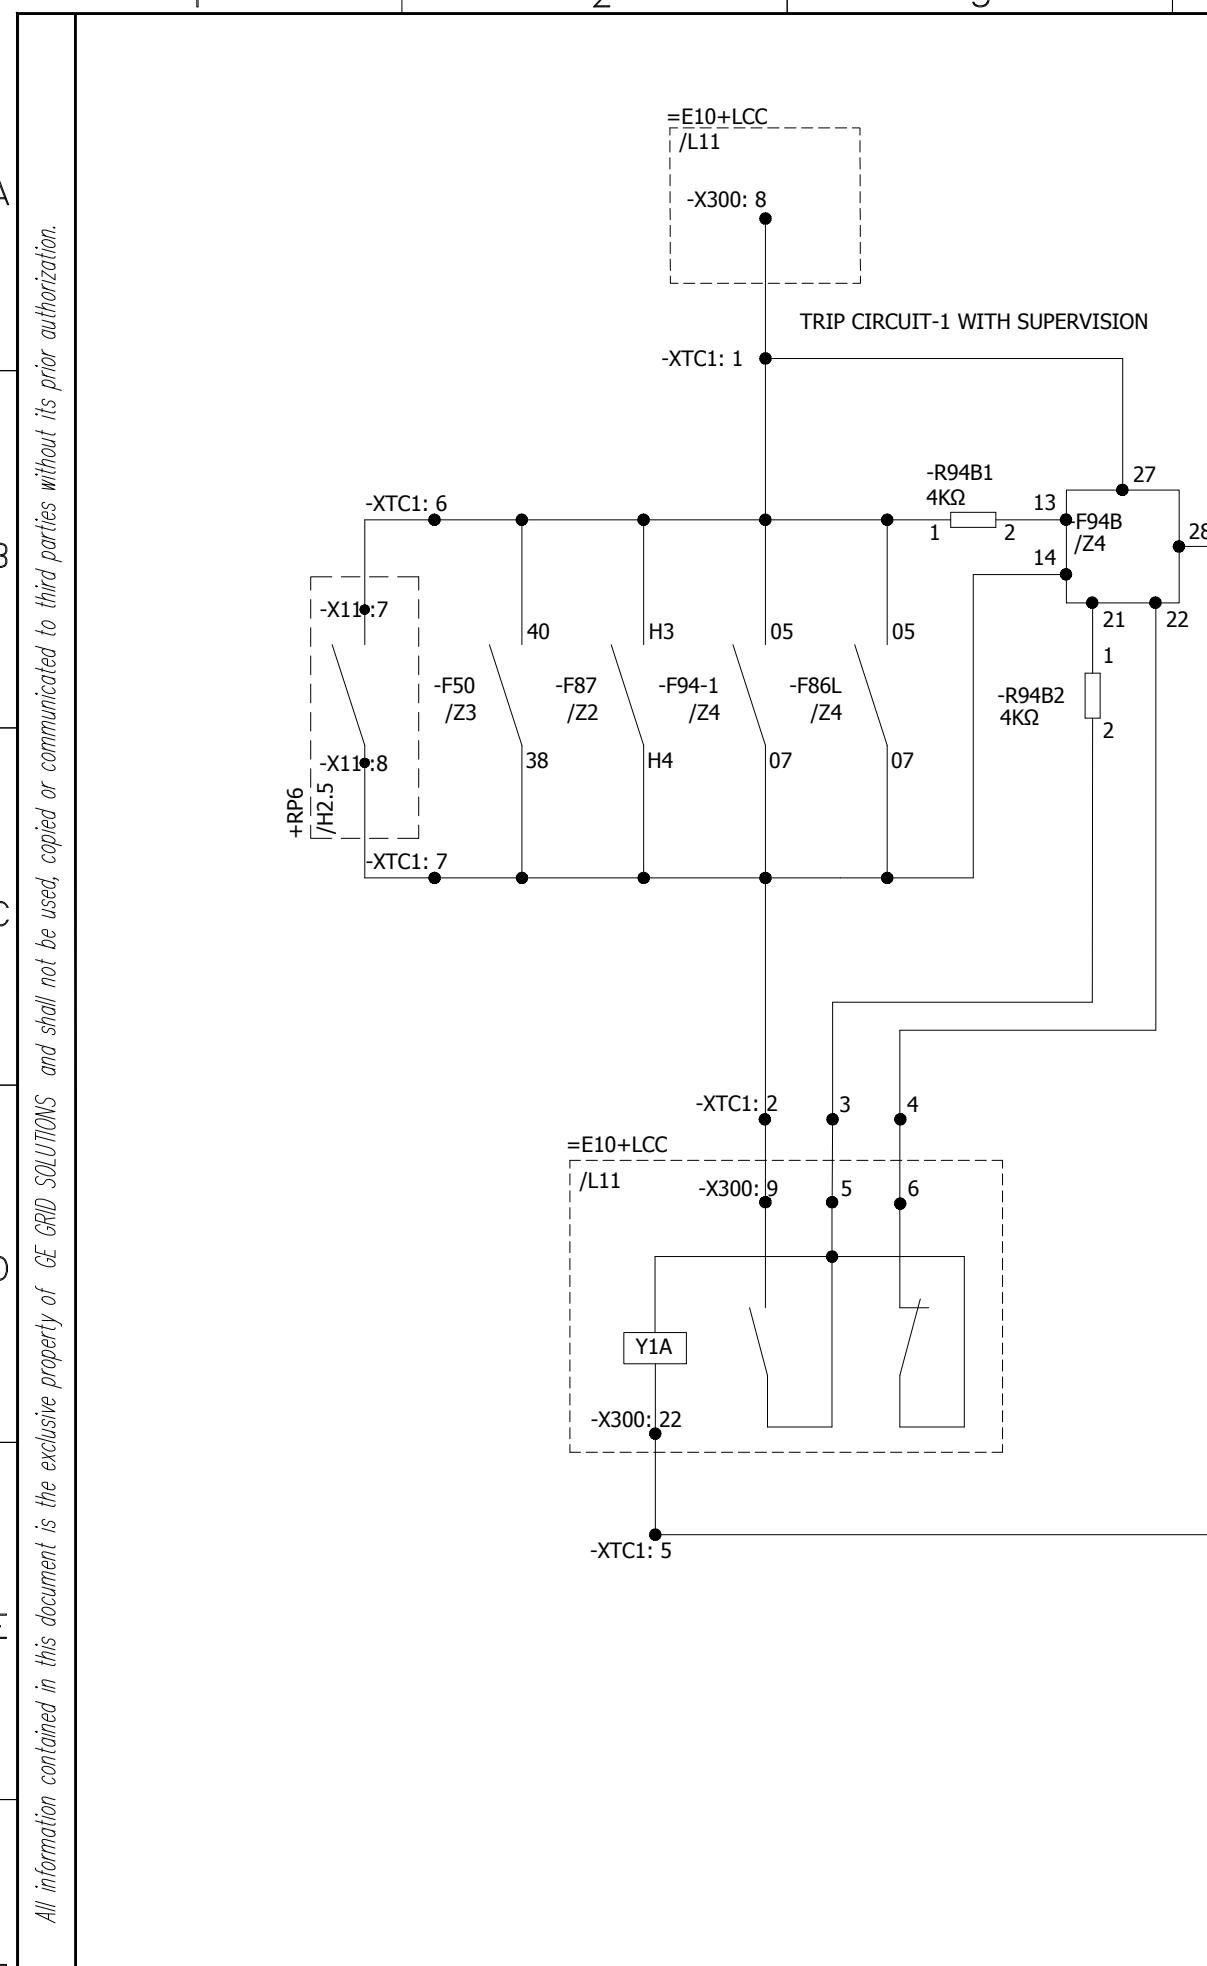


All information contained in this document is the exclusive property of GF GRAN SOLUTI<sup>NS</sup> and shall not be used, copied or communicated to third parties without its prior authorization.

## LINE DIFFERENTIAL PROTECTION

RED-PH TRIP      YELLOW-PH TRIP      BLUE-PH TRIP      ZONE-1 TRIP      ZONE-2 TRIP\ZONE-3 TRIP      POWER SWING DETECT      SWITCH ON TO FAULT      AUTORECLOSURE OPERATED      AUTORECLOSURE BLOCKED      LINE DIFF. RELAY FAULTY      R87+ DC SUPPLY MONITORING

+KDC1

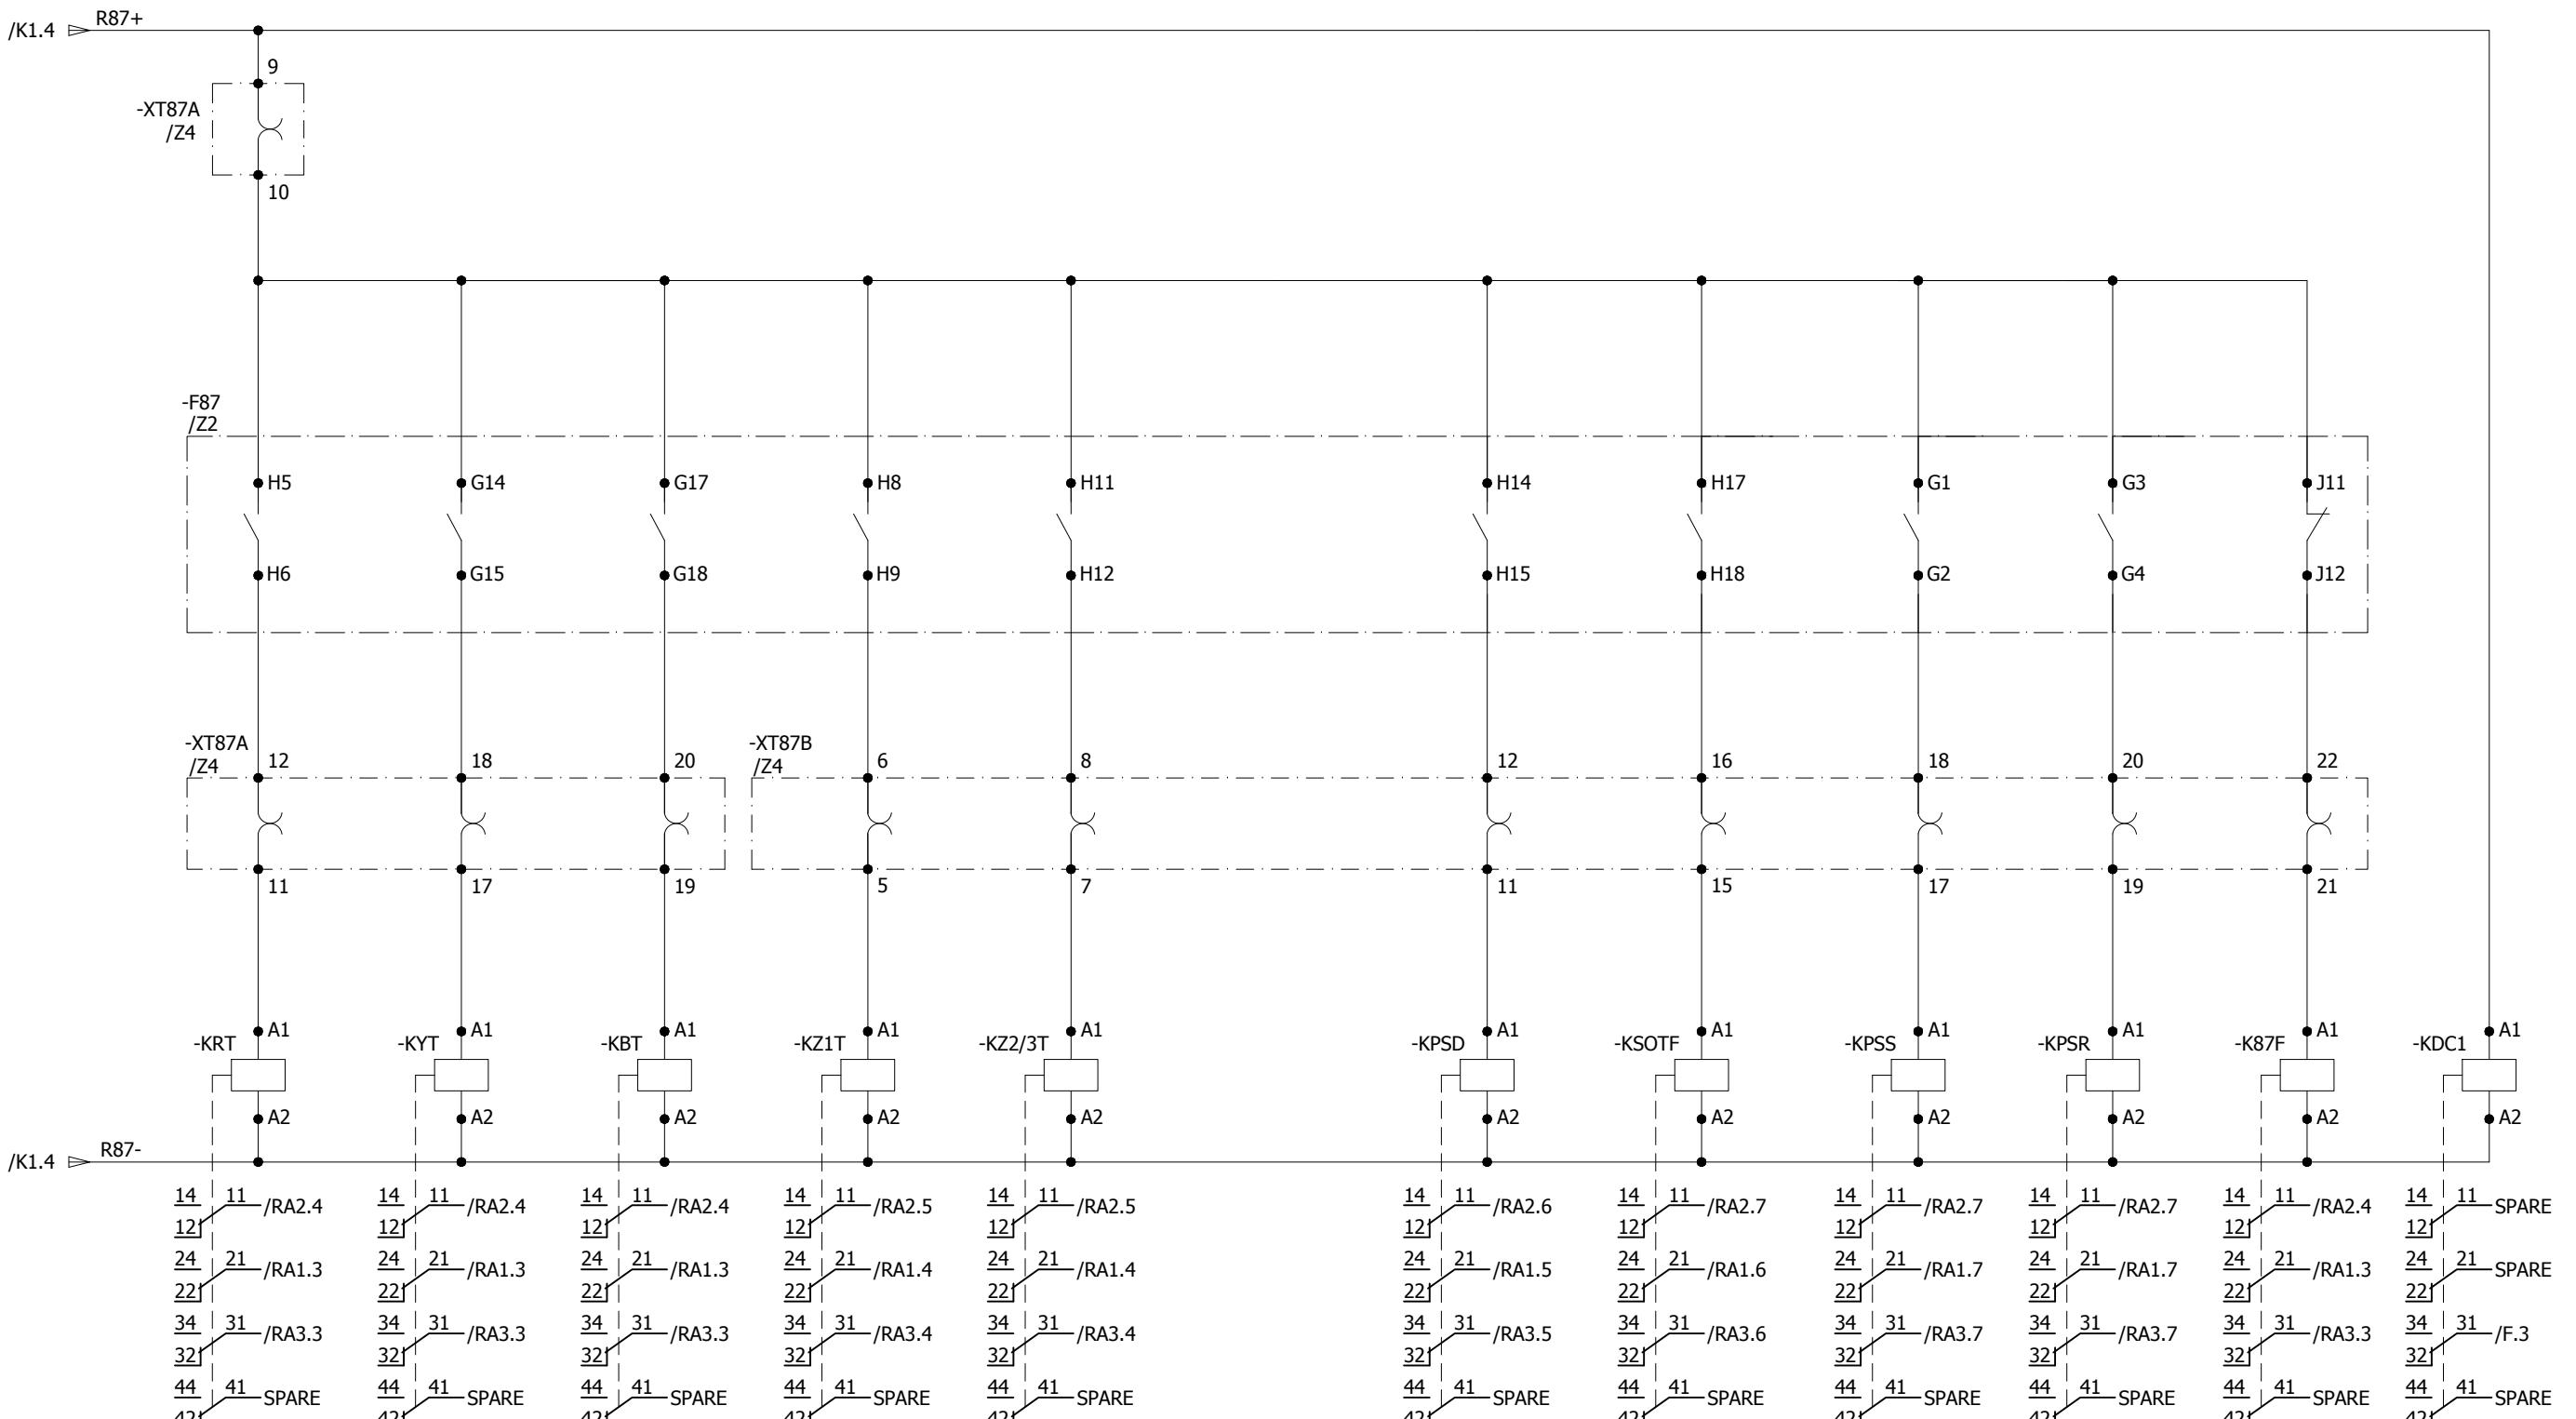


0	AS BUILT	20-11-2018	ASJ	Manufacturer  EPESOL 21-B Garden Block, New Garden Town, Lahore, Pakistan	Contractor  Grid Solutions A GE and Alstom joint venture	Client  NATIONAL TRANSMISSION & DISPATCH COMPANY LIMITED (NTDC-WAPDA)	Project 220kV/132kV GIS SUBSTATION GHAZI ROAD, LAHORE	Title 132kV LINE RELAY PANEL (=E10+RP3) SYSTEM ALARMS	Drawing no. P60194-E-ELR-SC-007	
REV.	DESCRIPTION	DATE	DRAWER					Project no. P-60194	Sheet type NA1	Sheet no. 17

O/C & E/F RELAY ALARMS  
R50+ DC SUPPLY MONITORING

O/C & E/F TRIP  
PROTECTION FAULTY +KDC2

/Z3

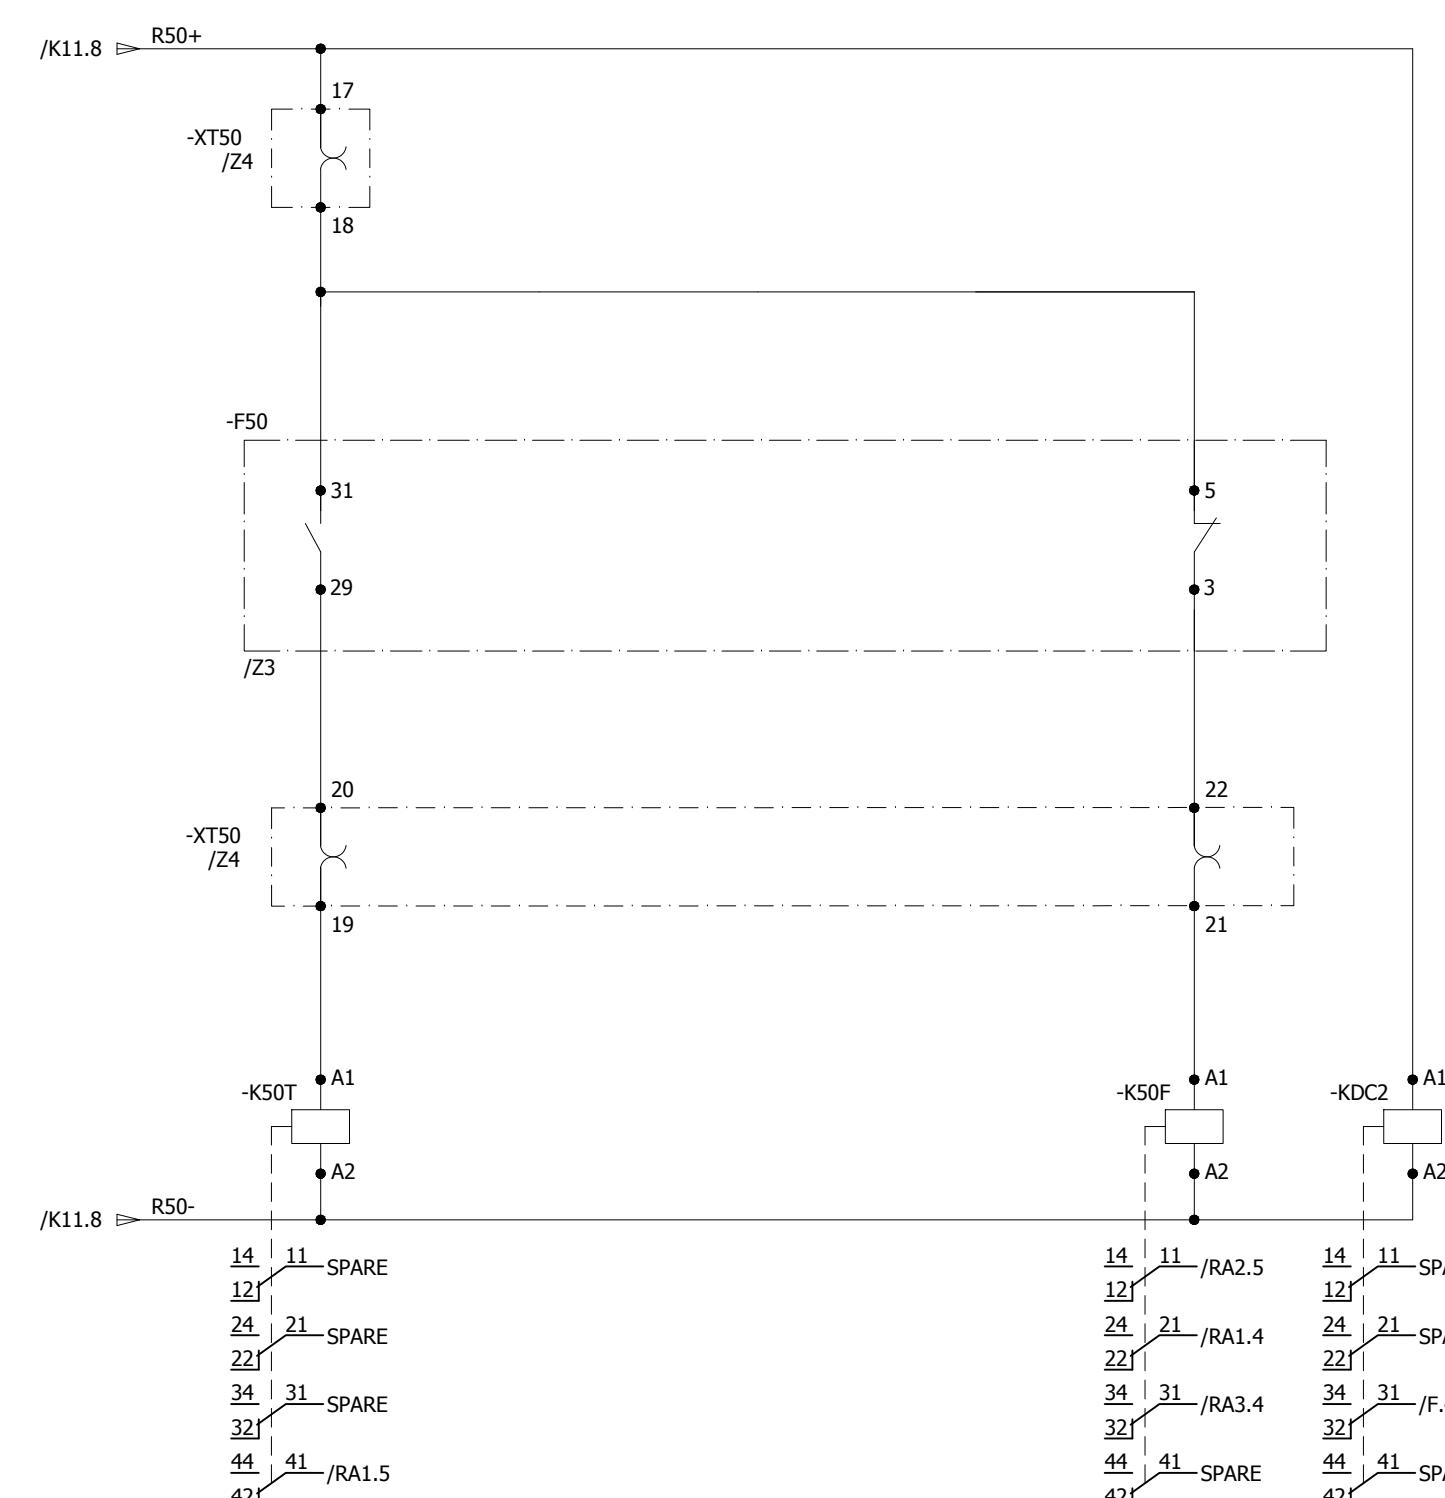

All information contained in this document is the exclusive property of GE GRID SOLUTIONS and shall not be used, copied or communicated to third parties without its prior authorization.

0	AS BUILT	20-11-2018	ASJ	Manufacturer <b>EPE SOL</b> 71-B Garden Block, New Garden Town, Lahore, Pakistan	Contractor <b>Grid Solutions</b> A GE and Alstom joint venture	Client <b>NATIONAL TRANSMISSION &amp; DISPATCH COMPANY LIMITED (NTDC-WAPDA)</b>	Project 220kV/132kV GIS SUBSTATION GHAZI ROAD, LAHORE	Title 132kV LINE RELAY PANEL (=E10+RP3) SYSTEM ALARMS	Drawing no. P60194-E-ELR-SC-007
									Project no. P-60194 Sheet type NA2 Sheet no. 18
REV.	DESCRIPTION	DATE	DRAWER						

All information contained in this document is the exclusive property of GE GRID SOLUTIONS and shall not be used, copied or communicated to third parties without its prior authorization.

A

B

C

D

E

F

A


B

C

D

E

F

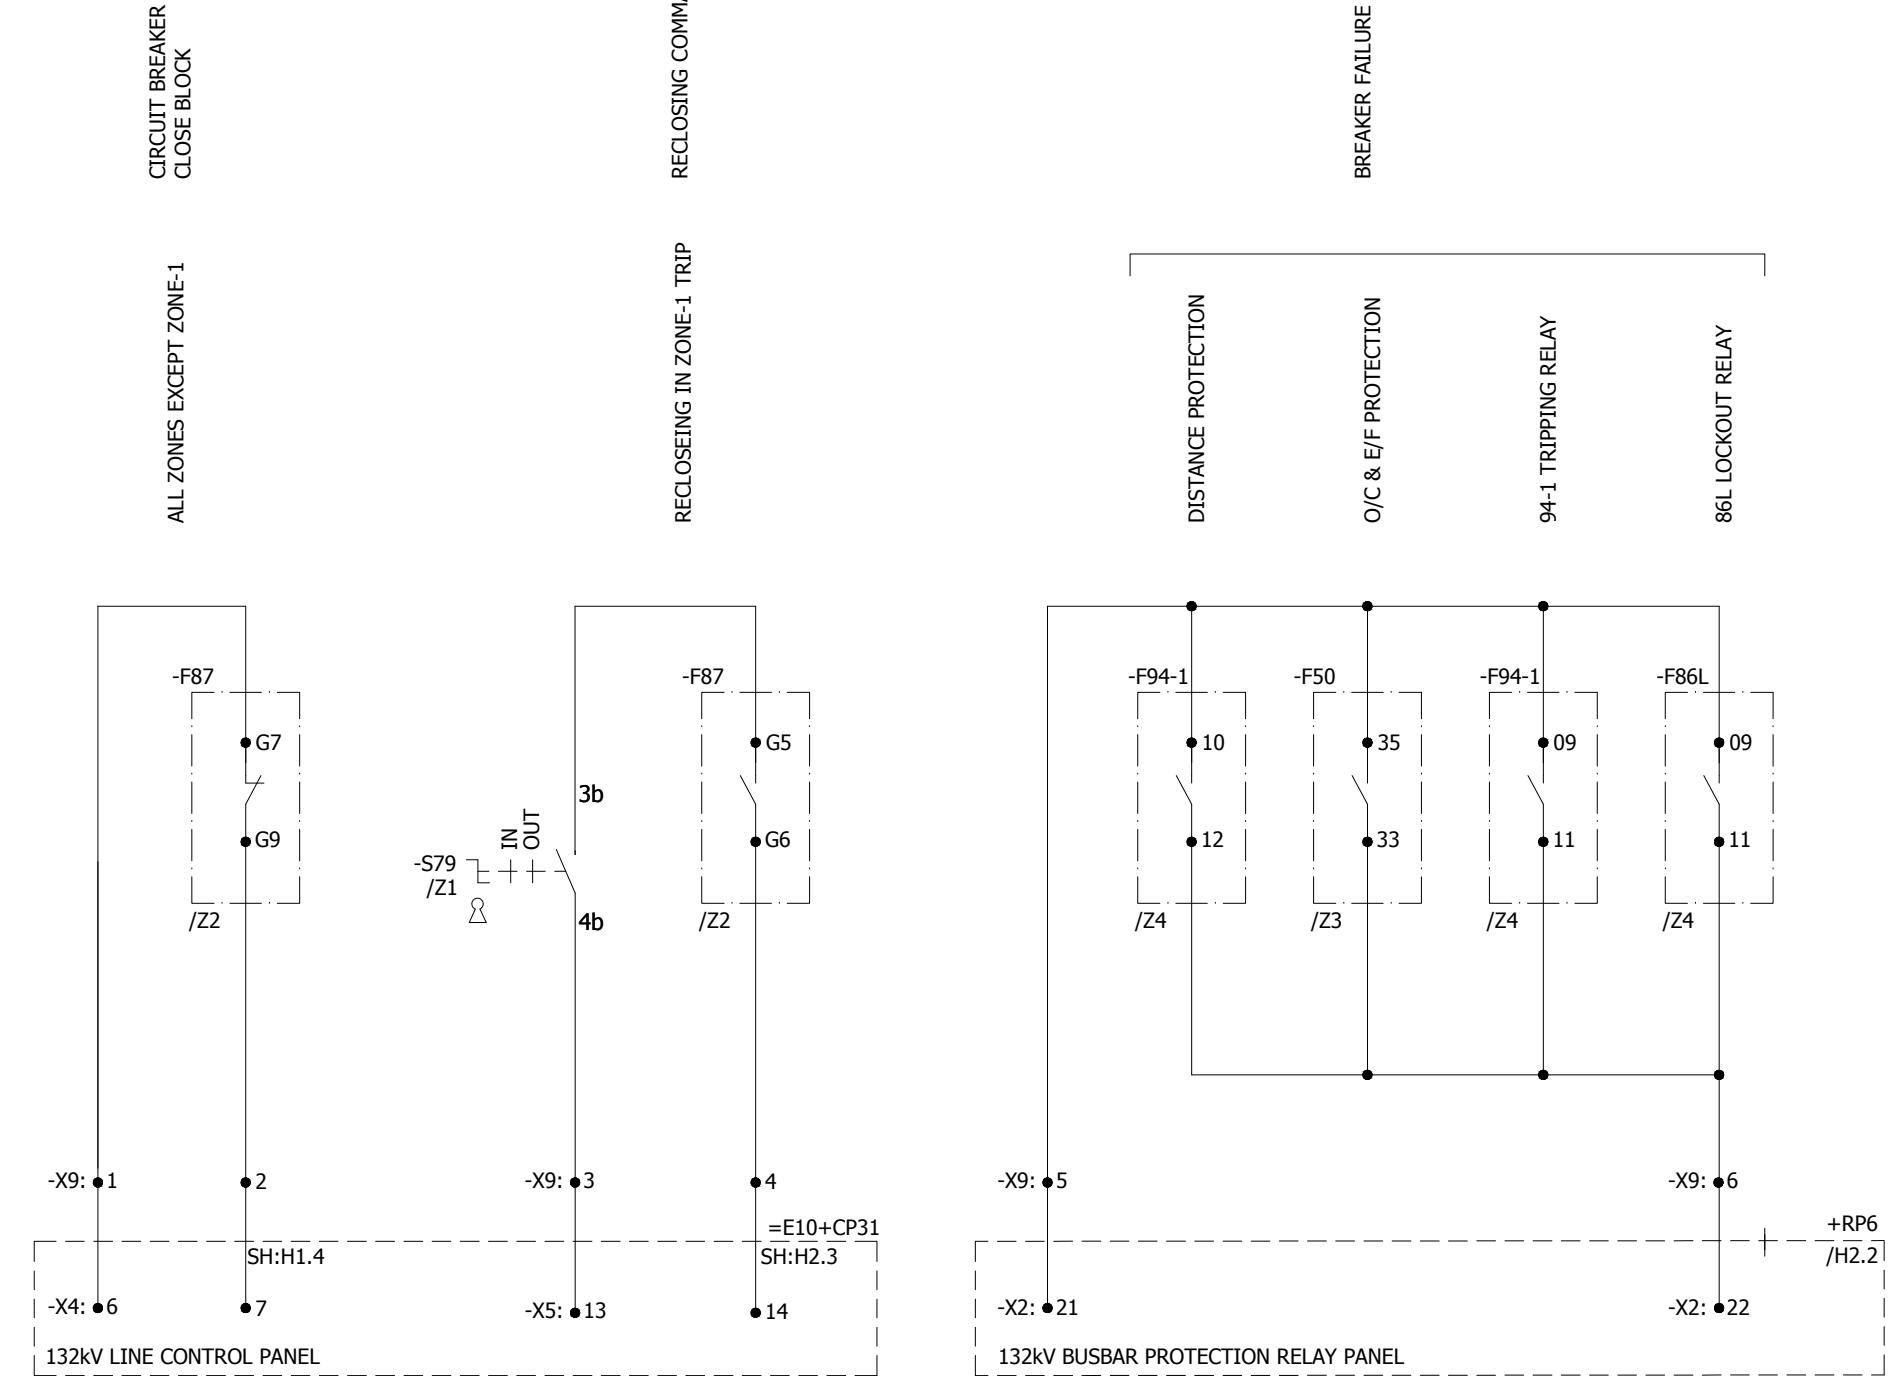

0	AS BUILT	20-11-2018	ASJ	Manufacturer <b>EPE SOL</b> 71-B Garden Block, New Garden Town, Lahore, Pakistan	Contractor <b>Grid Solutions</b> A GE and Alstom joint venture	Client <b>NATIONAL TRANSMISSION &amp; DISPATCH COMPANY LIMITED (NTDC-WAPDA)</b>	Project 220kV/132kV GIS SUBSTATION GHAZI ROAD, LAHORE	Title 132kV LINE RELAY PANEL (=E10+RP3) PROTECTION INTER-CIRCUITS	Drawing no. P60194-E-ELR-SC-007
REV.	DESCRIPTION	DATE	DRAWER						Project no. P-60194
									Sheet type PA2
									Sheet no. 19

All information contained in this document is the exclusive property of GE GRID SOLUTIONS and shall not be used, copied or communicated to third parties without its prior authorization.

A

DISTANCE PROTECTION

RED TRIP

DISTANCE PROTECTION

YELLOW POLE TRIP

DISTANCE PROTECTION

BLUE POLE TRIP

DISTANCE PROTECTION

ZONE-1 TRIP

DISTANCE PROTECTION

ZONE-2/3 TRIP

O/C &amp; E/F PROTECTION

OPERATED

POWER SWING

DETECTED

TRIP CIRCUIT-1

FAULTY

TRIP CIRCUIT-2

FAULTY

SWITCH ONTO FAULT


TRIP

AUTORECLOSURE

OPERATED

AUTORECLOSURE

BLOCKED

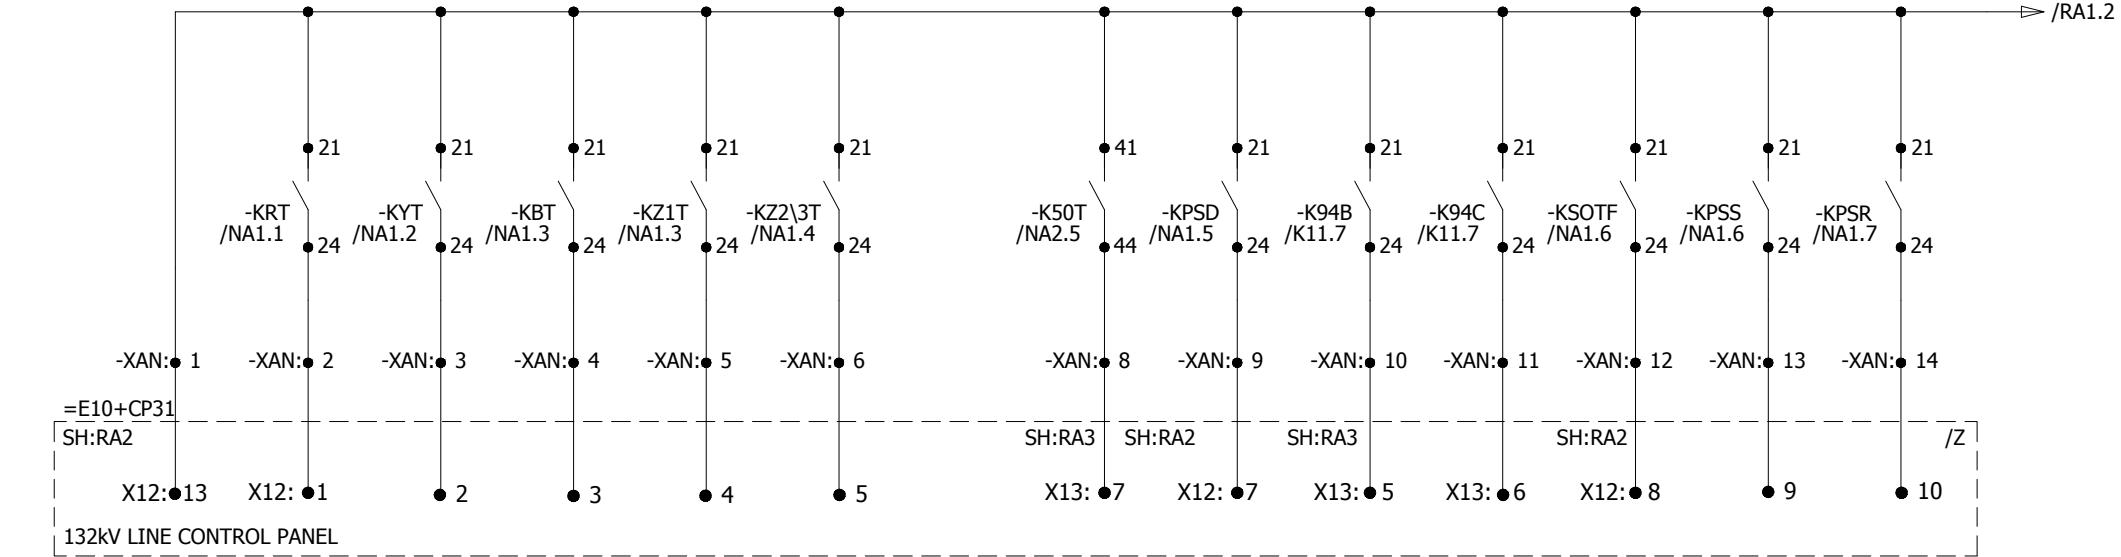

LINE DIFFERENTIAL

RELAY FAULTY

BUS VT SECONDARY CIRCUIT


MCB UNHEALTHY

O/C &amp; E/F PROTECTION

RELAY FAULTY

LINE RELAY PANEL  
230VAC CIRCUIT/SUPPLY FAULTYLINE RELAY PANEL  
110VDC CIRCUIT/SUPPLY FAULTY

/RA1.7

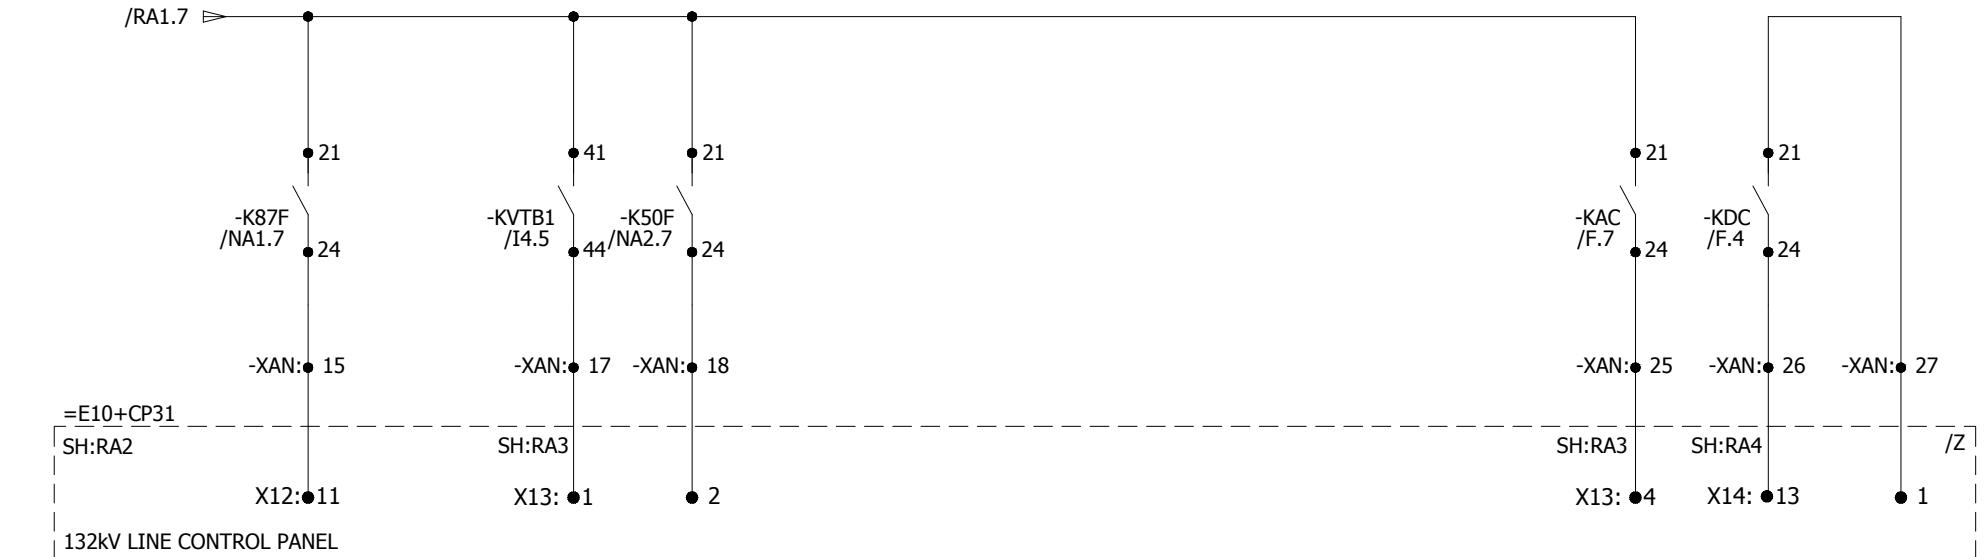

0	AS BUILT	20-11-2018	ASJ	Manufacturer EPESOL 71-B Garden Block, New Garden Town, Lahore, Pakistan	Contractor Grid Solutions A GE and Alstom joint venture	Client NATIONAL TRANSMISSION & DISPATCH COMPANY LIMITED (NTDC-WAPDA)	Project 220kV/132kV GIS SUBSTATION GHAZI ROAD, LAHORE	Title 132kV LINE RELAY PANEL (=E10+RP3) ANNUNCIATION CIRCUIT	Drawing no. P60194-E-ELR-SC-007	
REV.	DESCRIPTION	DATE	DRAWER					Project no. P-60194	Sheet type RA1	Sheet no. 20

1

2

3

4

5

6

7

8

All information contained in this document is the exclusive property of GE GRID SOLUTIONS and shall not be used, copied or communicated to third parties without its prior authorization.

0	AS BUILT	20-11-2018	ASJ	Manufacturer  EPE SOL 71-B Garden Block, New Garden Town, Lahore, Pakistan	Contractor  Grid Solutions A GE and Alstom joint venture	Client  NATIONAL TRANSMISSION & DISPATCH COMPANY LIMITED (NTDC-WAPDA)	Project 220kV/132kV GIS SUBSTATION GHAZI ROAD, LAHORE	Title 132kV LINE RELAY PANEL (=E10+RP3) EVENT & FAULT RECORDER CIRCUITS	Drawing no. P60194-E-ELR-SC-007	
REV.	DESCRIPTION	DATE	DRAWER					Project no. P-60194	Sheet type RA2	Sheet no. 21

DISTANCE PROTECTION  
GENERAL TRIPO/C & E/F PROTECTION  
TRIPDISTANCE PROTECTION  
RED TRIPDISTANCE PROTECTION  
YELLOW POLE TRIPDISTANCE PROTECTION  
BLUE POLE TRIPDISTANCE PROTECTION  
ZONE-1 TRIPDISTANCE PROTECTION  
ZONE-2/3 TRIPPOWER SWING  
DETECTEDSWITCH ONTO FAULT  
TRIPAUTORECLOSURE  
OPERATEDAUTORECLOSURE  
BLOCKED

/RA2.3

-F87

-Z2

-F50

-Z3

LINE DIFFERENTIAL  
RELAY FAULTBUS VT SECONDARY CIRCUIT  
MCB UNHEALTHYO/C & E/F PROTECTION  
RELAY FAULT

/RA2.8

LINE RELAY PANEL  
230VAC CIRCUIT/SUPPLY FAULTYLINE RELAY PANEL  
110VDC CIRCUIT/SUPPLY FAULTY

-XFR:• 1

-XFR:• 2

-XFR:• 3

-XEV:• 15

-XEV:• 17

-XEV:• 18

-XEV:• 25

-XEV:• 26

-X

-X

1

2

3

4

5

6

7


8

All information contained in this document is the exclusive property of GE GRID SOLUTIONS and shall not be used, copied or communicated to third parties without its prior authorization.

All information contained in this document is the exclusive property of GE GRID SOLUTIONS and shall not be used, copied or communicated to third parties without its prior authorization.


A

A

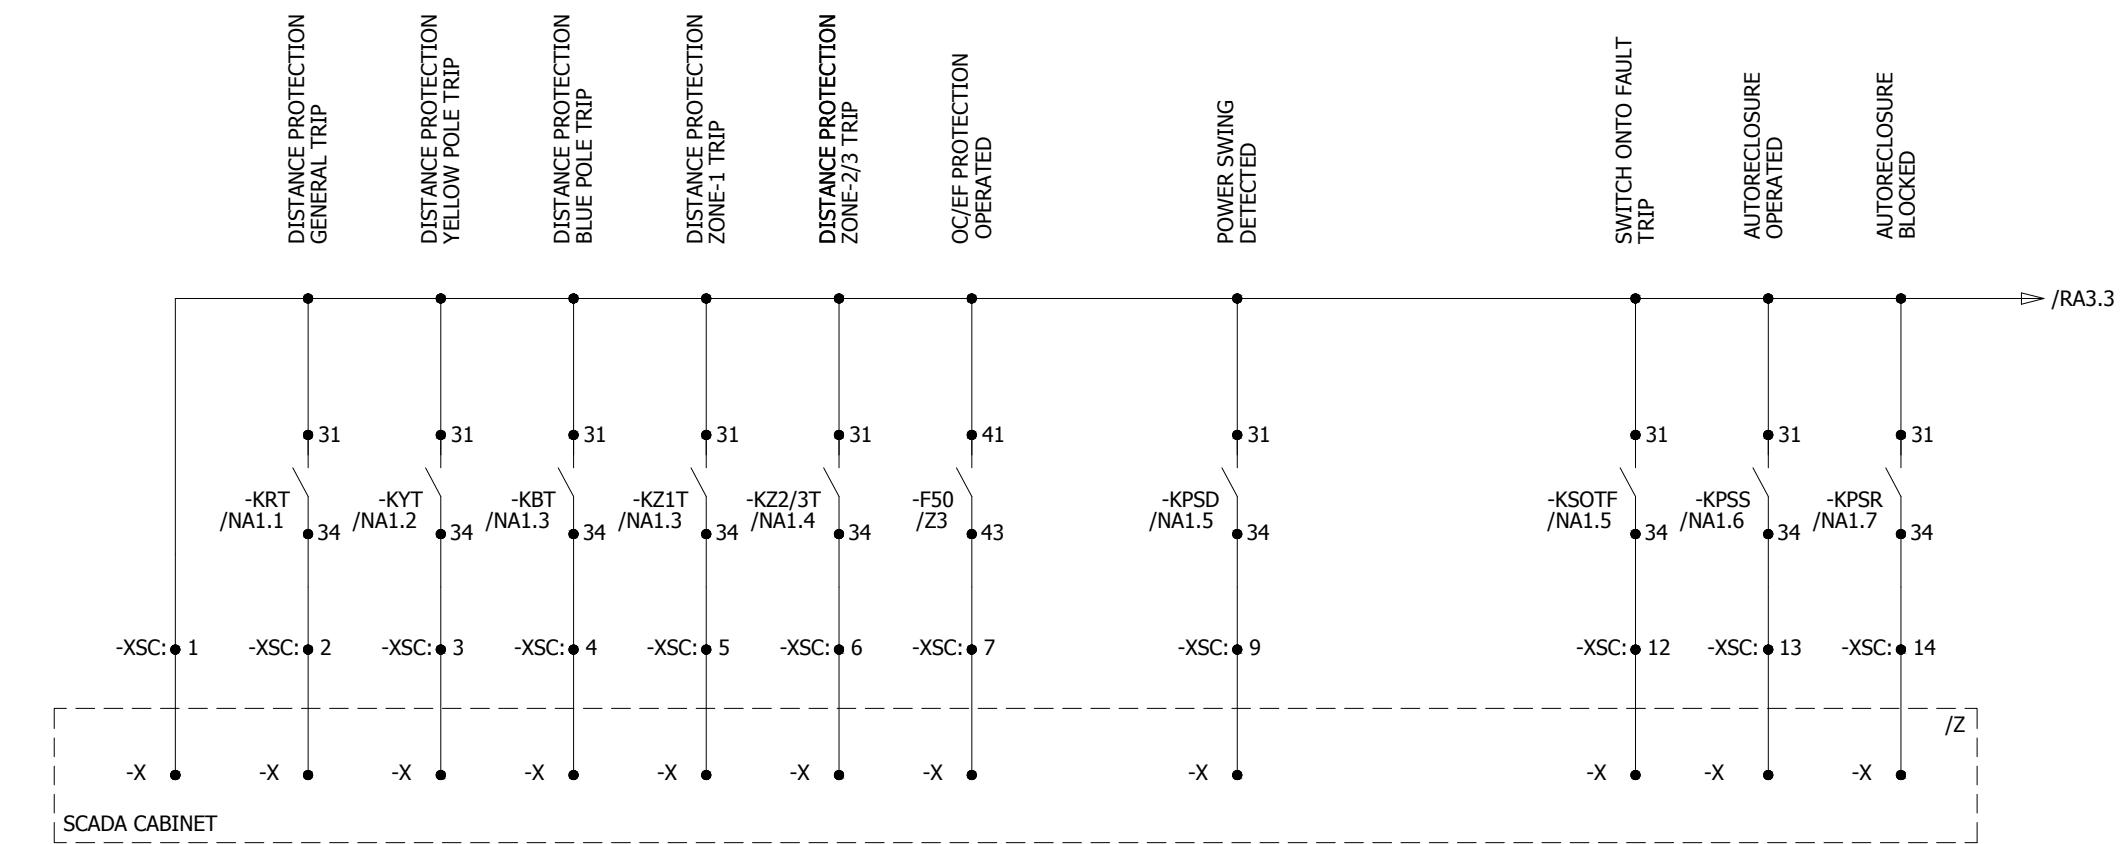

B

B

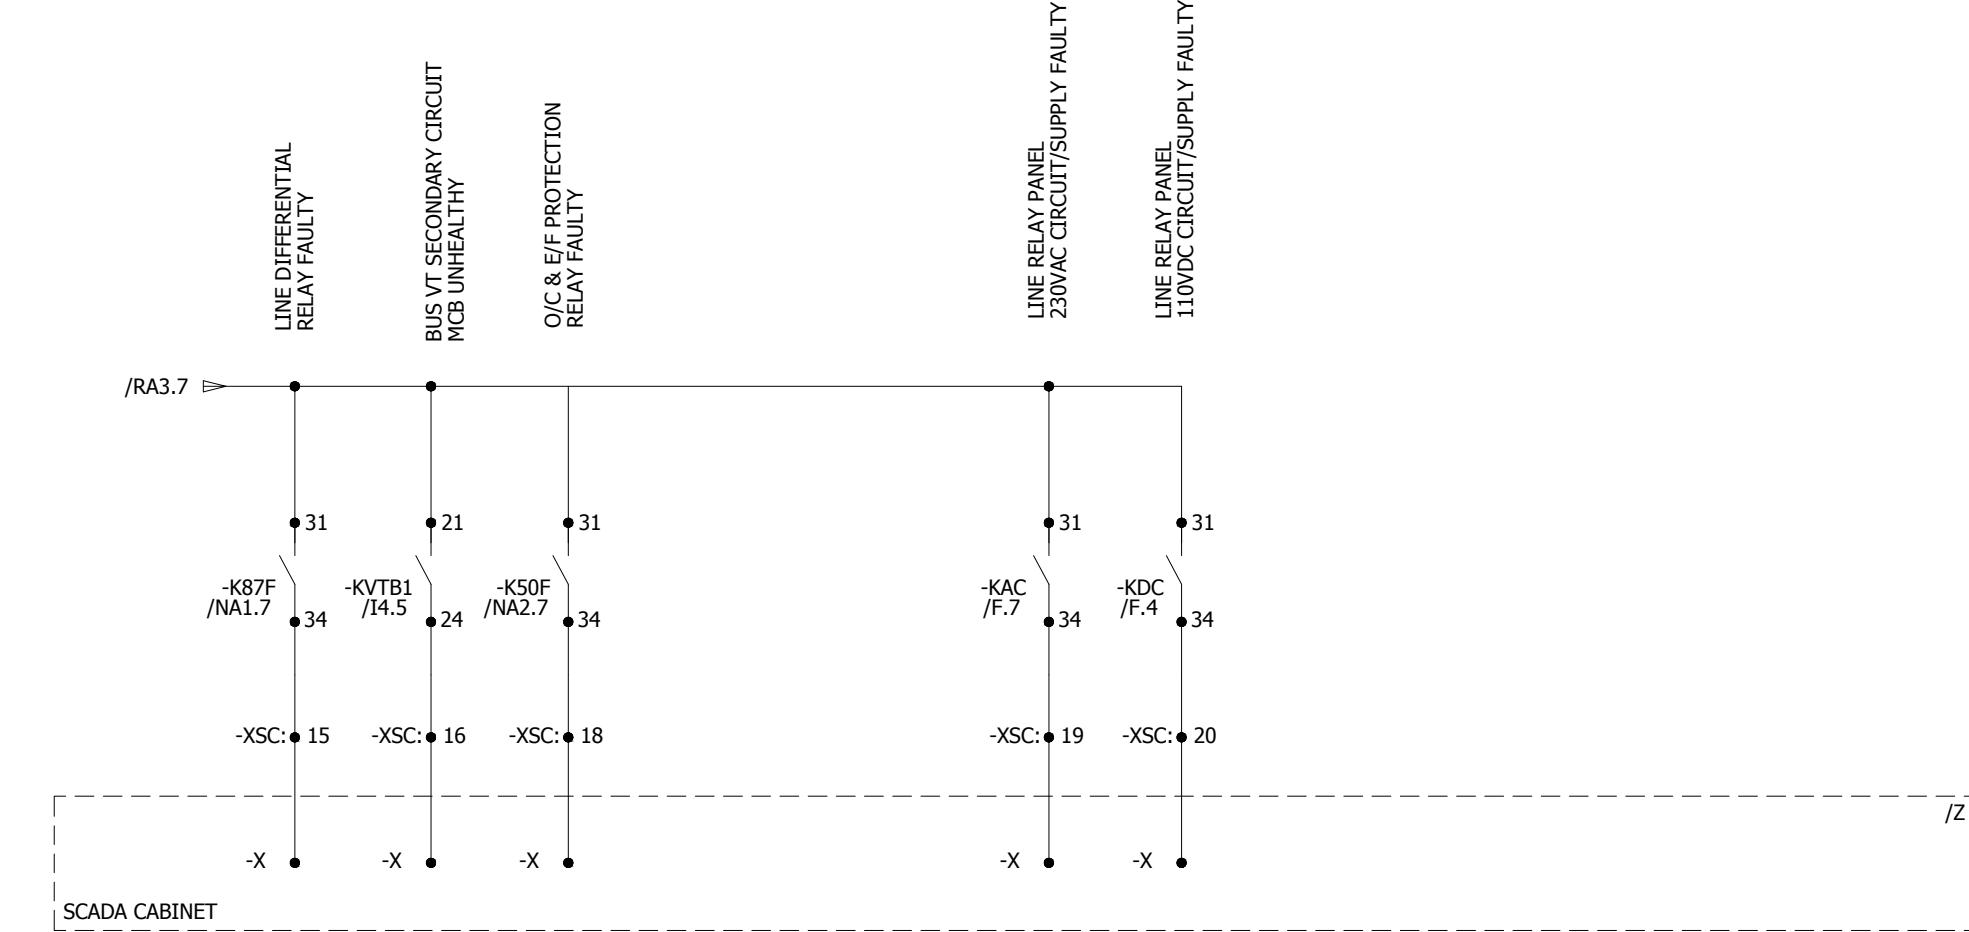

C


C

D

D

E

E

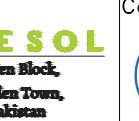0	AS BUILT	20-11-2018	ASJ	Manufacturer  EPESOL 71-B Garden Block, New Garden Town, Lahore, Pakistan	Contractor  Grid Solutions A GE and Alstom joint venture	Client  NATIONAL TRANSMISSION & DISPATCH COMPANY LIMITED (NTDC-WAPDA)	Project 220kV/132kV GIS SUBSTATION GHAZI ROAD, LAHORE	Title 132kV LINE RELAY PANEL (=E10+RP3) SCADA CIRCUIT	Drawing no. P60194-E-ELR-SC-007		
REV.	DESCRIPTION	DATE	DRAWER						Project no. P-60194	Sheet type RA3	Sheet no. 22
1	2	3	4	5	6	7	8				

1

2

3

4


5

6


7

8


All information contained in this document is the exclusive property of GE GRID SOLUTIONS and shall not be used, copied or communicated to third parties without its prior authorization.

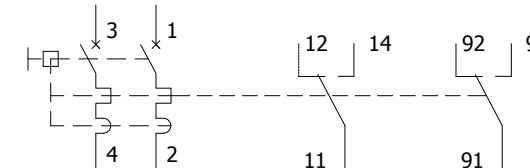


-F101	D.2	F.6	
-F102	D.4	F.6	
-F103	D.6	F.6	
-F201	E.5	F.2	
-F202	E.5	F.2	
-F203	E.6	F.2	
-F204	E.7	F.3	

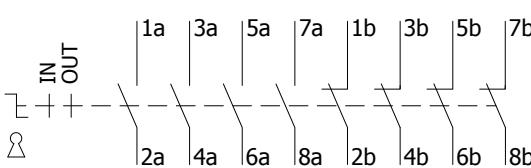


-S79				I1.2	PA2.4	
------	--	--	--	------	-------	--

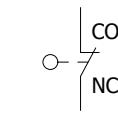


-S100	D.3
-------	-----

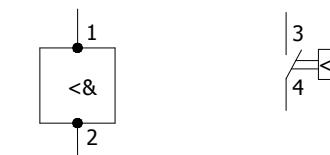


-B100	D.4	D.5
-------	-----	-----

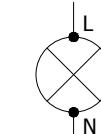


-H100	D.3
-H200	F.4

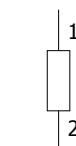

-R100	D.5
-------	-----

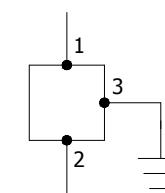

-X100	D.7
-------	-----

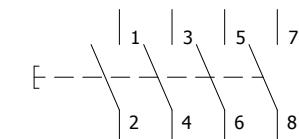

-S50	K1.7		
------	------	--	--

A

A

B

B

C

C

D

D

E

E

F

F

0	AS BUILT	20.11.2018	ASJ	Manufacturer  EPESOL 71-B Garden Block, New Garden Town, Lahore, Pakistan	Contractor  Grid Solutions A GE and Alstom joint venture	Client  NATIONAL TRANSMISSION & DISPATCH COMPANY LIMITED (NTDC-WAPDA)	Project 220kV/132kV GIS SUBSTATION GHAZI ROAD, LAHORE	Title 132kV LINE RELAY PANEL (=E10+RP3) COMPONENT DIAGRAM	Drawing no. P60194-E-ELR-SC-002
REV.	DESCRIPTION	DATE	DRAWER						Project no. P-60194
									Sheet type Z1
									Sheet no. 23

1

2

3


4


5

6

7


8

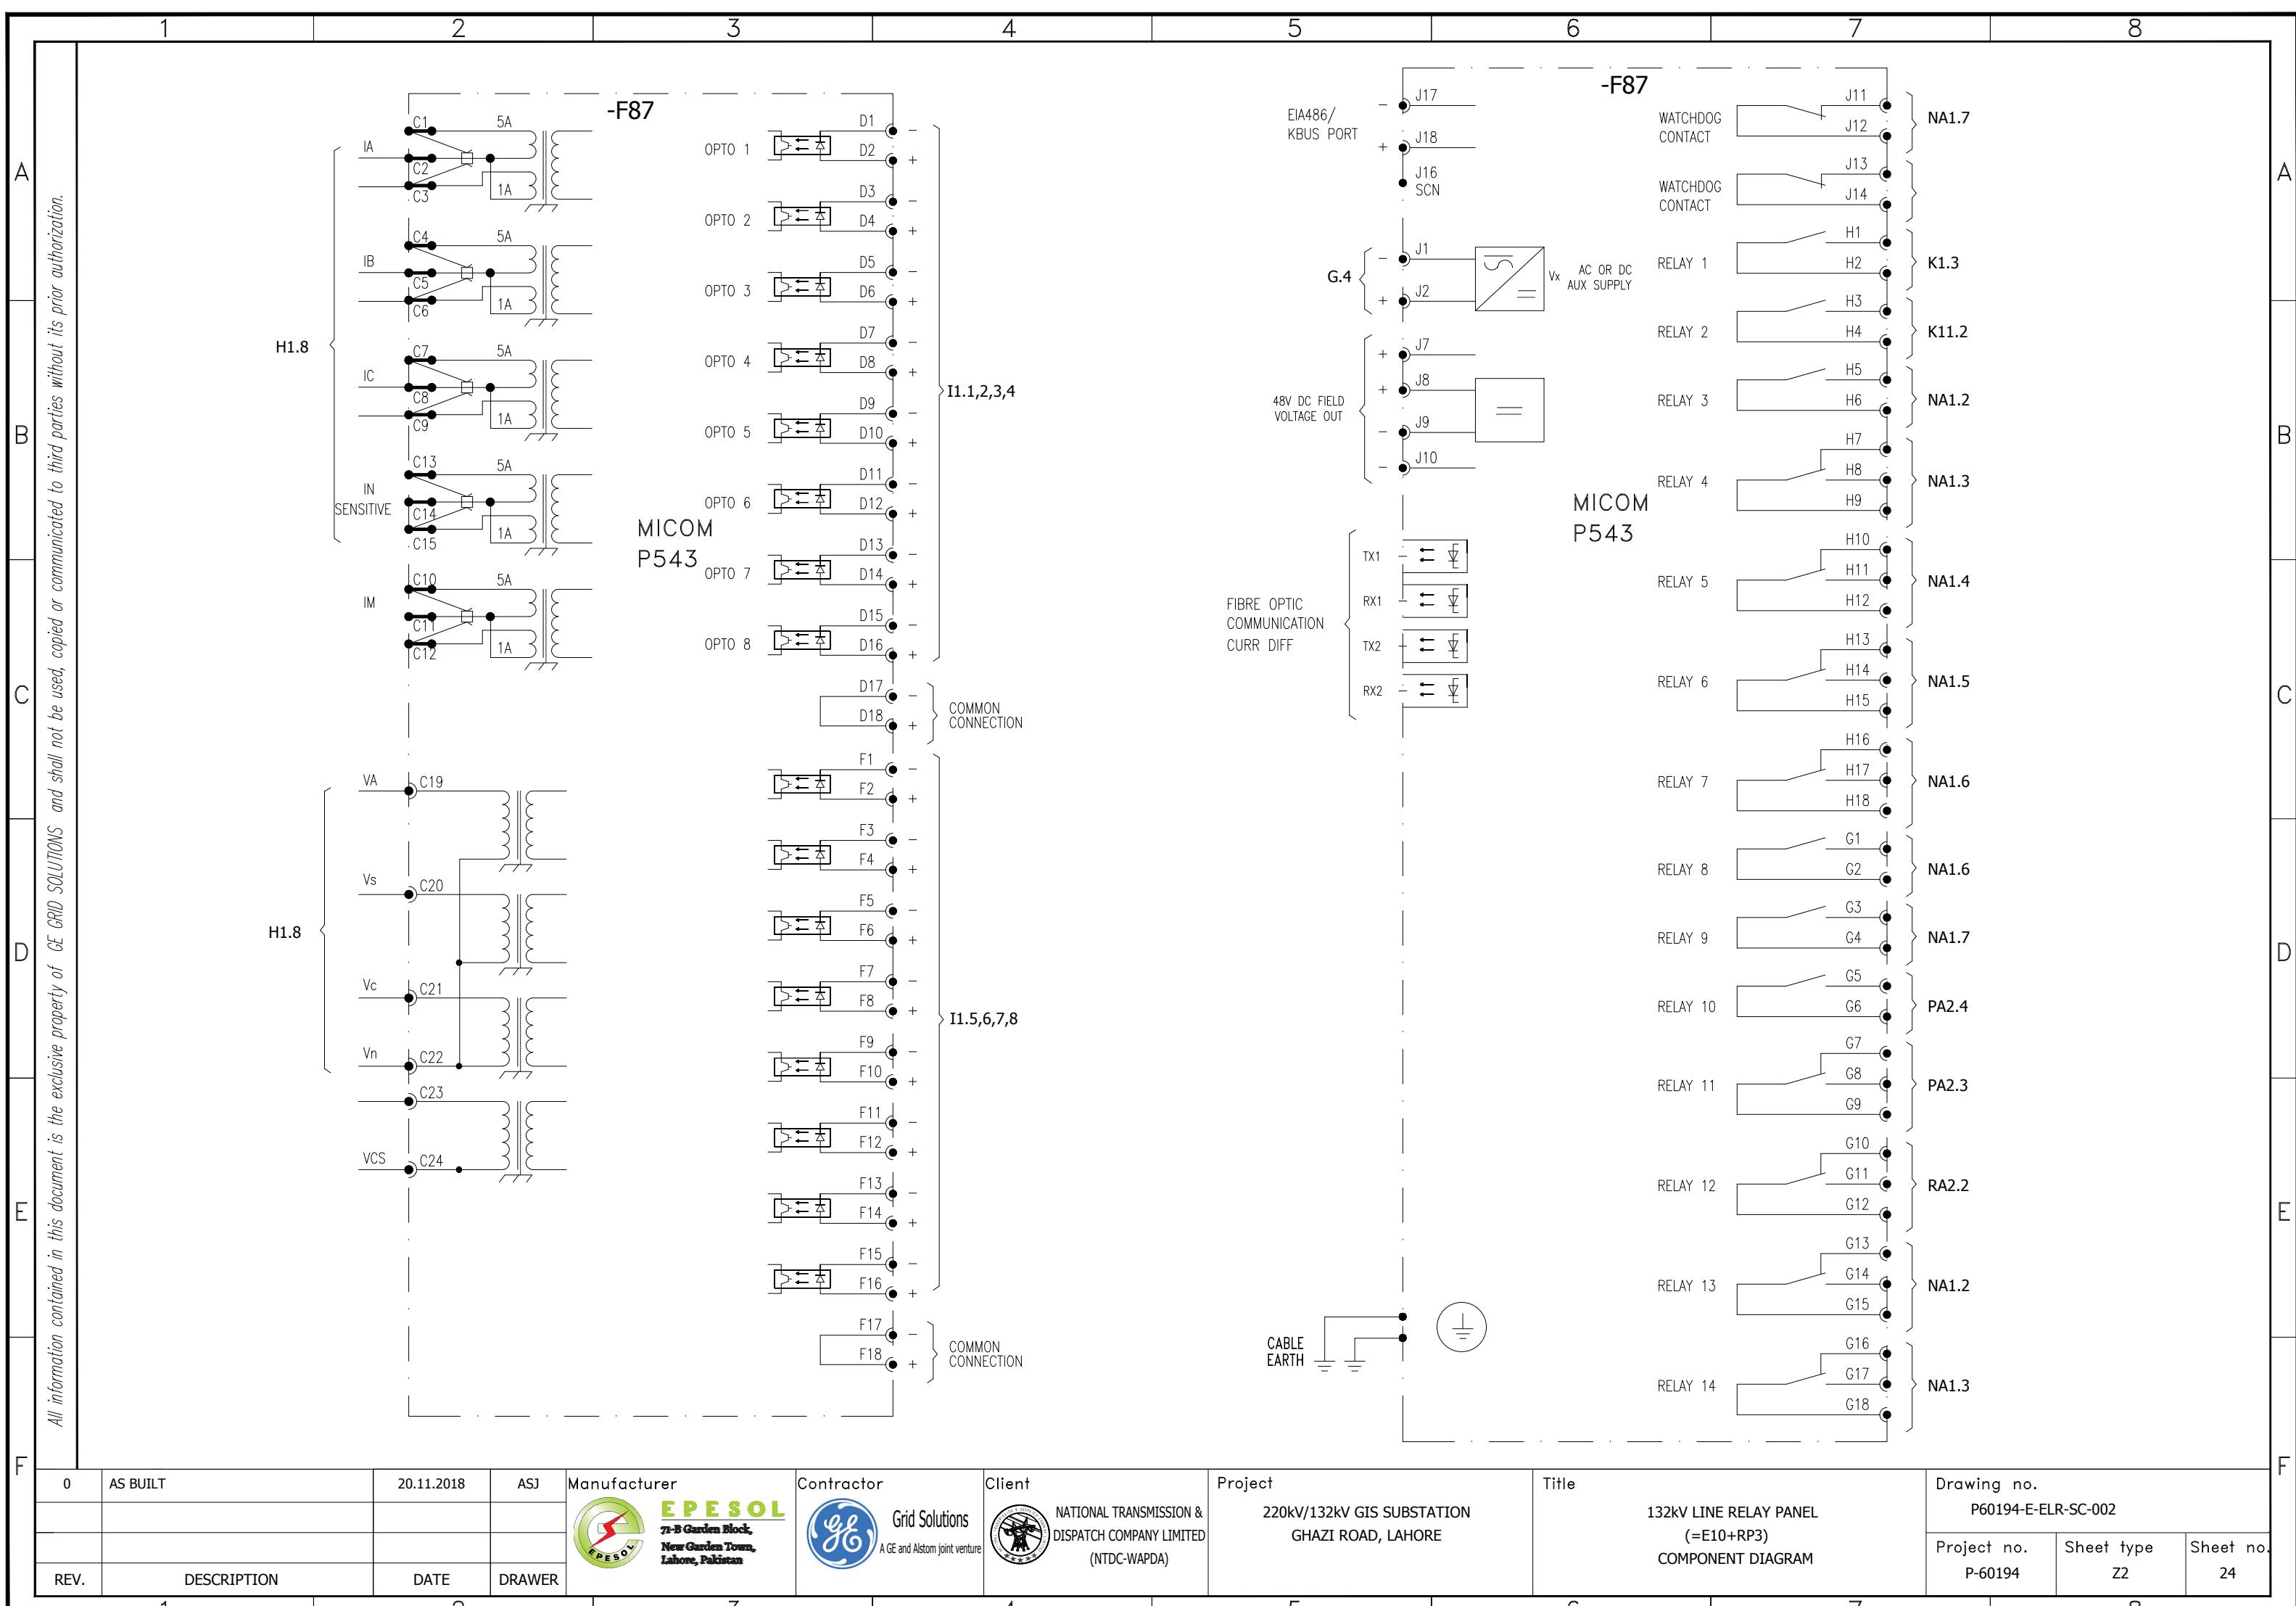

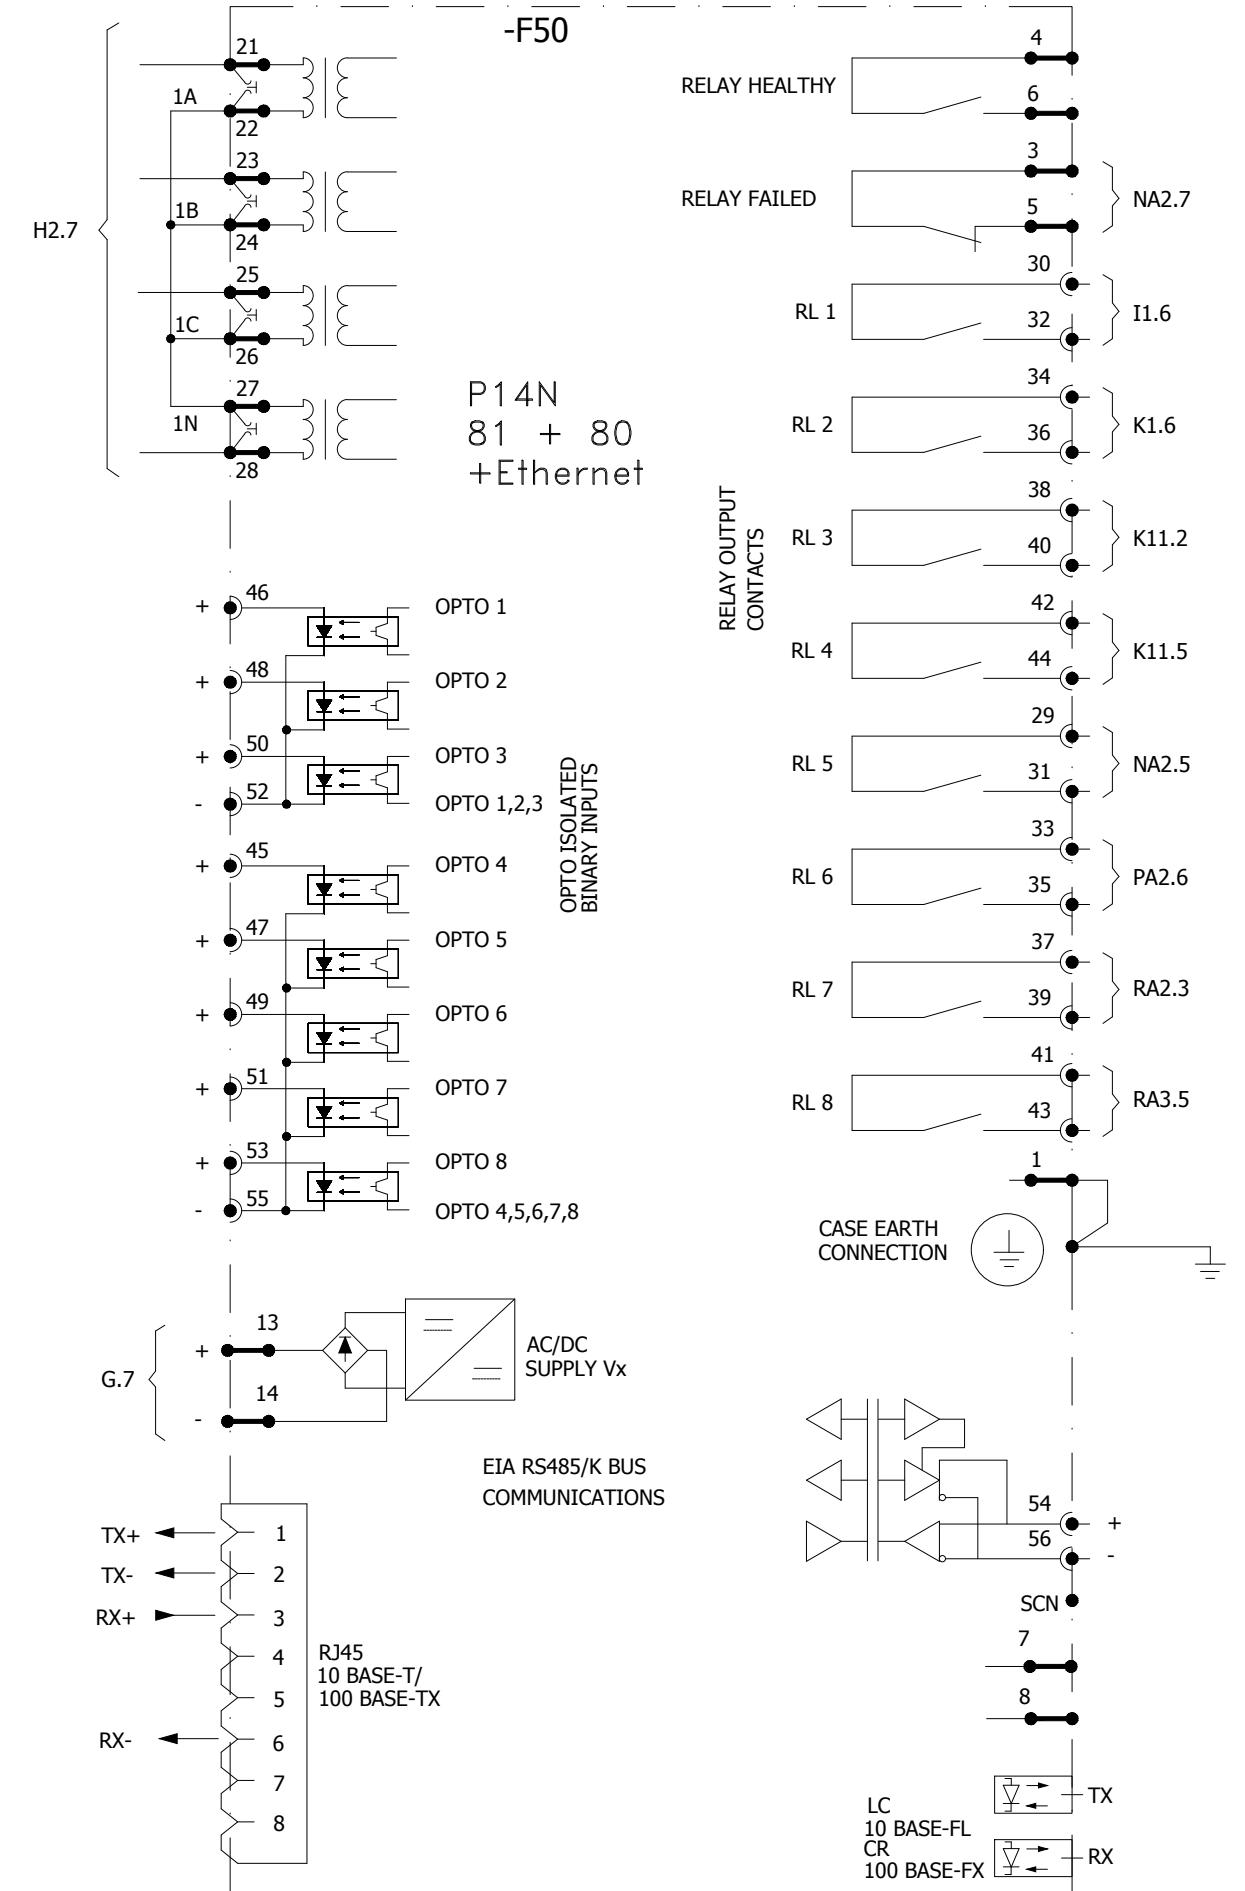


0	AS BUILT	20.11.2018	ASJ	Manufacturer <b>EPESOL</b> 71-B Garden Block, New Garden Town, Lahore, Pakistan	Contractor <b>GE</b> A GE and Alstom joint venture	Client <b>NATIONAL TRANSMISSION &amp; DISPATCH COMPANY LIMITED (NTDC-WAPDA)</b>	Project 220KV/132KV GIS SUBSTATION GHAZI ROAD, LAHORE	Title 132KV LINE RELAY PANEL (=E10+RP3) COMPONENT DIAGRAM	Drawing no. P60194-E-ELR-SC-002		
REV.	DESCRIPTION	DATE	DRAWER						Project no. P-60194	Sheet type Z3	Sheet no. 25


All information contained in this document is the exclusive property of GE GRID SOLUTIONS and shall not be used, copied or communicated to third parties without its prior authorization.

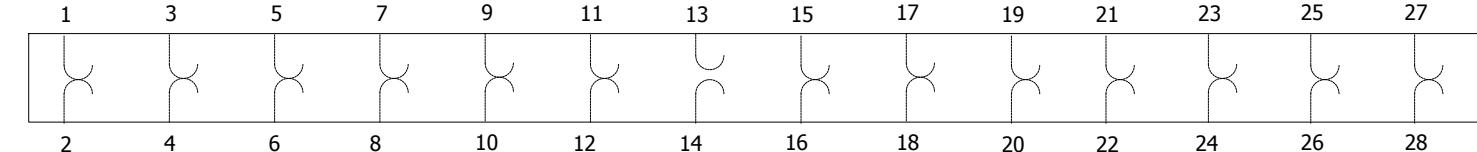

-XT87A	H1.6		NA1.1		G.4		NA1.2,3		H1.6	
-XT87B	K1.2	NA1.4		NA1.5		NA1.6,7				
-XT50	H2.6		K1.6		G.7		NA2.5	NA2.7		


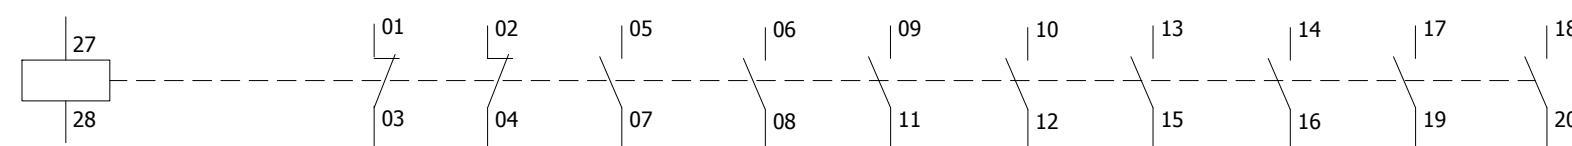


-F94-1	K1.2				K11.3	K11.5	PA2.7	PA2.5			
--------	------	--	--	--	-------	-------	-------	-------	--	--	--

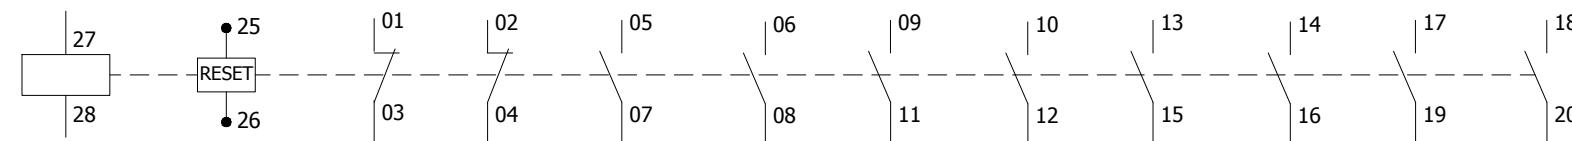

-F86L	K1.6				K11.3	K11.5	PA2.7				
-------	------	--	--	--	-------	-------	-------	--	--	--	--

-R94B1	K11.3
-R94B2	K11.3
-R94B3	K11.4
-R94C1	K11.6
-R94C2	K11.6
-R94C3	K11.7

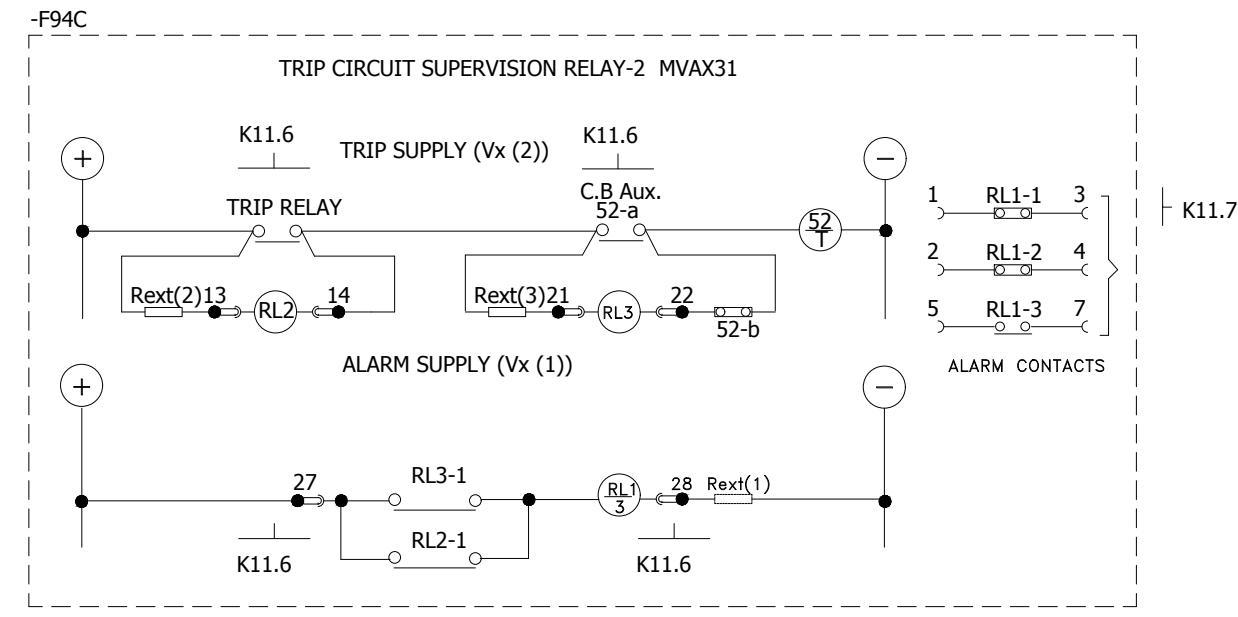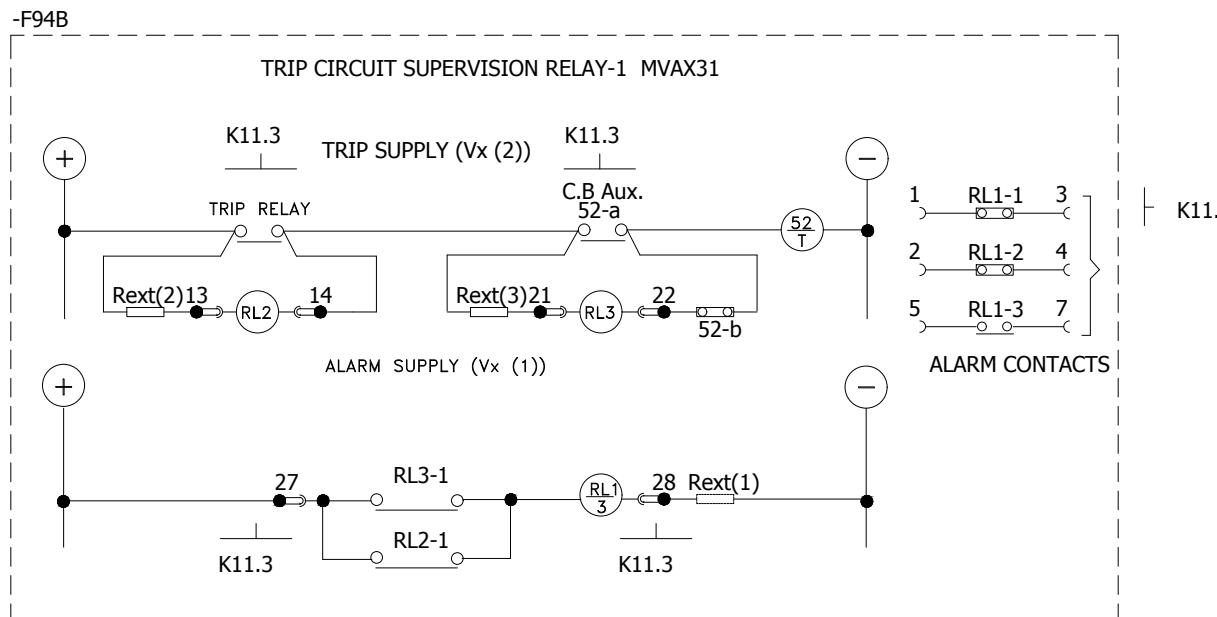

0	AS BUILT	20.11.2018	ASJ	Manufacturer  EPESOL 71-B Garden Block, New Garden Town, Lahore, Pakistan	Contractor  Grid Solutions A GE and Alstom joint venture	Client  NATIONAL TRANSMISSION & DISPATCH COMPANY LIMITED (NTDC-WAPDA)	Project 220KV/132KV GIS SUBSTATION GHAZI ROAD, LAHORE	Title 132KV LINE RELAY PANEL (=E10+RP3) COMPONENT DIAGRAM	Drawing no. P60194-E-ELR-SC-002		
REV.	DESCRIPTION	DATE	DRAWER						Project no. P-60194	Sheet type Z4	Sheet no. 26
1		2	3	4	5	6	7	8			