



**Grid Solutions**  
A GE and Alstom joint venture

# 220kV/132kV GIS SUBSTATION GHAZI ROAD , LAHORE

## 132kV LINE RELAY PANEL SCHEMATIC DRAWINGS

DOC / DWG REVIEW CODE	
<input type="checkbox"/> A	Approved, Issue IFC.
<input type="checkbox"/> B	Approved with comments as noted, Issue IFC after incorporation of these comments.
<input type="checkbox"/> C	Revise and re-submit for approval.
<input type="checkbox"/> D	Rejected.
Signed .....	Date .....
Permission to proceed does not constitute acceptance of approval of design details, analysers, test methods or materials/ selected by the CONTRACTOR and does not relieve the CONTRACTOR from full compliance with AGREEMENT obligations.	

REFERENCE DRAWINGS					
SR. NO.	DRAWING TITLE				DOCUMENT NO.
1.	220kV / 132kV Metering & Protection SLD				P60194-E-SLMP-001
REVISION HISTORY					
REV	DATE	DRW. BY	CHK. BY	APR. BY	REVISION DESCRIPTION
0	20.11.2018	ASJ	MFT	NAH	AS BUILT
Scale NOT-TO-SCALE					Sheet size A3
Client  NATIONAL TRANSMISSION & DISPATCH COMPANY LIMITED (NTDC-WAPDA)					
Contractor  Grid Solutions A GE and Alstom joint venture					Manufacturer  EPESOL 71-B Garden Block, New Garden Town, Lahore Pakistan
Project 220kV / 132kV GIS SUBSTATION GHAZI ROAD , LAHORE					
Title 132kV LINE RELAY PANEL (=E06+RP3) SCHEMATIC DRAWINGS					
Order no P-60194			Document no P60194-E-ELR-SC-004		
Sheet type A		Total sheets 26		Sheet no 1	






	SYMBOL	DESCRIPTION	SYMBOL	DESCRIPTION	SYMBOL	DESCRIPTION	SYMBOL	DESCRIPTION
A		CIRCUIT BREAKER		MINIATURE CIRCUIT BREAKER		AUXILIARY CONTACTOR NO+NC	21	DISTANCE
B		SWITCH/ISOLATOR		SELECTOR SWITCH		AMMETER	24	OVEREXCITATION
C		EARTHING		LIMITED SWITCH		VOLTMETER	25	SYCHROCHECK
D		GIS TERMINATION		HUMIDITY & TEMPERATURE CONTROLLER		POWER FACTOR METER	49	THERMAL OVERLOAD
E		SF6 TO AIR BUSHING		PANEL HEATER		DIGITAL PANEL METER	50/51	PHASE OVERCURRENT
F		LINE TRAP		THREE PIN SOCKET		ACTIVE POWER METER	50N/51N	EARTH FAULT
G		SURGE ARRESTOR		INDICATION LIGHT		REACTIVE POWER METER	50BF	CIRCUIT BREAKER FAILURE
H		CURRENT TRANSFORMER		PUSH BUTTON		ENERGY METER	64	RESTRICTED EARTH FAULT
I		COUPLING CAPACITOR VOLTAGE TRANSFORMER		AUXILIARY CONTACTOR COIL			67N	DIRECTIONAL EARTH FAULT
J		POWER TRANSFORMER		POWER SUPPLY AC/DC			68	POWER SWING BLOCKING
K		AUTO TRANSFORMER		TERMINAL			78	OUT OF STEP
L				OPTO CONTACTS			79	AUTO-RECLOSING
M				RELAY CONTACTS			85	COMMUNICATION FAILURE
N				HOOTER			87T	TRAFO DIFFERENTIAL
O				AC BELL			87C	LOW IMPEDANCE DIFFERENTIAL CONNECTION
P							87BB	LOW IMPEDANCE DIFFERENTIAL BUSBAR

All information contained in this document is the exclusive property of GE GRID SOLUTIONS and shall not be used, copied or communicated to third parties without its prior authorization.

0	AS BUILT	20-11-2018	ASJ	Manufacturer  7-B Garden Block, New Garden Town, Lahore, Pakistan	Contractor  A GE and Alstom joint venture	Client  NATIONAL TRANSMISSION & DISPATCH COMPANY LIMITED (NTDC-WAPDA)	Project 220kV/132kV GIS SUBSTATION GHAZI ROAD, LAHORE	Title 132kV LINE RELAY PANEL (=E06+RP3) SYMBOLA AND LEGENDS	Drawing no. P60194-E-ELR-SC-004
REV.	DESCRIPTION	DATE	DRAWER						Project no. P-60194
									Sheet type AB
									Sheet no. 03




	1	2	3	4	5	6	7	8				
	QTY.	DEVICE DESCRIPTION	DEVICE SPECIFICATIONS DEVICE TYPE ; TECHNICAL DATA / SPECIFICATIONS			DEVICE DESIGNITION	MANUFACTURER					
A	01	LINE DIFFERENTIAL PROTECTION RELAY		AGILE P543, Cortec: P543-91PC7M0820M Supply: 110-250VDC / 100-240VAC, VT + CT (100-120V:1/5A) Inputs 16 Opto Inputs, 14 Relay Outputs			-F87	GE				
	01	OVER CURRENT PROTECTION RELAY		AGILE P14N, Cortec: P14N-B16A7C570A 08 Opto Inputs, 08 Relay Outputs			-F50	GE				
	02	TRIP CIRCUIT SUPERVISION		MVAX31, Cortec: MVAX31-S1DD0754A			-F94B-C	GE				
B	04	RESISTORS		4KΩ			-R94 B/C 1-2	GE				
	02	RESISTORS		1.5KΩ			-R94 B/C 3	GE				
	03	TEST BLOCK		MMLG01, Cortec: MMLG01-R1AA9002D			-XT87A,-XT87B,XT50	GE				
C	01	TRIPPING RELAY (SELF-RESETTING)		MVAJ101, Cortec: MVAJ101-RA0802A Supply: 110-125VDC, 8 NO + 2 NC Contacts			-F94-1	GE				
	01	LOCKOUT RELAY (HAND/ELECTRICAL RESET)		MVAJ105, Cortec: MVAJ105-RA0802A Supply: 110-125VDC, 8 NO + 2 NC Contacts			-F86L	GE				
	02	CONTROL MCB - PANEL LIGHT & HEATER		2-Pole, Ratings: 2A, 240VAC, 6kA @ 240VAC, 2 C/O Contacts, Ord: G62C02+CAH(2)			-F101, -F102	GE				
D	01	CONTROL ELCB - PANEL SOCKET		2-Pole, Ratings: 16A, 30mA, 240VAC, 10kA @ 240VAC, 2 C/O Contacts, Ord: DM100C16/030+CAH(2)			-F103	GE				
	04	CONTROL MCB - DC DISTRIBUTION		2-Pole, Ratings: 4A, 110VDC, 10kA @ 110VDC, 2 C/O Contacts, Ord: EP102UCC04+CAH(2)			-F201, -F202, -F203, -F204	GE				
	25	AUXILIARY CONTACTOR		Coil Voltage: 110VDC, DIODE, 4 C/O Contacts, Ord: PRC4M40DCJL			-KDCM, -KQ0.ON, -KQ1.ON, -KQ2.ON, -KQ9.ON, -KZ2/3T, -KQ0.ONC, -KQ0.OFC, -KVTB1, -KRT, -KYT, -K94B, -K94C, -KBT, -KZ1T, -KPSD, -KSOTF, -KPSS, -KPSR, -K87F, -KDC1, -KAC, -K50T, -K50F, -KDC2	GE				
E	01	AUXILIARY CONTACTOR - SUPPLY CHANGEOVER		Coil Voltage: 110VDC, 3 NO + 3 NC Contacts, Ord: MCRC022ATWJ+MARN211AT			-KDCO	GE				
	02	AUXILIARY CONTACTOR		Coil Voltage: 240VAC, 4 C/O Contacts, Ord: PRC4M40ANL			-KDC, -KACM	GE				
	01	SELECTOR SWITCH - AUTORECLOSER		YS-AK-2-2-44-D, 2-Postion (IN-OUT), 110VDC, KEYLOCKABLE TYPE, KEY RELEASE ON "OUT"			-S79	YONGSUNG				
F	01	PUSH BUTTON		Black Button, Spring Return, 2-Pole, Rating 12A, 110VDC Ord: YS-AP1-2-40-B-D-W			-S50	YONGSUNG				
	01	PANEL LIGHT WITH DOOR SWITCH		240VAC @ 50Hz, 5W, with Door Limit Sw. Ord: YSP3315GW-B + YS-T8-30-5W			-H100,-S100	YONGSUNG				
	01	THREE PIN SOCKET		1N+PE, 16A, 240VAC @ 50Hz			-X100	LEAR				
G	01	PANEL HEATER		240VAC @ 50Hz, 50W			-R100	ELAB				
	01	HUMIDITY & TEMPERATURE CONTROLLER		40-90%RH, 25-50°C, 230VAC @ 50Hz			-B100	ELAB				
	01	INDICATION LAMP - DC SUPPLY FAILURE		Type: Integrated LED, Color : RED , Supply : 240VAC @ 50Hz, Ord: YS-PL-2-AL-22-R-W			-H200	YONGSUNG				
H	0	AS BUILT		20-11-2018	ASJ	Manufacturer  EPESOL 71-B Garden Block, New Garden Town, Lahore, Pakistan	Contractor  Grid Solutions A GE and Alstom joint venture	Client  NATIONAL TRANSMISSION & DISPATCH COMPANY LIMITED (NTDC-WAPDA)	Project 220KV/132KV GIS SUBSTATION GAZI ROAD, LAHORE	Title 132KV LINE RELAY PANEL (=E06+RP3) COMPONENT LIST	Drawing no. P60194-E-ELR-SC-004	
									Project no. P-60194			
	REV.	DESCRIPTION		DATE	DRAWER				Sheet type AC1	Sheet no. 04		

	1	2	3	4	5	6	7	8		
	QTY.	DEVICE DESCRIPTION	DEVICE SPECIFICATIONS DEVICE TYPE ; TECHNICAL DATA / SPECIFICATIONS			DEVICE DESIGNITION	MANUFACTURER			
A	12	TERMINAL BLOCKS FOR SYSTEM INPUT STATUS	CBD-4			-X8	CABUR			
	6	TERMINAL BLOCKS FOR PROTECTION INTER CIRCUIT	CBD-4			-X9	CABUR			
	4	TERMINAL BLOCKS FOR AC SUPPLY DISTRIBUTION	CBD-4			-XAC	CABUR			
B	19	TERMINAL BLOCKS FOR ANNUNCIATOR	CBD-4			-XAN	CABUR			
	2	TERMINAL BLOCKS FOR DC SUPPLY-1 DISTRIBUTION	CBD-4			-XDC1	CABUR			
	2	TERMINAL BLOCKS FOR DC SUPPLY-2 DISTRIBUTION	CBD-4			-XDC2	CABUR			
C	15	TERMINAL BLOCKS FOR EVENT RECORDER	CBD-4			-XEV	CABUR			
	3	TERMINAL BLOCKS FOR FAULT RECORDER	CBD-4			-XFR	CABUR			
	16	TERMINAL BLOCKS FOR SCADA	CBD-4			-XSC	CABUR			
D	7	TERMINAL BLOCKS FOR TRIP CIRCUIT-1	CBD-4			-XTC1	CABUR			
	7	TERMINAL BLOCKS FOR TRIP CIRCUIT-2	CBD-4			-XTC2	CABUR			
	2	TERMINAL BLOCKS FOR CONTROL	CBD-4			-X3	CABUR			
E	22	TERMINAL BLOCKS FOR LINE DIFFERENTIAL	CBD-4			-X6	CABUR			
	16	TERMINAL BLOCKS FOR CT	SCB-6			-X4	CABUR			
	16	TERMINAL BLOCKS FOR VT	SCB-6			-X4	CABUR			
F	8	TERMINAL BLOCKS FOR CT	SCB-6			-X5	CABUR			
	16	SPARE TERMINAL BLOCKS	CBD-4			-X1	CABUR			
<p>All information contained in this document is the exclusive property of GE GRID SOLUTIONS and shall not be used, copied or communicated to third parties without its prior authorization.</p>										
0	AS BUILT	20.11.2018	ASJ	Manufacturer  <b>EPESOL</b> 71-B Garden Block, New Garden Town, Lahore, Pakistan	Contractor  <b>Grid Solutions</b> A GE and Alstom joint venture	Client  <b>NATIONAL TRANSMISSION &amp; DISPATCH COMPANY LIMITED (NTDC-WAPDA)</b>	Project 220KV/132KV GIS SUBSTATION GHAZI ROAD, LAHORE	Title 132KV LINE RELAY PANEL (=E06+RP3) COMPONENT LIST	Drawing no. P60194-E-ELR-SC-004	
REV.	DESCRIPTION	DATE	DRAWER					Project no. P-60194	Sheet type AC1	Sheet no. 04a

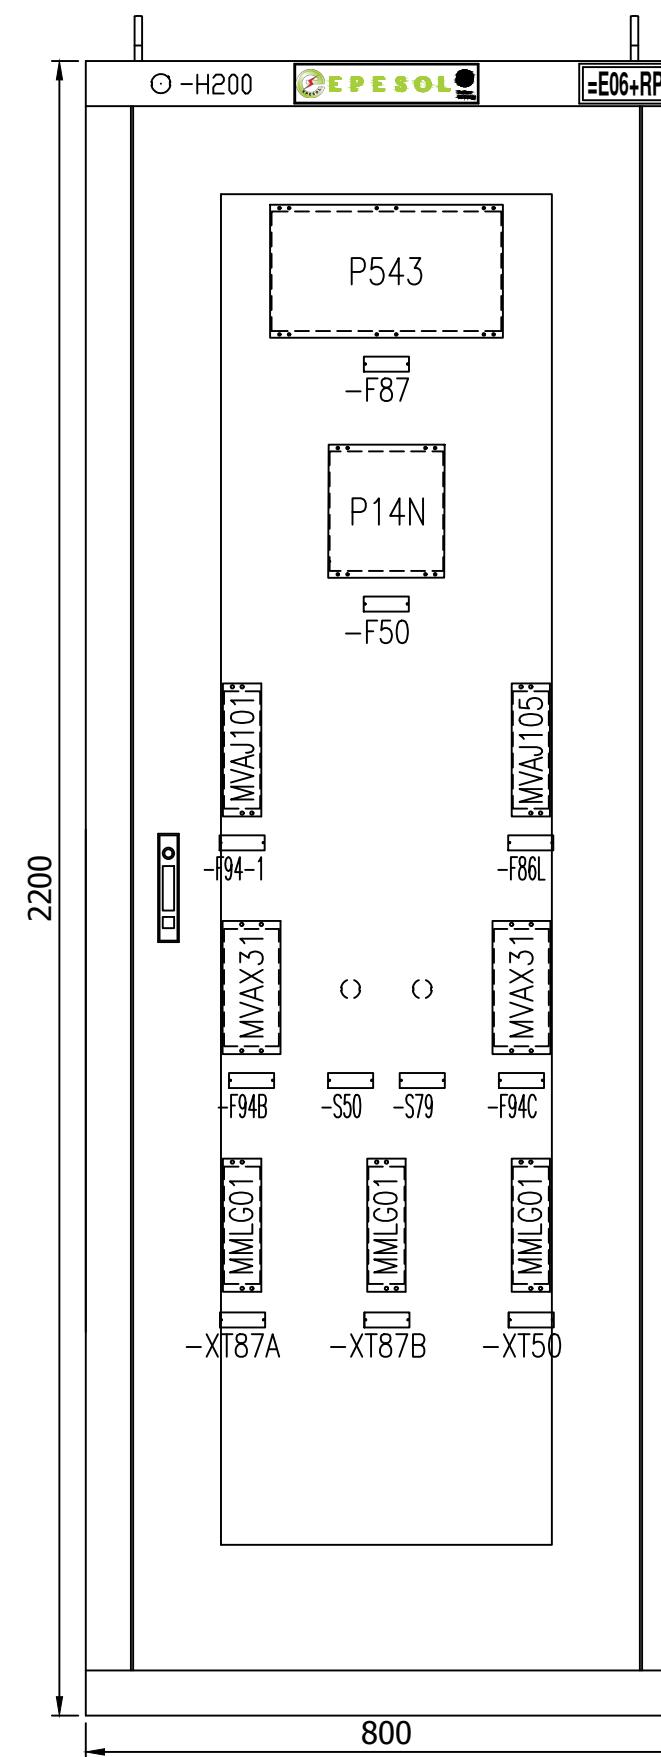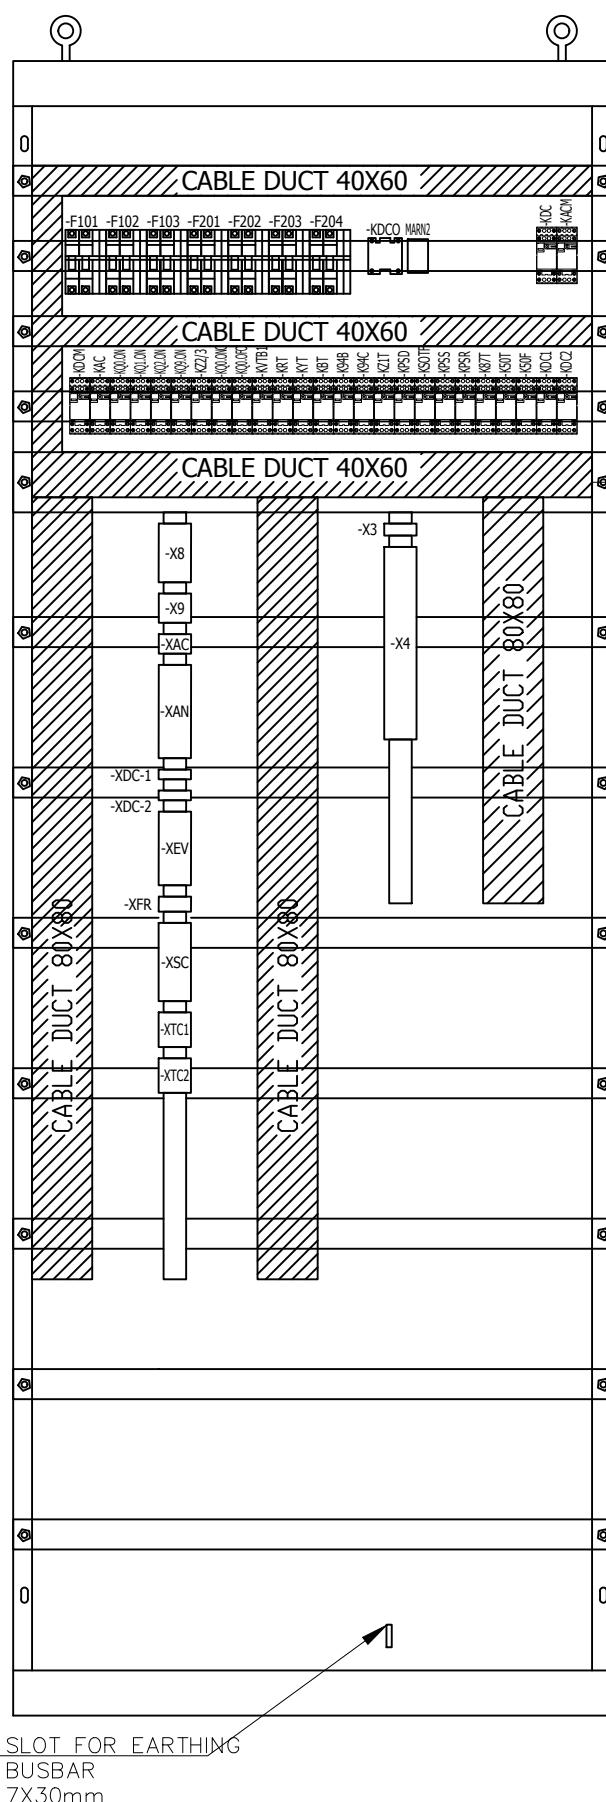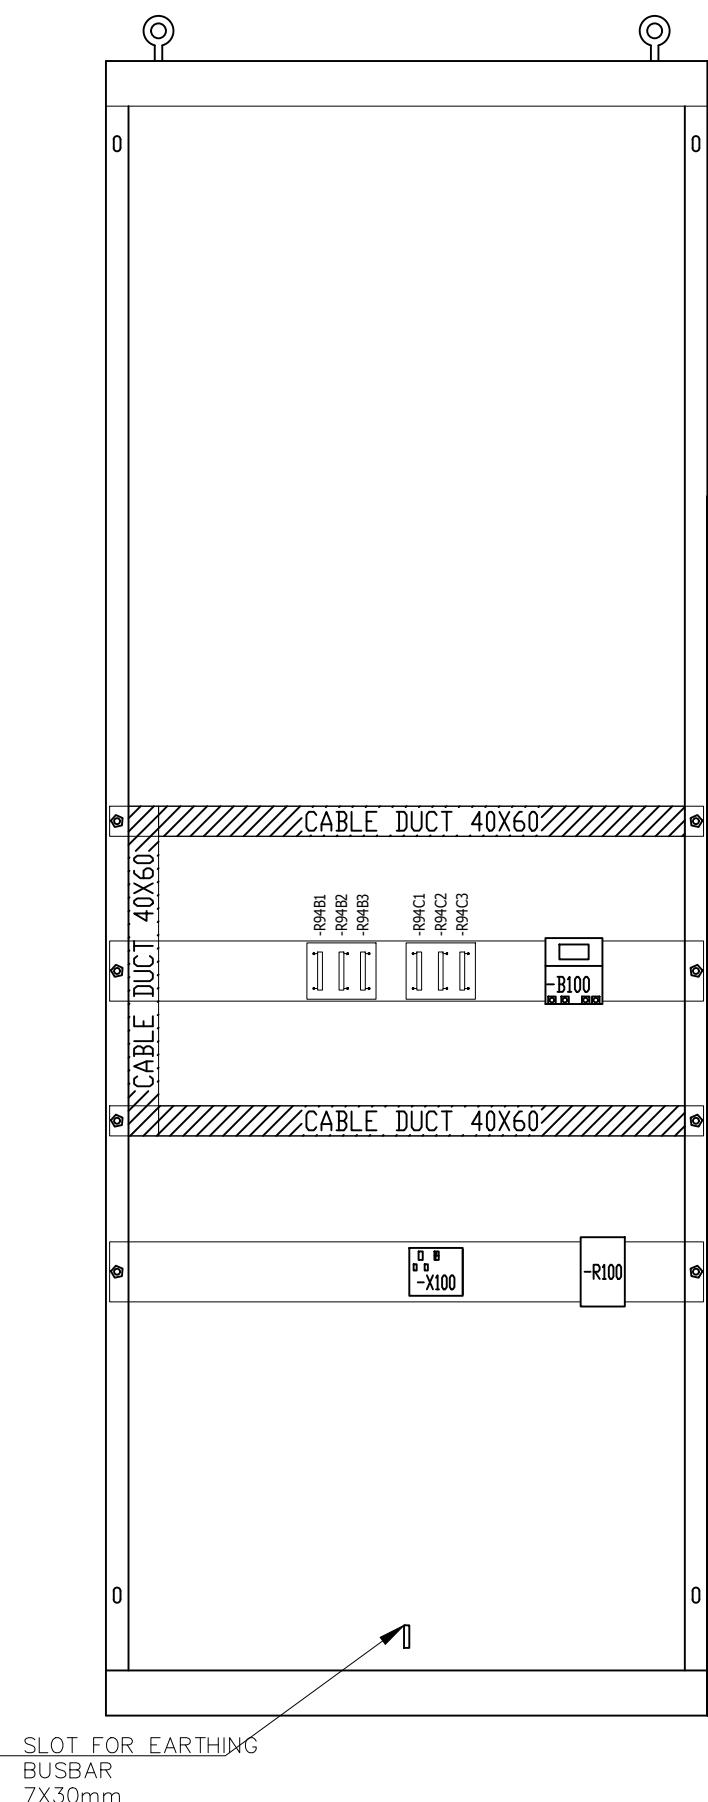FRONT VIEW WITH DOORLEFT SIDE VIEWRIGHT SIDE VIEW

All information contained in this document is the exclusive property of GE GRID SOLUTIONS and shall not be used, copied or communicated to third parties without its prior authorization.




0	AS BUILT	20.11.2018	ASJ	Manufacturer <b>EPESOL</b> 71-B Garden Block, New Garden Town, Lahore, Pakistan	Contractor <b>Grid Solutions</b> A GE and Alstom joint venture	Client <b>NATIONAL TRANSMISSION &amp; DISPATCH COMPANY LIMITED (NTDC-WAPDA)</b>	Project 220kV/132kV GIS SUBSTATION GHAZI ROAD, LAHORE	Title 132kV LINE RELAY PANEL (=E06+RP3) PANEL VIEW	Drawing no. P60194-E-ELR-SC-002
REV.	DESCRIPTION	DATE	DRAWER						Project no. P-60194

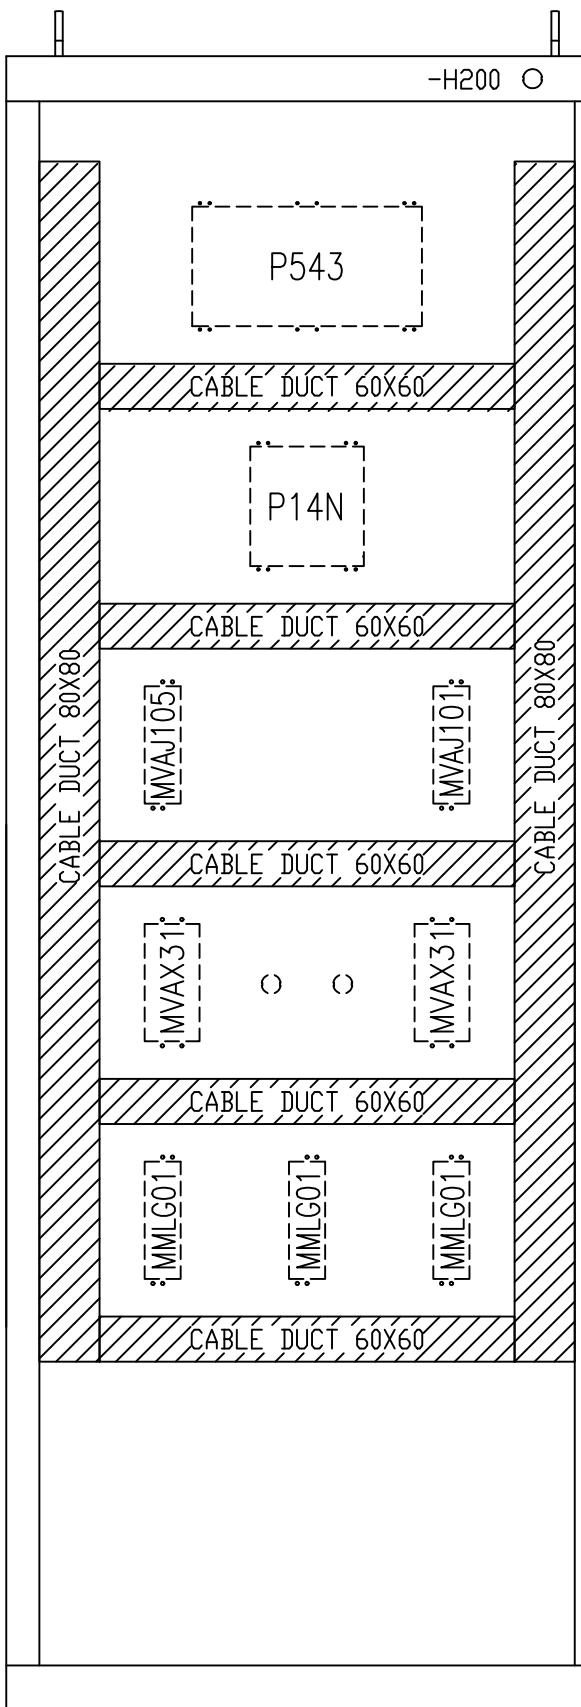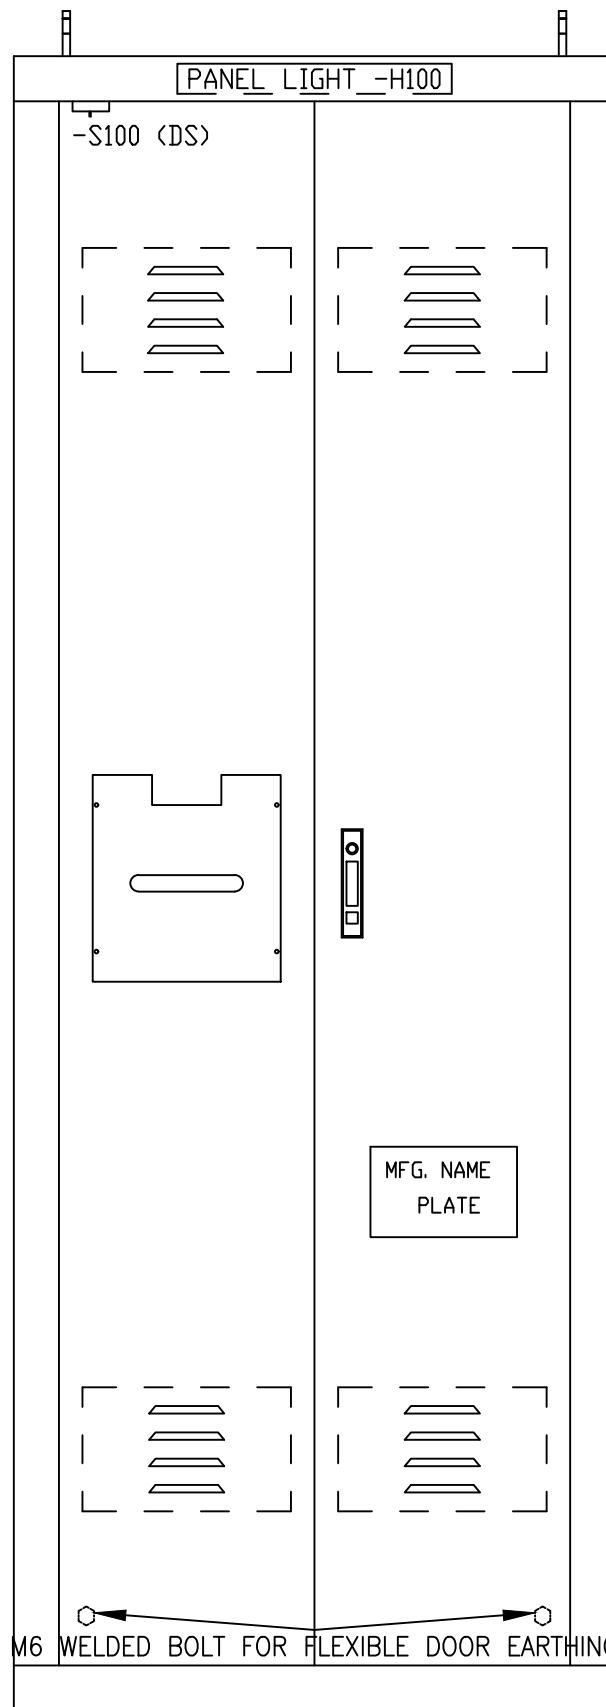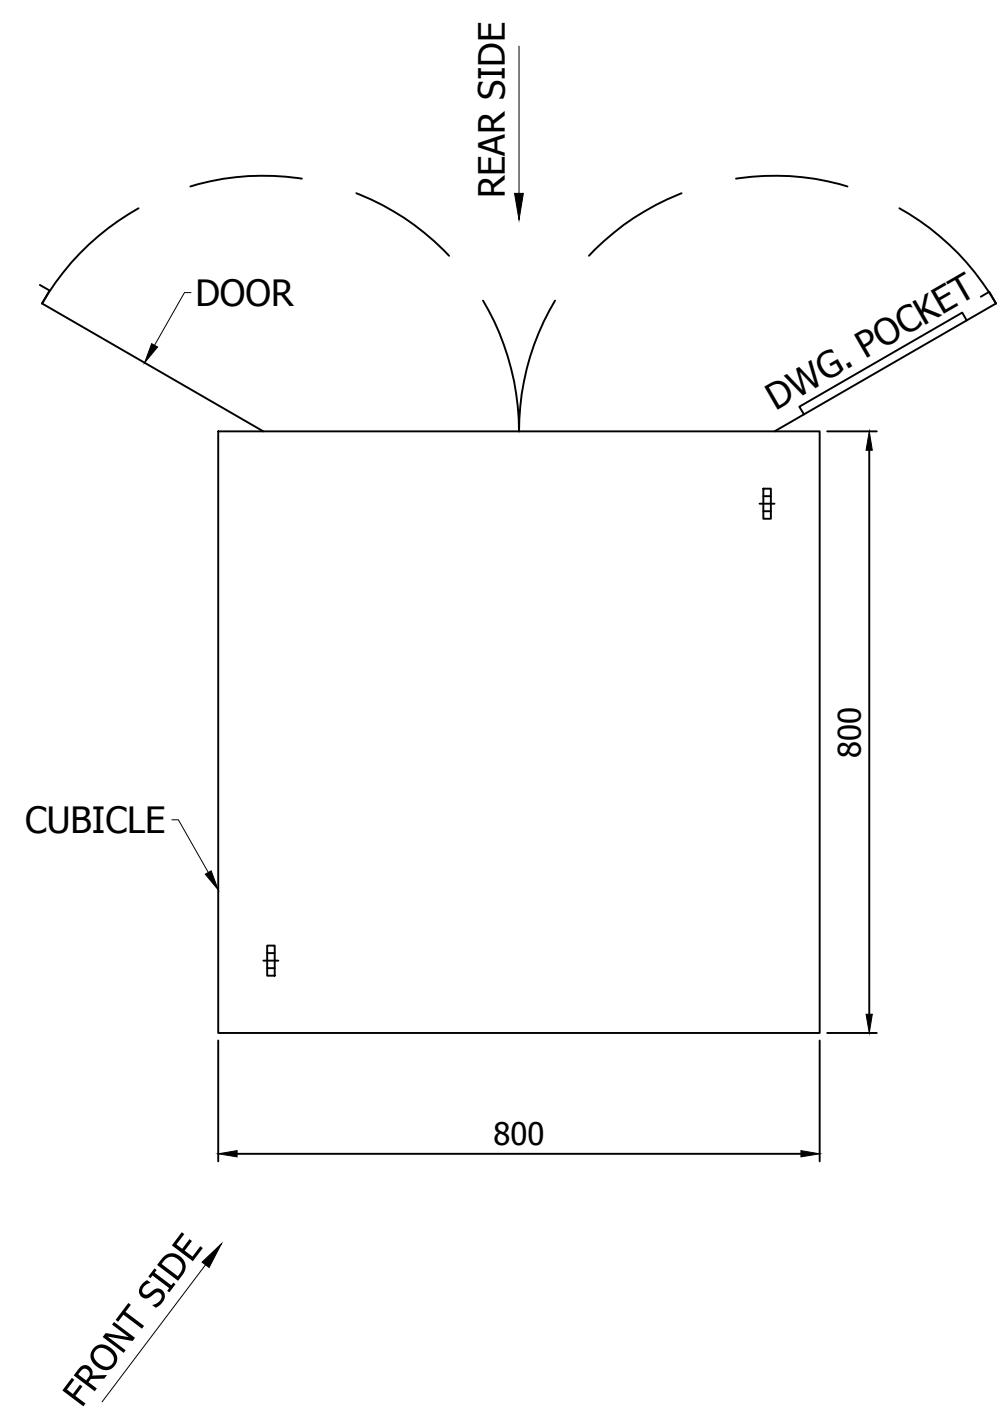BACK VIEW WITHOUT DOORBACK VIEW WITH DOORTOP VIEW**NOTE:-**

- 1 - PANEL DIMENSION: 800 x 800 x 2200mm (WxDxH)
- 2 - COLOR : RAL 7032
- 3 - SHEET THICKNESS : 2-2.5 mm
- 4 - PROTECTION CLASS : IP-51 (INDOOR TYPE)
- 5 - ALL DOOR FITTED WITH 16mm EARTH STRAP & INSULATED WITH GREEN-YELLOW COLOUR.


All information contained in this document is the exclusive property of GE GRID SOLUTIONS and shall not be used, copied or communicated to third parties without its prior authorization.

0	AS BUILT	20.11.2018	ASJ	Manufacturer <b>EPE SOL</b> 71-B Garden Block, New Garden Town, Lahore, Pakistan	Contractor <b>GE</b> Grid Solutions A GE and Alstom joint venture	Client <b>NTDC-WAPDA</b> NATIONAL TRANSMISSION & DISPATCH COMPANY LIMITED	Project 220kV/132kV GIS SUBSTATION GHAZI ROAD, LAHORE	Title 132kV LINE RELAY PANEL (=E06+RP3) PANEL VIEW	Drawing no. P60194-E-ELR-SC-002
REV.	DESCRIPTION	DATE	DRAWER						Project no. P-60194

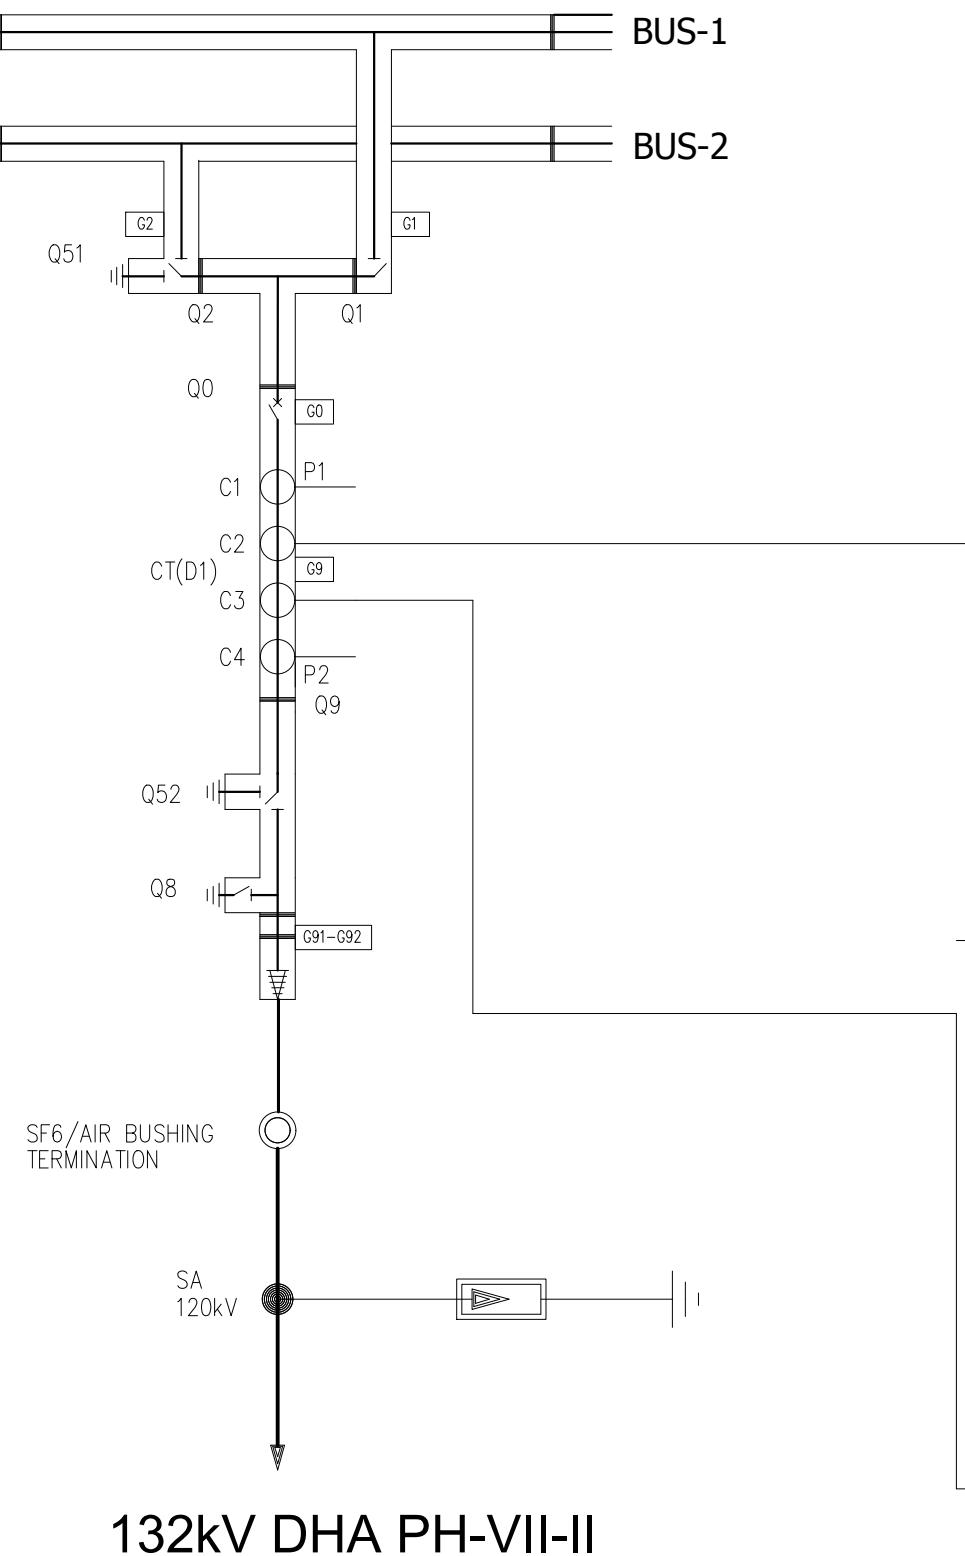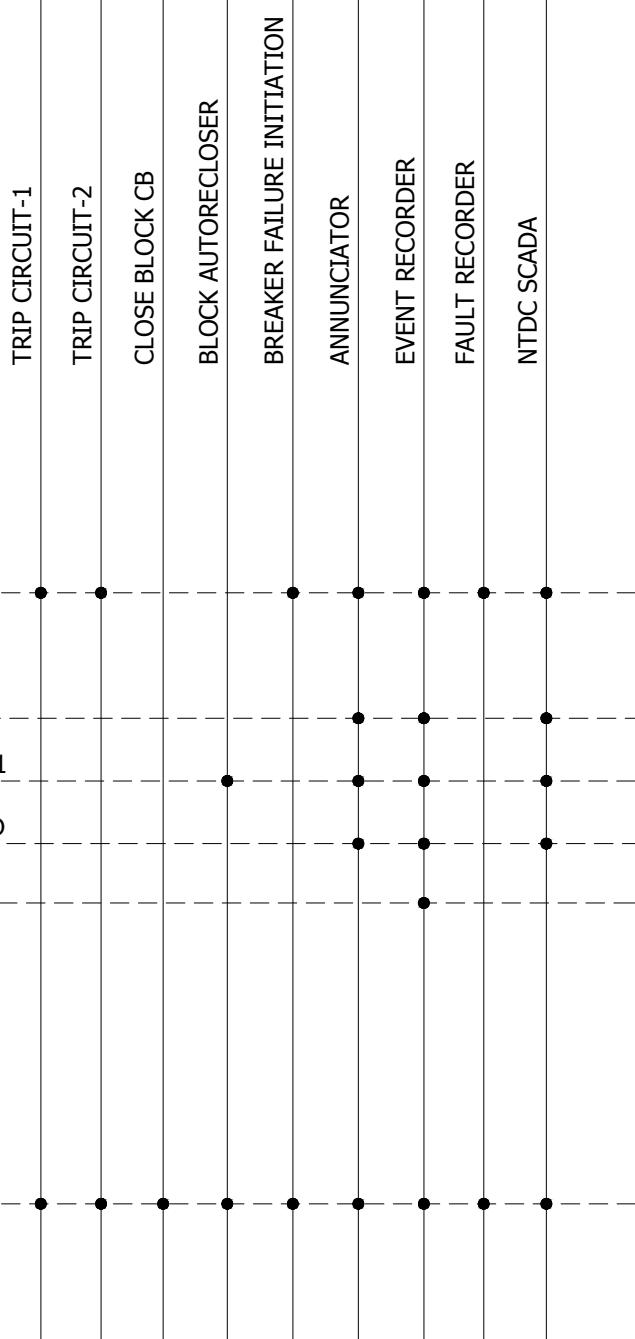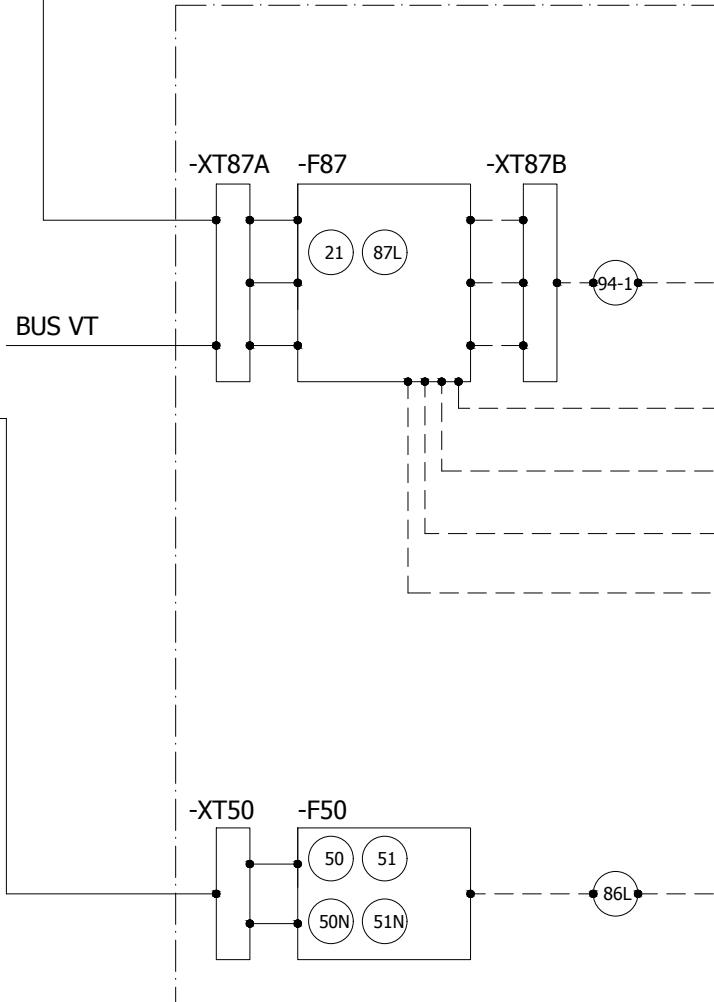**=E06****=E06+RP3  
132kV LINE RELAY PANEL**

All information contained in this document is the exclusive property of GE GRID SOLUTIONS and shall not be used, copied or communicated to third parties without its prior authorization.

0	AS BUILT	20-11-2018	ASJ	Manufacturer <b>E P E S O L</b> 71-B Garden Block, New Garden Town, Lahore, Pakistan	Contractor <b>Grid Solutions</b> A GE and Alstom joint venture	Client <b>NATIONAL TRANSMISSION &amp; DISPATCH COMPANY LIMITED (NTDC-WAPDA)</b>	Project 220kV/132kV GIS SUBSTATION GHAZI ROAD, LAHORE	Title 132kV LINE RELAY PANEL (=E06+RP3) BAY CONCEPT & PROTECTION LOGICS	Drawing no. P60194-E-ELR-SC-004
REV.	DESCRIPTION	DATE	DRAWER					Project no. P-60194	Sheet type AE
									Sheet no. 06

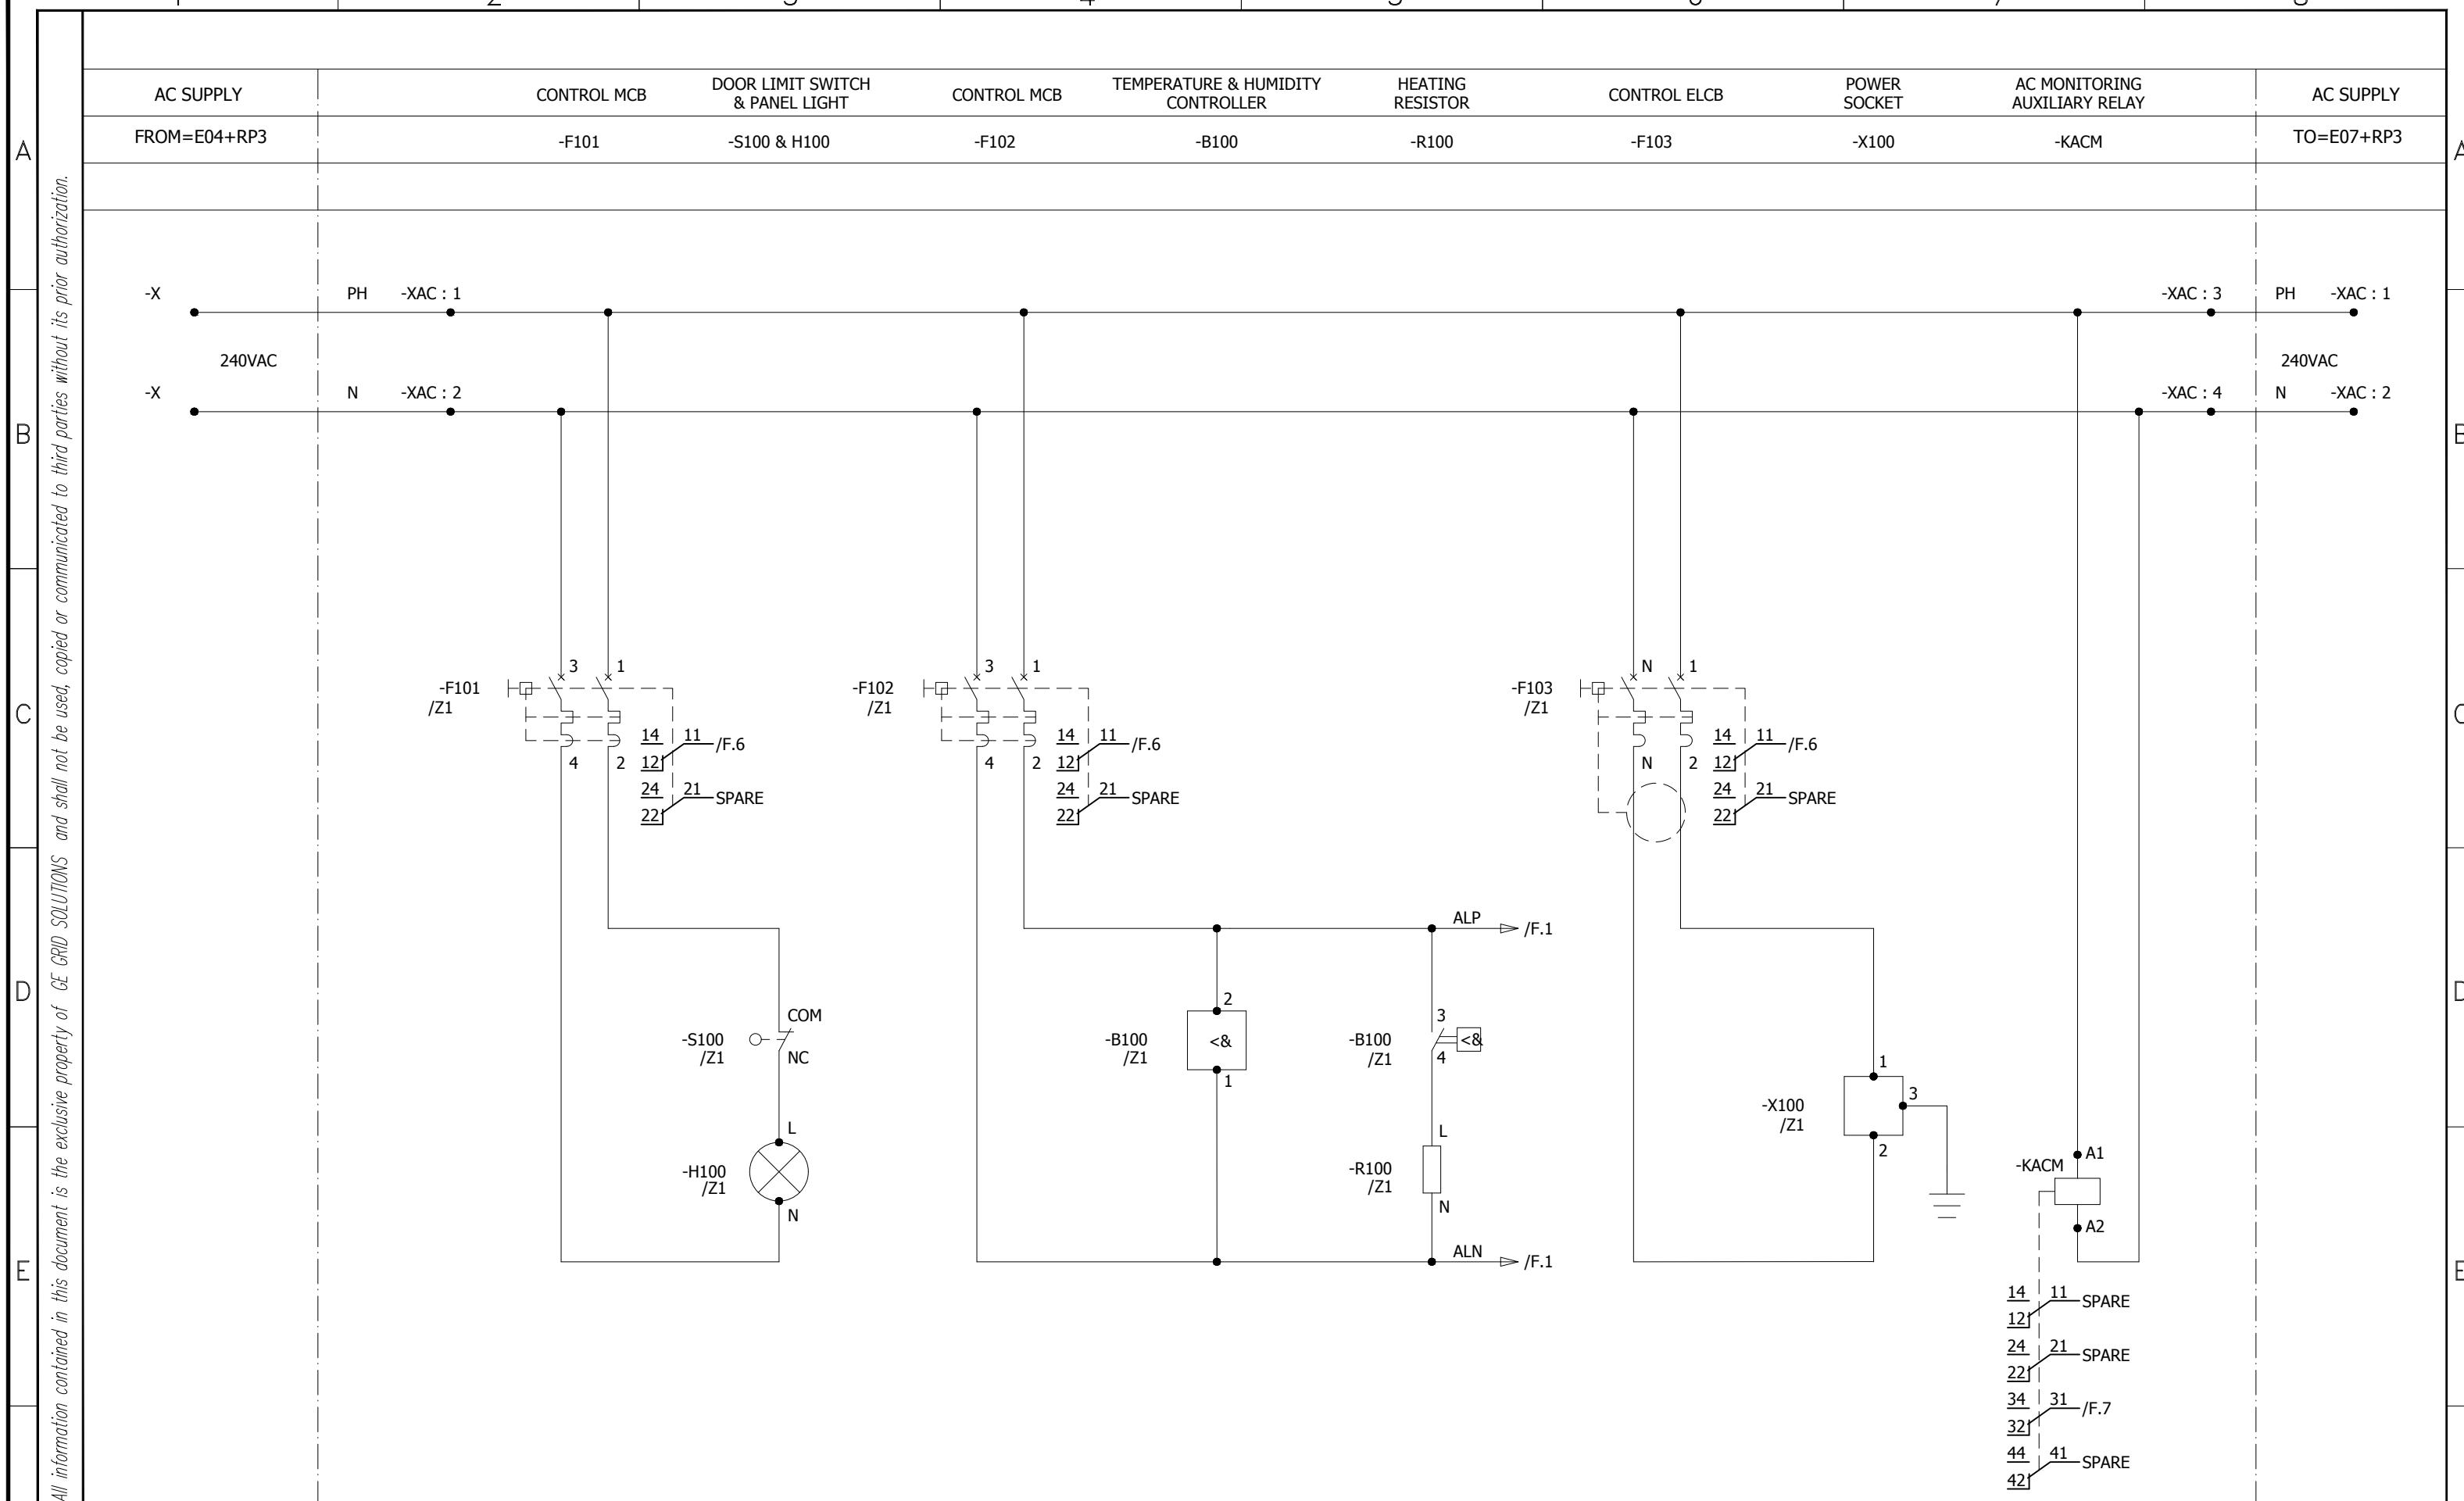

0	AS BUILT	20-11-2018	ASJ	Manufacturer <b>EPESOL</b> 75-B Garden Block, New Garden Town, Lahore, Pakistan	Contractor <b>Grid Solutions</b> A GE and Alstom joint venture	Client <b>NATIONAL TRANSMISSION &amp; DISPATCH COMPANY LIMITED (NTDC-WAPDA)</b>	Project 220kV/132kV GIS SUBSTATION GHAZI ROAD, LAHORE	Title 132kV LINE RELAY PANEL (=E06+RP3) AC SUPPLY DISTRIBUTION	Drawing no. P60194-E-ELR-SC-004
REV.	DESCRIPTION	DATE	DRAWER						Project no. P-60194
									Sheet type D
									Sheet no. 07

CONTROL MCB LINE DIFFERENTIAL RELAY SUPPLY	CONTROL MCB OVERCURRENT SUPPLY	CONTROL MCB AC CIRCUIT FAULTY SUPPLY	CONTROL MCB DC-1 SPARE	DC SUPPLY MONITORING AUXILIARY RELAY
---	-----------------------------------	---	---------------------------	---

-F201



-F202

-F203

-F204

-KDCM
-------

All information contained in this document is the exclusive property of GE GRID SOLUTIONS and shall not be used, copied or communicated to third parties without its prior authorization.

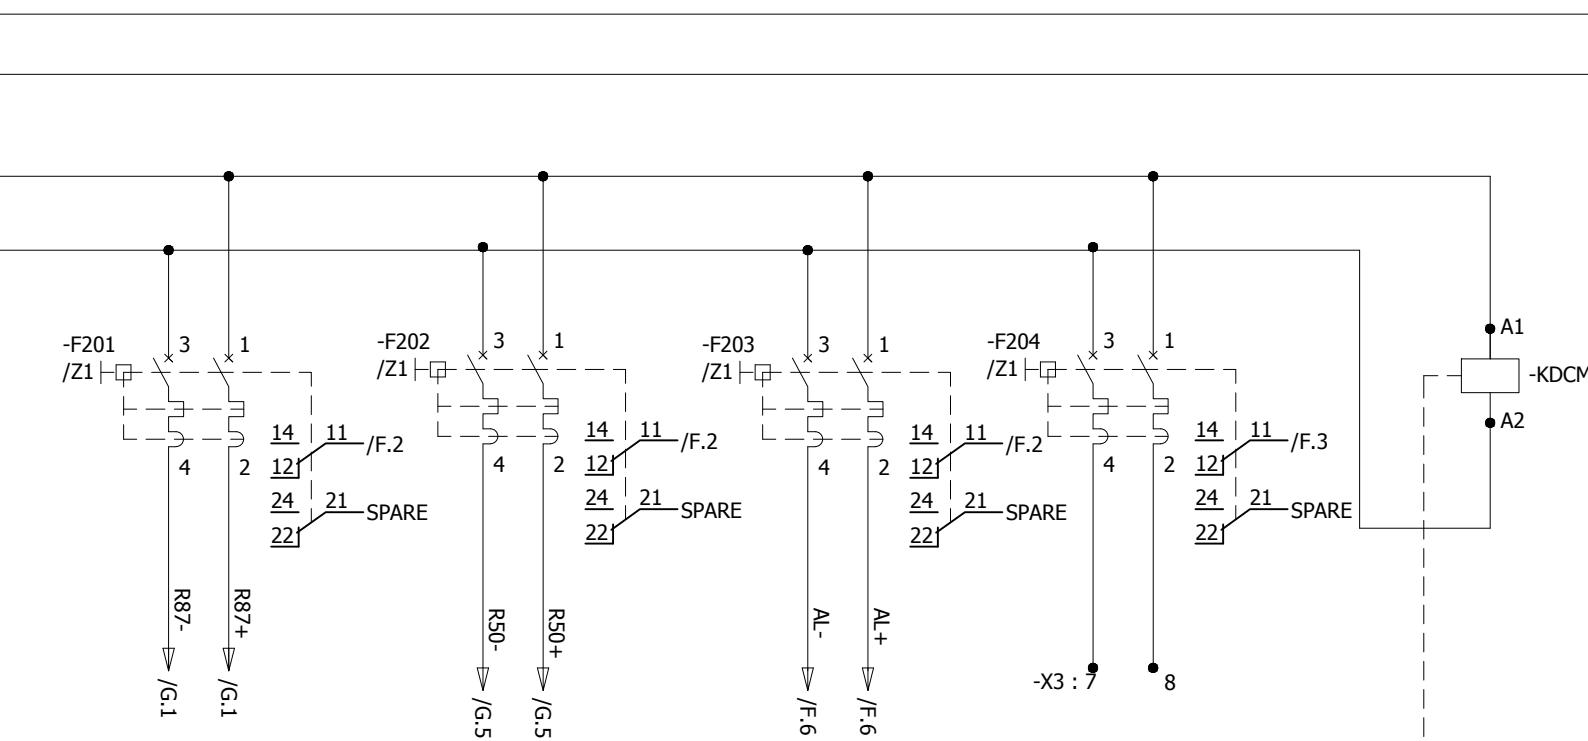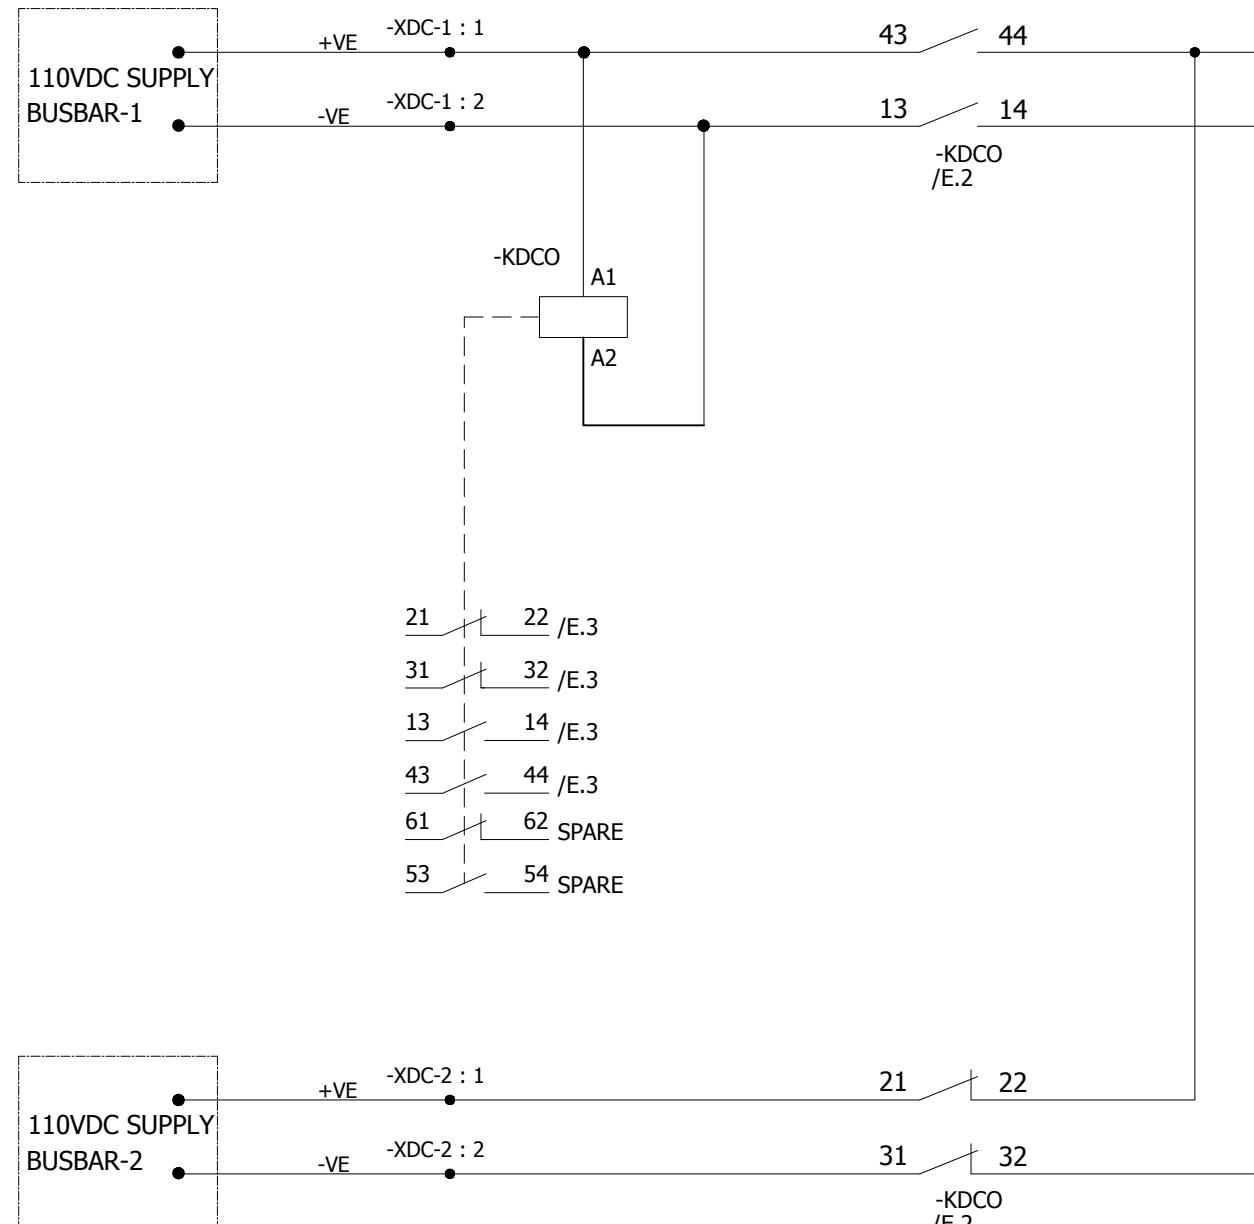



0	AS BUILT	20-11-2018	ASJ	Manufacturer <b>EPE SOL</b> 71-B Garden Block, New Garden Town, Lahore, Pakistan	Contractor <b>Grid Solutions</b> A GE and Alstom joint venture	Client <b>NATIONAL TRANSMISSION &amp; DISPATCH COMPANY LIMITED (NTDC-WAPDA)</b>	Project 220KV/132KV GIS SUBSTATION GHAZI ROAD, LAHORE	Title 132KV LINE RELAY PANEL (=E06+RP3) DC SUPPLY DISTRIBUTION	Drawing no. P60194-E-ELR-SC-004
REV.	DESCRIPTION	DATE	DRAWER						Project no. P-60194
									Sheet type E
									Sheet no. 08

110V DC CIRCUIT FAULTY

240V AC CIRCUIT FAULTY

-KDC

-KAC

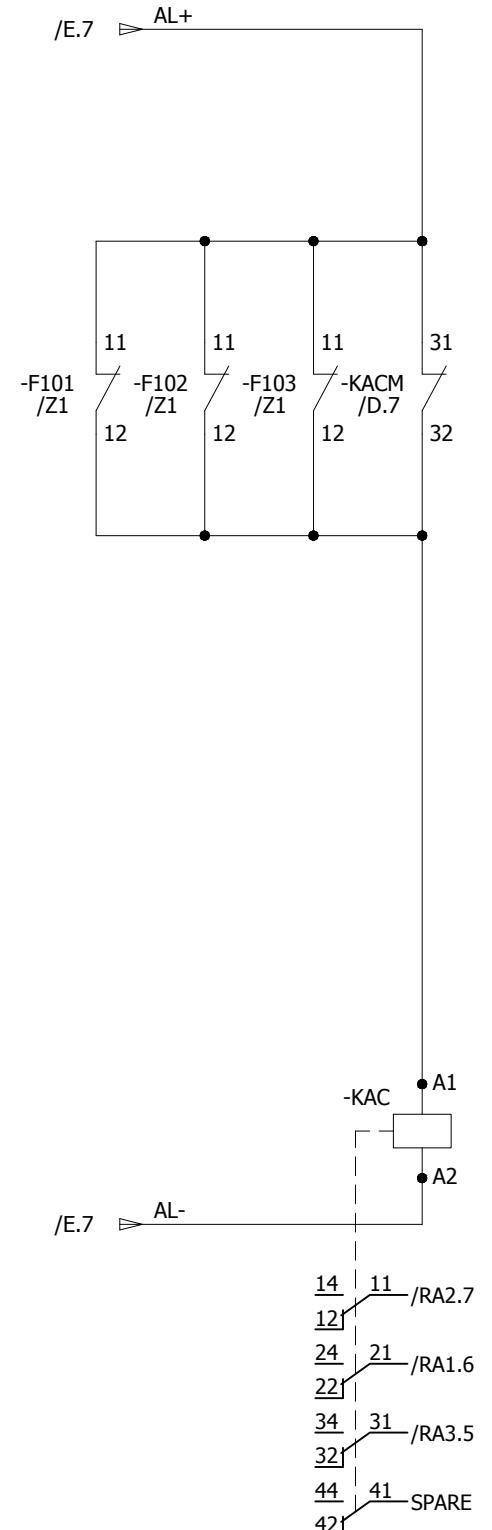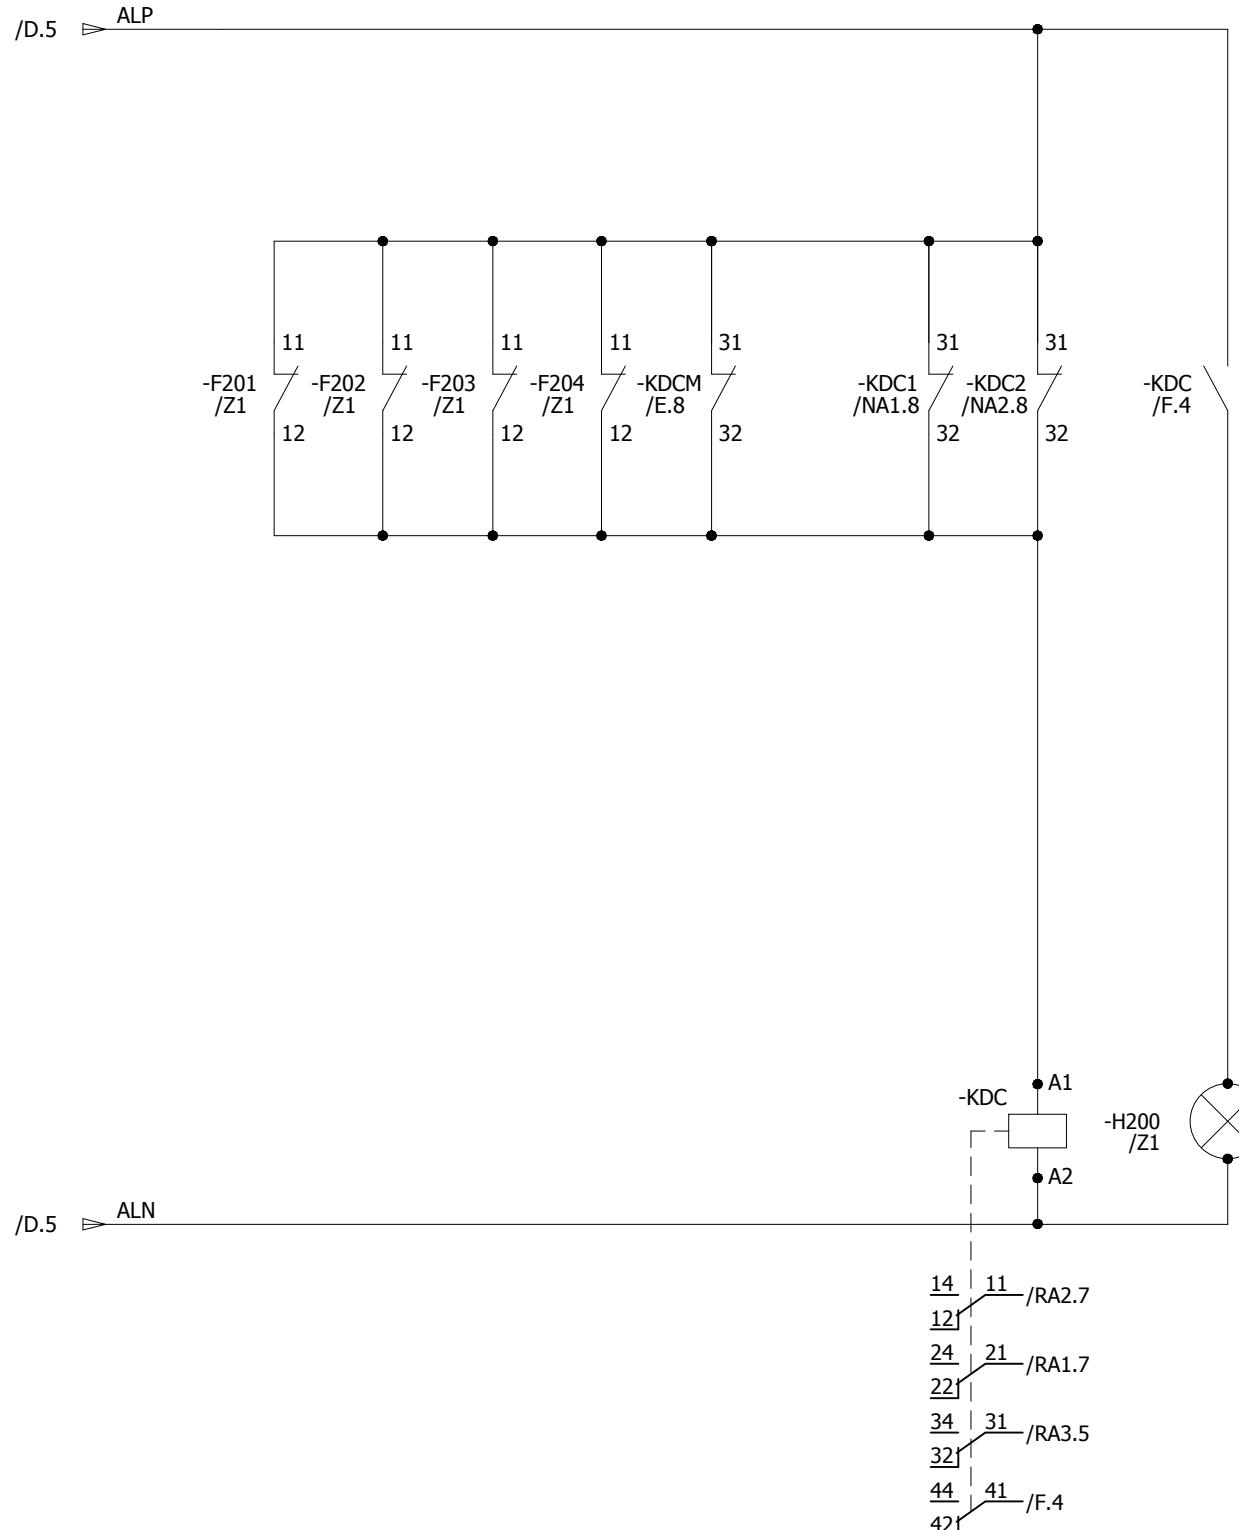

All information contained in this document is the exclusive property of GE GRID SOLUTIONS and shall not be used, copied or communicated to third parties without its prior authorization.


0	AS BUILT	20-11-2018	ASJ	Manufacturer  71-B Garden Block, New Garden Town, Lahore, Pakistan	Contractor  A GE and Alstom joint venture	Client  NATIONAL TRANSMISSION & DISPATCH COMPANY LIMITED (NTDC-WAPDA)	Project 220kV/132kV GIS SUBSTATION GHAZI ROAD, LAHORE	Title 132kV LINE RELAY PANEL (=E06+RP3) AC/DC SUPPLY FAILURE CIRCUIT	Drawing no. P60194-E-ELR-SC-004
REV.	DESCRIPTION	DATE	DRAWER						Project no. P-60194
									Sheet type F
									Sheet no. 09

## LINE DIFFERENTIAL PROTECTION

## OVERCURRENT PROTECTION

## RELAY SUPPLY

## RELAY SUPPLY

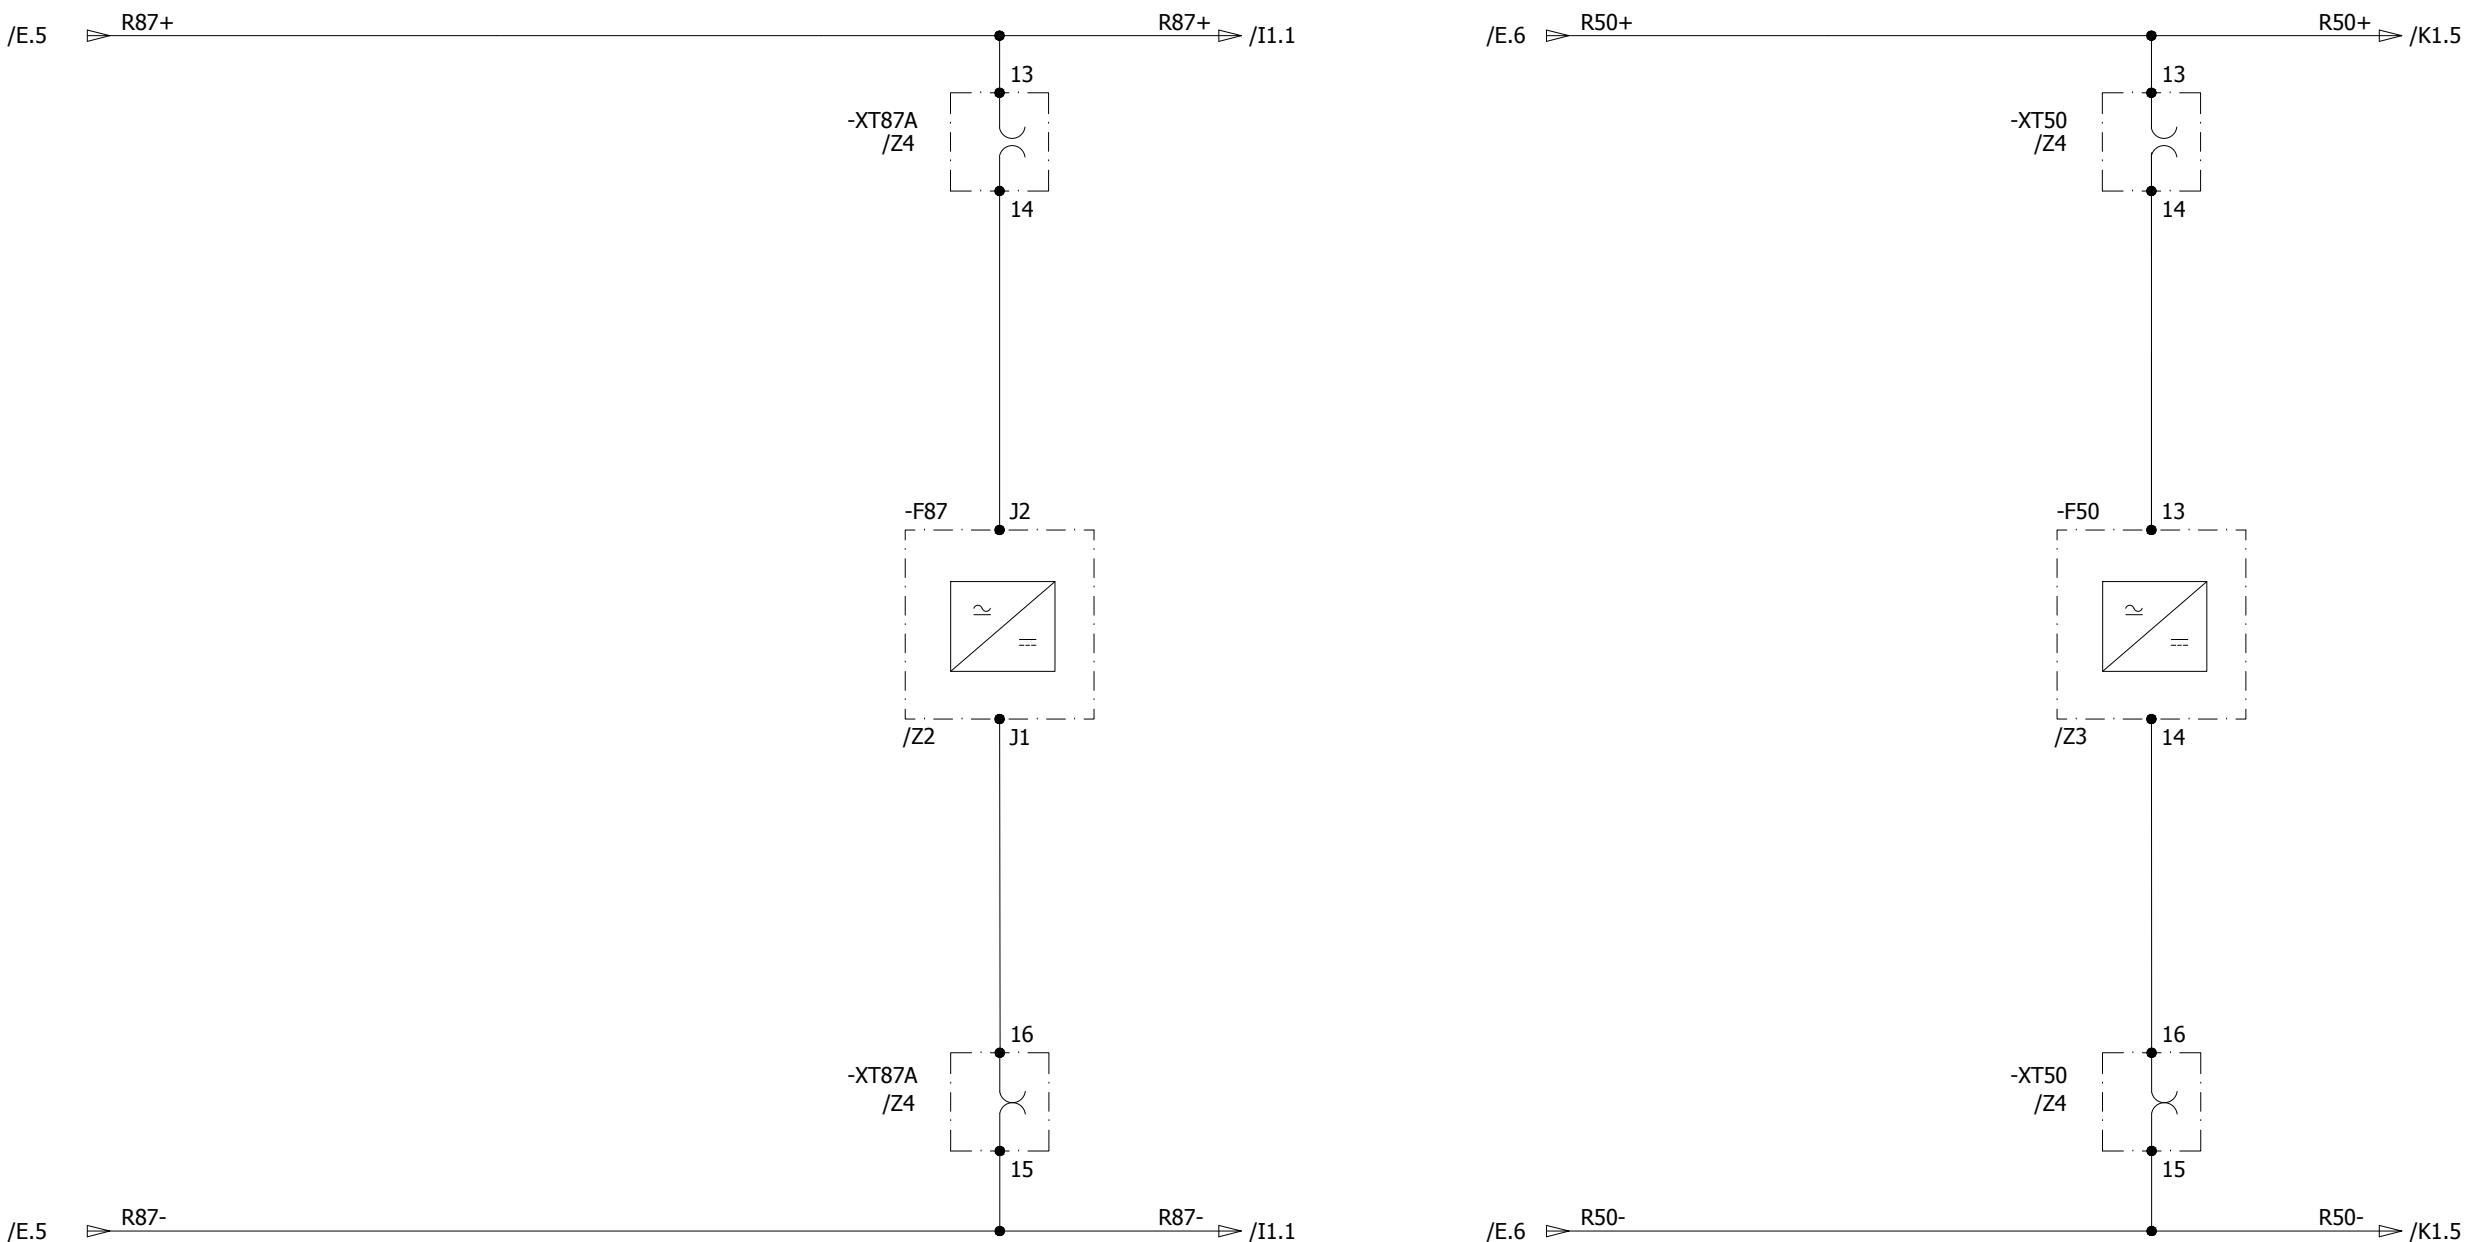

All information contained in this document is the exclusive property of GE GRID SOLUTIONS and shall not be used, copied or communicated to third parties without its prior authorization.

A  
B  
C  
D  
E  
F

A  
B  
C  
D  
E  
F

0	AS BUILT	20-11-2018	ASJ	Manufacturer  <b>EPESOL</b> 71-B Garden Block, New Garden Town, Lahore, Pakistan	Contractor  Grid Solutions A GE and Alstom joint venture	Client  NATIONAL TRANSMISSION & DISPATCH COMPANY LIMITED (NTDC-WAPDA)	Project 220kV/132kV GIS SUBSTATION GHAZI ROAD, LAHORE	Title 132kV LINE RELAY PANEL (=E06+RP3) RELAY POWER SUPPLY CIRCUIT	Drawing no. P60194-E-ELR-SC-004
REV.	DESCRIPTION	DATE	DRAWER						Project no. P-60194
									Sheet type G
									Sheet no. 10

1 2 3 4 5 6 7 8

TEST BLOCK

LINE DIFFERENTIAL PROTECTION  
RELAY


-XT87A

-F87

/Z4

/Z2

All information contained in this document is the exclusive property of GE GRID SOLUTIONS and shall not be used, copied or communicated to third parties without its prior authorization.

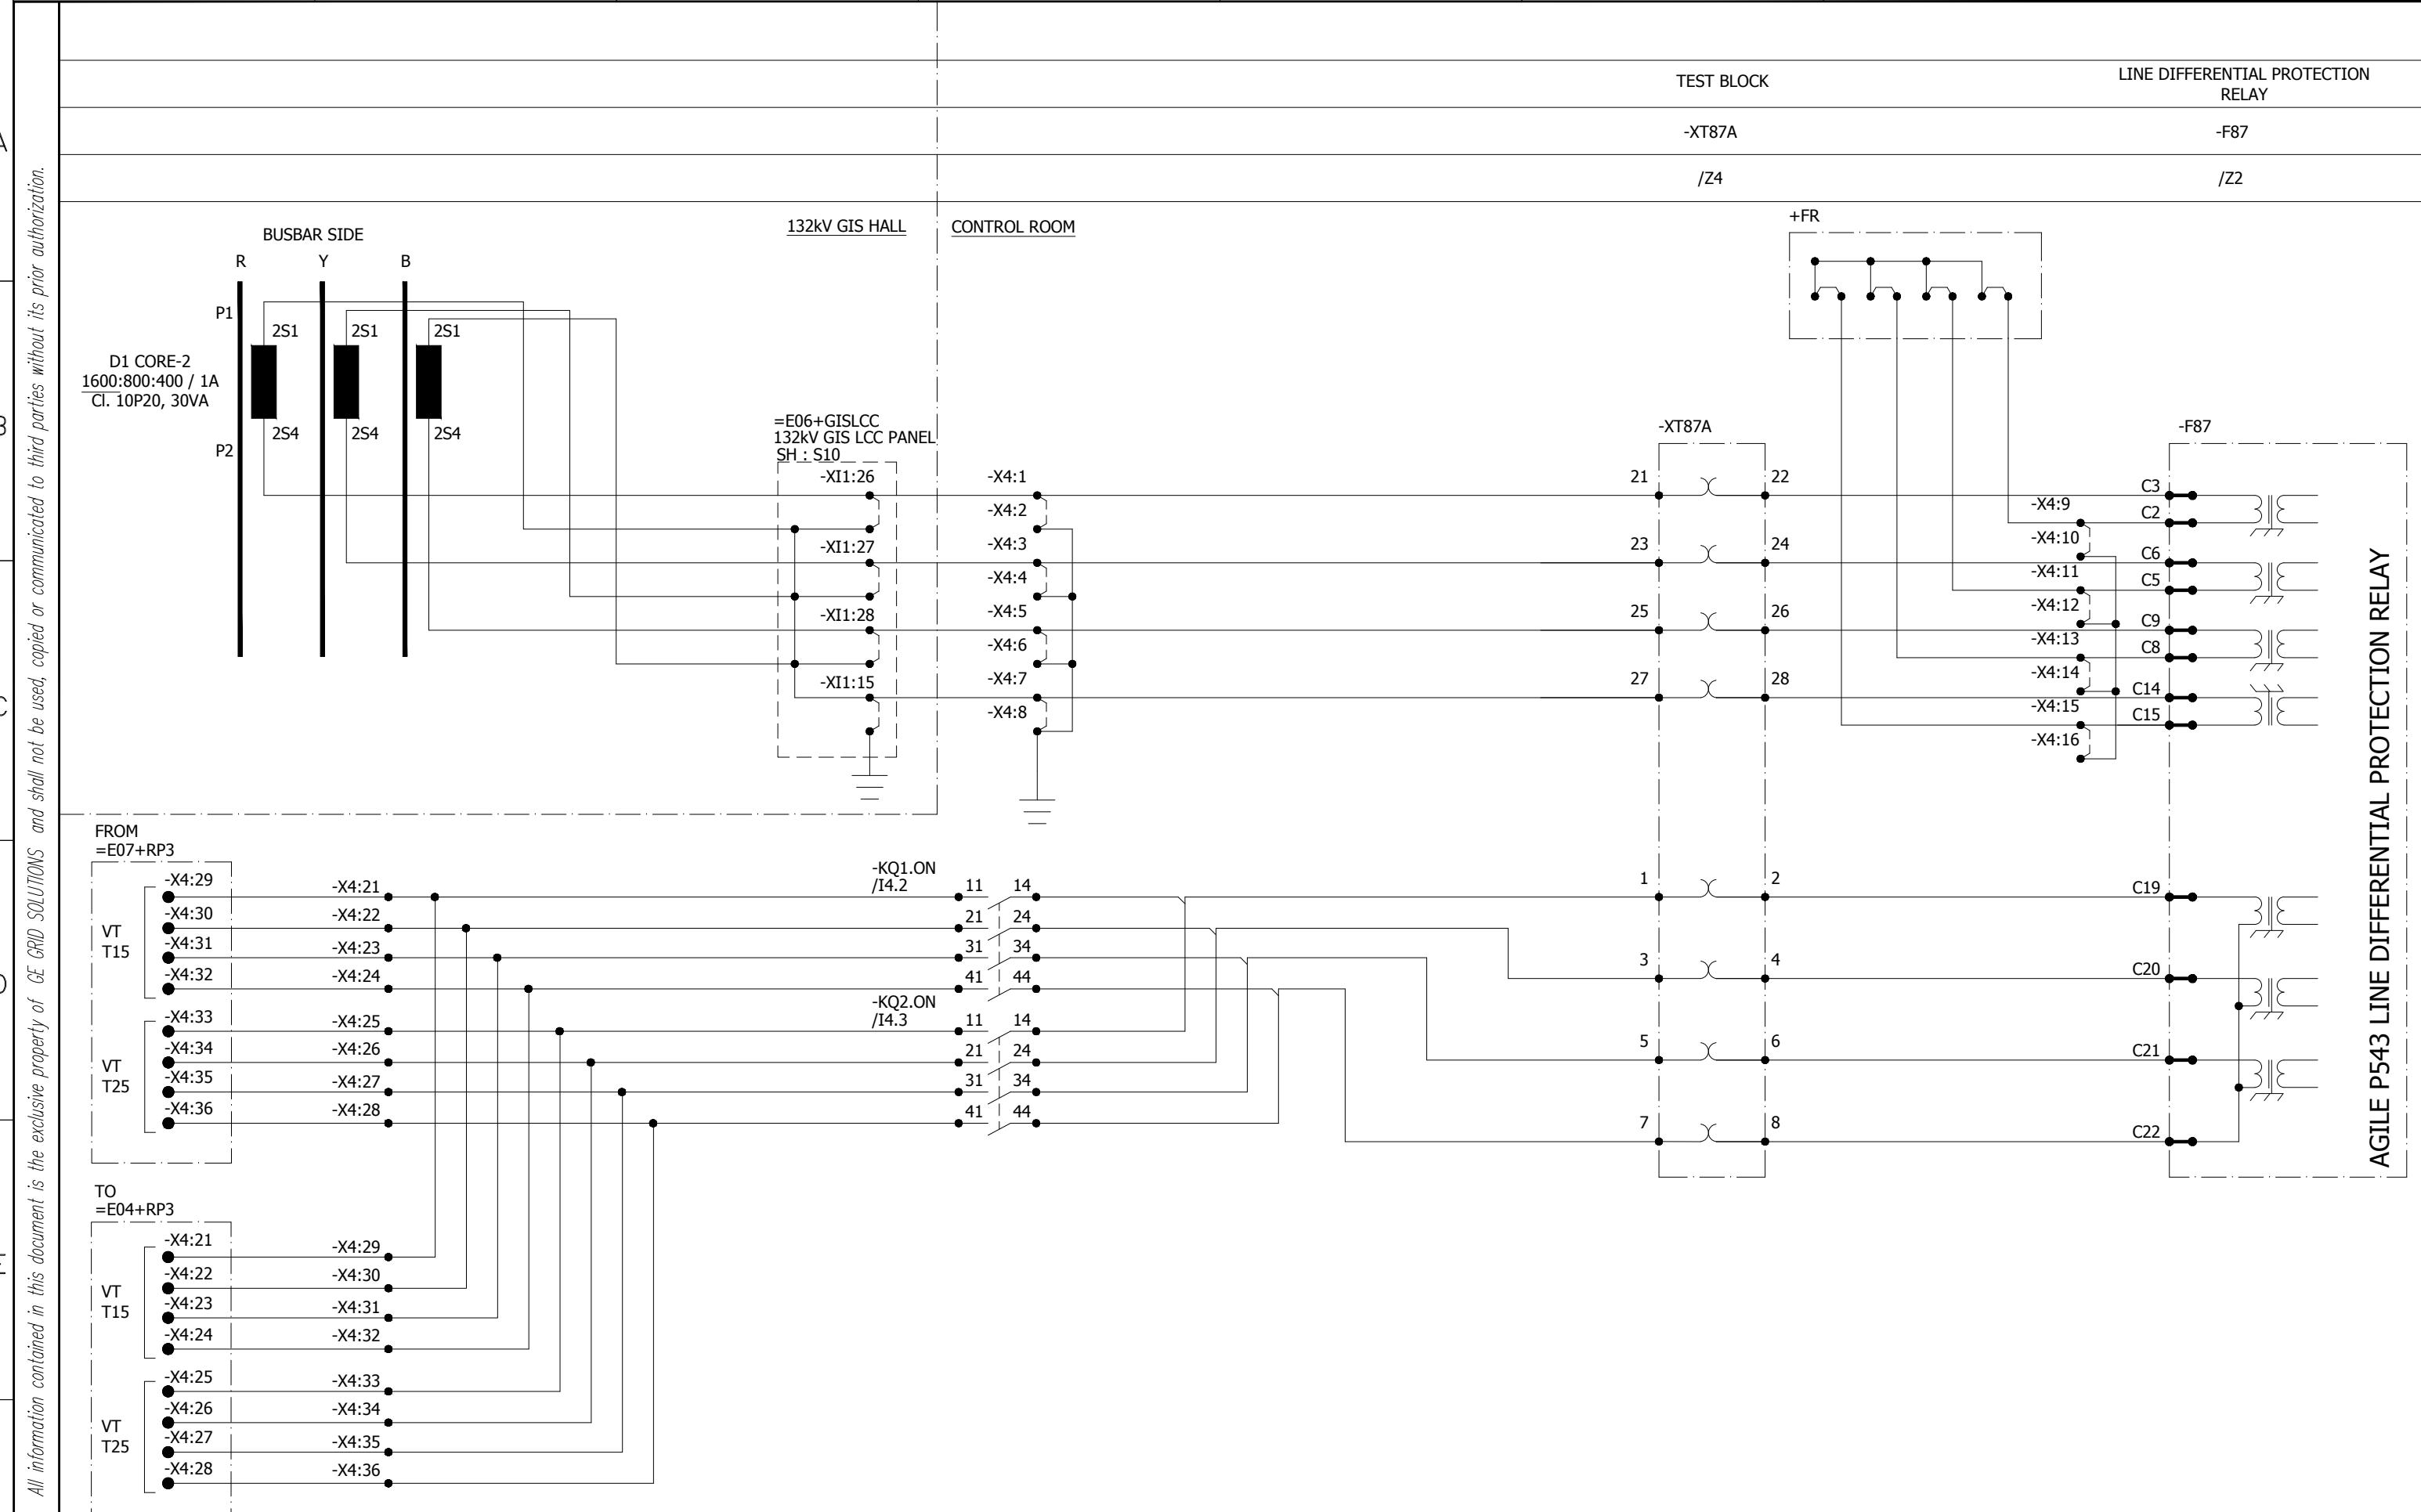


0	AS BUILT	20-11-2018	ASJ	Manufacturer	Contractor	Client	Project	Title	Drawing no.
				EPESOL	Grid Solutions	NATIONAL TRANSMISSION & DISPATCH COMPANY LIMITED (NTDC-WAPDA)	220kV/132kV GIS SUBSTATION GHAZI ROAD, LAHORE	132kV LINE RELAY PANEL (=E06+RP3) LINE DIFFERENTIAL PROTECTION CT/VT CIRCUIT	P60194-E-ELR-SC-004
REV.	DESCRIPTION	DATE	DRAWER						Project no. P-60194    Sheet type H1    Sheet no. 11

1 2 3 4 5 6 7 8

TEST BLOCK  
OVERCURRENT RELAY  
-XT50  
/Z4  
-F50  
/Z3


All information contained in this document is the exclusive property of GE GRID SOLUTIONS and shall not be used, copied or communicated to third parties without its prior authorization.

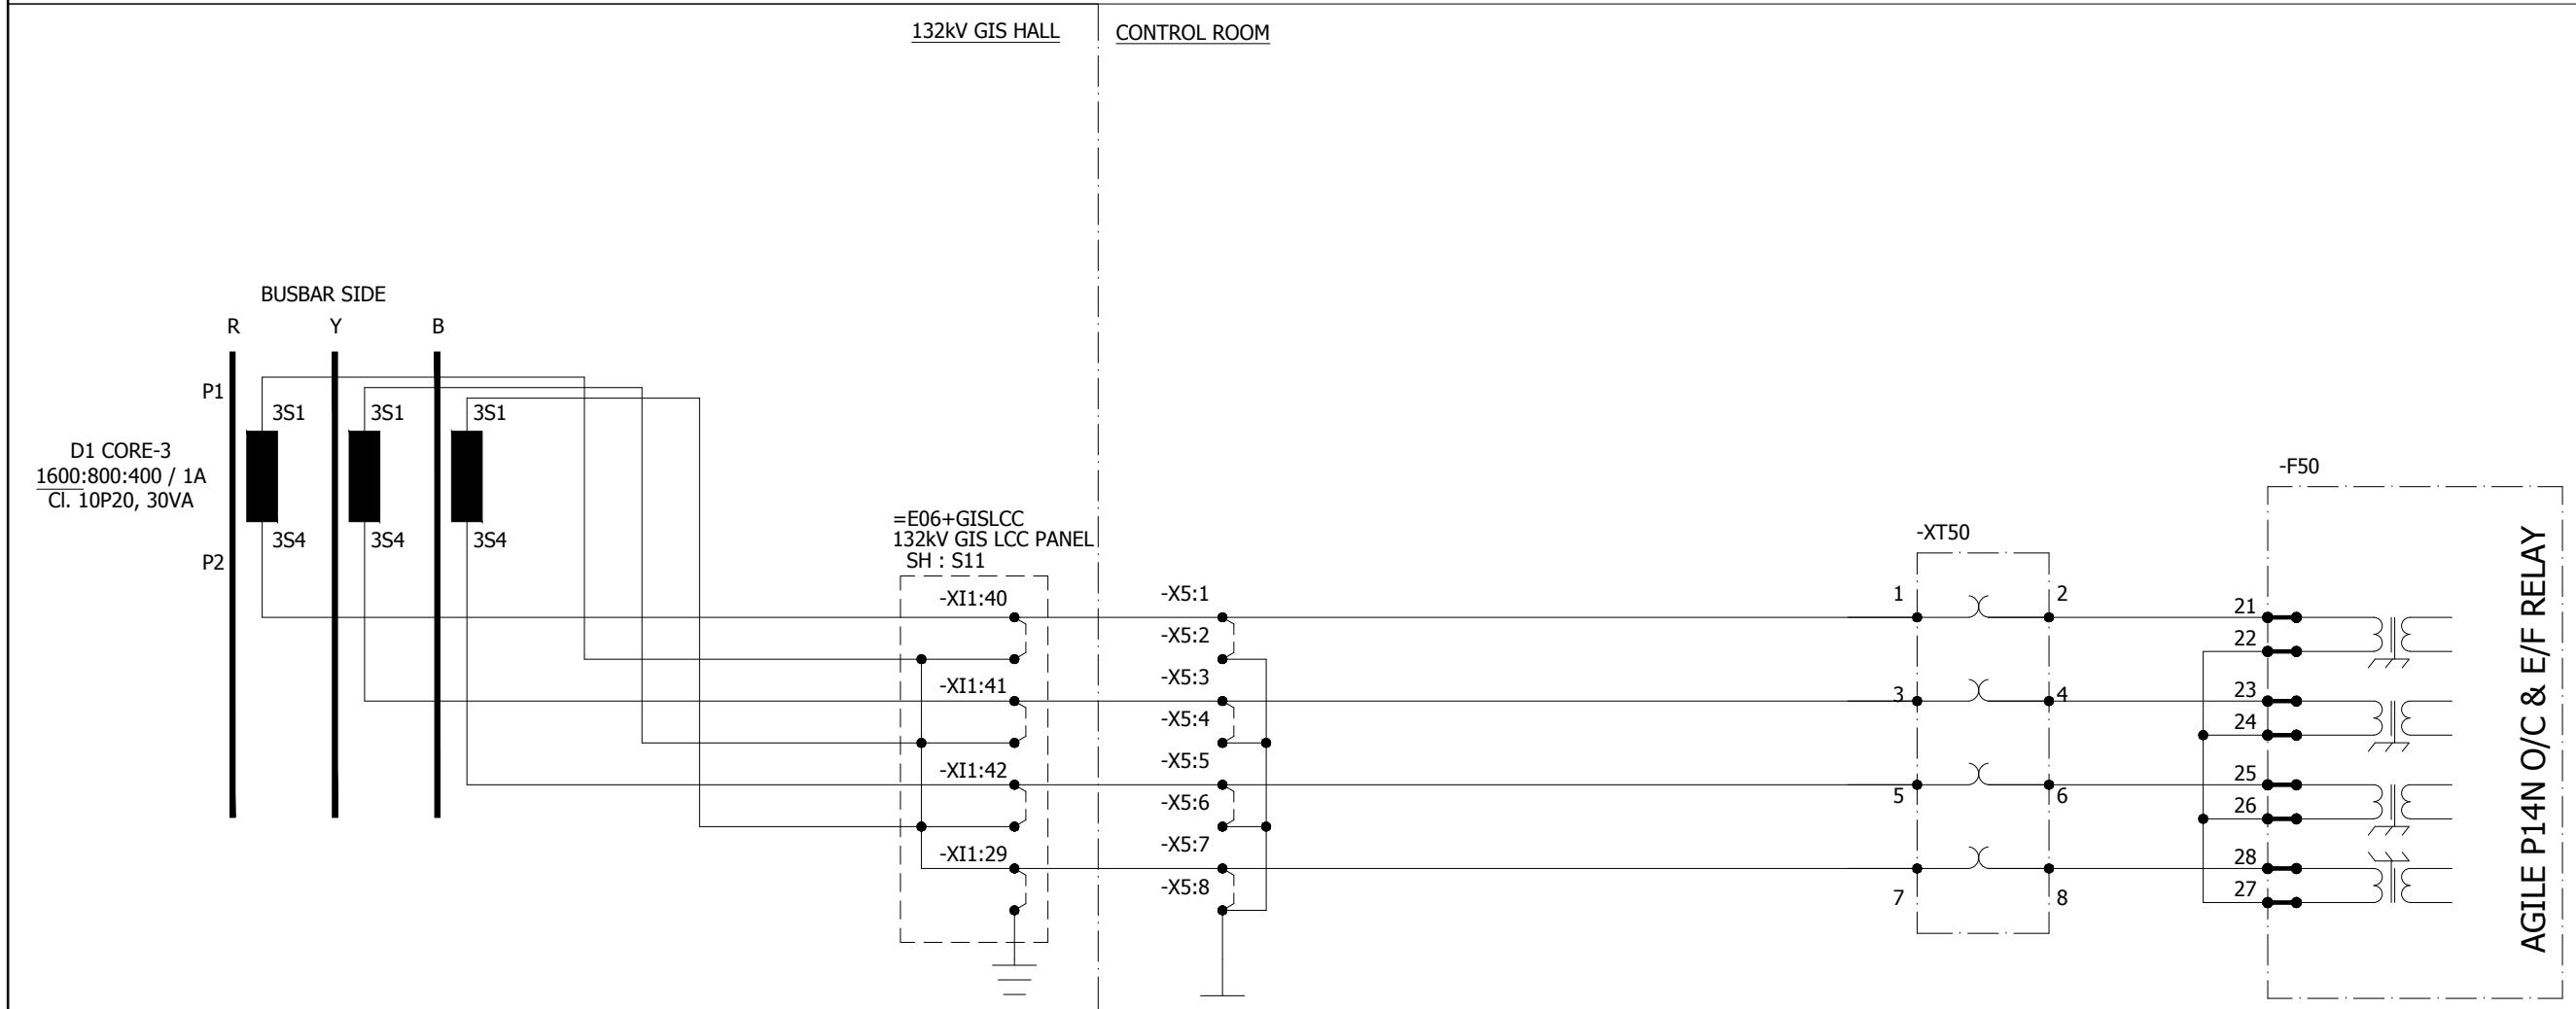

A  
B  
C  
D  
E  
F


0	AS BUILT	20-11-2018	ASJ	Manufacturer <b>EPE SOL</b> 71-B Garden Block, New Garden Town, Lahore, Pakistan	Contractor <b>Grid Solutions</b> A GE and Alstom joint venture	Client <b>NATIONAL TRANSMISSION &amp; DISPATCH COMPANY LIMITED (NTDC-WAPDA)</b>	Project 220kV/132kV GIS SUBSTATION GHAZI ROAD, LAHORE	Title 132kV LINE RELAY PANEL (=E06+RP3) O/C & E/F CT INPUTS	Drawing no. P60194-E-ELR-SC-004
REV.	DESCRIPTION	DATE	DRAWER						Project no. P-60194

## LINE DIFFERENTIAL PROTECTION RELAY

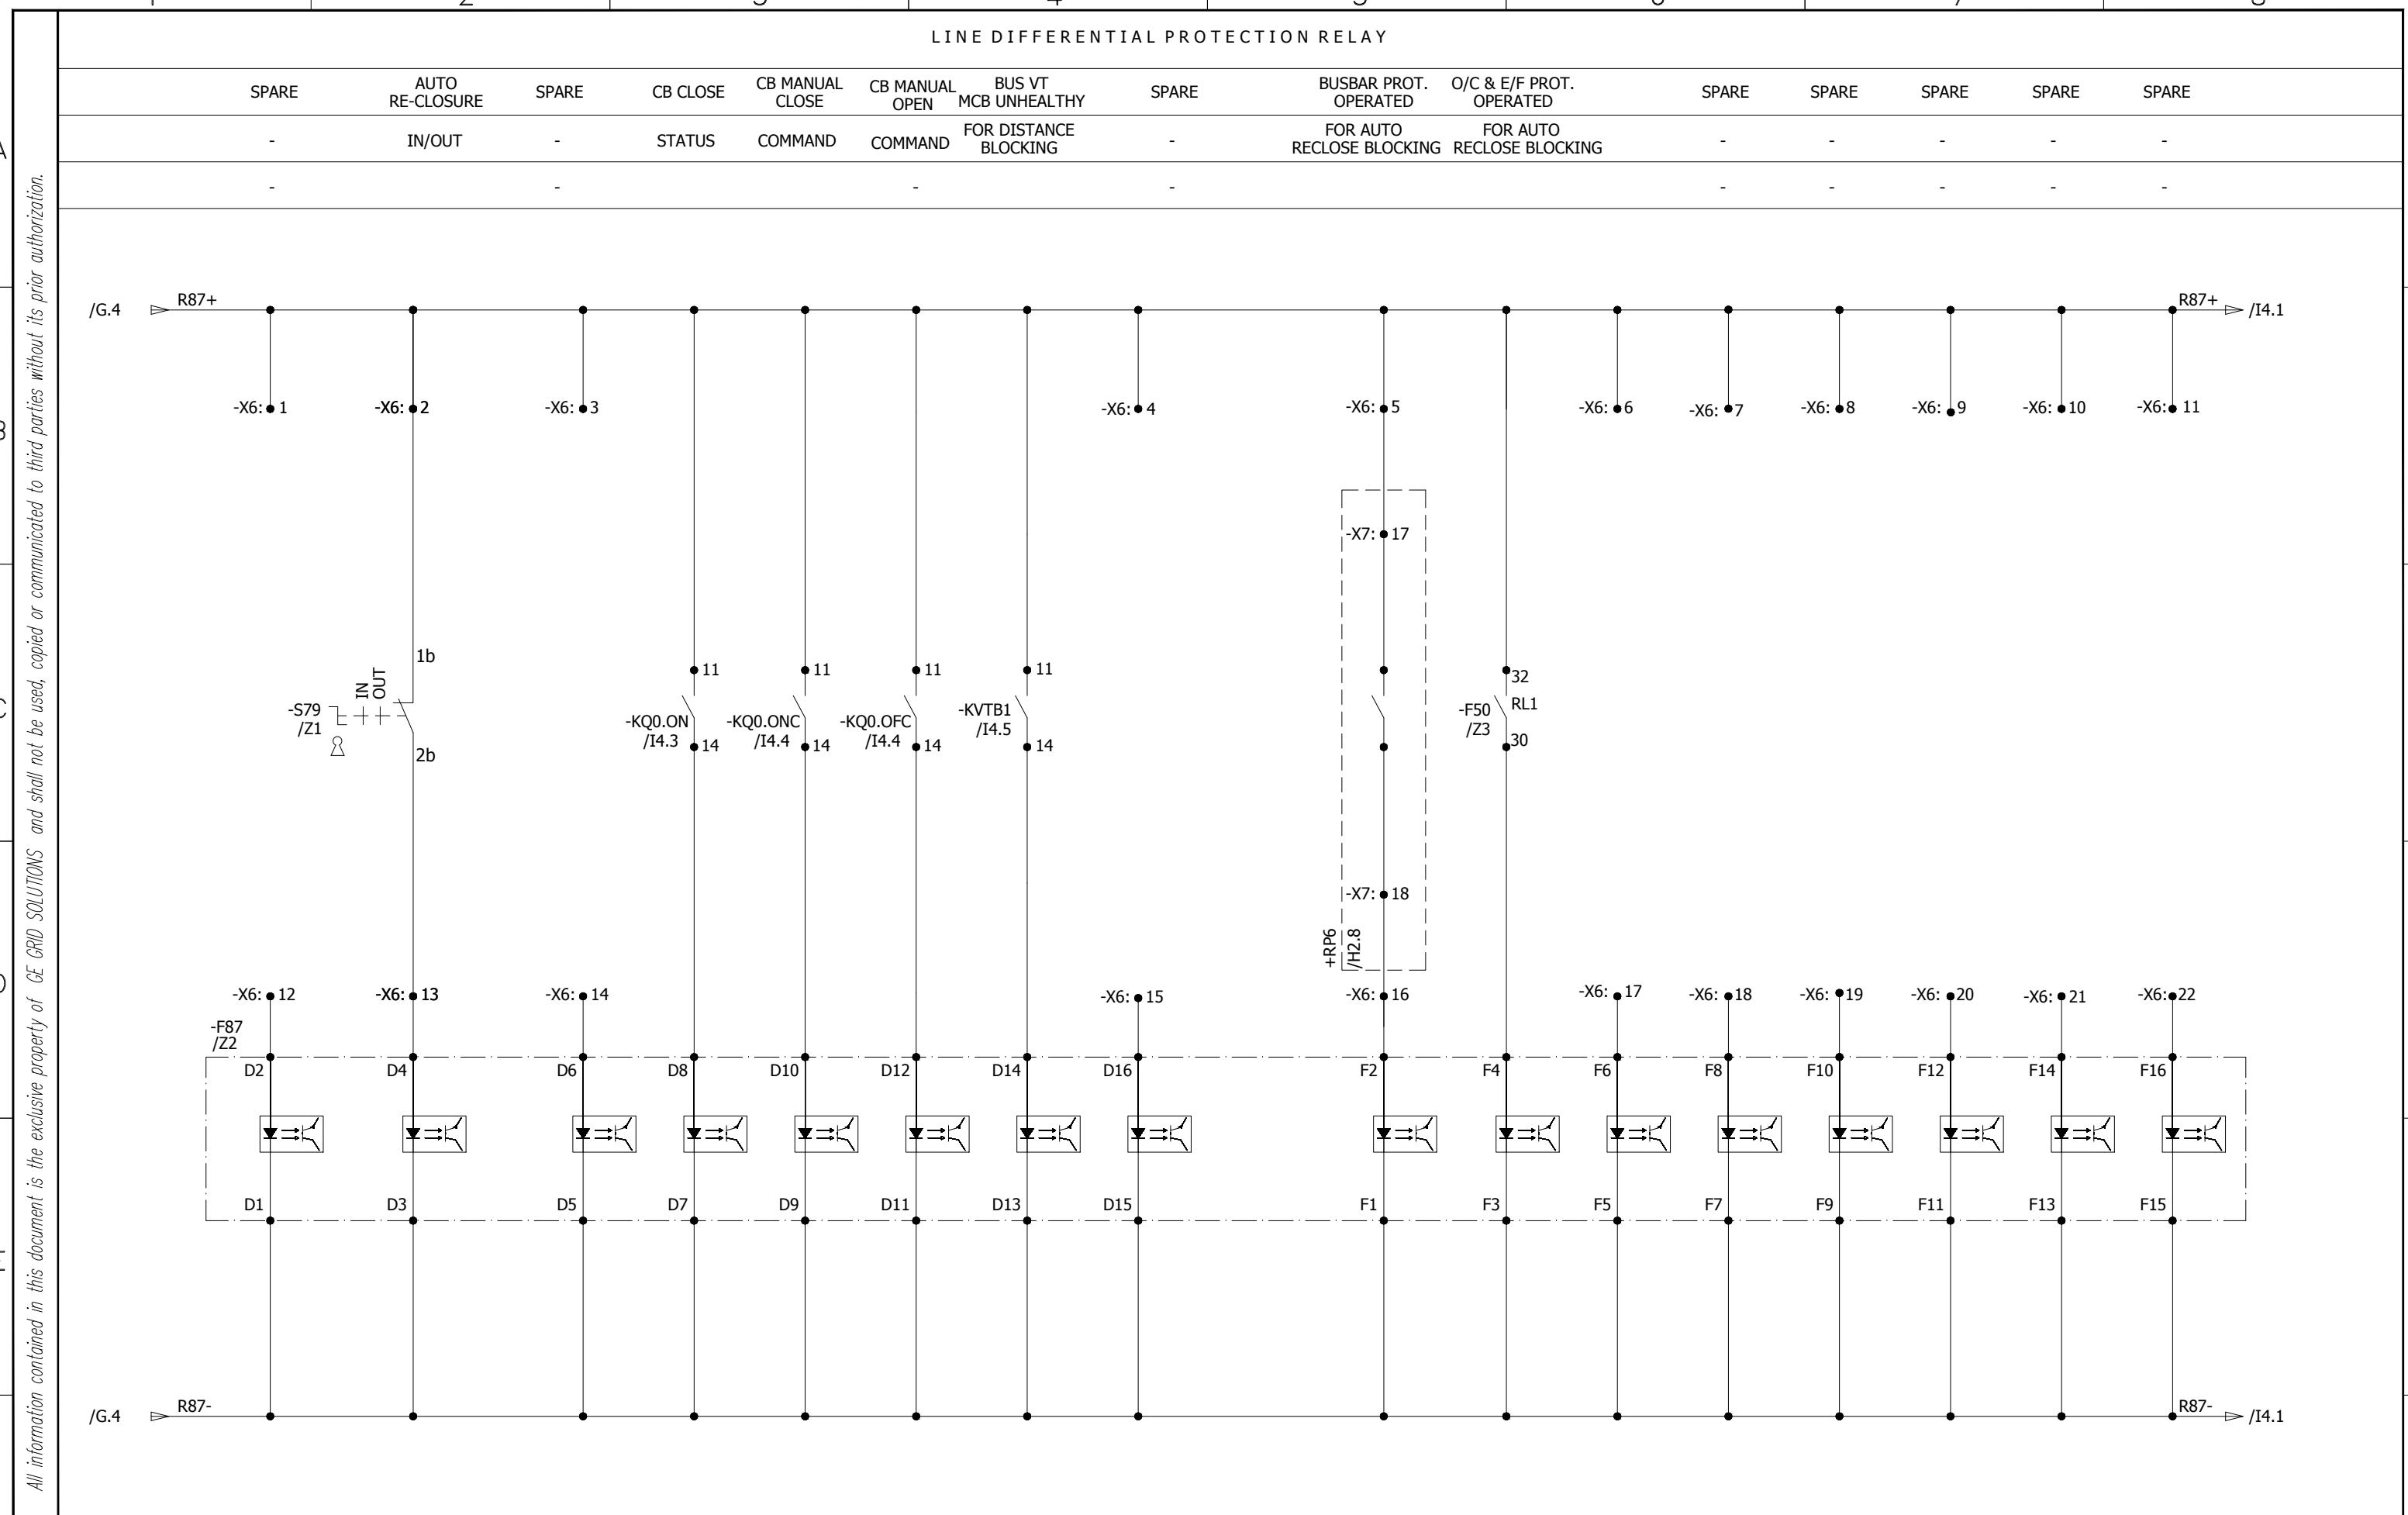

0	AS BUILT	20-11-2018	ASJ	Manufacturer <b>EPESOL</b> 71-B Garden Block, New Garden Town, Lahore, Pakistan	Contractor <b>Grid Solutions</b> A GE and Alstom joint venture	Client <b>NATIONAL TRANSMISSION &amp; DISPATCH COMPANY LIMITED</b> (=NTDC-WAPDA/NTDC-WAPDA)	Project 220KV/132KV GIS SUBSTATION GHAZI ROAD, LAHORE	Title 132KV LINE RELAY PANEL (=E06+RP3) LINE DIFFERENTIAL RELAY INPUTS	Drawing no. P60194-E-ELR-SC-004
									Project no. P-60194
REV.	DESCRIPTION	DATE	DRAWER						Sheet type I1
									Sheet no. 13

All information contained in this document is the exclusive property of GE GRID SOLUTIONS and shall not be used, copied or communicated to third parties without its prior authorization.

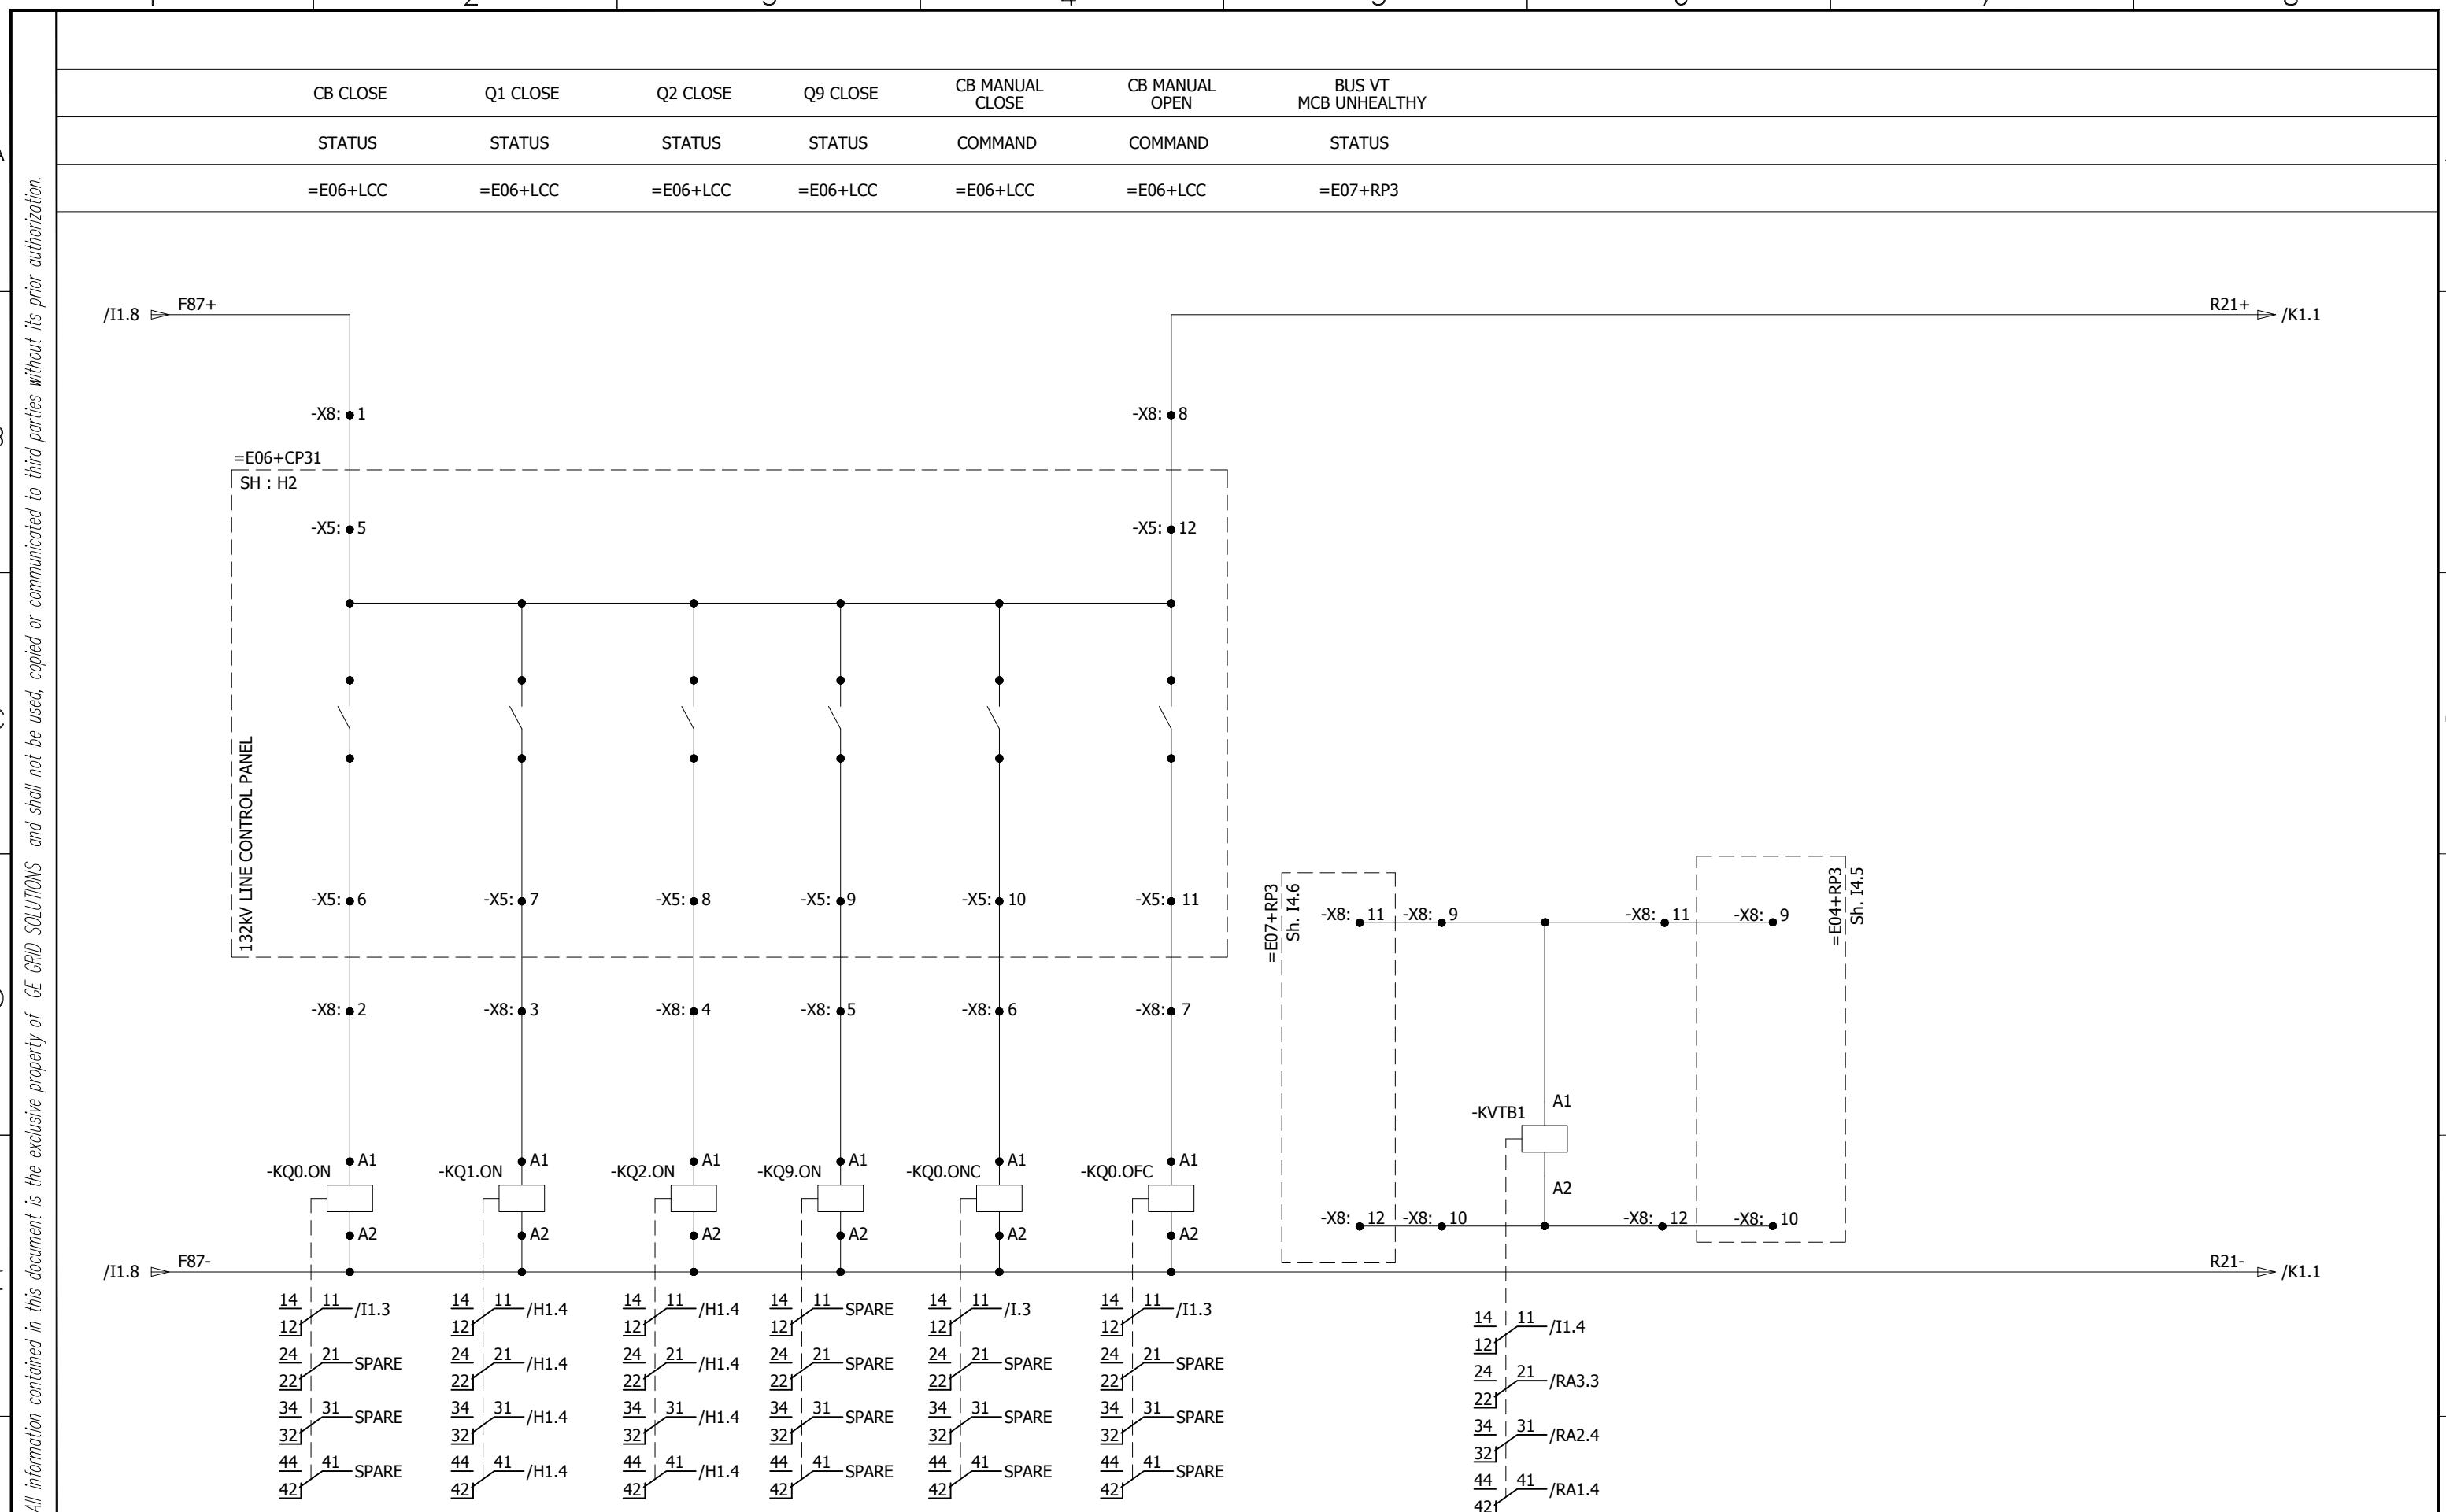


0	AS BUILT	20-11-2018	ASJ	Manufacturer  EPESOL 71-B Garden Block, New Garden Town, Lahore, Pakistan	Contractor  Grid Solutions A GE and Alstom joint venture	Client  NATIONAL TRANSMISSION & DISPATCH COMPANY LIMITED (NTDC-WAPDA)	Project 220kV/132kV GIS SUBSTATION GHAZI ROAD, LAHORE	Title 132kV LINE RELAY PANEL (=E06+RP3) SYSTEM INPUTS	Drawing no. P60194-E-ELR-SC-008		
REV.	DESCRIPTION	DATE	DRAWER						Project no. P-60194	Sheet type I4	Sheet no. 14
1	2	3	4	5	6	7	8				

## LINE DIFFERENTIAL PROTECTION GENERAL TRIP


O/C &amp; E/F PROTECTION TRIP    TRIP RELAY RESET

All information contained in this document is the exclusive property of GE GRID SOLUTIONS and shall not be used, copied or communicated to third parties without its prior authorization.

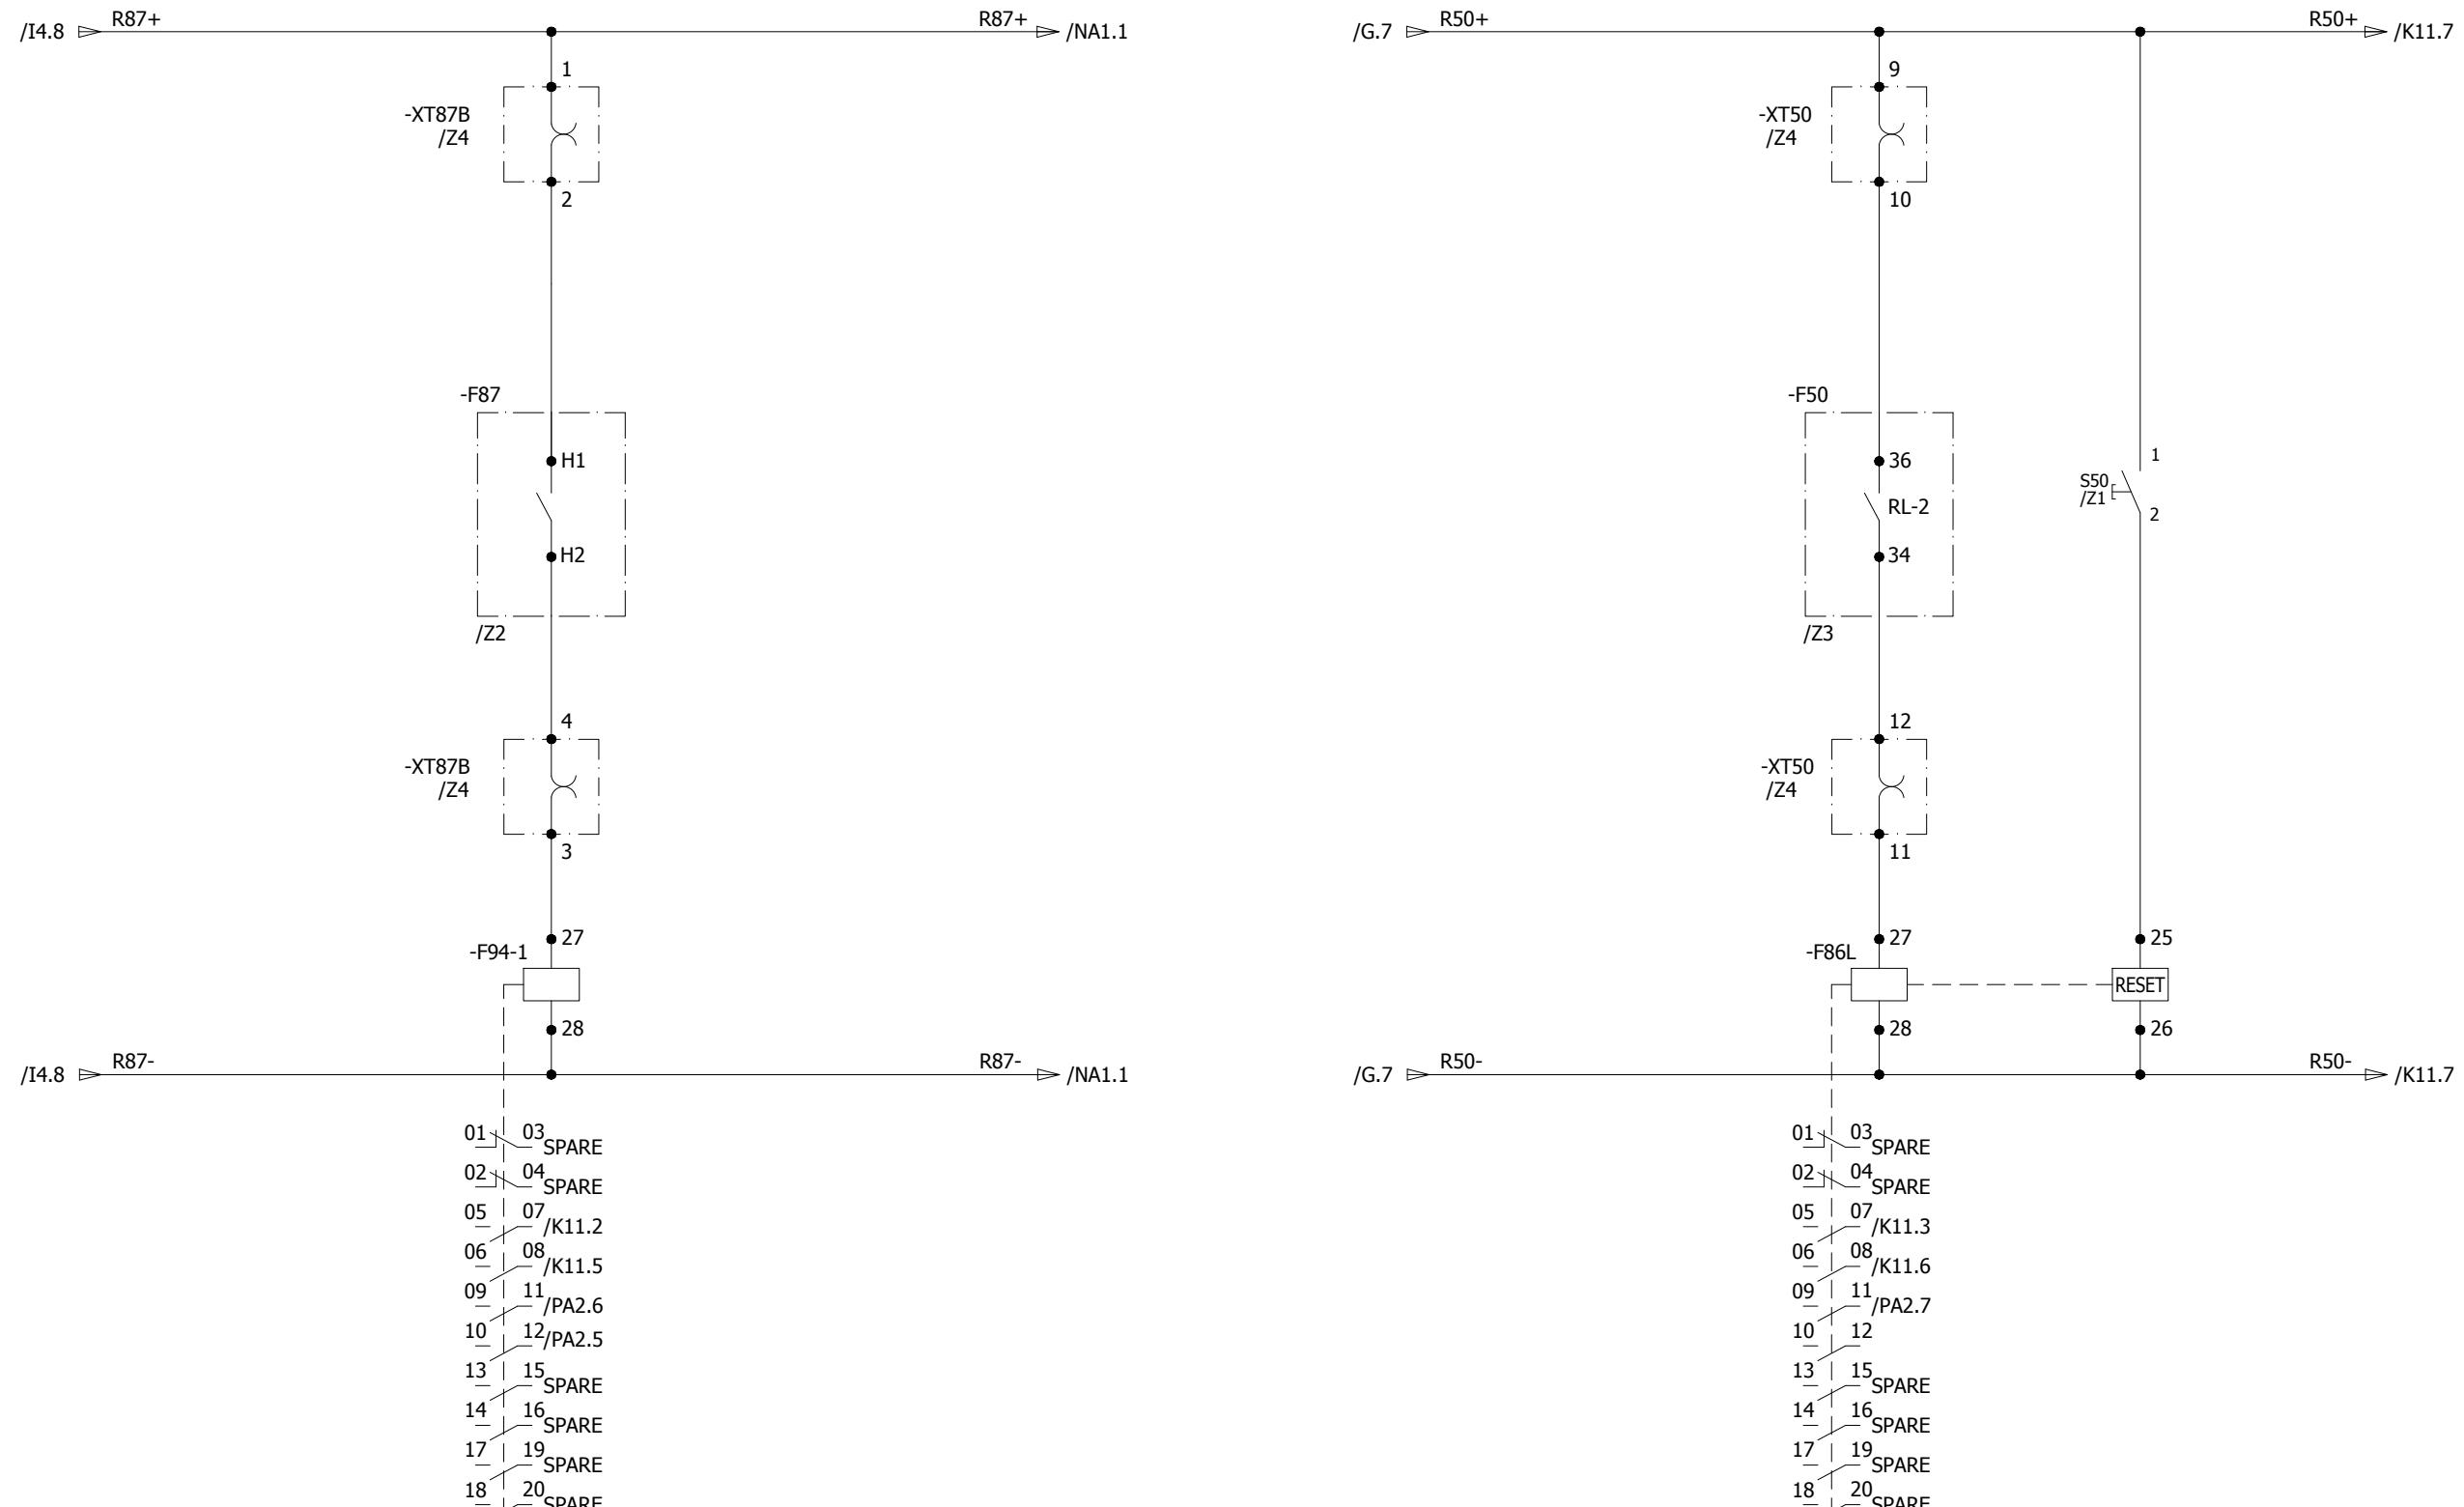

0	AS BUILT	20-11-2018	ASJ	Manufacturer  EPESOL 71-B Garden Block, New Garden Town, Lahore, Pakistan	Contractor  Grid Solutions A GE and Alstom joint venture	Client  NATIONAL TRANSMISSION & DISPATCH COMPANY LIMITED (NTDC-WAPDA)	Project 220kV/132kV GIS SUBSTATION GHAZI ROAD, LAHORE	Title 132kV LINE RELAY PANEL (=E06+RP3) PROTECTION TRIPS	Drawing no. P60194-E-ELR-SC-004		
REV.	DESCRIPTION	DATE	DRAWER						Project no. P-60194	Sheet type K1	Sheet no. 15
1	2	3	4	5	6	7	8				

1 2 3 4 5 6 7 8

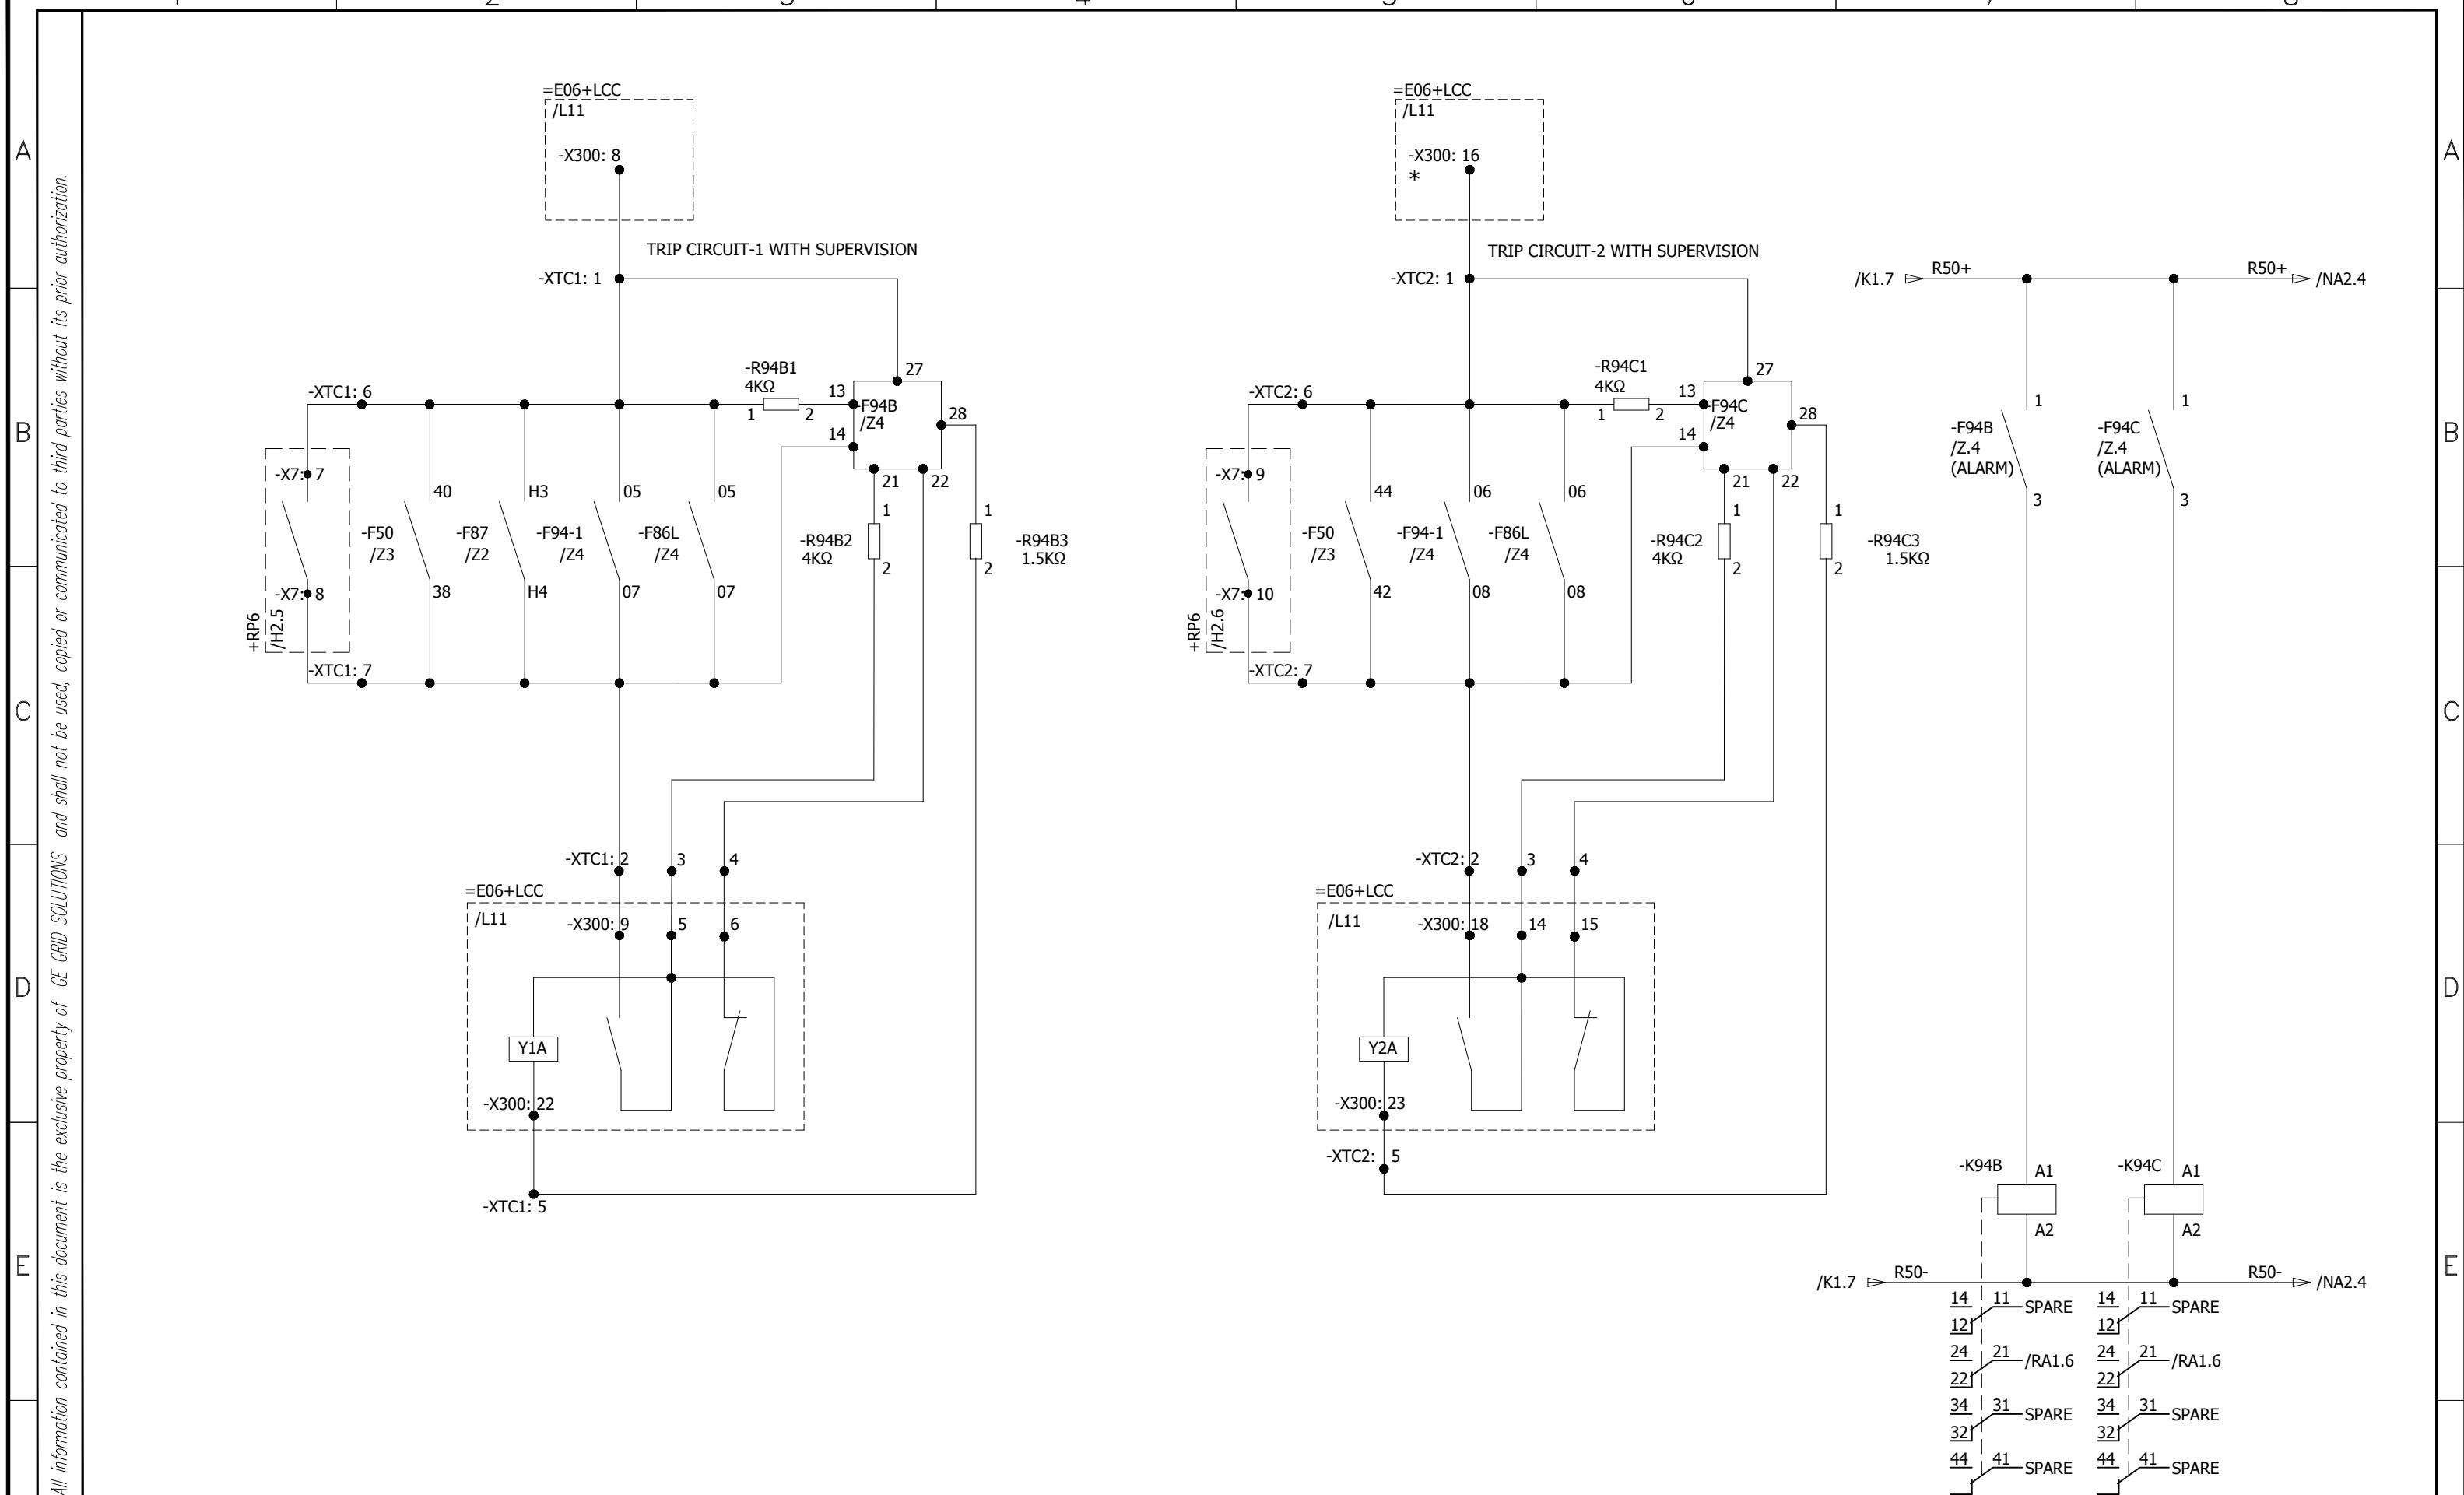


0	AS BUILT	20-11-2018	ASJ	Manufacturer <b>EPE SOL</b> 71-B Garden Block, New Garden Town, Lahore, Pakistan	Contractor <b>Grid Solutions</b> A GE and Alstom joint venture	Client <b>NATIONAL TRANSMISSION &amp; DISPATCH COMPANY LIMITED (NTDC-WAPDA)</b>	Project 220KV/132KV GIS SUBSTATION GHAZI ROAD, LAHORE	Title 132KV LINE RELAY PANEL (=E06+RP3) TRIP CIRCUIT SUPERVISION CIRCUIT	Drawing no. P60194-E-ELR-SC-004
REV.	DESCRIPTION	DATE	DRAWER						Project no. P-60194
									Sheet type K11
									Sheet no. 16

1 2 3 4 5 6 7 8

## LINE DIFFERENTIAL PROTECTION

RED-PH TRIP	YELLOW-PH TRIP	BLUE-PH TRIP	ZONE-1 TRIP	ZONE-2 TRIP\ZONE-3 TRIP	POWER SWING DETECT	SWITCH ON TO FAULT	AUTORECLOSURE OPERATED	AUTORECLOSURE BLOCKED	LINE DIFF. RELAY FAULTY	R87+ DC SUPPLY MONITORING
-------------	----------------	--------------	-------------	-------------------------	--------------------	--------------------	------------------------	-----------------------	-------------------------	---------------------------

+KDC1

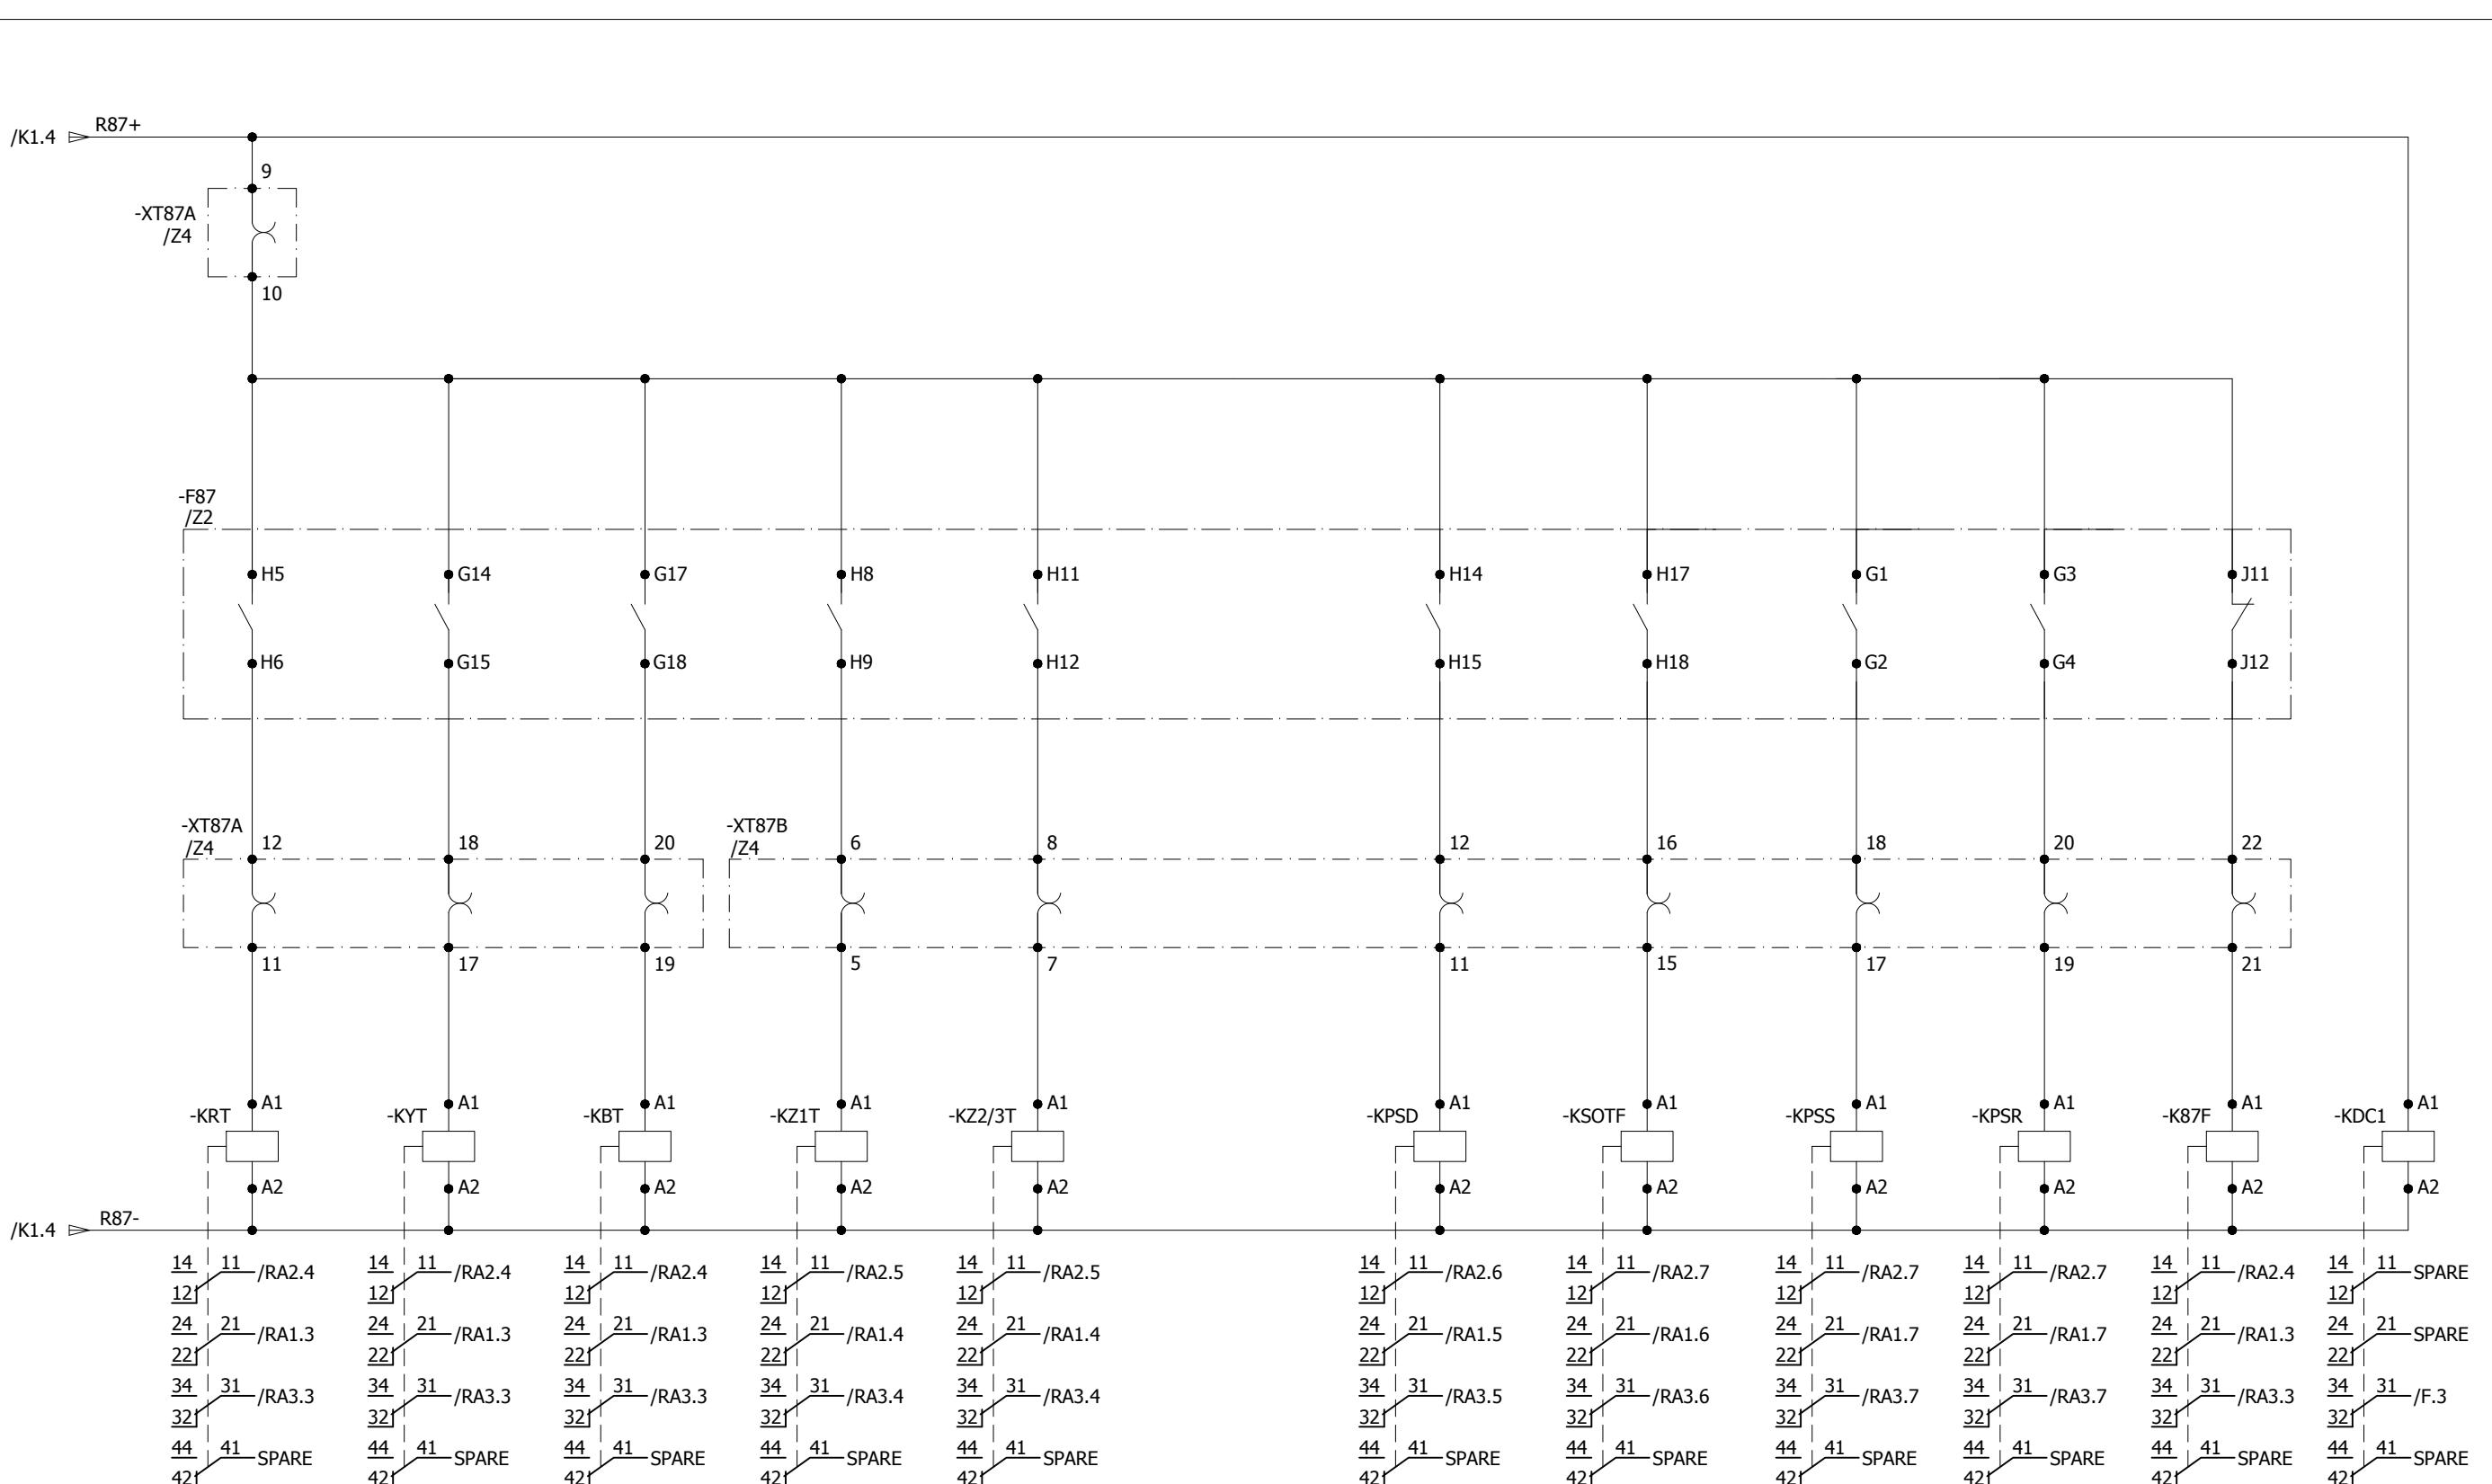

All information contained in this document is the exclusive property of GE GRID SOLUTIONS and shall not be used, copied or communicated to third parties without its prior authorization.

A

A

B

B

C

C

D

D

E

E

F

F


0	AS BUILT	20-11-2018	ASJ	Manufacturer <b>EPE SOL</b> 71-B Garden Block, New Garden Town, Lahore, Pakistan	Contractor <b>GE Grid Solutions</b> A GE and Alstom joint venture	Client <b>NATIONAL TRANSMISSION &amp; DISPATCH COMPANY LIMITED (NTDC-WAPDA)</b>	Project 220kV/132kV GIS SUBSTATION GHAZI ROAD, LAHORE	Title 132kV LINE RELAY PANEL (=E06+RP3) SYSTEM ALARMS	Drawing no. P60194-E-ELR-SC-004
REV.	DESCRIPTION	DATE	DRAWER						Project no. P-60194

O/C &amp; E/F RELAY ALARMS

R50+ DC SUPPLY  
MONITORINGO/C & E/F  
TRIPPROTECTION  
FAULTY

+KDC2

/Z3

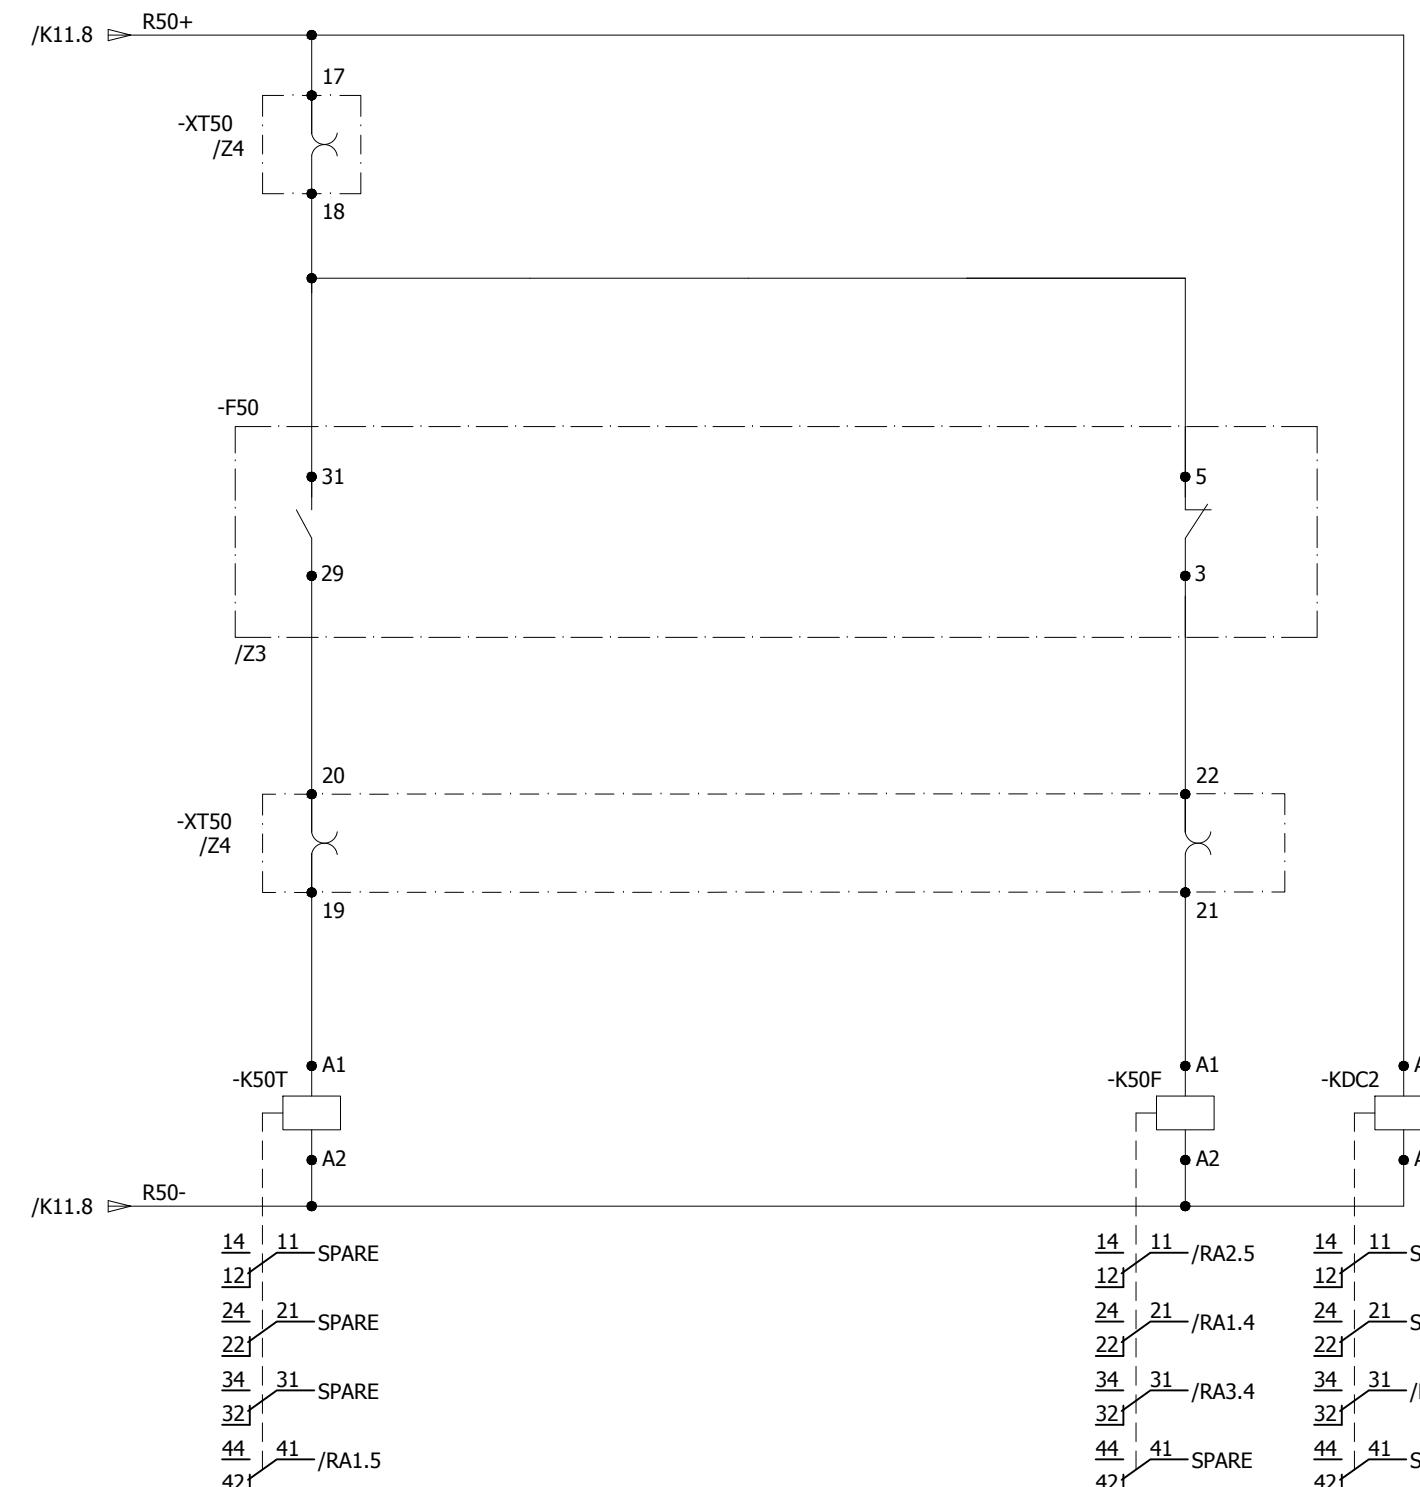

All information contained in this document is the exclusive property of GE GRID SOLUTIONS and shall not be used, copied or communicated to third parties without its prior authorization.

A

B

C

D

E

F

A

B

C

D

E

F

0	AS BUILT	20-11-2018	ASJ	Manufacturer <b>EPE SOL</b> 71-B Garden Block, New Garden Town, Lahore, Pakistan	Contractor <b>Grid Solutions</b> A GE and Alstom joint venture	Client <b>NATIONAL TRANSMISSION &amp; DISPATCH COMPANY LIMITED (NTDC-WAPDA)</b>	Project 220kV/132kV GIS SUBSTATION GHAZI ROAD, LAHORE	Title 132kV LINE RELAY PANEL (=E06+RP3) SYSTEM ALARMS	Drawing no. P60194-E-ELR-SC-004
REV.	DESCRIPTION	DATE	DRAWER						Project no. P-60194
									Sheet type NA2
									Sheet no. 18

All information contained in this document is the exclusive property of GE GRID SOLUTIONS and shall not be used, copied or communicated to third parties without its prior authorization.

A

B

C

D

E

F

A


B

C

D

E


F

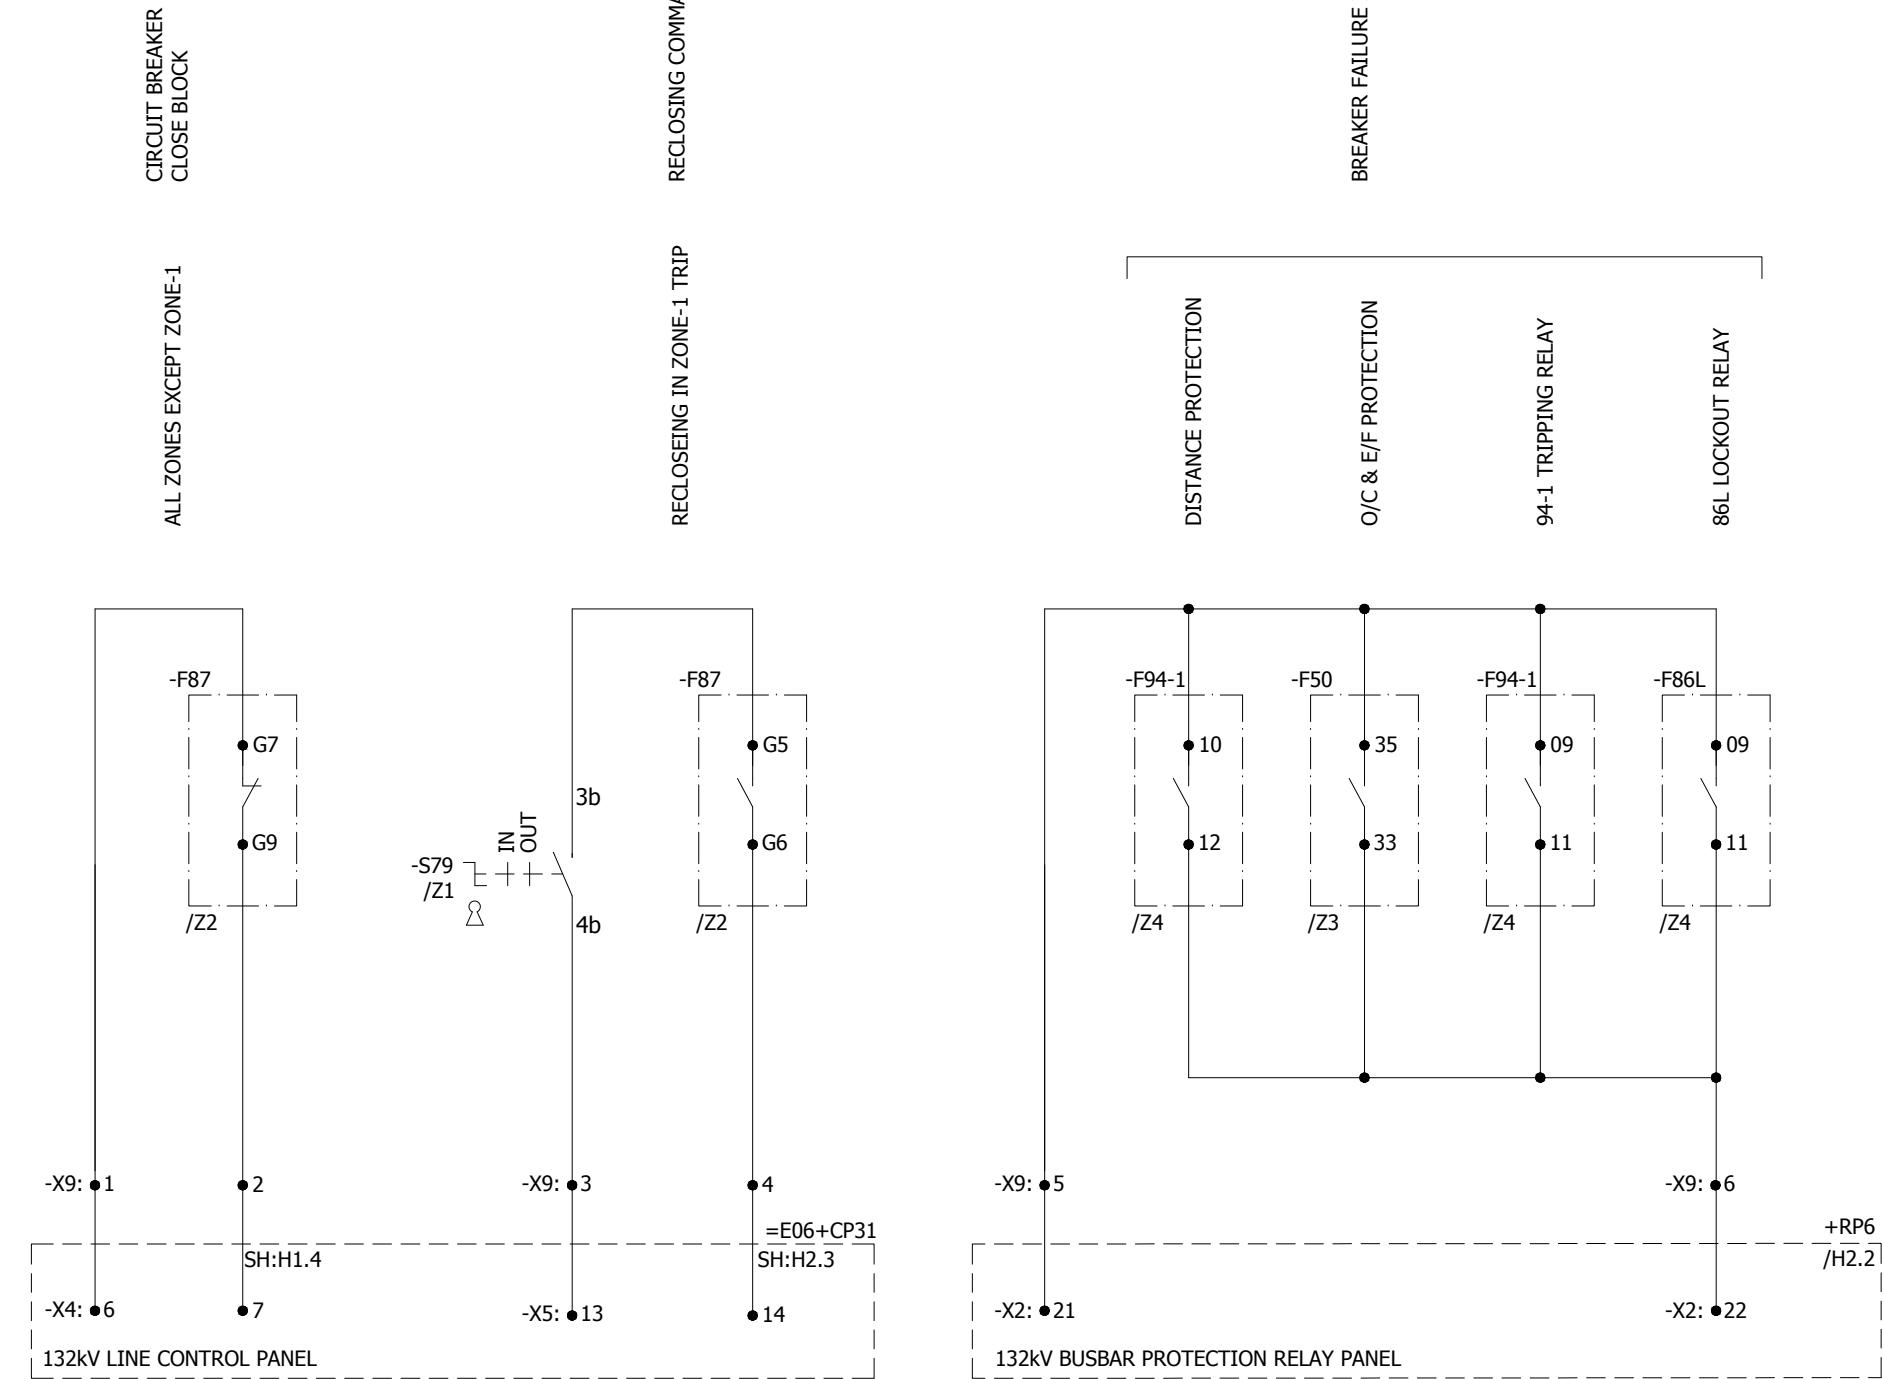

0	AS BUILT		20-11-2018	ASJ	Manufacturer  <b>EPESOL</b> 71-B Garden Block, New Garden Town, Lahore, Pakistan	Contractor  <b>Grid Solutions</b> A GE and Alstom joint venture	Client  <b>NATIONAL TRANSMISSION &amp; DISPATCH COMPANY LIMITED (NTDC-WAPDA)</b>	Project 220kV/132kV GIS SUBSTATION GHAZI ROAD, LAHORE	Title 132kV LINE RELAY PANEL (=E06+RP3) PROTECTION INTER-CIRCUITS	Drawing no. P60194-E-ELR-SC-004	
REV.	DESCRIPTION		DATE	DRAWER					Project no. P-60194	Sheet type PA2	Sheet no. 19
1	2	3	4	5	6	7	8				

All information contained in this document is the exclusive property of GE GRID SOLUTIONS and shall not be used, copied or communicated to third parties without its prior authorization.

A

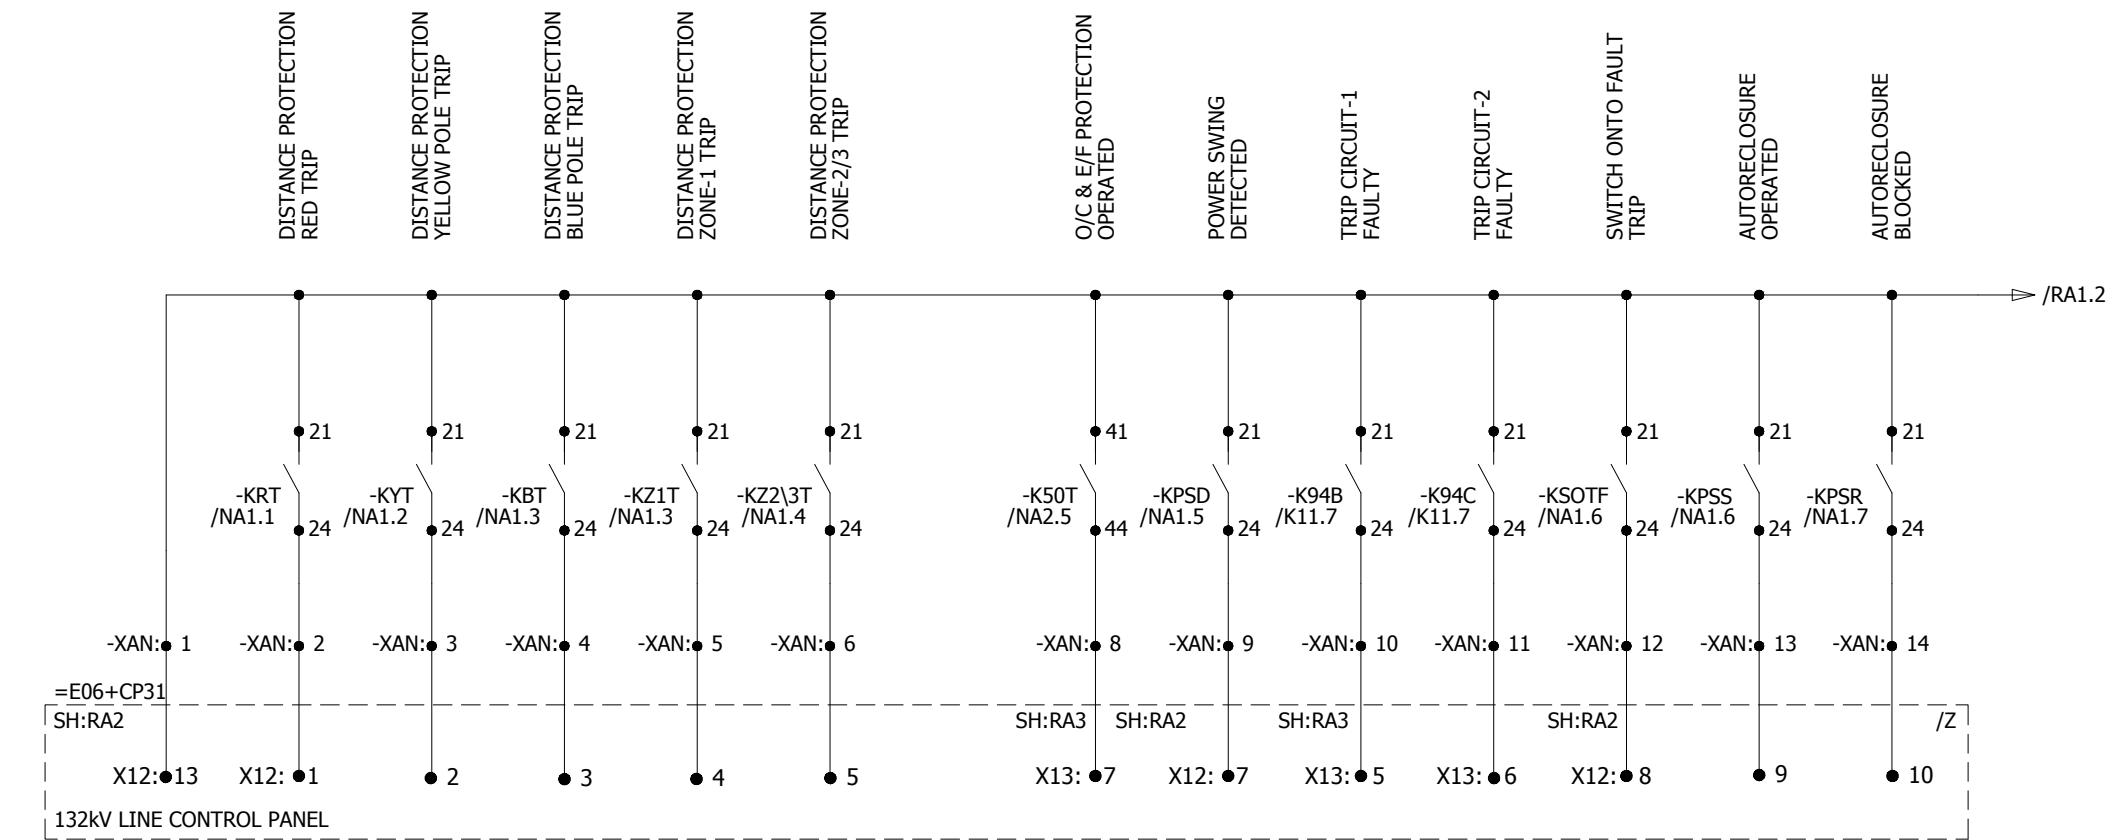


C


D

E

F

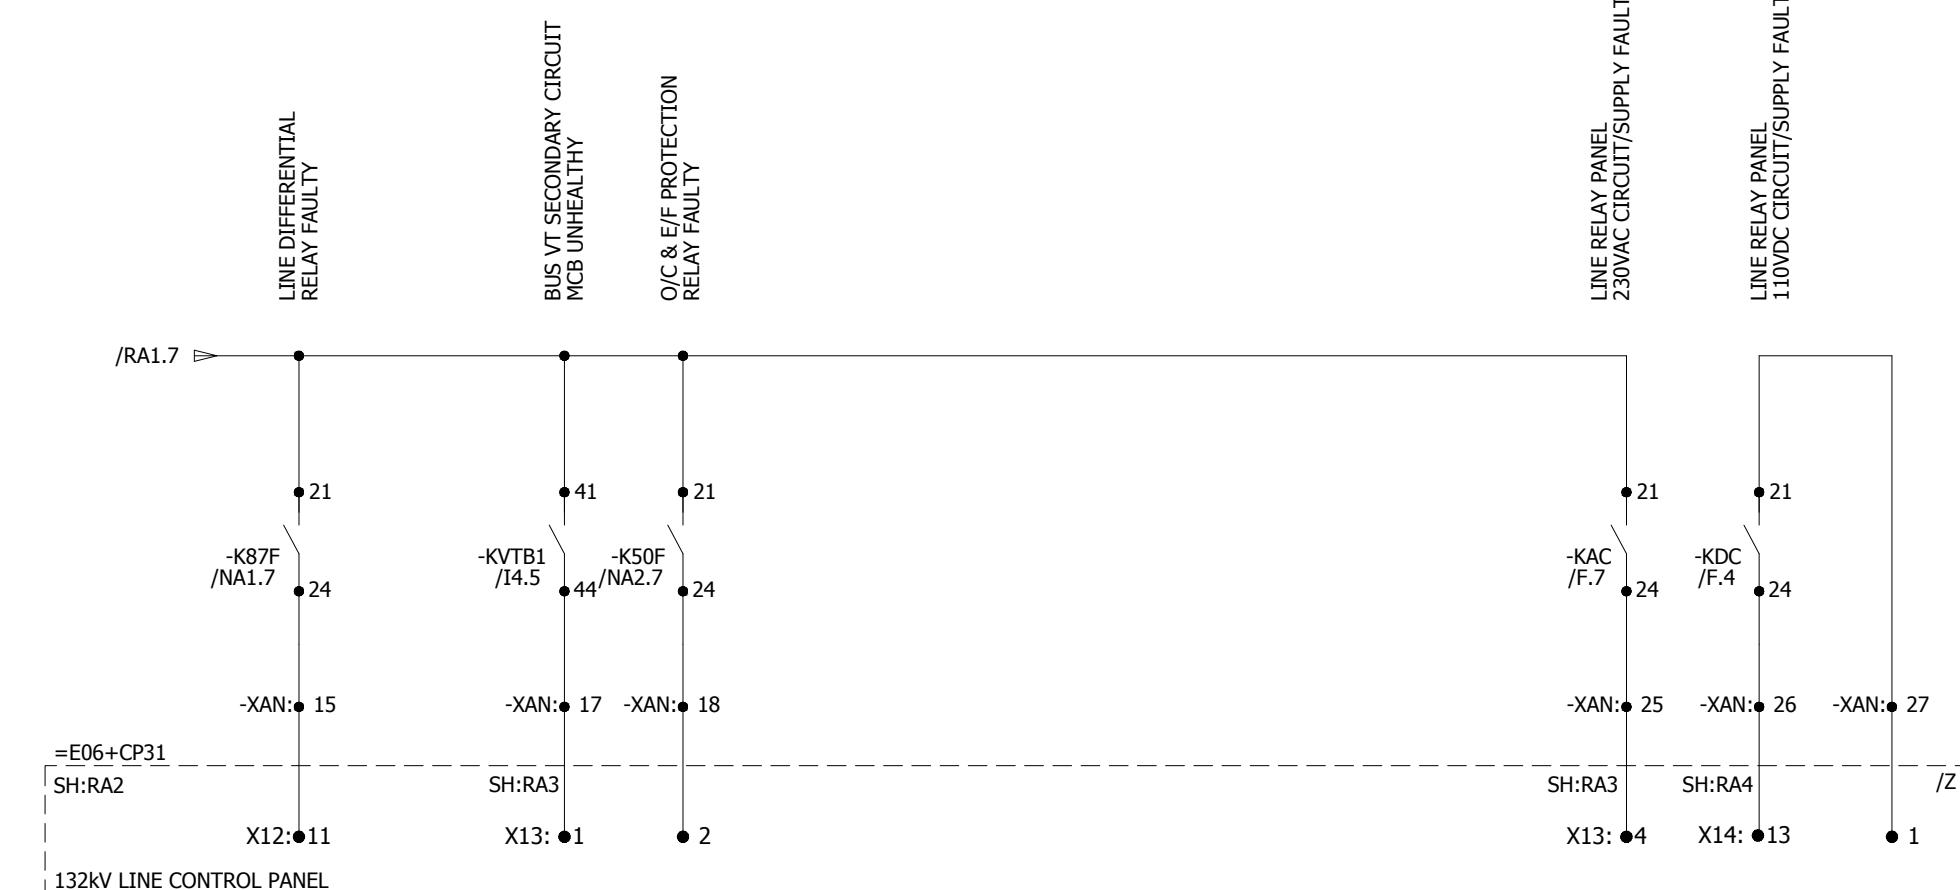





0	AS BUILT	20-11-2018	ASJ	Manufacturer  EPESOL 71-B Garden Block, New Garden Town, Lahore, Pakistan	Contractor  Grid Solutions A GE and Alstom joint venture	Client  NATIONAL TRANSMISSION & DISPATCH COMPANY LIMITED (NTDC-WAPDA)	Project 220kV/132kV GIS SUBSTATION GHAZI ROAD, LAHORE	Title 132kV LINE RELAY PANEL (=E06+RP3) ANNUNCIATION CIRCUIT	Drawing no. P60194-E-ELR-SC-004		
REV.	DESCRIPTION	DATE	DRAWER						Project no. P-60194	Sheet type RA1	Sheet no. 20
1		2									

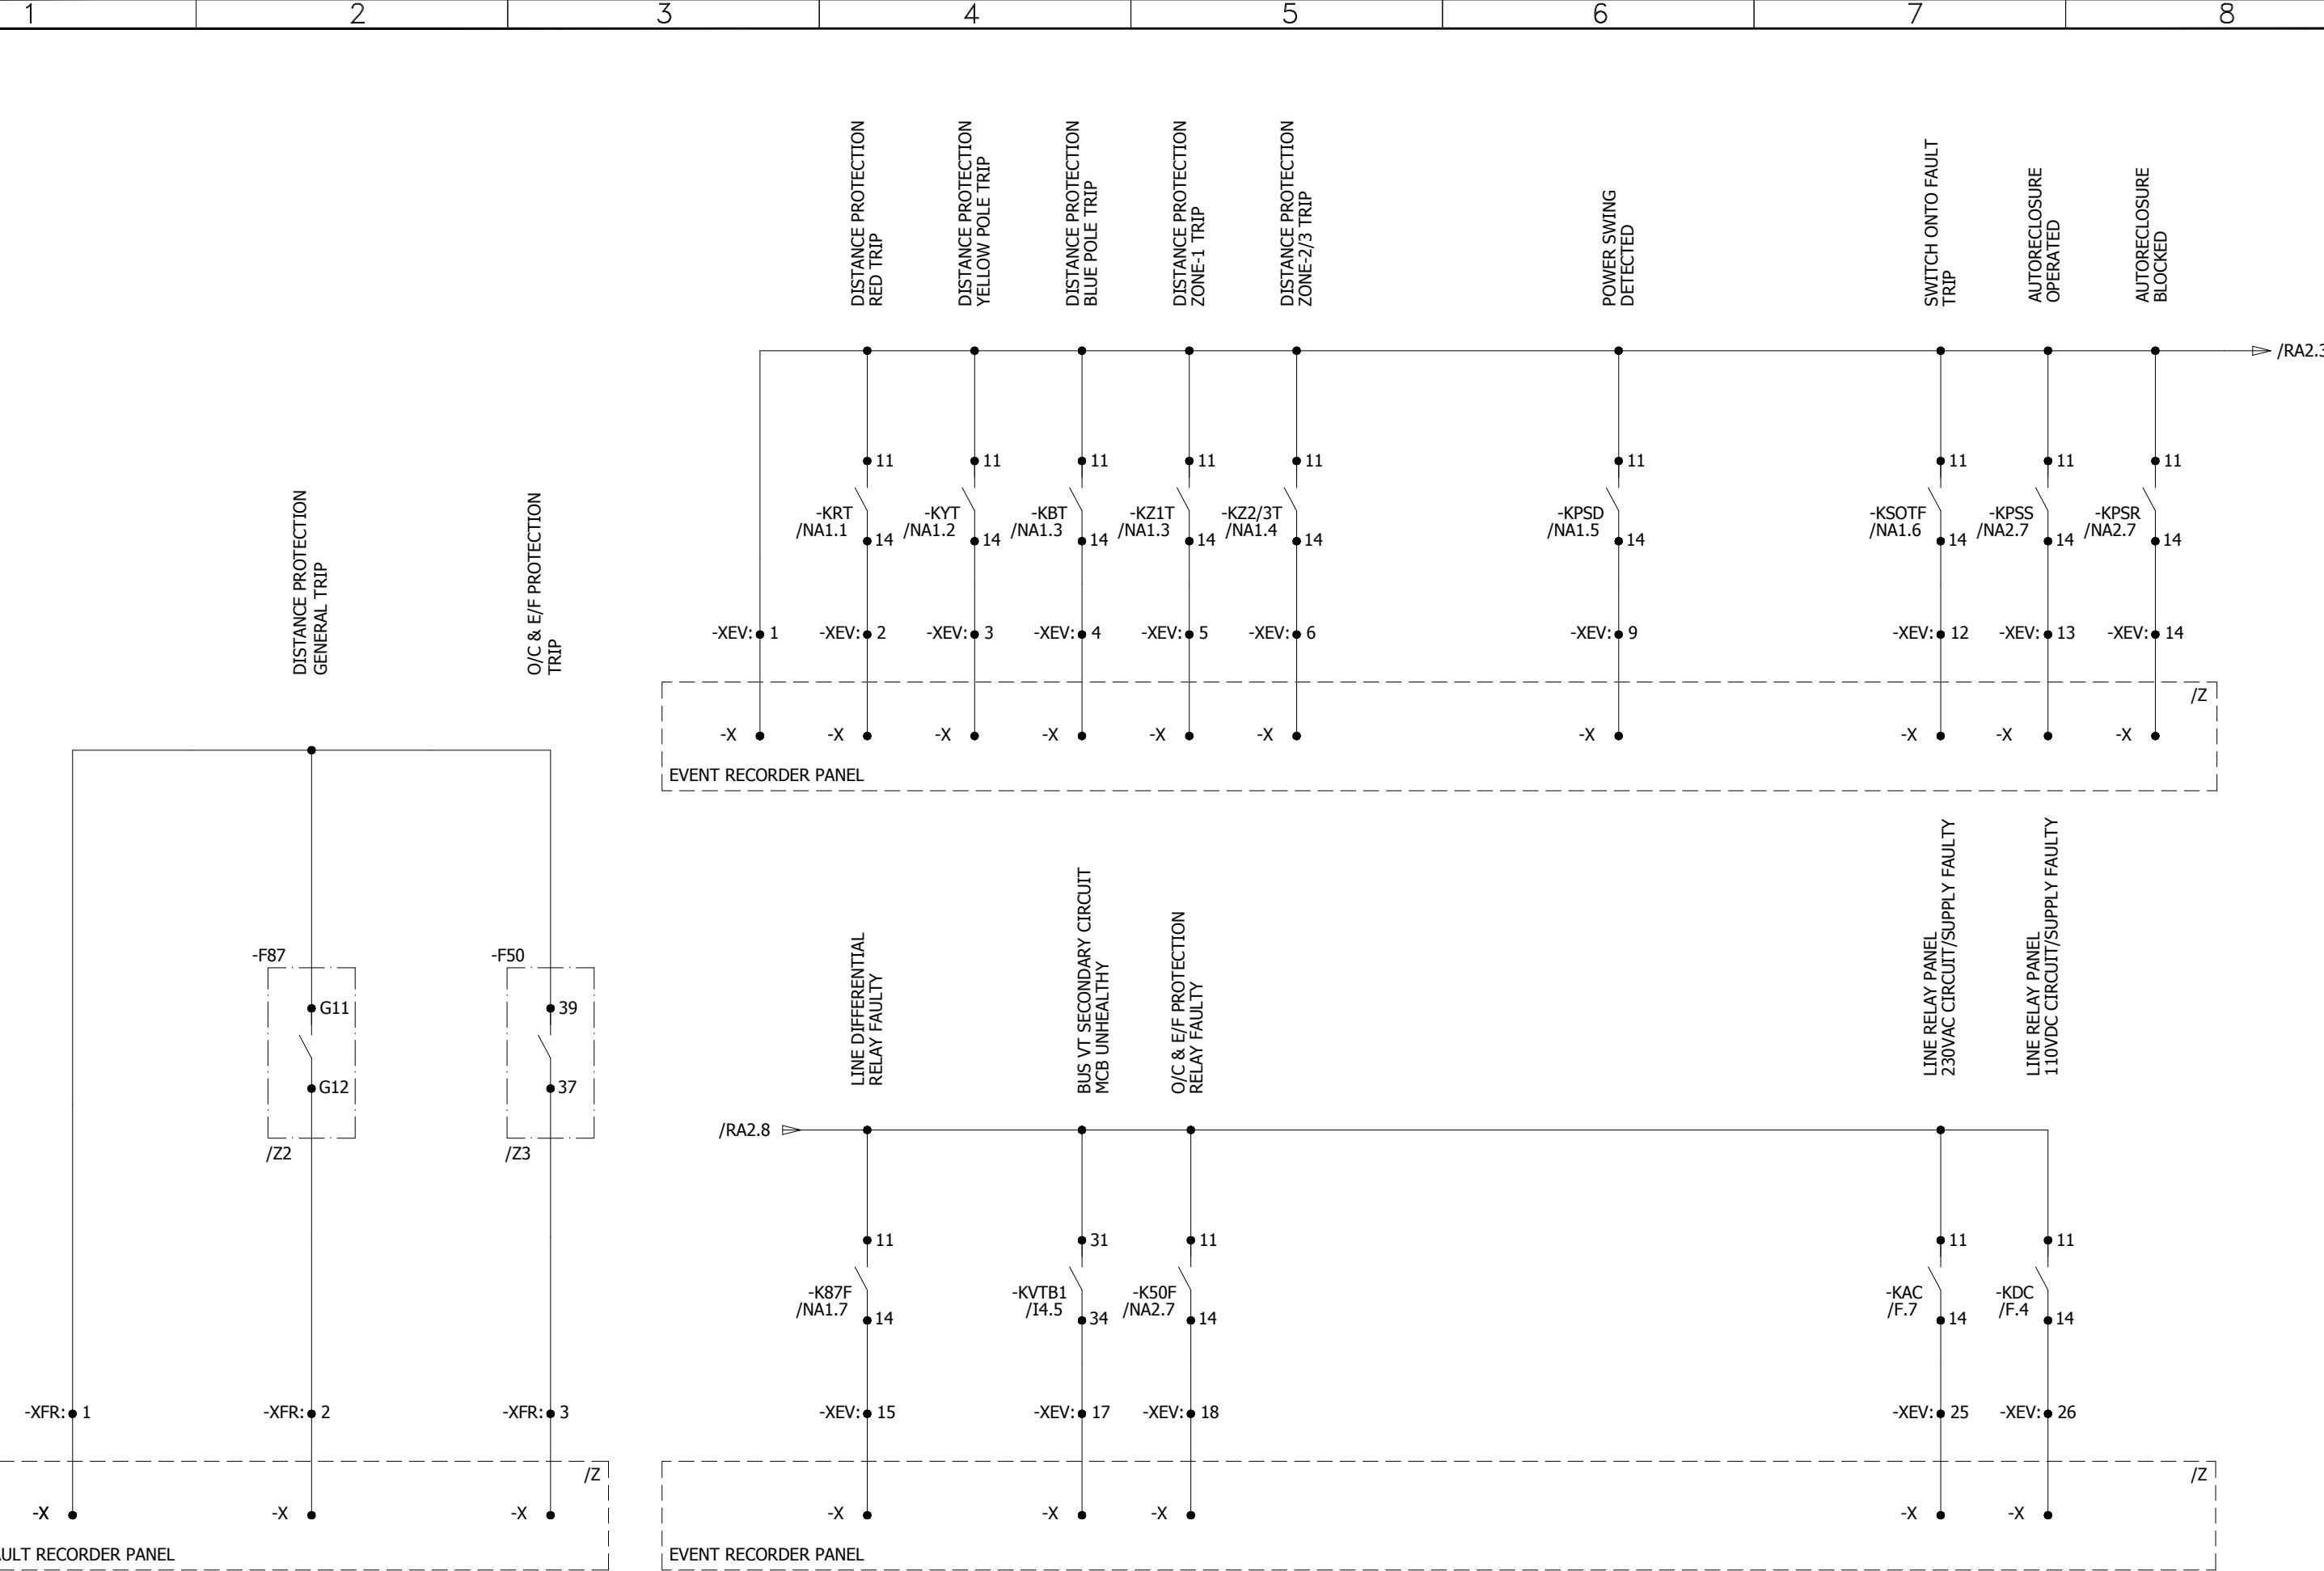

0	AS BUILT	20-11-2018	ASJ	Manufacturer  EPESOL 71-B Garden Block, New Garden Town, Lahore, Pakistan	Contractor  Grid Solutions A GE and Alstom joint venture	Client  NATIONAL TRANSMISSION & DISPATCH COMPANY LIMITED (NTDC-WAPDA)	Project	Title	Drawing no.
REV.	DESCRIPTION	DATE	DRAWER				220kV/132kV GIS SUBSTATION GHAZI ROAD, LAHORE	132kV LINE RELAY PANEL (=E06+RP3) EVENT & FAULT RECORDER CIRCUITS	P60194-E-ELR-SC-004
									Project no. P-60194

All information contained in this document is the exclusive property of GE GRID SOLUTIONS and shall not be used, copied or communicated to third parties without its prior authorization.

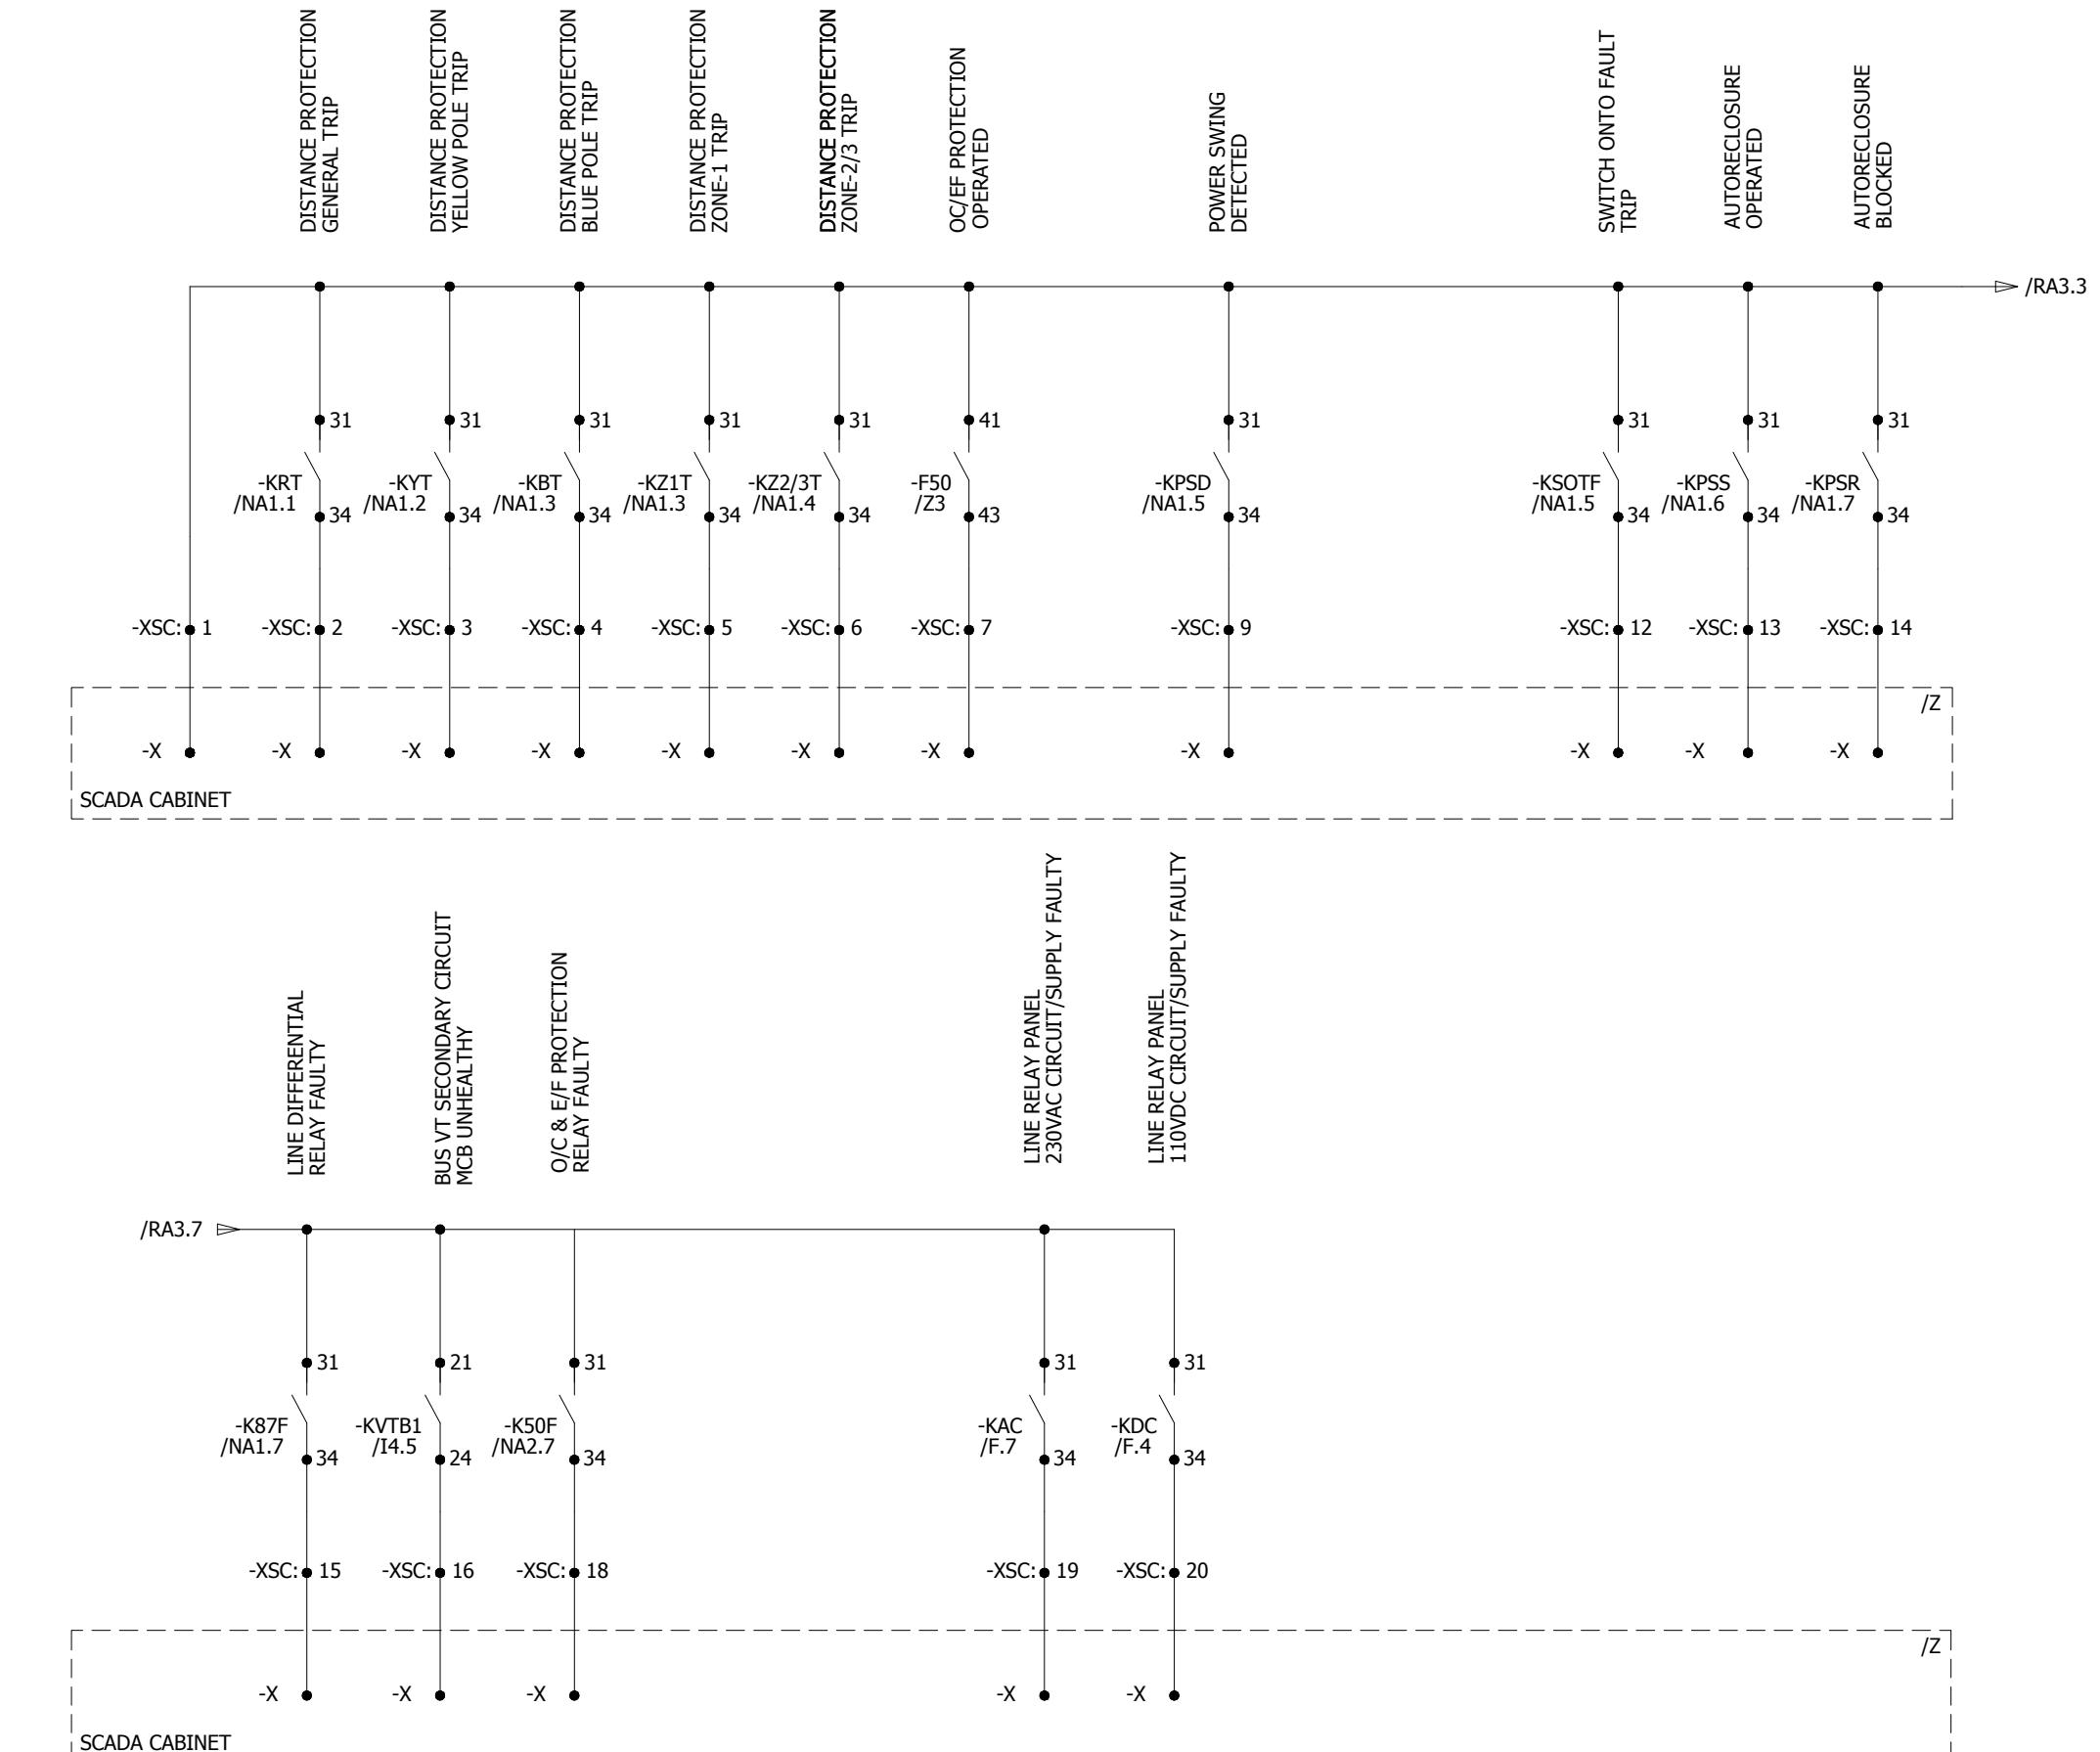

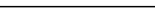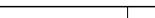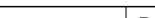0	AS BUILT	20-11-2018	ASJ	<b>Manufacturer</b>  <b>EPESOL</b> 21-B Garden Block, New Garden Town, Lahore, Pakistan	<b>Contractor</b>  <b>Grid Solutions</b> A GE and Alstom joint venture	<b>Client</b>  <b>NATIONAL TRANSMISSION &amp; DISPATCH COMPANY LIMITED</b> (NTDC-WAPDA)	<b>Project</b> 220KV/132KV GIS SUBSTATION GHAZI ROAD, LAHORE	<b>Title</b> 132KV LINE RELAY PANEL (=E06+RP3) SCADA CIRCUIT	<b>Drawing no.</b>		
								P60194-E-ELR-SC-004			
								<b>Project no.</b>	Sheet type	Sheet no.	
REV.	DESCRIPTION	DATE	DRAWER					P-60194	RA3	22	

1

2

3

4


5

6


7

8


All information contained in this document is the exclusive property of GE GRID SOLUTIONS and shall not be used, copied or communicated to third parties without its prior authorization.

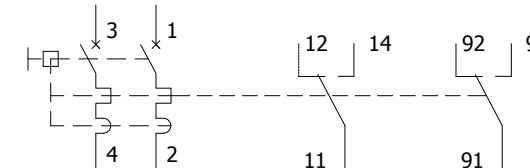


-F101	D.2	F.6	
-F102	D.4	F.6	
-F103	D.6	F.6	
-F201	E.5	F.2	
-F202	E.5	F.2	
-F203	E.6	F.2	
-F204	E.7	F.3	

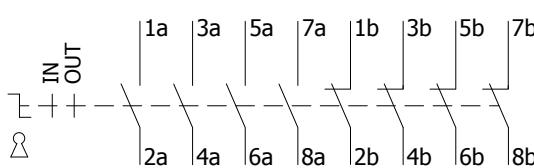


-S79				I1.2	PA2.4	
------	--	--	--	------	-------	--

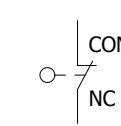


-S100	D.3
-------	-----

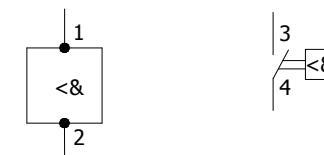


-B100	D.4	D.5
-------	-----	-----

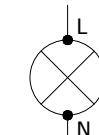


-H100	D.3
-H200	F.4

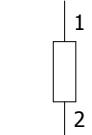

-R100	D.5
-------	-----

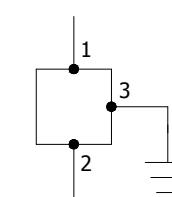

-X100	D.7
-------	-----

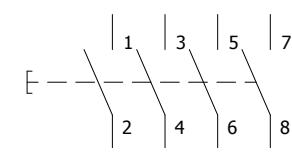

-S50	K1.7		
------	------	--	--

A

A

B

B

C

C

D

D

E

E

F

F

0	AS BUILT	20.11.2018	ASJ	Manufacturer  EPESOL 71-B Garden Block, New Garden Town, Lahore, Pakistan	Contractor  Grid Solutions A GE and Alstom joint venture	Client  NATIONAL TRANSMISSION & DISPATCH COMPANY LIMITED (NTDC-WAPDA)	Project 220kV/132kV GIS SUBSTATION GHAZI ROAD, LAHORE	Title 132kV LINE RELAY PANEL (=E06+RP3) COMPONENT DIAGRAM	Drawing no. P60194-E-ELR-SC-002
REV.	DESCRIPTION	DATE	DRAWER						Project no. P-60194
									Sheet type Z1
									Sheet no. 23

1

2

3

4



5

6


7

8

All information contained in this document is the exclusive property of GE GRID SOLUTIONS and shall not be used, copied or communicated to third parties without its prior authorization.

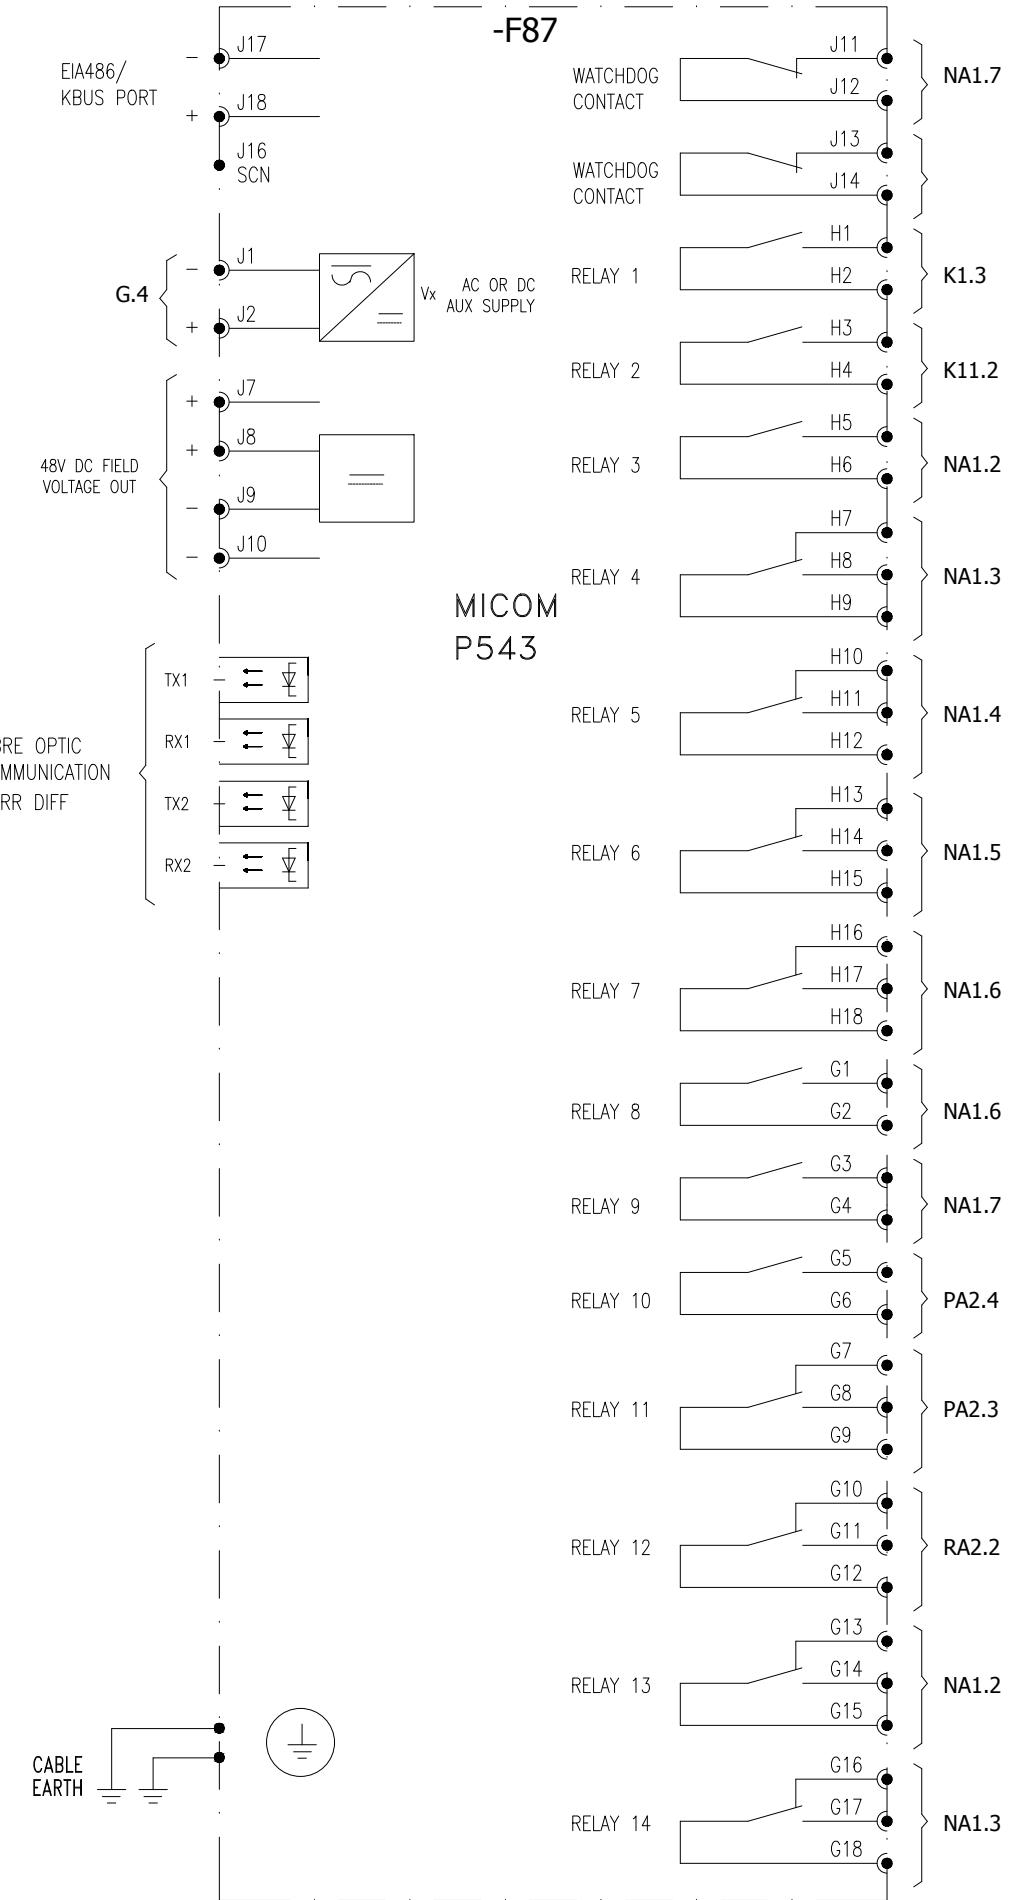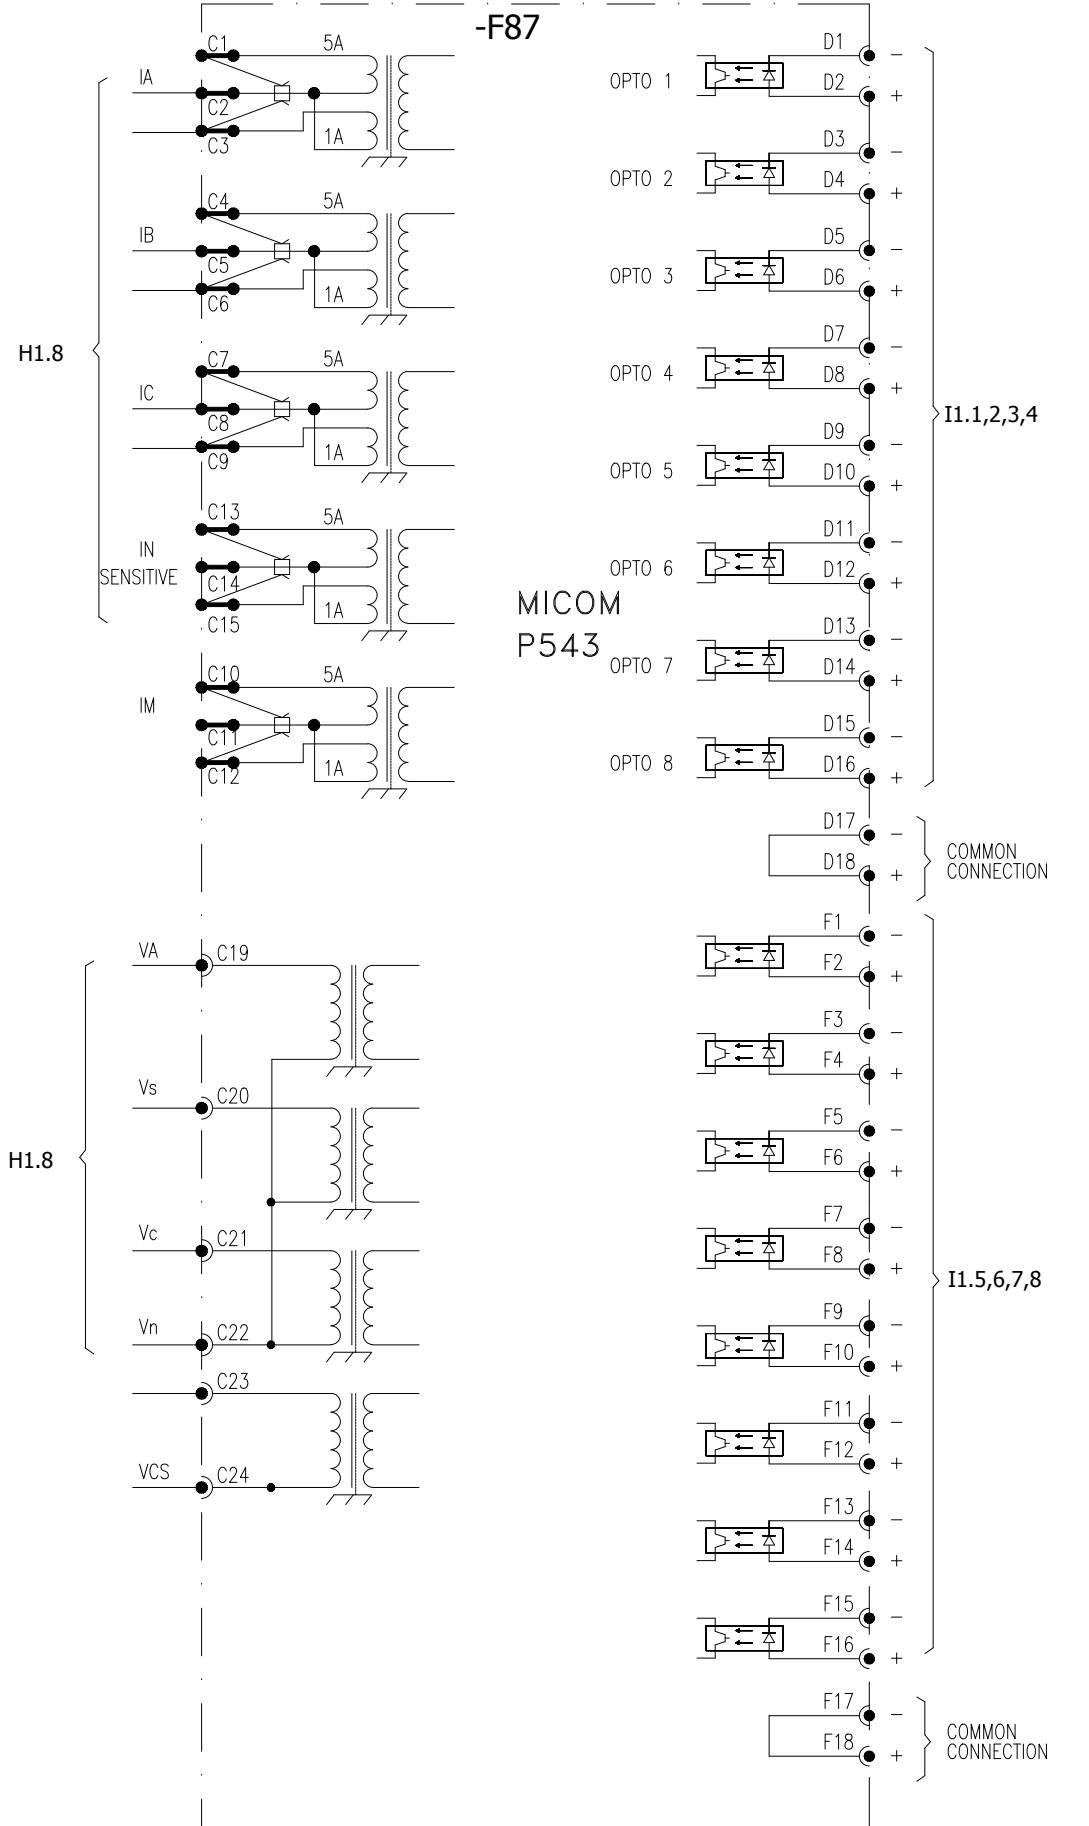


0	AS BUILT	20.11.2018	ASJ	Manufacturer  <b>EPESOL</b> 71-B Garden Block, New Garden Town, Lahore, Pakistan	Contractor  <b>Grid Solutions</b> A GE and Alstom joint venture	Client  <b>NATIONAL TRANSMISSION &amp; DISPATCH COMPANY LIMITED</b> (NTDC-WAPDA)	Project 220KV/132KV GIS SUBSTATION GAZI ROAD, LAHORE	Title 132KV LINE RELAY PANEL (=E06+RP3) COMPONENT DIAGRAM	Drawing no. P60194-E-ELR-SC-002		
									Project no. P-60194		
									Sheet type Z2	Sheet no. 24	
REV.	DESCRIPTION	DATE	DRAWER	1	2	3	4	5	6	7	8


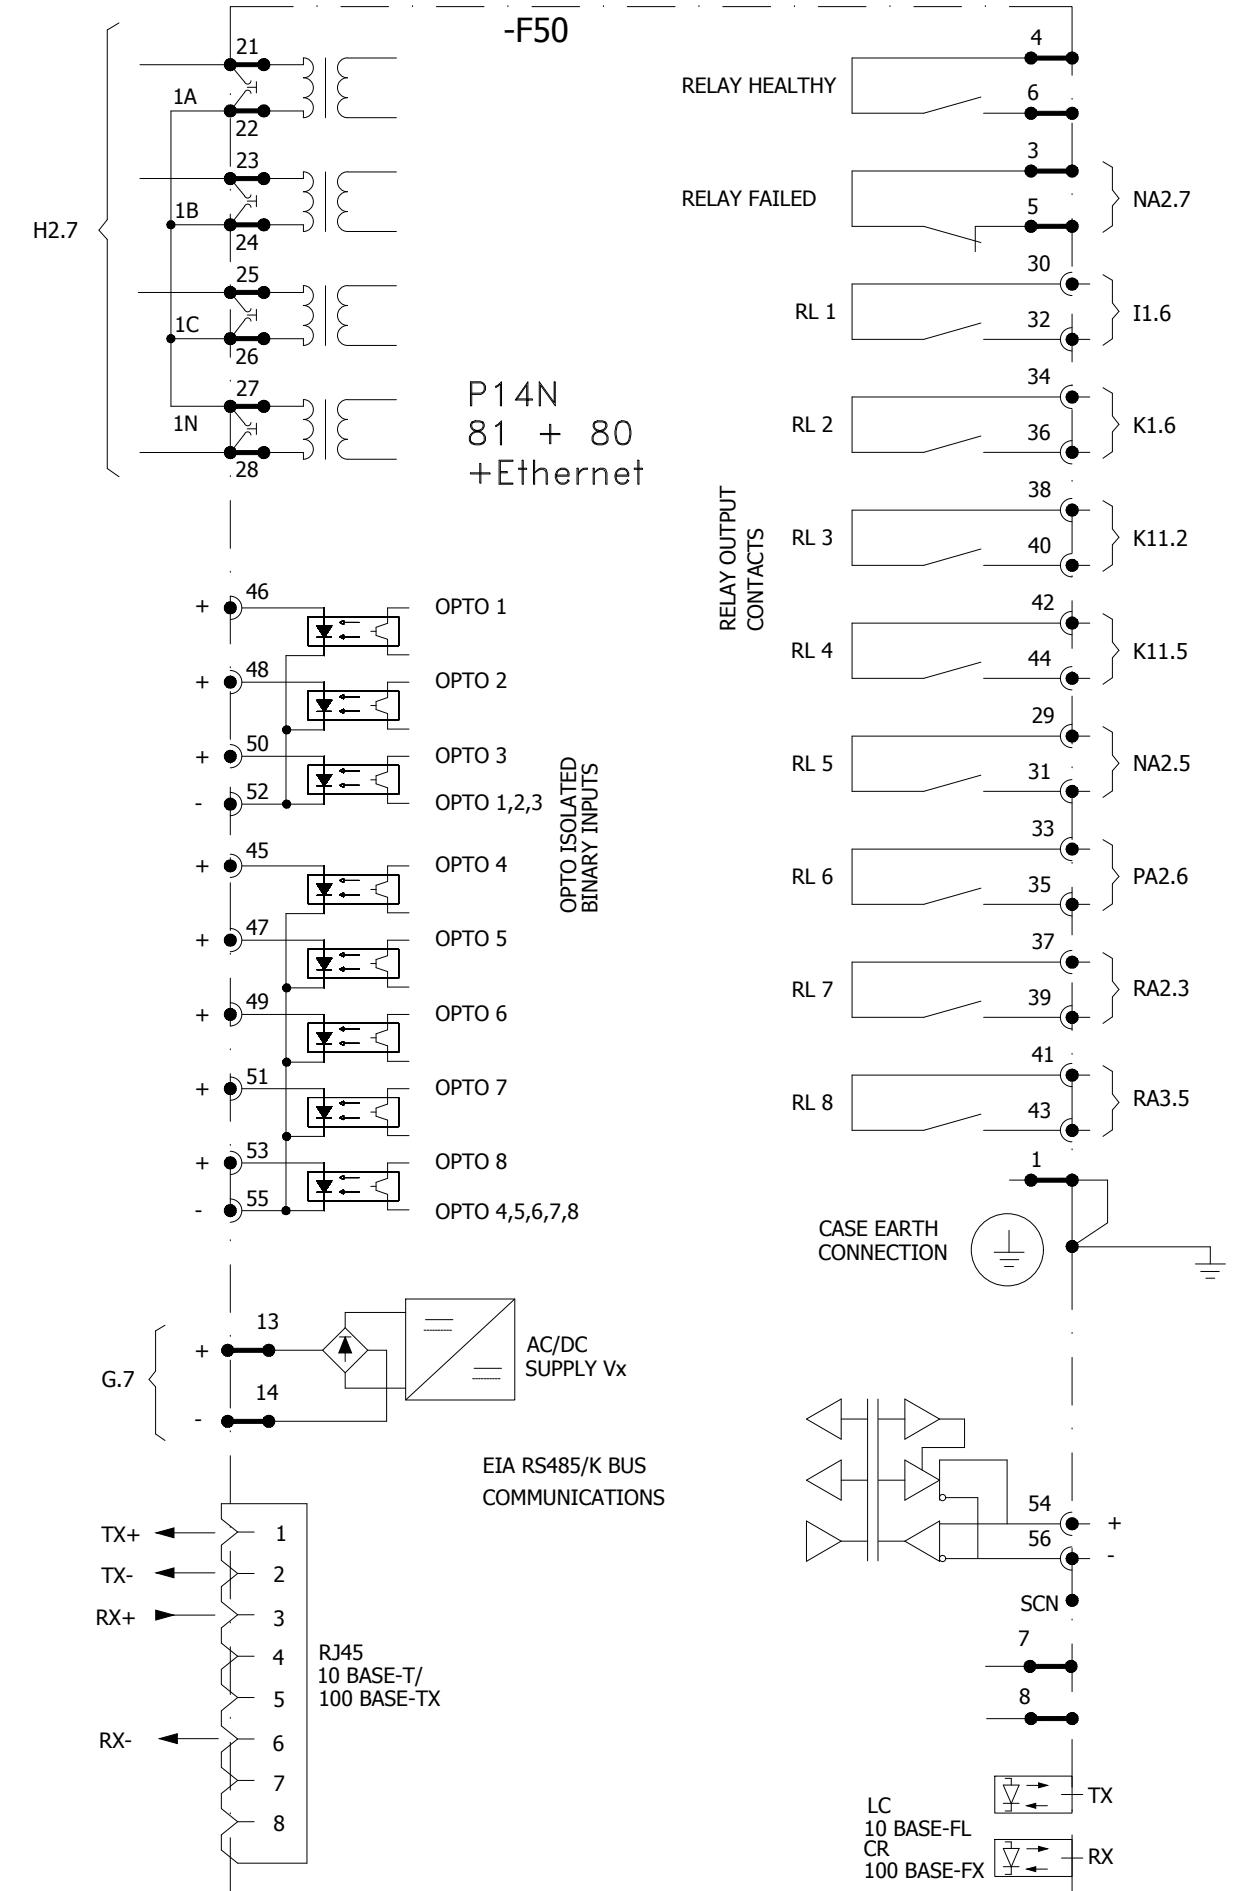


0	AS BUILT	20.11.2018	ASJ	Manufacturer	Contractor	Client	Project	Title	Drawing no.
				EPE SOL 71-B Garden Block, New Garden Town, Lahore, Pakistan	Grid Solutions A GE and Alstom joint venture	NATIONAL TRANSMISSION & DISPATCH COMPANY LIMITED (NTDC-WAPDA)	220KV/132KV GIS SUBSTATION GHAZI ROAD, LAHORE	132KV LINE RELAY PANEL (=E06+RP3) COMPONENT DIAGRAM	Project no. P-60194
REV.	DESCRIPTION	DATE	DRAWER						Sheet type Z3



All information contained in this document is the exclusive property of GE GRID SOLUTIONS and shall not be used, copied or communicated to third parties without its prior authorization.

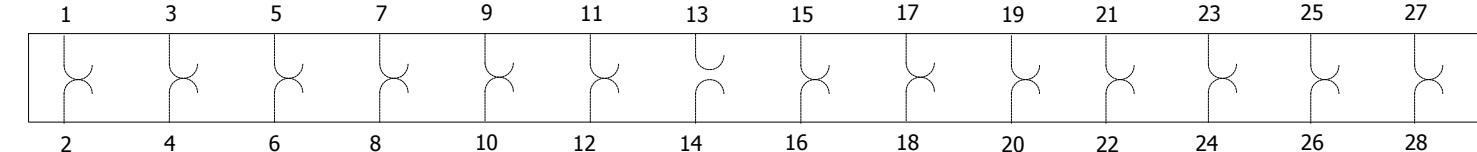

-XT87A	H1.6		NA1.1		G.4		NA1.2,3		H1.6	
-XT87B	K1.2	NA1.4		NA1.5			NA1.6,7			
-XT50	H2.6		K1.6		G.7		NA2.5	NA2.7		

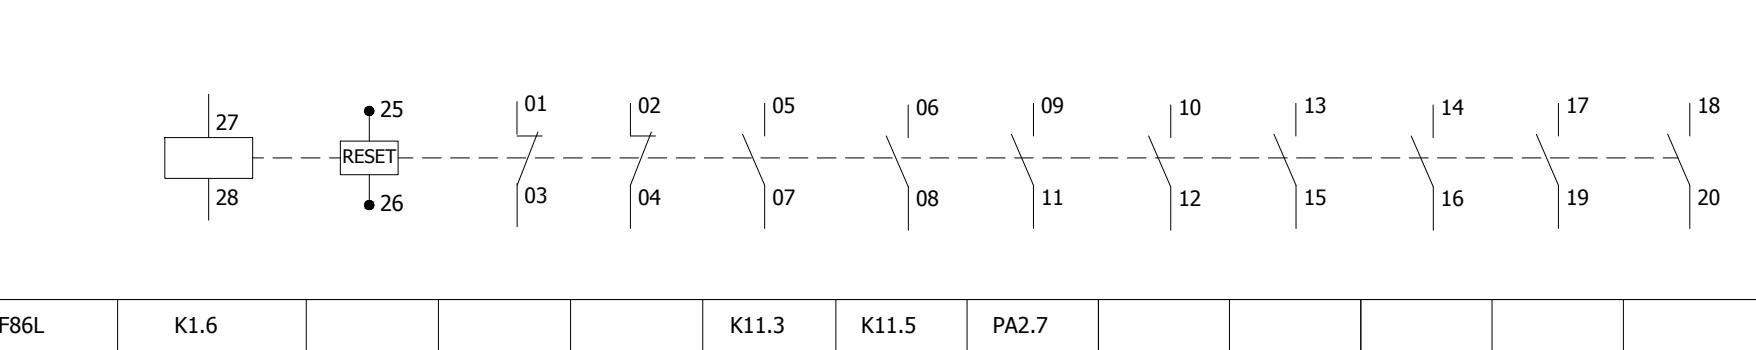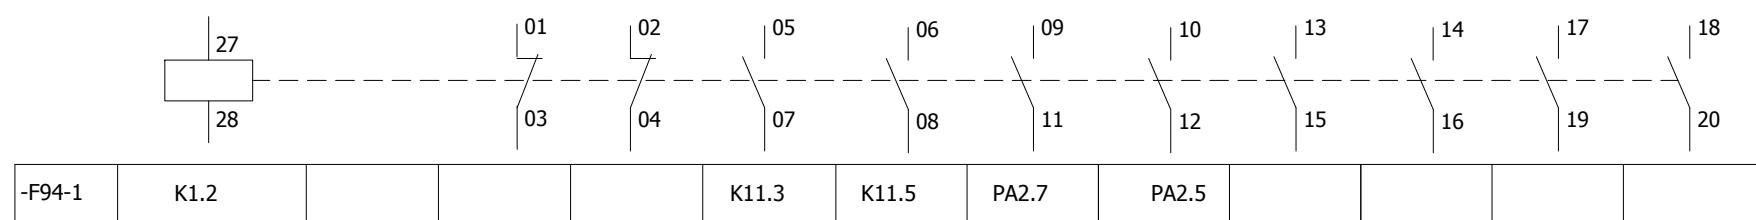

-R94B1	K11.3
-R94B2	K11.3
-R94B3	K11.4
-R94C1	K11.6
-R94C2	K11.6
-R94C3	K11.7

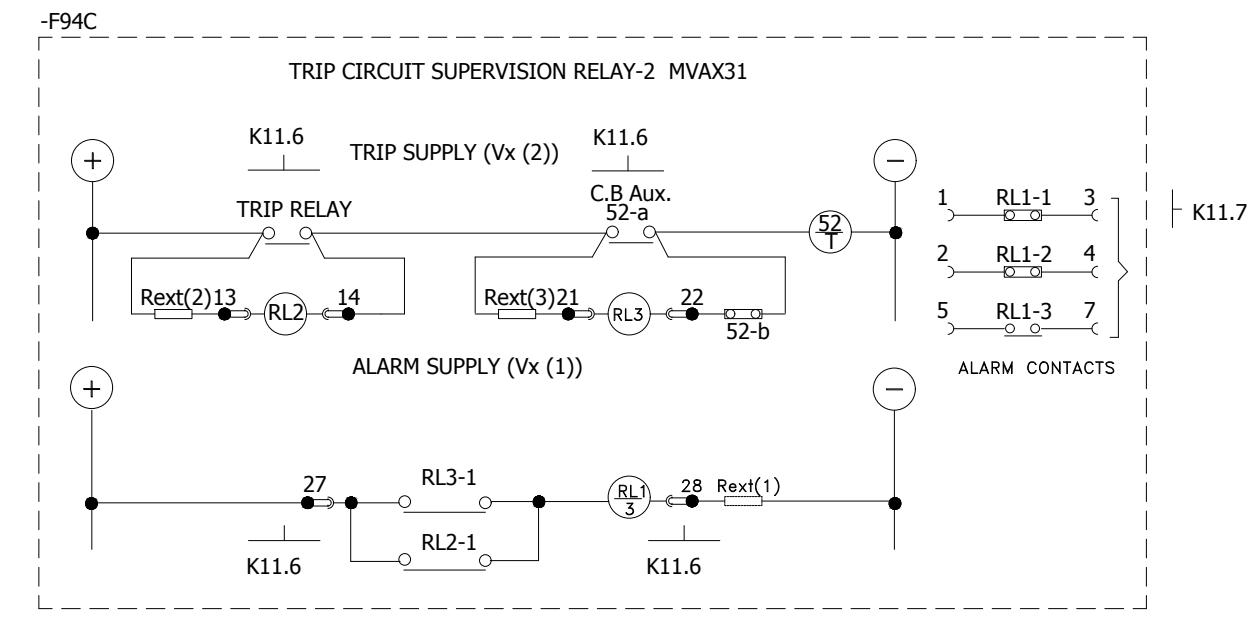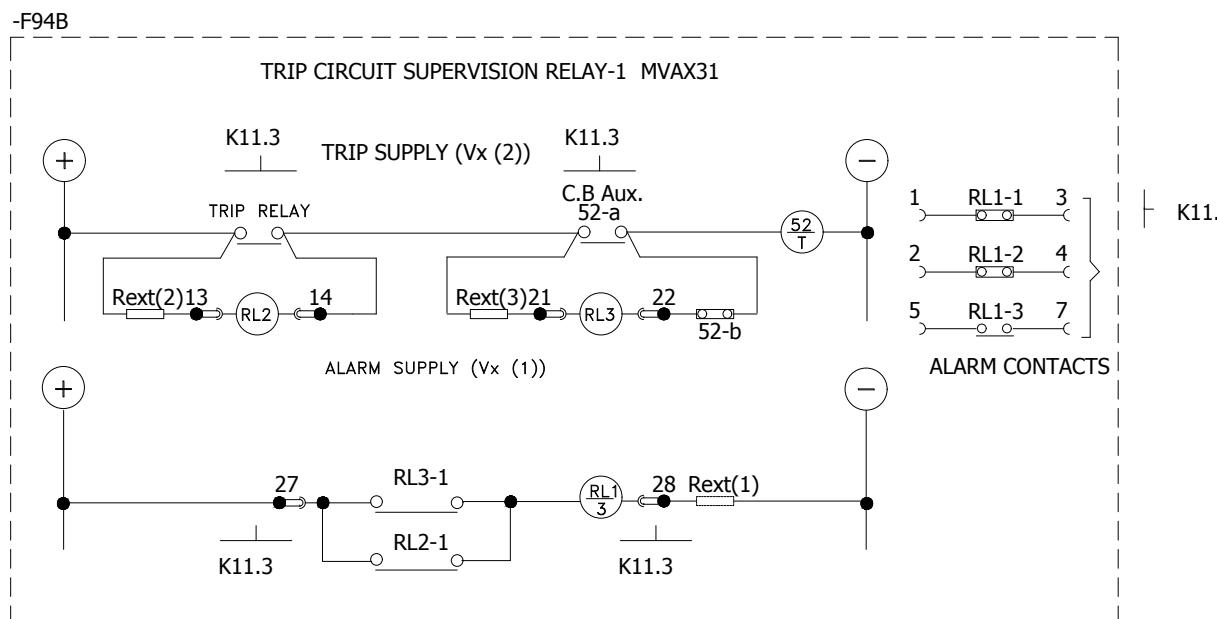

0	AS BUILT	20.11.2018	ASJ	Manufacturer  EPESOL 7-B Garden Block, New Garden Town, Lahore, Pakistan	Contractor  Grid Solutions A GE and Alstom joint venture	Client  NATIONAL TRANSMISSION & DISPATCH COMPANY LIMITED (NTDC-WAPDA)	Project 220KV/132KV GIS SUBSTATION GHAZI ROAD, LAHORE	Title 132KV LINE RELAY PANEL (=E06+RP3) COMPONENT DIAGRAM	Drawing no. P60194-E-ELR-SC-002		
REV.	DESCRIPTION	DATE	DRAWER						Project no. P-60194	Sheet type Z4	Sheet no. 26
1	2	3	4	5	6	7	8				