






132kV BUS COUPLER RELAY PANEL SCHEMATIC DRAWINGS

REFERENCE DRAWINGS					
SR. NO.	DRAWING TITLE				DOCUMENT NO.
1.	220kV / 132kV Metering & Protection SLD				P60194-E-SLMP-001
REVISION HISTORY					
REV	DATE	DRW. BY	CHK. BY	APR. BY	REVISION DESCRIPTION
0	18.08.2018	MUR	AMR	NAH	AS BUILT
Scale NOT-TO-SCALE				Sheet size A3	
Client <div><div></div><div>NATIONAL TRANSMISSION & DISPATCH COMPANY LIMITED (NTDC-WAPDA)</div></div>					
Contractor <div><div></div><div>Grid Solutions A GE and Alstom joint venture</div></div>				Manufacturer <div><div></div><div>EPESOL 71-B Garden Block, New Garden Town, Lahore Pakistan</div></div>	
Project 220kV / 132kV GIS SUBSTATION GHAZI ROAD , LAHORE					
Title 132kV BUS COUPLER RELAY PANEL (=E11+RP1) SCHEMATIC DRAWINGS					
Order no P-60194			Document no P60194-E-EBR-SC-001		
Sheet type A		Total sheets 21		Sheet no 1	




	1	2		3		4		5		6		7		8								
	PAGE NO.	SHEET NAME		SHEET DESCRIPTION						ISSUE / REVISION												
										A	B	C	D	E	F	01	02	03	04	05		
A	01	A		Cover Sheet																		
	02	AA		List Of Contents																		
	03	AB		Symbol and Legends																		
B	04	AC1		Component List																		
	05, 05a	AD, AD1		Panel View																		
	06	AE		Bay Concept & Protection Logic																		
	07	D		AC Supply Distribution Circuit																		
	08	E		DC Supply Distribution Circuit																		
	09	F		AC/DC Supply Failure Circuit																		
C	10	G		Relay Power Supply Circuit																		
	11	H2		O/C & E/F CT Input Circuit																		
	12	K1		Protection Trips Circuit																		
	13	K11		Trips Circuit Supervision																		
	14	NA2		System Alarm Circuit																		
	15	PA2		Protection Inter Circuit																		
D	16	RA1		Annunciation Circuit																		
	17	RA2		Event & Fault Recorder Circuit																		
	18	RA3		SCADA Circuit																		
	19	Z1		Component Diagram																		
	20	Z3		Component Diagram																		
	21	Z4		Component Diagram																		
E																						
F																						
	0	AS BUILT		18.08.2018	MSC	Manufacturer  EPESOL 77-B Garden Road, New Garden Town, Lahore, Pakistan		Contractor  Grid Solutions A GE and Alstom joint venture		Client  NATIONAL TRANSMISSION & DISPATCH COMPANY LIMITED (NTDC-WAPDA)		Project 220kV/132kV GIS SUBSTATION GHAZI ROAD, LAHORE		Title 132kV BUS COUPLER RELAY PANEL (=E11+RP1) LIST OF CONTANTS			Drawing no. P60194-E-EBR-SC-001 Project no. P-60194 Sheet type AA Sheet no. 02					
	REV.	DESCRIPTION		DATE	DRAWER																	
	1		2		3		4		5		6		7		8							

F

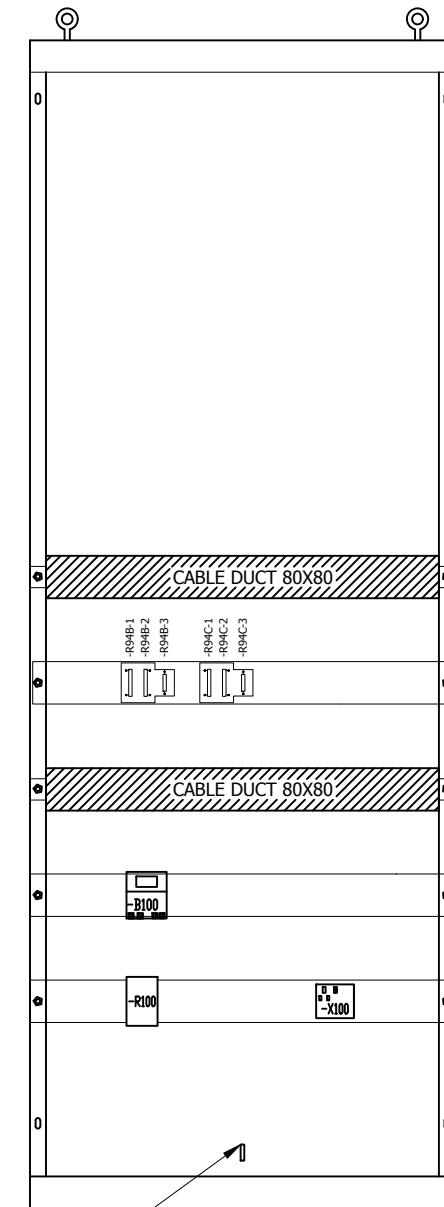
LE

1	2	3	4	5	6	7	8
---	---	---	---	---	---	---	---

All information contained in this document is the exclusive property of GE GRID SOLUTIONS and shall not be used, copied or communicated to third parties without its prior authorization.

All information contained in this document is the exclusive property of GE GRID SOLUTIONS and shall not be used, copied or communicated to third parties without its prior authorization.	QTY.		DEVICE DESCRIPTION		DEVICE SPECIFICATIONS DEVICE TYPE ; TECHNICAL DATA / SPECIFICATIONS		DEVICE DESIGNITION		MANUFACTURER						
	01	OVER CURRENT PROTECTION RELAY		AGILE P14N, Cortec: P14N-B16A7C570A		-F50		GE							
				08 Opto Inputs, 08 Relay Outputs											
	02	TRIP CIRCUIT SUPERVISION		MVAX31, Cortec: MVAX31-S1DD0754A		-F94B-C		GE							
	01	TEST BLOCK		MMLG01, Cortec: MMLG01-R1AA9002D		-XT50		GE							
	01	LOCKOUT RELAY (HAND/ELECTRICAL RESET)		MVAJ105, Cortec: MVAJ105-RA0802A		-F86-1		GE							
				Supply: 110-125VDC, 8 NO + 2 NC Contacts											
	04	RESISTORS		4KΩ		R94 B/C 1-2		GE							
	02	RESISTOR		1.5KΩ		R94 B/C 3		GE							
	02	CONTROL MCB - PANEL LIGHT & HEATER		2-Pole, Ratings: 2A, 240VAC, 10kA @ 240VAC, 2 C/O Contacts, Ord: G62C02+CAH(2)		-F101-102		GE							
	01	CONTROL ELCB - PANEL SOCKET		2-Pole, Ratings: 16A, 30mA, 240VAC, 1P+N, 2 C/O Contacts, Ord: DM100C16/030+CAH(2)		-F103		GE							
	03	CONTROL MCB - DC DISTRIBUTION		2-Pole, Ratings: 4A, 250VDC, 10kA @ 250VDC, 2 C/O Contacts, Ord: EP102UCC04+CAH(2)		-F202-204		GE							
	01	PUSHBUTTON - RELAY LED RESET		Type: Switch (A Type), Color : BLACK , Supply : 110VDC, Ord: YS-AP1-2-40-B-D-W		-S50R		YONGSUNG							
	01	INDICATION LAMP - DC SUPPLY FAILURE		Type: Integrated LED, Color : RED , Supply : 230VAC @ 50Hz, Ord: YS-PL-2-AL-22-R-W		-H200		YONGSUNG							
	01	AUXILIARY CONTACTOR - SUPPLY CHANGEOVER		Coil Voltage: 110VDC, 16A, 3 NO + 3 NC Contacts, Ord: MCRC022ATWJ+MARN211AT		-KDCO		GE							
	02	CONTACTOR RELAY		Coil Voltage: 230VAC @ 50/60 Hz, 6A, 4 C/O Contacts, Ord: PRC4M40ANL		-KACM, -KDC		GE							
	07	CONTACTOR RELAY		Coil Voltage: 110VDC, DIODE, 4 C/O Contacts, Ord: PRC4M40DCJL		-KDCM, -KAC, -K94B, -K94C, -K50T, -K50F, -KDC2		GE							
	01	PANEL LIGHT		230VAC @ 50Hz, 05W, Ord: YS-T8-30-5W		-H100		YONGSUNG							
	01	DOOR SWITCH		230VAC @ 50Hz, 1 NO Contact, Ord: YS P3315GW-B + YS MS-C		-S100		YONGSUNG							
	01	THREE PIN SOCKET		1N+PE, 16A, 230VAC @ 50Hz		-X100		LOCAL							
	01	PANEL HEATER		240VAC @ 50Hz, 50W		-R100		E-LABS							
	01	HUMIDITY & TEMPERATURE CONTROLLER		40-90%RH, 25-50 deg.C, 240VAC @ 50Hz		-B100		E-LABS							
	04	TERMINAL BLOCKS - AC SUPPLY DISTRIBUTION		Screw-type, Feed Through Terminal, CBD-4		-XAC		CABUR							
	04	TERMINAL BLOCKS - DC SUPPLY DISTRIBUTION		Screw-type, Feed Through Terminal, CBD-4		-XDC-1, -XDC-2		CABUR							
	04	TERMINAL BLOCKS - SPARE CONTROL DC MCB		Screw-type, Feed Through Terminal, CBD-4		-X3		CABUR							
	18	TERMINAL BLOCKS - O/C & E/F CT INPUTS, INCL. SPARE		Screw-type, Feed Through Terminal, With Shortening Links, SCB-6		-X5		CABUR							
	14	TERMINAL BLOCKS - TRIP CIRCUIT SUPERVISION		Screw-type, Feed Through Terminal, CBD-4		-XTC1, -XTC2		CABUR							
	04	TERMINAL BLOCKS - PROTECTION INTER-CIRCUITS		Screw-type, Feed Through Terminal, CBD-4		-X9		CABUR							
	08	TERMINAL BLOCKS - ANNUNCIATOR CIRCUIT		Screw-type, Feed Through Terminal, CBD-4		-XAN		CABUR							
	07	TERMINAL BLOCKS - ER & FR CIRCUITS		Screw-type, Feed Through Terminal, CBD-4		-XEV, -XFR		CABUR							
	04	TERMINAL BLOCKS - SCADA CIRCUIT		Screw-type, Feed Through Terminal, CBD-4		-XSC		CABUR							
	06	TERMINAL BLOCKS - SPARE		Screw-type, Feed Through Terminal, CBD-4		-X		CABUR							
	0	AS BUILT		18.08.2018	MSC	Manufacturer	Contractor	Client	Project	Title		Drawing no.			
						 EPESOL 21-B Garden Road, New Garden Town, Lahore, Pakistan	 Grid Solutions A GE and Alstom joint venture	 NATIONAL TRANSMISSION & DISPATCH COMPANY LIMITED (NTDC-WAPDA)	220kV/132kV GIS SUBSTATION GHAZI ROAD, LAHORE	132kV BUS COUPLER RELAY PANEL (=E11+RP1) COMPONENT LIST		P60194-E-EBR-SC-001			
												Project no.	Sheet type	Sheet no.	
	REV.	DESCRIPTION		DATE	DRAWER							P-60194	AC1	04	
1		2		3		4		5		6		7		8	

RIGHT SIDE VIEW



~~SLOT FOR EARTHING~~
BUSBAR
7X30mm







0	AS BUILT	18.08.2018	MSC	 EPESOL 77-B Garden Road, New Garden Town, Lahore, Pakistan	 Grid Solutions A GE and Alstom joint venture	 NATIONAL TRANSMISSION & DISPATCH COMPANY LIMITED (NTDC-WAPDA)	Project 220kV/132kV GIS SUBSTATION GHAZI ROAD, LAHORE	Title 132kV BUS COUPLER RELAY PANEL (=E11+RP1) PANEL VIEW	Drawing no. P60194-E-EBR-SC-001					
												Project no. P-60194	Sheet type AD	Sheet no 05
REV.	DESCRIPTION	DATE	DRAWER											

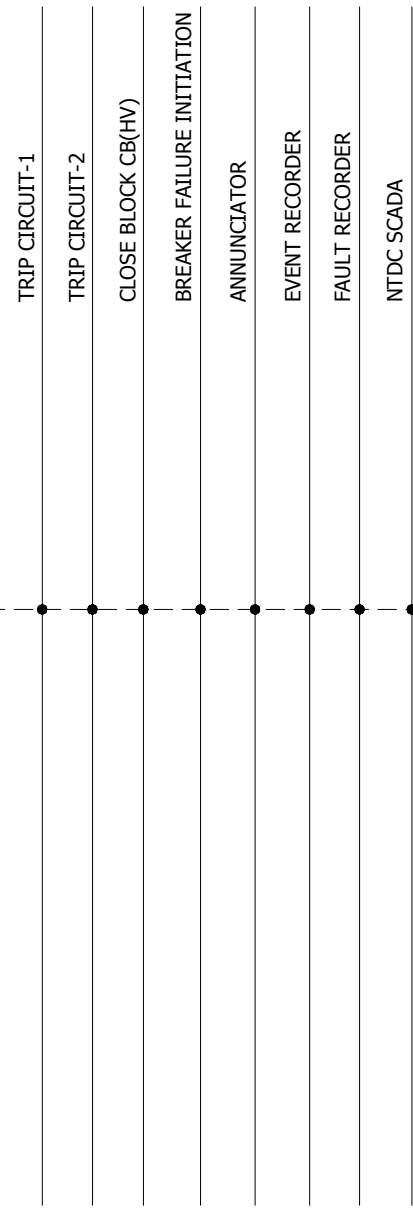
Diagram of the front panel of a 100A 1P+N+PE molded case circuit breaker. The panel is divided into two main sections. The left section contains a large rectangular cutout for a handle, a label "S100 (DS)" at the top left, and a label "MFG. NAME PLATE" on the right. The right section contains a label "PANEL LIGHT -H100" at the top right. Both sections have ventilation slots at the top and bottom. A label "M6 WELDED BOLT FOR FLEXIBLE DOOR EARTHING" is at the bottom left with arrows pointing to two circular mounting points.

Technical drawing of a square cubicle. The main square is labeled "CUBICLE" with an arrow pointing to its left side. The width and height are both dimensioned as 800. Above the square, there are three curved lines representing a door and two side pockets. The leftmost curve is labeled "DOOR" with an arrow. The middle curve is labeled "REAR SIDE" with a downward arrow. The rightmost curve is labeled "DWG. POCKET" with an arrow. At the bottom left, there is a diagonal arrow pointing towards the bottom right, labeled "FRONT SIDE".

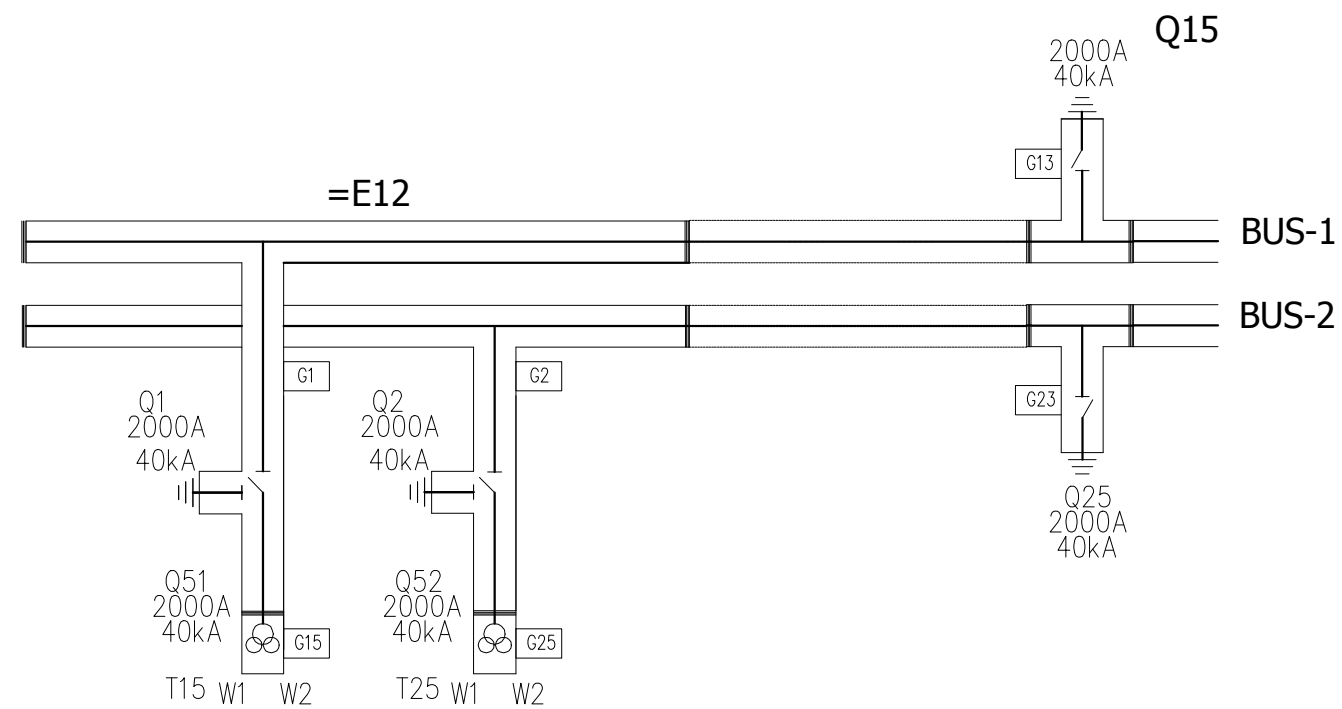
- 1 - PANEL DIMENSION: 800 x 800 x 2200mm (WxDxH)
- 2 - COLOR : RAL 7032
- 3 - SHEET THICKNESS : 2-2.5 mm
- 4- PROTECTION CLASS : IP-51 (INDOOR TYPE)
- 5 - ALL DOOR FITTED WITH 16mm EARTH STRAP & INSULATED WITH GREEN-YELLOW COLOUR.




0	AS BUILT	18.08.2018	MSC	 EPESOL <small>37-B Garden Road, New Garden Town, Lahore, Pakistan</small>	 Grid Solutions <small>A GE and Alstom joint venture</small>	 NATIONAL TRANSMISSION & DISPATCH COMPANY LIMITED <small>(NTDC-WAPDA)</small>	Project 220kV/132kV GIS SUBSTATION GHAZI ROAD, LAHORE	Title 132kV BUS COUPLER RELAY PANEL (=E11+RP1) PANEL VIEW	Drawing no. P60194-E-EBR-SC-001				
											Project no. P-60194	Sheet type AD1	Sheet no 05a
REV.	DESCRIPTION	DATE	DRAWER										

A
B
C
D
E
F

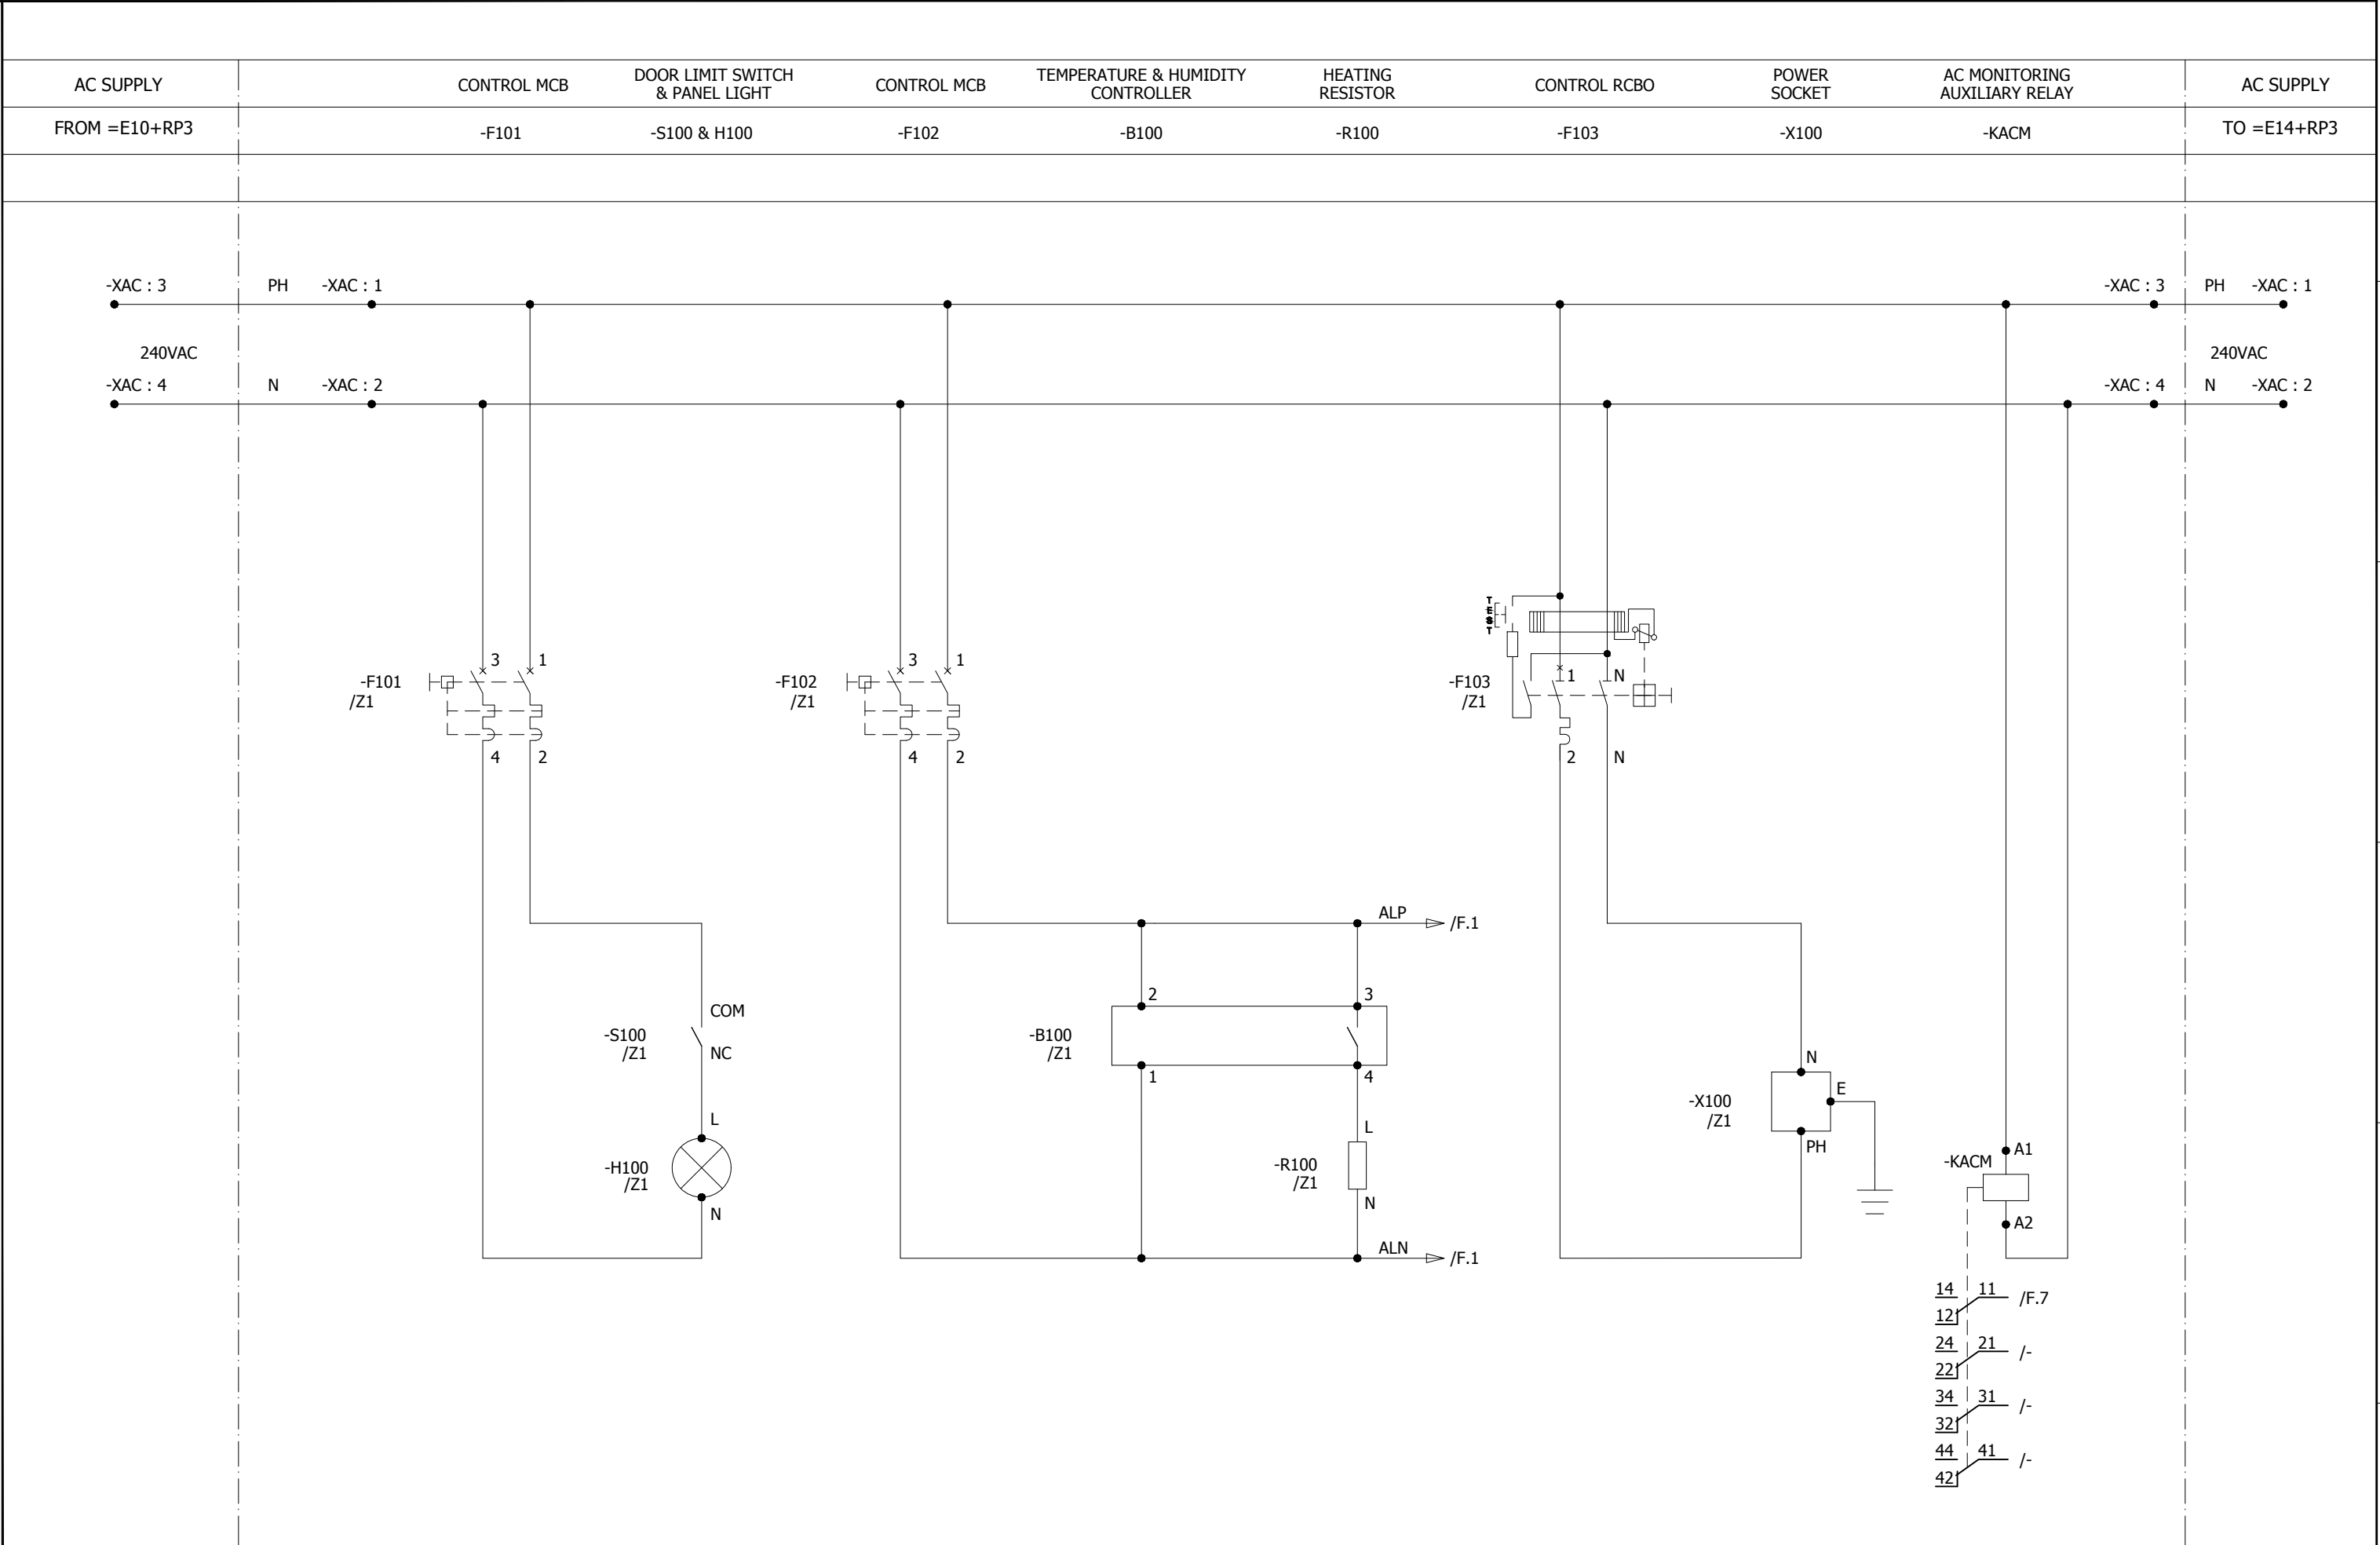





BUS COUPLER



0	AS BUILT	18.08.2018	MSC	 EPESOL 77-B Garden Block, New Garden Town, Lahore, Pakistan	 Grid Solutions A GE and Alstom joint venture	 NATIONAL TRANSMISSION & DISPATCH COMPANY LIMITED (NTDC-WAPDA)	Project 220kv/132kv GIS SUBSTATION GHAZI ROAD, LAHORE	Title 132kv BUS COUPLER RELAY PANEL (=E11+RP1) BAY CONCEPT & PROTECTION LOGICS	Drawing no. P60194-E-EBR-SC-001						
REV.	DESCRIPTION	DATE	DRAWER											Project no. P-60194	Sheet type AE

All information contained in this document is the exclusive property of GE GRID SOLUTIONS and shall not be used, copied or communicated to third parties without its prior authorization.

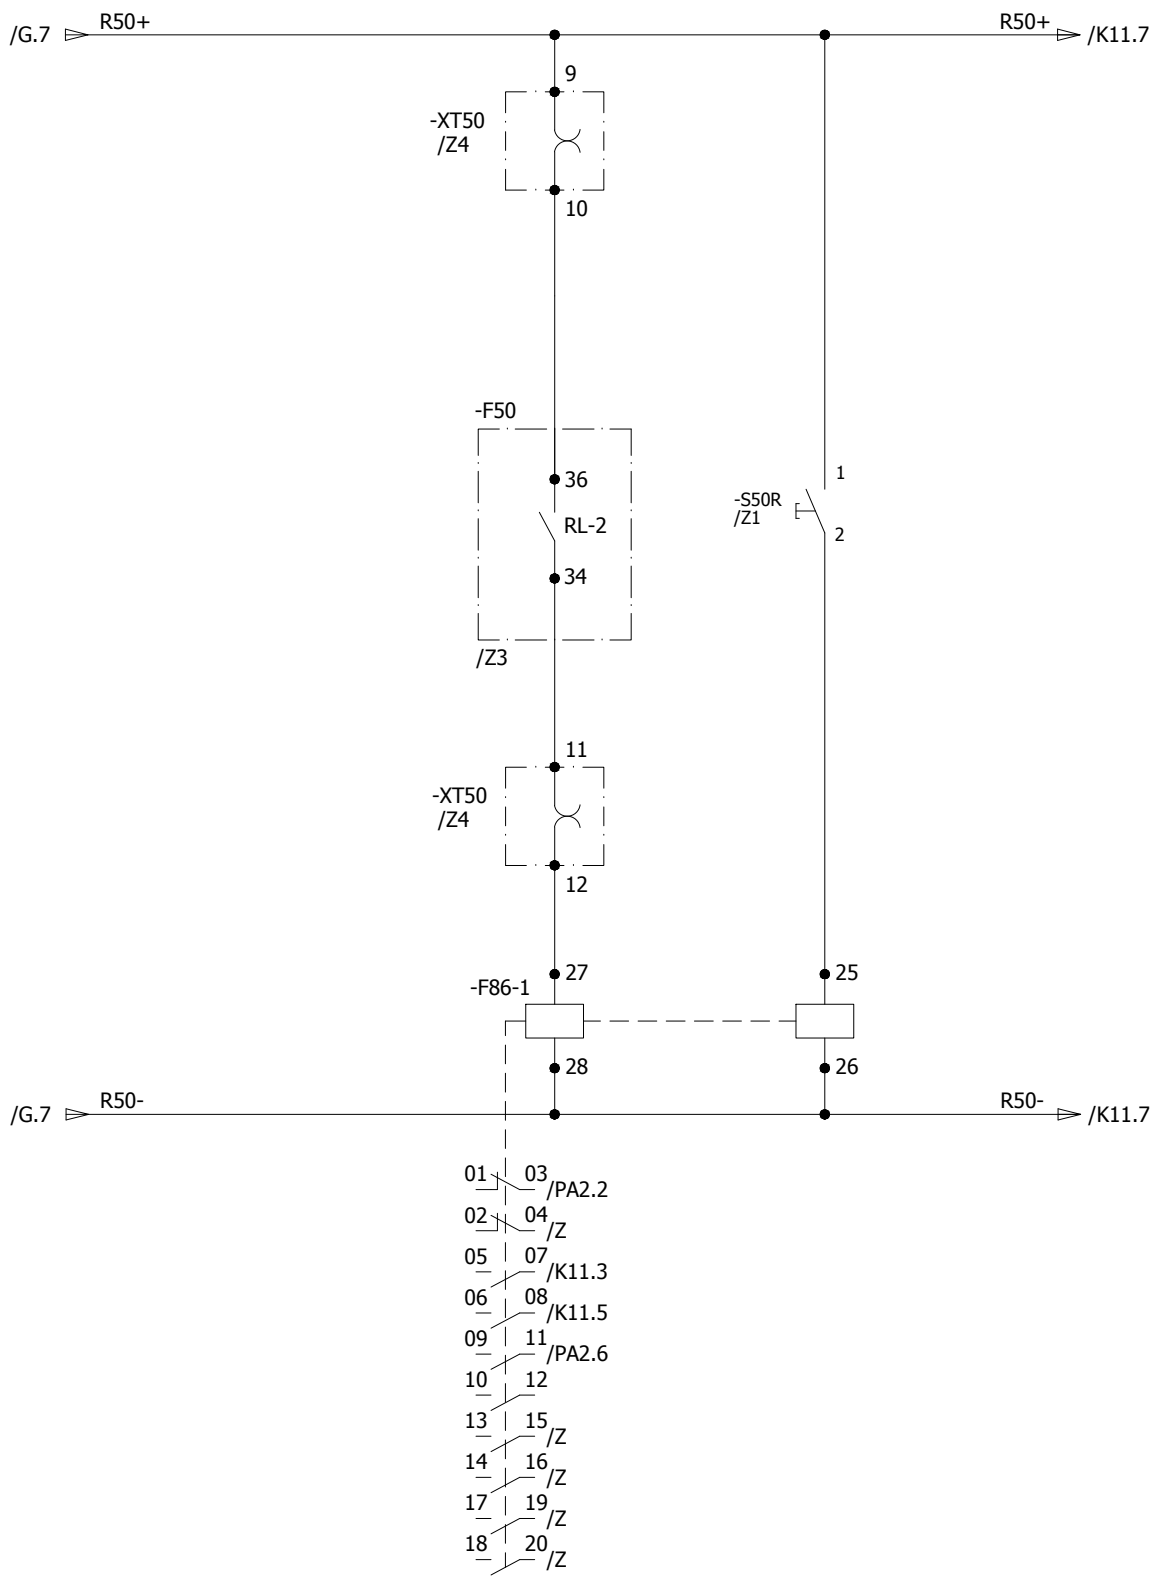





0	AS BUILT	18.08.2018	MSC	<div><div>EPESOL 71-B Garden Block, New Garden Town, Lahore, Pakistan</div></div>	<div><div>Grid Solutions A GE and Alstom joint venture</div></div>	<div><div>NATIONAL TRANSMISSION & DISPATCH COMPANY LIMITED (NTDC-WAPDA)</div></div>	Project 220kv/132kv GIS SUBSTATION GHAZI ROAD, LAHORE	Title 132kv BUS COUPLER RELAY PANEL (=E11+RP1) AC SUPPLY DISTRIBUTION	Drawing no. P60194-E-EBR-SC-001		
Project no. P-60194	Sheet type D	Sheet no. 07									
REV.	DESCRIPTION	DATE	DRAWER								

LA

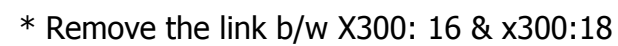
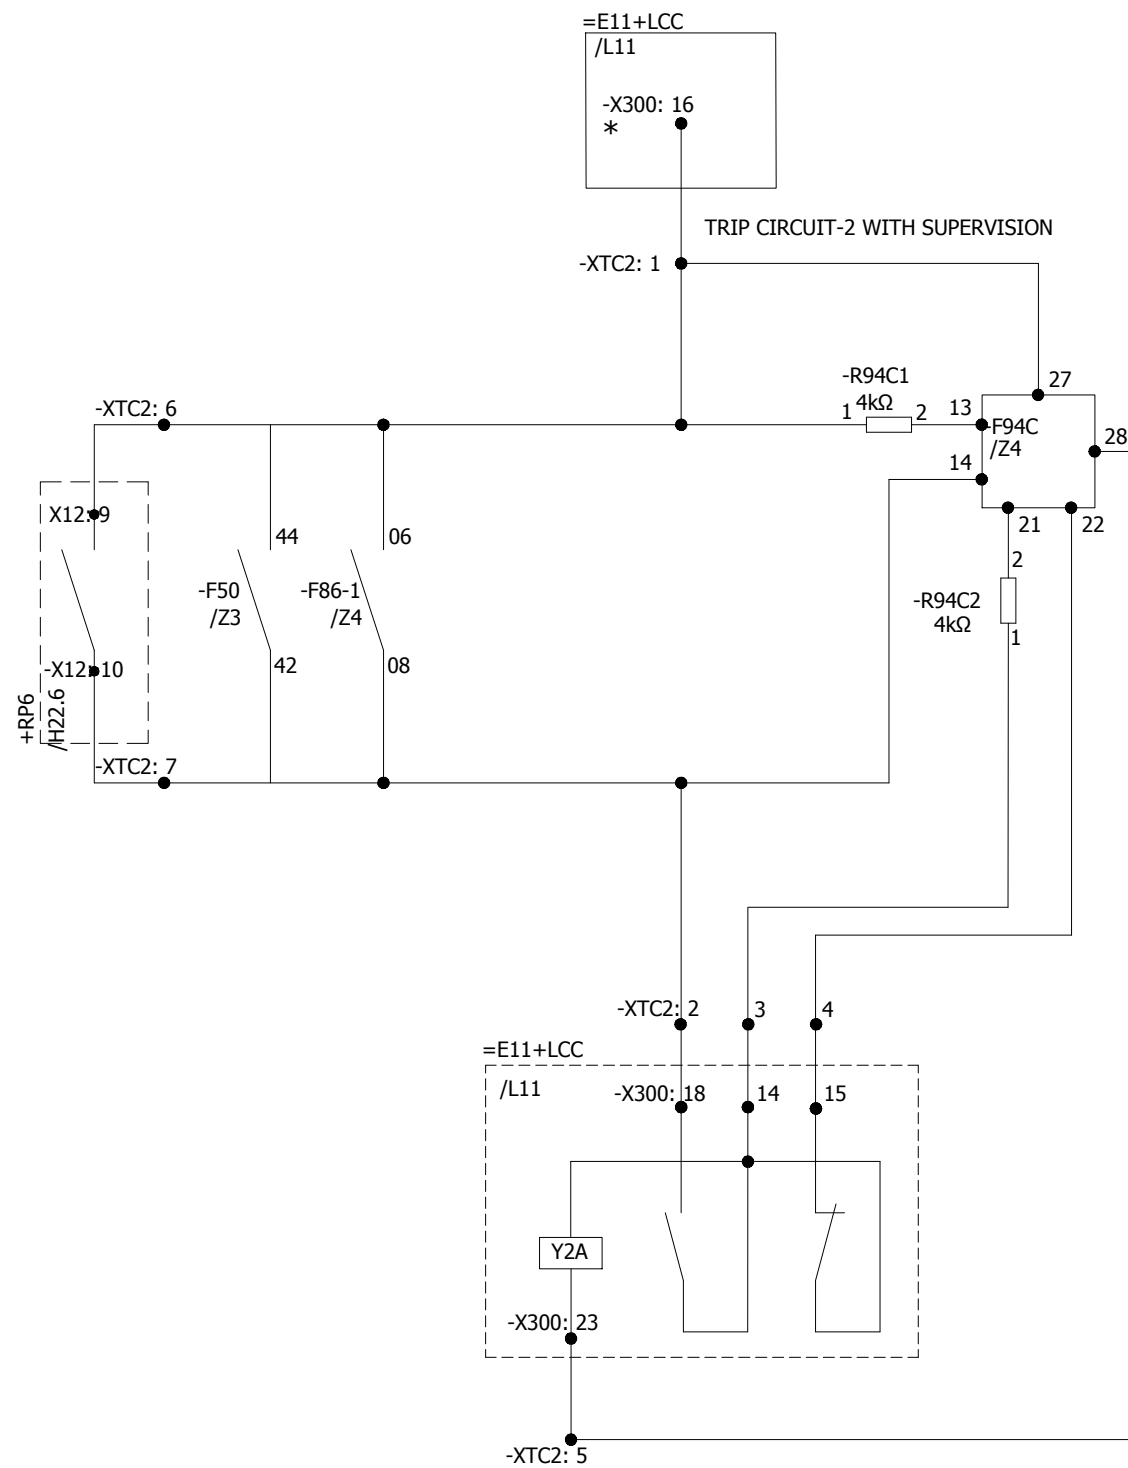
F

All information contained in this document is the exclusive property of GE GRID SOLUTIONS and shall not be used, copied or communicated to third parties without its prior authorization.



0	AS BUILT	18.08.2018	MSC	Manufacturer	Contractor	Client	Project	Title	Drawing no.		
				 EPESOL 71-B Garden Block, New Garden Town, Lahore, Pakistan	 Grid Solutions A GE and Alstom joint venture	 NATIONAL TRANSMISSION & DISPATCH COMPANY LIMITED (NTDC-WAPDA)	220kV/132kV GIS SUBSTATION GHAZI ROAD, LAHORE	132kV BUS COUPLER RELAY PANEL (=E11+RP1) PROTECTION TRIPS	P60194-E-EBR-SC-001		
									Project no.	Sheet type	Sheet no.
REV.	DESCRIPTION	DATE	DRAWER						P-60194	K1	12

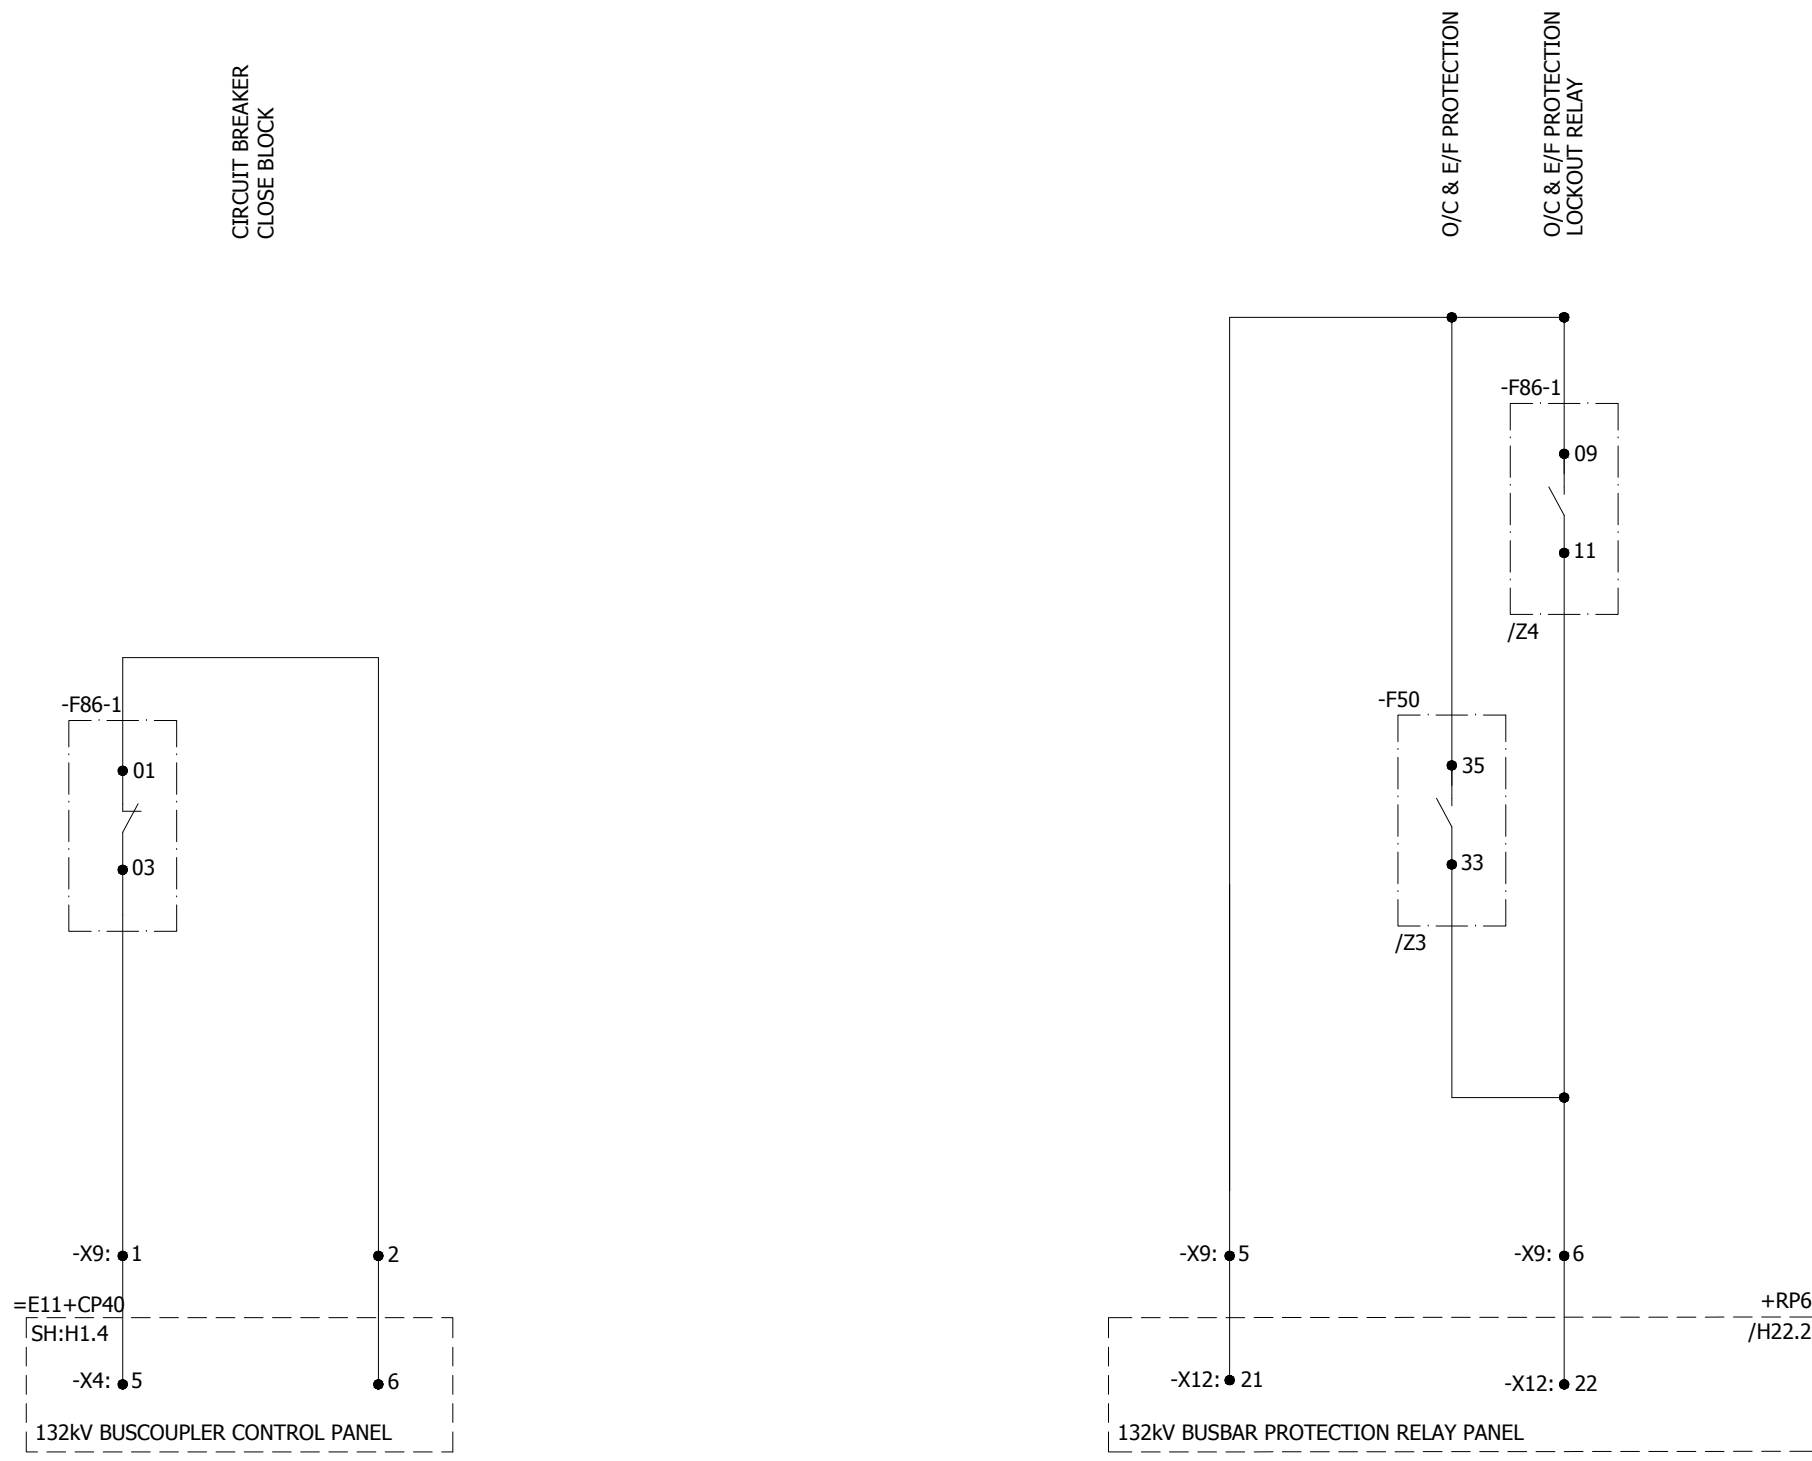
F




F

F

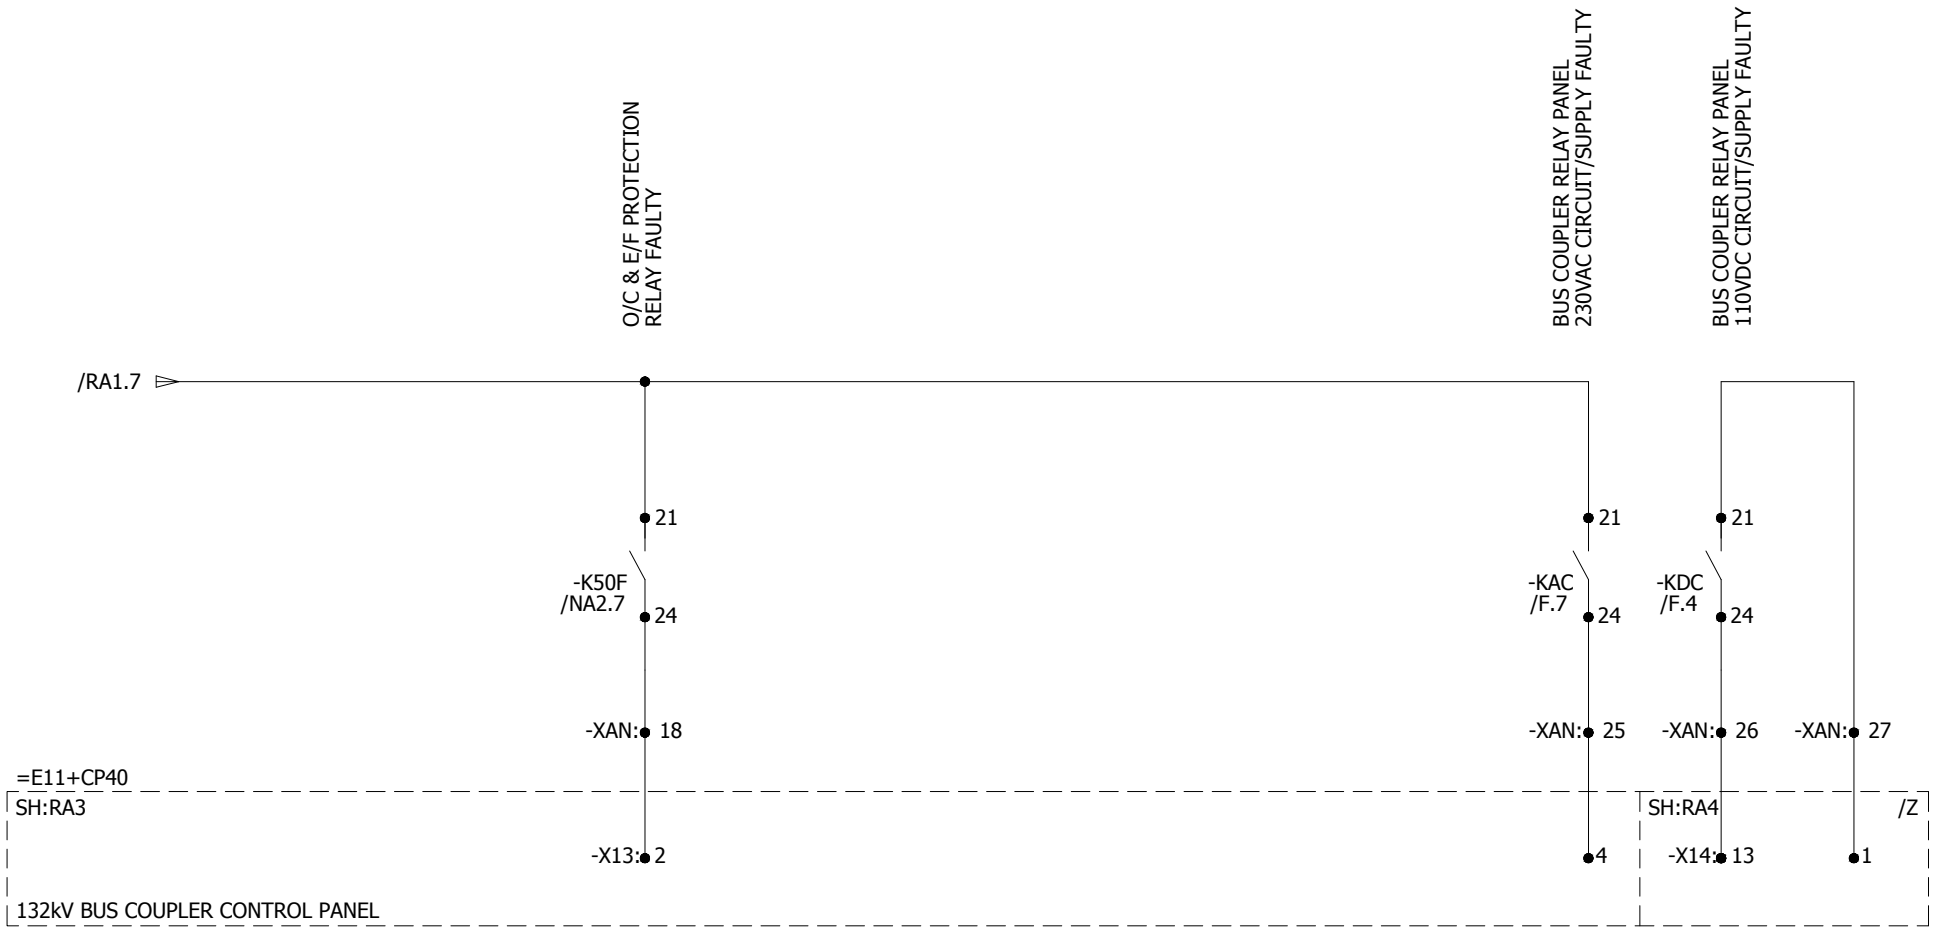
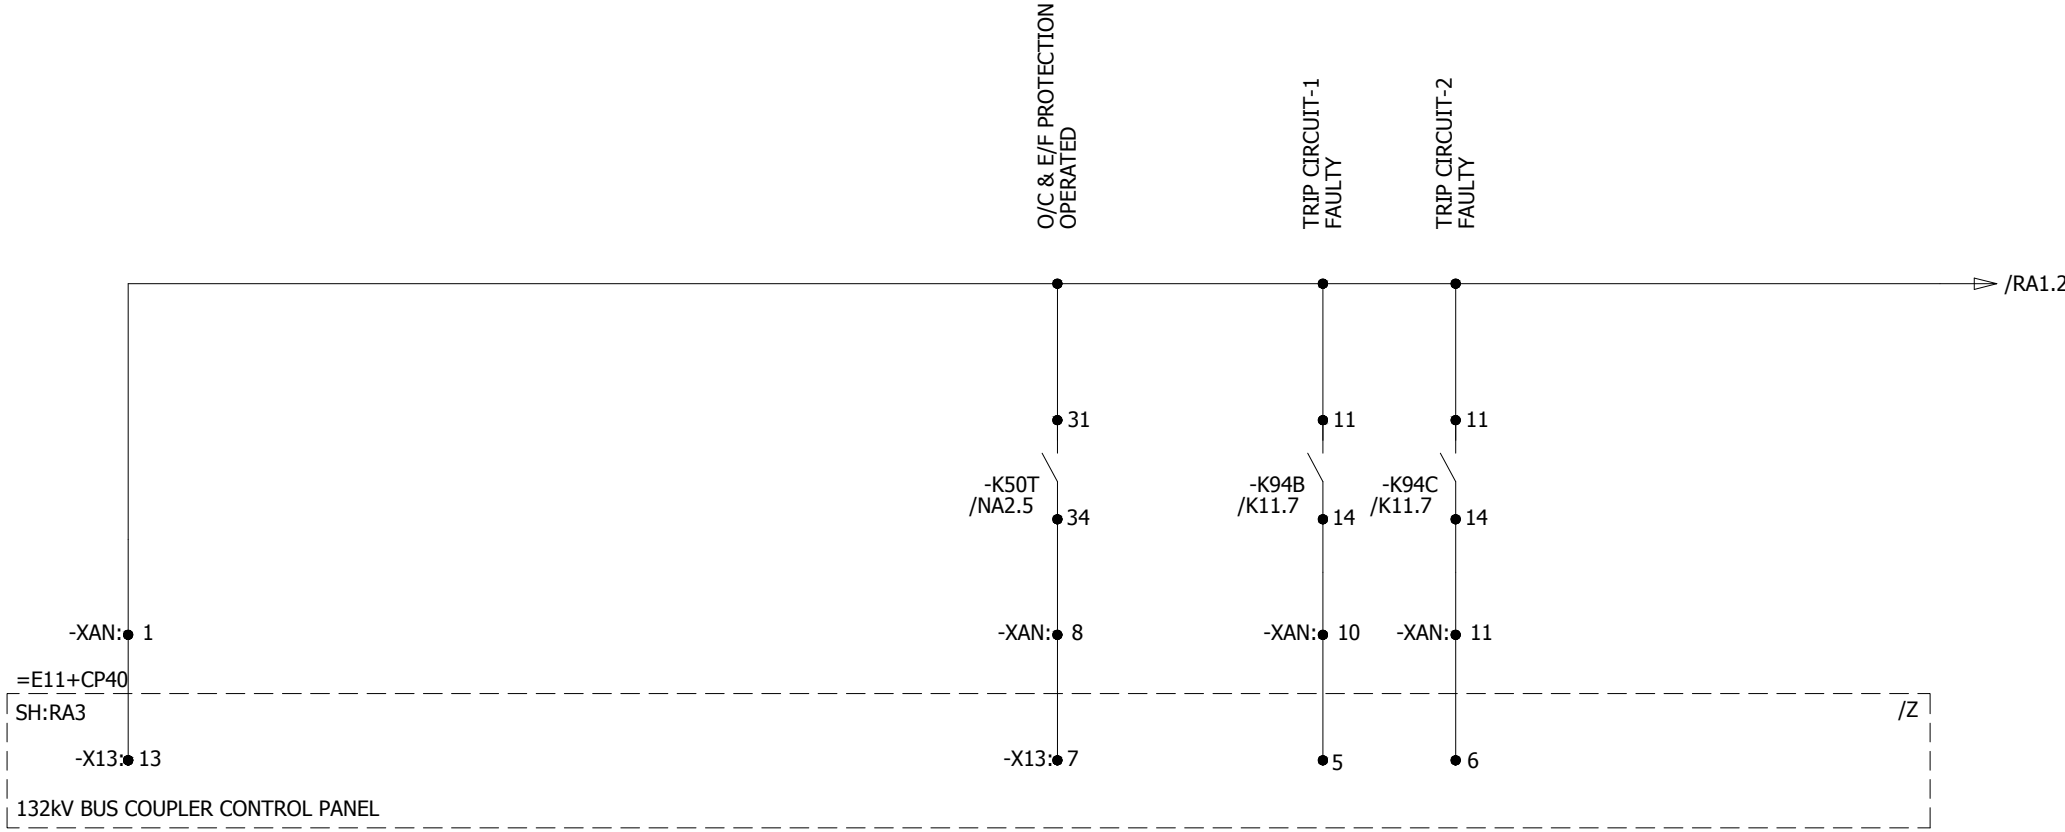





All information contained in this document is the exclusive property of GE GRID SOLUTIONS and shall not be used, copied or communicated to third parties without its prior authorization.



0	AS BUILT	18.08.2018	MSC	<div><div></div><div>EPESOL 71-B Garden Block, New Garden Town, Lahore, Pakistan</div></div>	<div><div></div><div>Grid Solutions A GE and Alstom joint venture</div></div>	<div><div></div><div>NATIONAL TRANSMISSION & DISPATCH COMPANY LIMITED (NTDC-WAPDA)</div></div>	Project 220kv/132kv GIS SUBSTATION GHAZI ROAD, LAHORE	Title 132kv BUS COUPLER RELAY PANEL (=E11+RP1) PROTECTION INTER-CIRCUITS	Drawing no. P60194-E-EBR-SC-001		
Project no. P-60194	Sheet type PA2	Sheet no. 15									
REV.	DESCRIPTION	DATE	DRAWER								

All information contained in this document is the exclusive property of GE GRID SOLUTIONS and shall not be used, copied or communicated to third parties without its prior authorization.

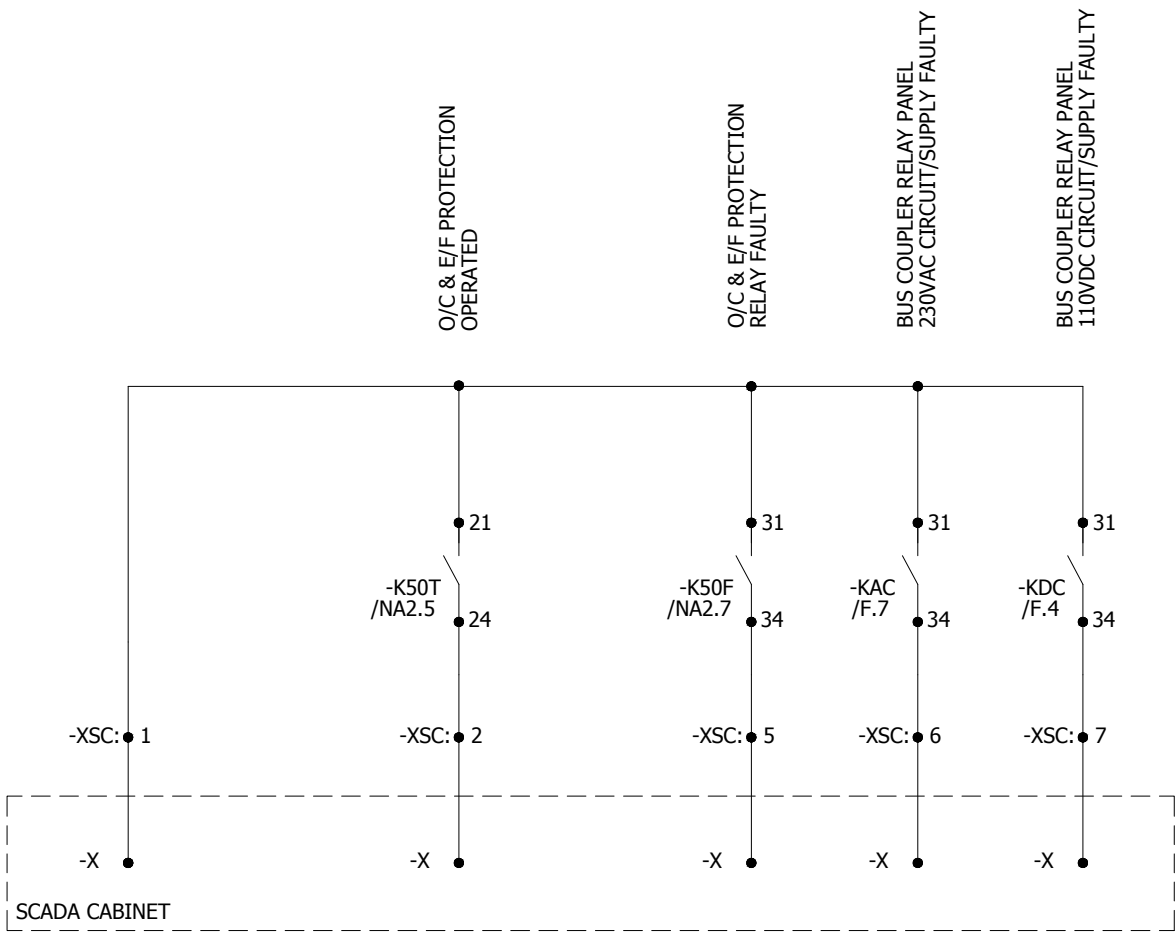





0	AS BUILT	18.08.2018	MSC	Manufacturer	Contractor	Client	Project	Title	Drawing no.		
				 EPESOL 71-B Garden Block, New Garden Town, Lahore, Pakistan	 Grid Solutions A GE and Alstom joint venture	 NATIONAL TRANSMISSION & DISPATCH COMPANY LIMITED (NTDC-WAPDA)	220kV/132kV GIS SUBSTATION GHAZI ROAD, LAHORE	132kV BUS COUPLER RELAY PANEL (=E11+RP1) ANNUNCIATION CIRCUIT	P60194-E-EBR-SC-001		
									Project no.	Sheet type	Sheet no.
REV.	DESCRIPTION	DATE	DRAWER						P-60194	RA1	16

A

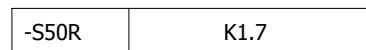
F

All information contained in this document is the exclusive property of GE GRID SOLUTIONS and shall not be used, copied or communicated to third parties without its prior authorization.

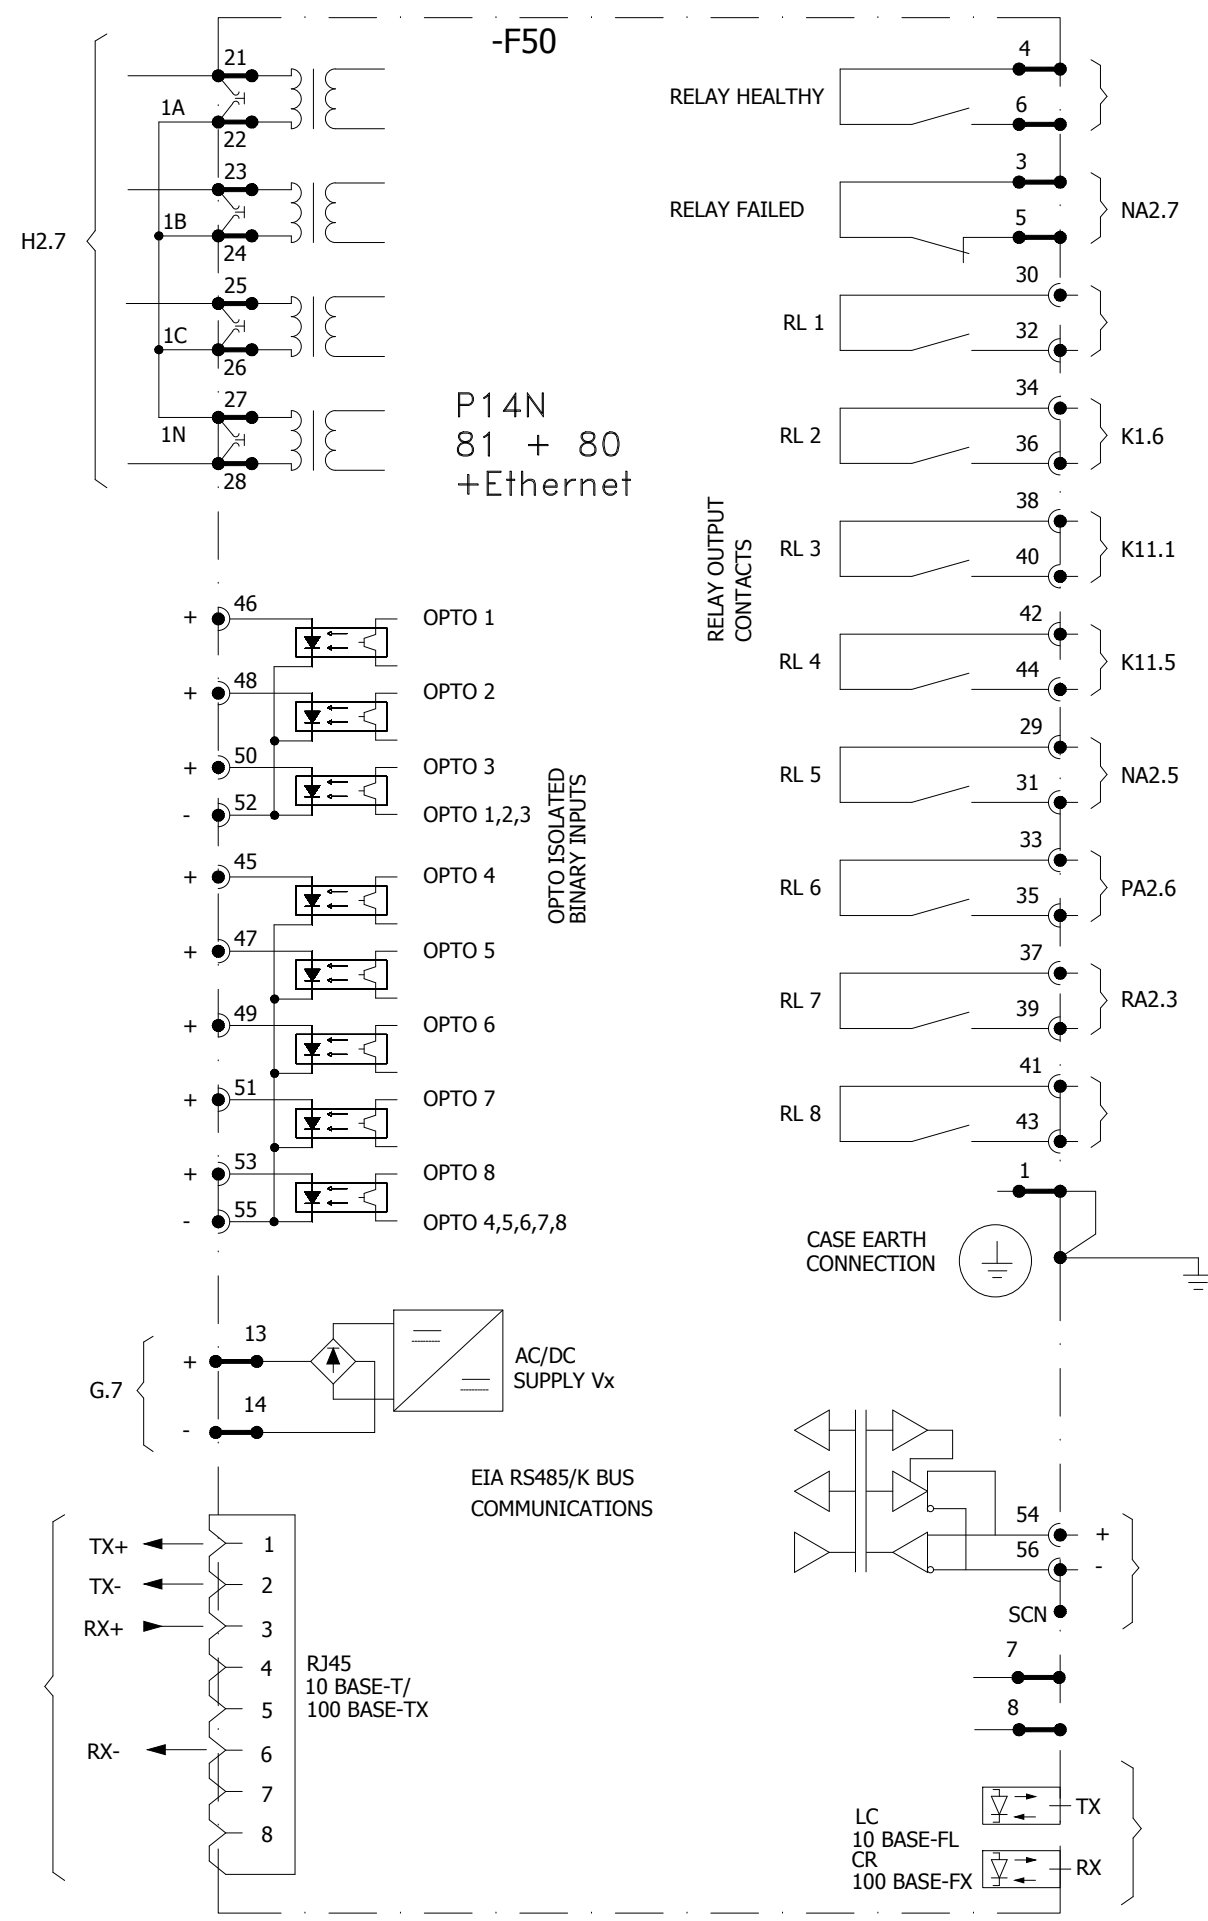





0	AS BUILT	18.08.2018	MSC	<div><div></div><div>EPESOL 71-B Garden Block, New Garden Town, Lahore, Pakistan</div></div> <div><div></div><div>Grid Solutions A GE and Alstom joint venture</div></div> <div><div></div><div>NATIONAL TRANSMISSION & DISPATCH COMPANY LIMITED (NTDC-WAPDA)</div></div> <div><div>220kV/132kV GIS SUBSTATION GHAZI ROAD, LAHORE</div></div> <div><div>132kV BUS COUPLER RELAY PANEL (=E11+RP1) SCADA CIRCUIT</div></div> <div><div>Drawing no. P60194-E-EBR-SC-001</div><div><div>Project no. P-60194</div><div>Sheet type RA3</div><div>Sheet no. 18</div></div></div>			
REV.	DESCRIPTION	DATE	DRAWER				

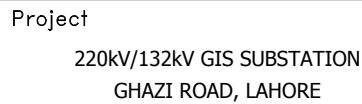
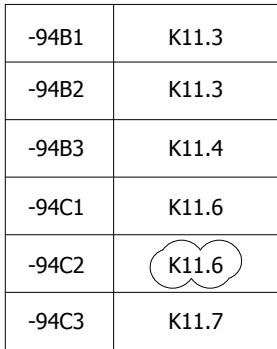
F

8

All information contained in this document is the exclusive property of GE GRID SOLUTIONS and shall not be used, copied or communicated to third parties without its prior authorization.



0	AS BUILT	18.08.2018	MSC	Manufacturer	Contractor	Client	Project	Title	Drawing no.		
				 71-B Garden Block, New Garden Town, Lahore, Pakistan	 A GE and Alstom joint venture	 NATIONAL TRANSMISSION & DISPATCH COMPANY LIMITED (NTDC-WAPDA)	220kV/132kV GIS SUBSTATION GHAZI ROAD, LAHORE	132kV BUS COUPLER RELAY PANEL (=E11+RP1) COMPONENT DIAGRAM	P60194-E-EBR-SC-001		
REV.	DESCRIPTION	DATE	DRAWER						Project no.	Sheet type	Sheet no.
									P-60194	Z3	20



 **EPESOL**
71-B Garden Block,
New Garden Town,
Lahore, Pakistan

