



Grid Solutions

A GE and Alstom joint venture

220kV/132kV GIS SUBSTATION GHAZI ROAD , LAHORE

220kV SYNCHRONIZING PANEL (=D00+C6)

SCHEMATIC DRAWINGS

| | 1 | 2 | 3 | 4 | 5 | 6 | 7 | 8 | | | | | | | |
|---|----------------|----------------------|------------------------------------------|--------|-------------------------------------------------------------------------------------------------------------------------------------------------------------------------|-----------------------------------------------------------------------------------------------------------------------------------------------------|---------------------------------------------------------------------------------------------------------------------------------------------------------------------|-------------------------------------------------------------|---------------------------------------------------------------------|------------------------------------|------------------|-----------------|----|----|----|
| | PAGE NO. | SHEET NAME | SHEET DESCRIPTION | | | ISSUE / REVISION | | | | | | | | | |
| | | | | | | A | B | C | D | E | F | 01 | 02 | 03 | 04 |
| A | 01 | A | Cover Sheet | | | | | | | | | | | | |
| | 02 | AA | List Of Contents | | | | | | | | | | | | |
| | 03 | AB | Symbols and Legends | | | | | | | | | | | | |
| | 04, 04a | AC, AC-1 | Component List | | | | | | | | | | | | |
| | 05, 05a | AD, AD-1 | Panel View | | | | | | | | | | | | |
| B | 06 | D | AC Supply Distribution Circuit | | | | | | | | | | | | |
| | 07 | E | DC Supply Distribution Circuit | | | | | | | | | | | | |
| | 08 | F | AC/DC Supply Failure Circuits | | | | | | | | | | | | |
| | 09 | G1 | Relay Control & Supply Circuits | | | | | | | | | | | | |
| | 10, 11 | H1, H2 | VT CIRCUIT | | | | | | | | | | | | |
| | 12, 13 | I1, I2 | Timer Circuit | | | | | | | | | | | | |
| | 14 | I3 | Sync Enable Circuit | | | | | | | | | | | | |
| C | 15 | I4 | CB Selection for Sync | | | | | | | | | | | | |
| | 16, 16a | I5, 15-1 | Sync Key Interlocking Circuit | | | | | | | | | | | | |
| | 17 | I6 | BUS-1 VT HEALTH STATUS | | | | | | | | | | | | |
| | 18 | I7 | BUS-2 VT HEALTH STATUS | | | | | | | | | | | | |
| | 19 | I8 | LINE VT HEALTH STATUS | | | | | | | | | | | | |
| D | 20 | K1 | Synchro Check Relay Contact | | | | | | | | | | | | |
| | 21, 22 | K2, K3 | Common Alarms Circuit | | | | | | | | | | | | |
| | 23 | PA1 | CB CLOSING PERMISSION | | | | | | | | | | | | |
| | 24, 25, 26, 27 | RA1, RA2, RA2-1, RA3 | CP Annunciation, Event AND SCADA Circuit | | | | | | | | | | | | |
| | 28 | Z1 | Component Diagram | | | | | | | | | | | | |
| | 29 | Z2 | Component Diagram | | | | | | | | | | | | |
| E | | | | | | | | | | | | | | | |
| F | | | | | | | | | | | | | | | |
| | 0 | AS BUILT | 18.08.2018 | MSC | Manufacturer  EPESOL 7-B Garden Block, New Garden Town, Lahore, Pakistan | Contractor  Grid Solutions A GE and Alstom joint venture | Client  NATIONAL TRANSMISSION & DISPATCH COMPANY LIMITED (NTDC-WAPDA) | Project 220kV/132kV GIS SUBSTATION GHAZI ROAD, LAHORE | Title 220kV SYNCHRONIZING PANEL (=D00+C6) LIST OF CONTENTS | Drawing no. P60194-E-DSC-SC-001 | | | | | |
| | REV. | DESCRIPTION | DATE | DRAWER | | | | | | Project no. P-60194 | Sheet type AA | Sheet no. 02 | | | |

| | SYMBOL | DESCRIPTION | SYMBOL | DESCRIPTION | SYMBOL | DESCRIPTION | SYMBOL | DESCRIPTION |
|---|--------|----------------------------------------|--------|-----------------------------------|--------|---------------------------|---------|-------------------------|
| A | | CIRCUIT BREAKER | | MINIATURE CIRCUIT BREAKER | | AUXILIARY CONTACTOR NO+NC | 21 | DISTANCE |
| B | | SWITCH/ISOLATOR | | KEY OPERATED SELECTOR SWITCH | | AMMETER | 24 | OVEREXCITATION |
| C | | EARTHING | | LIMITED SWITCH | | VOLTMETER | 25 | SYNCHROCHECK |
| D | | SF6 TO AIR BUSHING | | HUMIDITY & TEMPERATURE CONTROLLER | | POWER FACTOR METER | 49 | THERMAL OVERLOAD |
| E | | LINE TRAP | | PANEL HEATER | | DIGITAL PANEL METER | 50/51 | PHASE INST./OVERCURRENT |
| F | | SURGE ARRESTOR | | THREE PIN SOCKET | | ACTIVE POWER METER | 50N/51N | EARTH INST./OVERCURRENT |
| G | | CURRENT TRANSFORMER | | INDICATION LIGHT | | REACTIVE POWER METER | 50BF | CIRCUIT BREAKER FAILURE |
| H | | COUPLING CAPACITOR VOLTAGE TRANSFORMER | | PUSH BUTTON | | ENERGY METER | 64 | RESTRICTED EARTH FAULT |
| I | | POWER TRANSFORMER | | AUXILIARY CONTACTOR COIL | | | 67N | DIRECTIONAL EARTH FAULT |
| J | | AUTO TRANSFORMER | | POWER SUPPLY AC/DC | | | 68 | POWER SWING BLOCKING |
| K | | | | TERMINAL | | | 24 | OVER EXCITATION |
| L | | | | OPTO CONTACTS | | | 79 | AUTO-RECLOSING |
| M | | | | RELAY CONTACTS | | | 49 | THERMAL OVERLOAD |
| N | | | | HOOTER | | | 87T | TRAFO DIFFERENTIAL |
| O | | | | AC BELL | | | 87C | DIFFERENTIAL CONNECTION |
| P | | | | | | | 87BB | DIFFERENTIAL BUSBAR |

All information contained in this document is the exclusive property of GE GRID SOLUTIONS and shall not be used, copied or communicated to third parties without its prior authorization.

1 AS BUILT 18.08.2018 MSC Manufacturer EPESOL 71-B Garden Block, New Garden Town, Lahore, Pakistan

Contractor Grid Solutions A GE and Alstom joint venture

Client NATIONAL TRANSMISSION & DISPATCH COMPANY LIMITED (NTDC-WAPDA)

Project 220kV/132kV GIS SUBSTATION GHAZI ROAD, LAHORE

Title 220kV SYNCHRONIZING PANEL (=D00+C6) SYMBOLA AND LEGENDS


Drawing no. P60194-E-DSC-SC-001

Project no. P-60194 Sheet type AB Sheet no. 03


| | 1 | 2 | 3 | 4 | 5 | 6 | 7 | 8 | | | |
|---|------|-----------------------------------------|---|--------------------------------------------------------------------------------------------------------------------------------------------------------|--------|----------------------------------------------------------------------------------------------------------------------------------------------------------------------------|------------------------------------------------------------------------------------------------------------------------------------------------------------------------------------------------------------------------------------------------------------------------------------------------------------|---------------------------------------------------------------------------------------------------------------------------------------------------------------------|-------------------------------------------------------------|-------------------------------------------------------------------|------------------------------------|
| | QTY. | DEVICE DESCRIPTION | | DEVICE SPECIFICATIONS DEVICE TYPE ; TECHNICAL DATA / SPECIFICATIONS | | | DEVICE DESIGNITION | | MANUFACTURER | | |
| | | | | | | | | | | | |
| A | 01 | SYNCHRO CHECK RELAY | | AGILE P94V, Cortec: P94VP16A7C0520A Supply: 24-250VDC / 110-240VAC, 4 VT Inputs, 8 Opto Inputs, 8 Relay Outputs 8 Opto Inputs, 8 Relay Outputs | | | -F25 | | GE | | |
| | 01 | TEST BLOCK | | MMLG01, Cortec: MMLG01-R1AA9002D | | | -XT25 | | GE | | |
| | 02 | CONTROL MCB - PANEL LIGHT & HEATER | | 2-Pole, Ratings: 2A, 240VAC, 10kA @ 240VAC, 2 C/O Contacts, Ord: G62C02+CAH(2) | | | -F101-102 | | GE | | |
| B | 01 | CONTROL MCB - AC BELL CIRCUIT | | 2-Pole, Ratings: 2A, 240VAC, 10kA @ 240VAC, 2 C/O Contacts, Ord: G62C02+CAH(2) | | | -F104 | | GE | | |
| | 01 | CONTROL ELCB - PANEL SOCKET | | 2-Pole, Ratings: 16A, 30mA, 240VAC, 1P+N, 2 C/O Contacts, Ord: DM100C16/030+CAH(2) | | | -F103 | | GE | | |
| | 02 | CONTROL MCB - DC DISTRIBUTION | | 2-Pole, Ratings: 4A, 250VDC, 10kA @ 250VDC, 2 C/O Contacts, Ord: EP102UCC04+CAH(2) | | | -F201-202 | | GE | | |
| | 01 | CONTROL MCB - DC HOOTER CIRCUIT | | 2-Pole, Ratings: 4A, 250VDC, 10kA @ 250VDC, 2 C/O Contacts, Ord: EP102UCC04+CAH(2) | | | -F203 | | GE | | |
| C | 02 | CONTACTOR RELAY | | Coil Voltage: 230VAC @ 50/60 Hz, 6A, 4 C/O Contacts, Ord: PRC4M40ANL | | | -KACM, -KDC | | GE | | |
| | 01 | AUXILIARY CONTACTOR - SUPPLY CHANGEOVER | | Coil Voltage: 220VDC, 16A, 3 NO + 3 NC Contacts, Ord: MCRC022ATWN+MARN211AT | | | -KCS | | GE | | |
| | 39 | CONTACTOR RELAY | | Coil Voltage: 220VDC, DIODE, 4 C/O Contacts, Ord: PRC4M40DCML | | | -KDCM, -KAC, -KS1, -KS1-1, -KS1-2, -KS1-3, -KS2, -KS2-1, -KS2-2, -KS2-3, -KS5, -KS5-1, -KS5-2, -KS5-3, -K11, -KS6, -KS6-1, -KS6-2, -KS6-3, -KS8, -KS8-1, -KS8-2, -KS8-3, -K12, -K25-1, -K25-2, -K25-3, -K25F, -K101, -K102, -K103, -K104, -K105, -KSCU1, -KSCU2, -KSCU5, -KSCU6, -KSCU8, -KDC1 | | GE | | |
| | 01 | TIMER | | Type: 220VDC, 0-60s, 2 C/O Contacts, Ord: AT8N | | | -KT | | AUTONICS | | |
| | 01 | INDICATION LAMP - DC SUPPLY FAILURE | | Type: Integrated LED, Color : RED , Supply : 230VAC @ 50Hz, Ord: YS-PL-2-AL-22-R-W | | | -H200 | | YONGSUNG | | |
| D | 01 | PUSH BUTTON - ACKNOWLEDGE | | Type: Switch (A Type), Color : BLACK , Supply : 220VDC, Ord: YS-AP1-2-31-B-D-W | | | -S21 | | YONGSUNG | | |
| | 01 | PUSH BUTTON - LAMP TEST | | Type: Switch (A Type), Color : RED , Supply : 220VDC, Ord: YS-AP1-2-31-R-D-W | | | -S22 | | YONGSUNG | | |
| | 01 | PUSH BUTTON - RESET | | Type: Switch (A Type), Color : GREEN , Supply : 220VDC, Ord: YS-AP1-2-31-G-D-W | | | -S23 | | YONGSUNG | | |
| E | 01 | PANEL LIGHT | | 230VAC @ 50Hz, 05W, Ord: YS-T8-30-5W | | | -H100 | | YONGSUNG | | |
| | 01 | DOOR SWTICH | | 230VAC @ 50Hz, 1 NO Contact, Ord: YS P3315GW-B + YS MS-C | | | -S100 | | YONGSUNG | | |
| | 01 | THREE PIN SOCKET | | 1N+PE, 16A, 230VAC @ 50Hz | | | -X100 | | LOCAL | | |
| F | 01 | PANEL HEATER | | 230VAC @ 50Hz, 60W | | | -R100 | | E-LABS | | |
| | 01 | HUMIDITY & TEMPERATURE CONTROLLER | | 40-90%RH, 25-50 deg.C, 230VAC @ 50Hz | | | -B100 | | E-LABS | | |
| | 01 | DUAL VOLT METER | | METER: 90 DEGREE ANALOGUE DOUBLE VOLT METER, INPUT 0...110/165 VAC (L-L), ACCURACY CLASS 1 SCALE 0...220/330 KV (MARKED RED AT 220 KV), Ord: F96YVE | | | -AP2 | | FRER | | |
| G | 01 | DUAL FREQUENCY METER | | METER: 90 DEGREE ANALOGUE DOUBLE FREQUENCY METER, INPUT 0...110/165 VAC (L-L), ACCURACY CLASS 0.1, SCALE 45...55 Hz, Ord: F96VFE | | | -AP1 | | FRER | | |
| | 01 | SYNCHROSCOPE | | SIZE: 96X96 mm, Ord: F96YX | | | -AP3 | | FRER | | |
| | 02 | ANNUNCIATORS | | 12-WINDOW, SUPPLY: 100-275VAC/ 100-375 VDC | | | -H11, -H12 | | E-LABS | | |
| H | 0 | AS BUILT | | 18.08.2018 | MSC | Manufacturer  EPESOL 7-B Garden Block, New Garden Town, Lahore, Pakistan | Contractor  GE Grid Solutions A GE and Alstom joint venture | Client  NATIONAL TRANSMISSION & DISPATCH COMPANY LIMITED (NTDC-WAPDA) | Project 220kV/132kV GIS SUBSTATION GHAZI ROAD, LAHORE | Title 220kV SYNCHRONIZING PANEL (=D00+C6) COMPONENT LIST | Drawing no. P60194-E-DSC-SC-001 |
| | | | | | | | Project no. P-60194 | | | | |
| | REV. | DESCRIPTION | | DATE | DRAWER | | | | | | |

| | 1 | 2 | 3 | 4 | 5 | 6 | 7 | 8 | | | | |
|------|-------------|------------------------------------------|------|------------------------------------------------------------------------|-----|---------------------------------------------------------------------------------------------------------------------------------------------------------------------------------|------------------------------------------------------------------------------------------------------------------------------------------------------------|--------------------------------------------------------------------------------------------------------------------------------------------------------------------------|-------------------------------------------------------------|-------------------------------------------------------------------|------------------------------------|--|
| | QTY. | DEVICE DESCRIPTION | | DEVICE SPECIFICATIONS DEVICE TYPE ; TECHNICAL DATA / SPECIFICATIONS | | | DEVICE DESIGNITION | MANUFACTURER | | | | |
| | | | | | | | | | | | | |
| A | 01 | AC BELL | | Type: Exposure, 220VAC, Ord: YS MB7-22A | | | -B1 | YONGSUNG | | | | |
| | 01 | DC HOOTER | | Type: AH-101, 220VDC | | | -H1 | E-LABS | | | | |
| B | 04 | TERMINAL BLOCKS - AC SUPPLY DISTRIBUTION | | Screw-type, Feed Through Terminal, CBD-4 | | | -XAC | CABUR | | | | |
| | 04 | TERMINAL BLOCKS - DC SUPPLY DISTRIBUTION | | Screw-type, Feed Through Terminal, CBD-4 | | | -XDC | CABUR | | | | |
| | 36 | TERMINAL BLOCKS - SYNC VT CIRCUIT | | Screw-type, Feed Through Terminal, SCB-6 | | | -X2, -X3, -X4, -X5, -X6, -X7 | CABUR | | | | |
| | 02 | TERMINAL BLOCKS - TIMER CIRCUIT | | Screw-type, Feed Through Terminal, CBD-4 | | | -X9 | CABUR | | | | |
| | 20 | TERMINAL BLOCKS - SYNC CIRCUIT | | Screw-type, Feed Through Terminal, CBD-4 | | | -X12 | CABUR | | | | |
| | 40 | TERMINAL BLOCKS - BUS VT HEALTH STATUS | | Screw-type, Feed Through Terminal, CBD-4 | | | -X13, -X8 | CABUR | | | | |
| | 20 | TERMINAL BLOCKS - COMMON ALARM SIGNALS | | Screw-type, Feed Through Terminal, CBD-4 | | | -X15, -X16 | CABUR | | | | |
| | 30 | TERMINAL BLOCKS - CB CLOSING PERMISSION | | Screw-type, Feed Through Terminal, CBD-4 | | | -X17, -X14 | CABUR | | | | |
| | 20 | TERMINAL BLOCKS - AC ANNUNCIATION | | Screw-type, Feed Through Terminal, CBD-4 | | | -XAN | CABUR | | | | |
| | 08 | TERMINAL BLOCKS - BELL/HOOTER CIRCUIT | | Screw-type, Feed Through Terminal, CBD-4 | | | -XF | CABUR | | | | |
| C | 30 | TERMINAL BLOCKS - ER, SCADA SIGNALS | | Screw-type, Feed Through Terminal, CBD-4 | | | -XEV, -XSC | CABUR | | | | |
| | 18 | TERMINAL BLOCKS - SPARE | | Screw-type, Feed Through Terminal, CBD-4 | | | -X | CABUR | | | | |
| D | 04 | TERMINAL BLOCKS - SPARE | | Screw-type, Feed Through Terminal, SCB-6 | | | -X | CABUR | | | | |
| | | | | | | | | | | | | |
| E | | | | | | | | | | | | |
| | | | | | | | | | | | | |
| F | 0 | AS BUILT | | 18.08.2018 | MSC | Manufacturer  EPESOL 71-B Garden Block, New Garden Town, Lahore, Pakistan | Contractor  Grid Solutions A GE and Alstom joint venture | Client  NATIONAL TRANSMISSION & DISPATCH COMPANY LIMITED (NTDC-WAPDA) | Project 220kV/132kV GIS SUBSTATION GHAZI ROAD, LAHORE | Title 220kV SYNCHRONIZING PANEL (=D00+C6) COMPONENT LIST | Drawing no. P60194-E-DSC-SC-001 | |
| | | | | | | | | | | | | |
| REV. | DESCRIPTION | | DATE | DRAWER | | | | | Project no. P-60194 | Sheet type AC1 | Sheet no. 04a | |


All information contained in this document is the exclusive property of GE GRID SOLUTIONS and shall not be used, copied or communicated to third parties without its prior authorization.

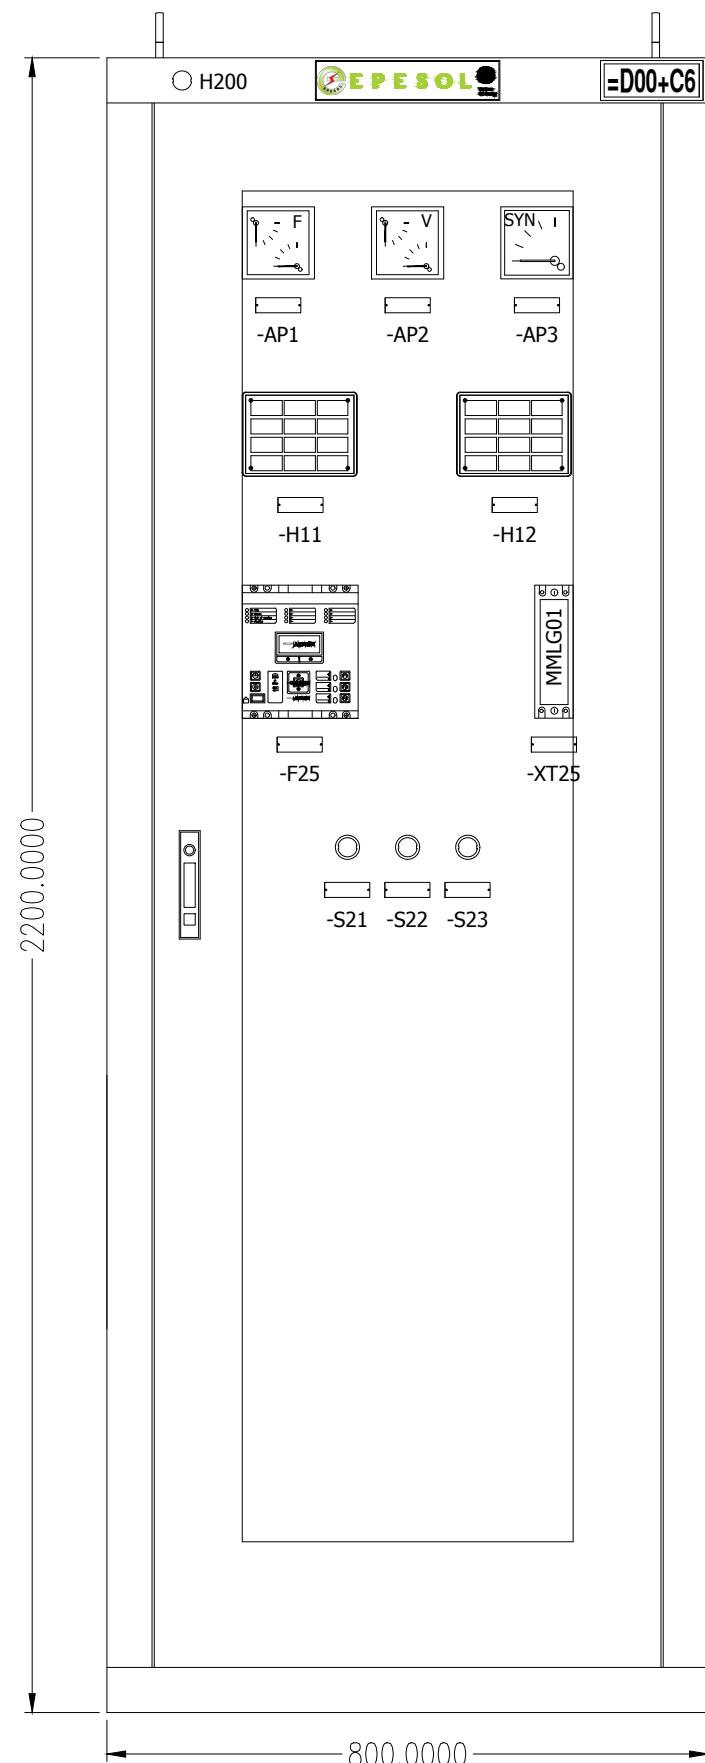

FRONT VIEW



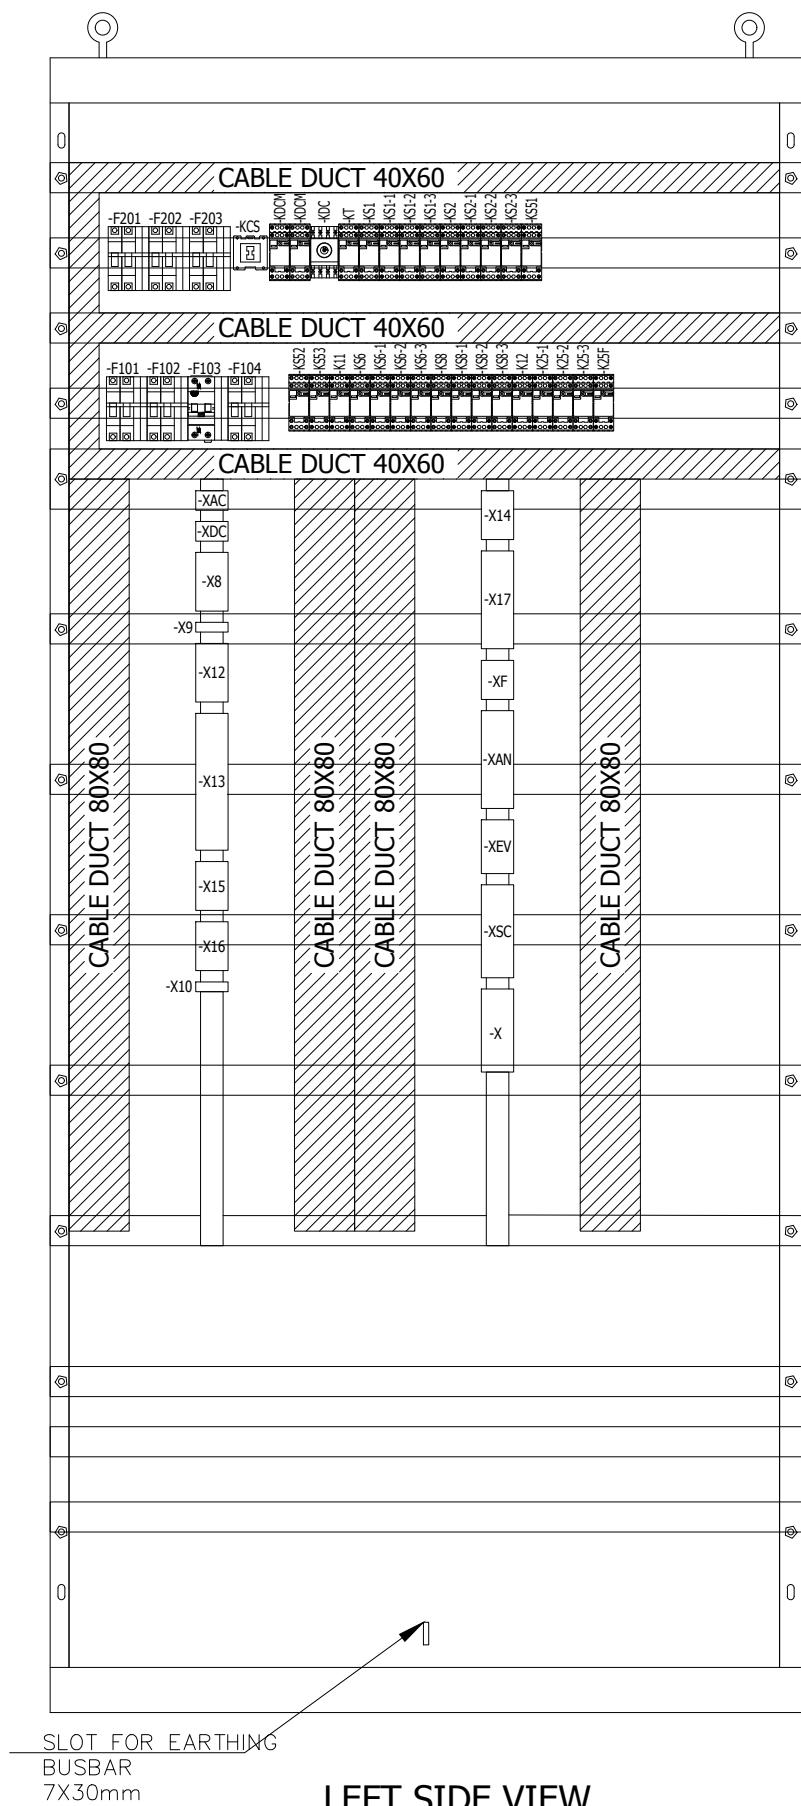


LEFT SIDE VIEW

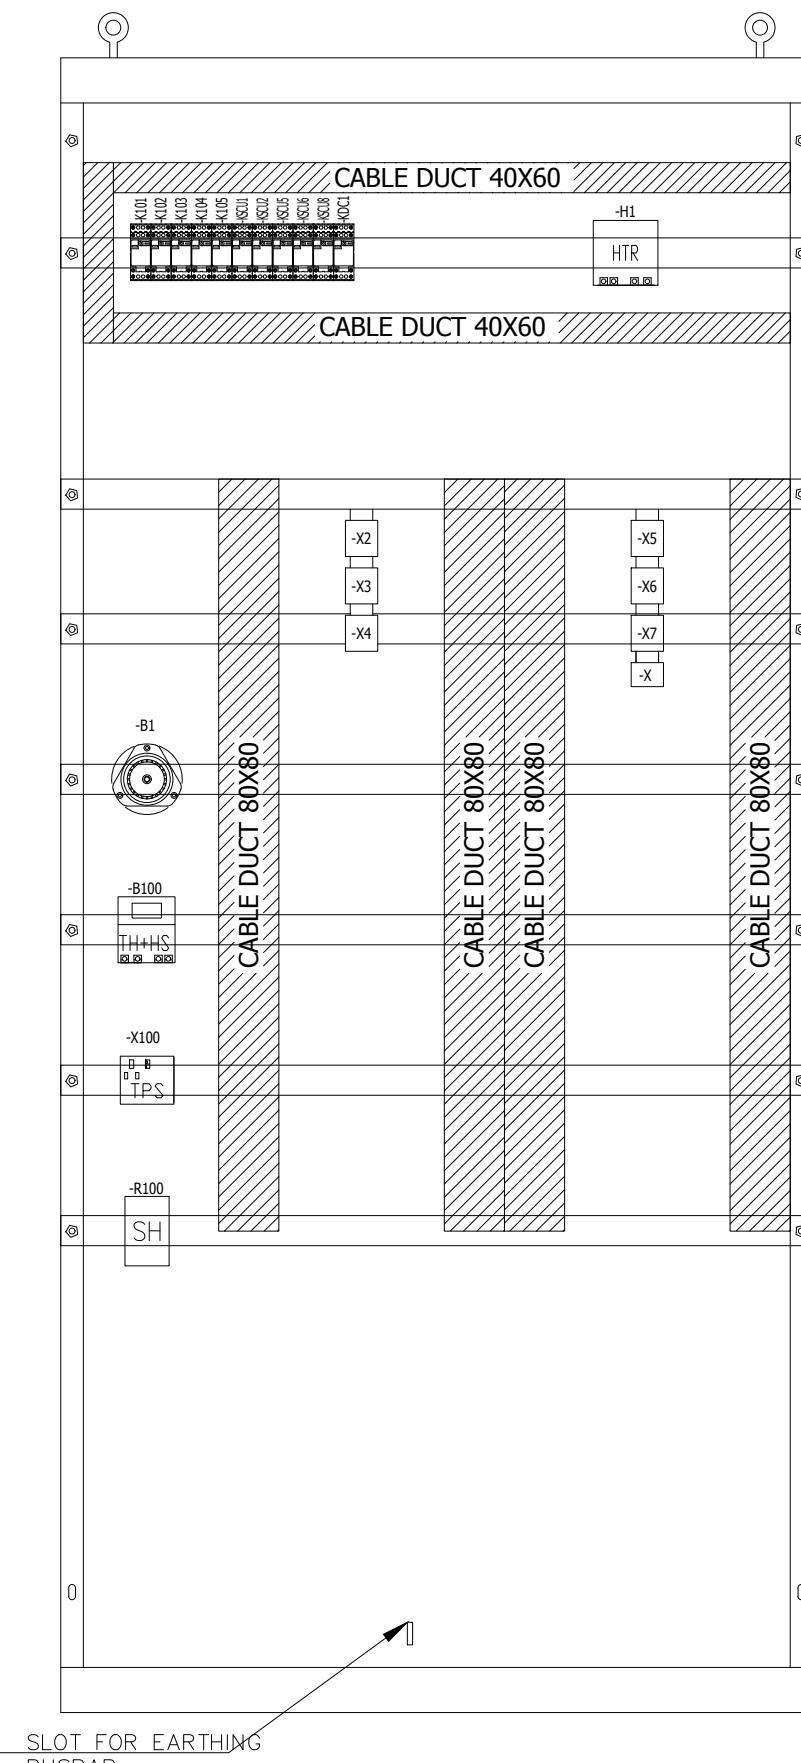

RIGHT SIDE VIEW

| 0 | AS BUILT | 18.08.2018 | MSC | Manufacturer  EPESOL 7-B Garden Block, New Garden Town, Lahore, Pakistan | Contractor  Grid Solutions A GE and Alstom joint venture | Client  NATIONAL TRANSMISSION & DISPATCH COMPANY LIMITED (NTDC-WAPDA) | Project 220kV/132kV GIS SUBSTATION GHAZI ROAD, LAHORE | Title 220kV SYNCHRONIZING PANEL (=D00+C6) PANEL VIEW | Drawing no. P60194-E-DSC-SC-001 | | |
|------|-------------|------------|--------|-------------------------------------------------------------------------------------------------------------------------------------------------------------------------|-----------------------------------------------------------------------------------------------------------------------------------------------------|---------------------------------------------------------------------------------------------------------------------------------------------------------------------|-------------------------------------------------------------|---------------------------------------------------------------|------------------------------------|------------------|-----------------|
| REV. | DESCRIPTION | DATE | DRAWER | | | | | | Project no. P-60194 | Sheet type AD | Sheet no. 05 |
| 1 | 2 | 3 | 4 | 5 | 6 | 7 | 8 | | | | |

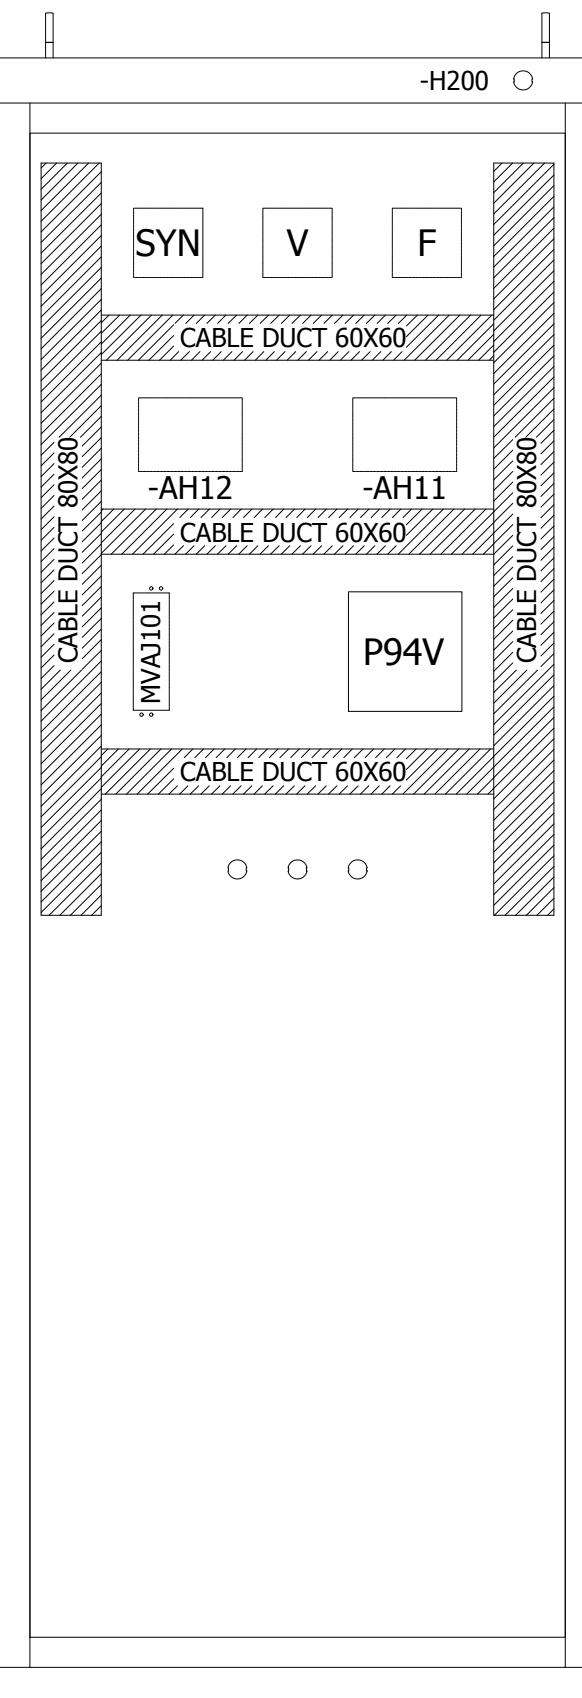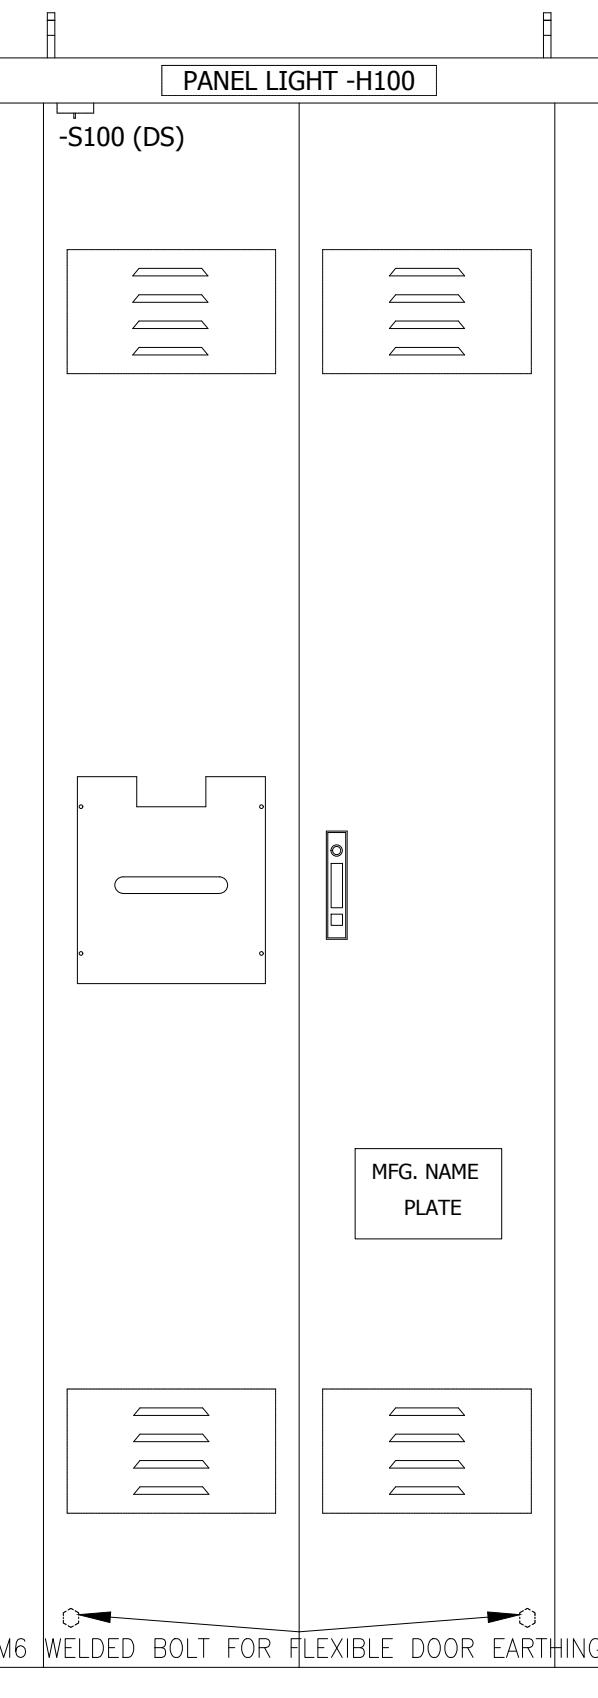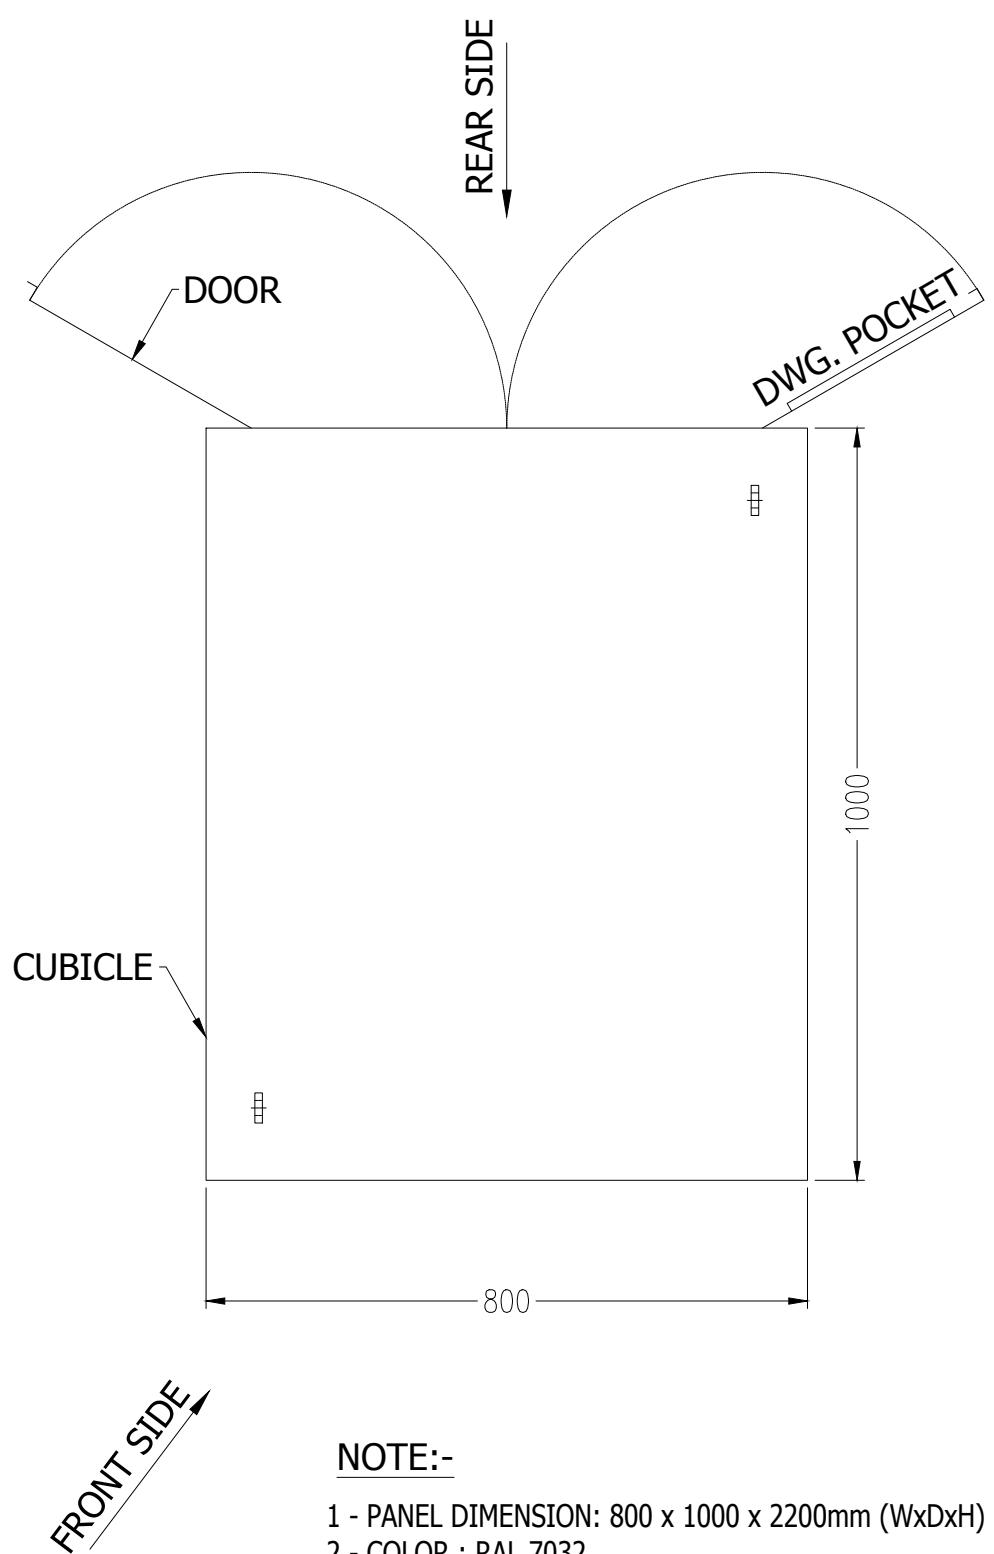BACK VIEWBACK VIEWTOP VIEW


All information contained in this document is the exclusive property of GE GRID SOLUTIONS and shall not be used, copied or communicated to third parties without its prior authorization.

| | | | | | | | | | |
|------|-------------|------------|--------|---------------------------------------------------------------------------------------------|----------------------------------------------------------------------|------------------------------------------------------------------------------------|------------------------------------------------------------|---------------------------------------------------------------|------------------------------------|
| 0 | AS BUILT | 18.08.2018 | MSC | Manufacturer EPESOL 71-B Garden Block, New Garden Town, Lahore, Pakistan | Contractor Grid Solutions A GE and Alstom joint venture | Client NATIONAL TRANSMISSION & DISPATCH COMPANY LIMITED (NTDC-WAPDA) | Project 220kV/132kV GIS SUBSTATION GAZI ROAD, LAHORE | Title 220kV SYNCHRONIZING PANEL (=D00+C6) PANEL VIEW | Drawing no. P60194-E-DSC-SC-001 |
| REV. | DESCRIPTION | DATE | DRAWER | | | | | | Project no. P-60194 |

NOTE:-


- 1 - PANEL DIMENSION: 800 x 1000 x 2200mm (WxDxH)
- 2 - COLOR : RAL 7032
- 3 - SHEET THICKNESS : 2-2.5 mm
- 4- PROTECTION CLASS : IP-51 (INDOOR TYPE)
- 5 - ALL DOOR FITTED WITH 16mm EARTH STRAP & INSULATED WITH GREEN-YELLOW COLOUR.

All information contained in this document is the exclusive property of GE GRID SOLUTIONS and shall not be used, copied or communicated to third parties without its prior authorization.

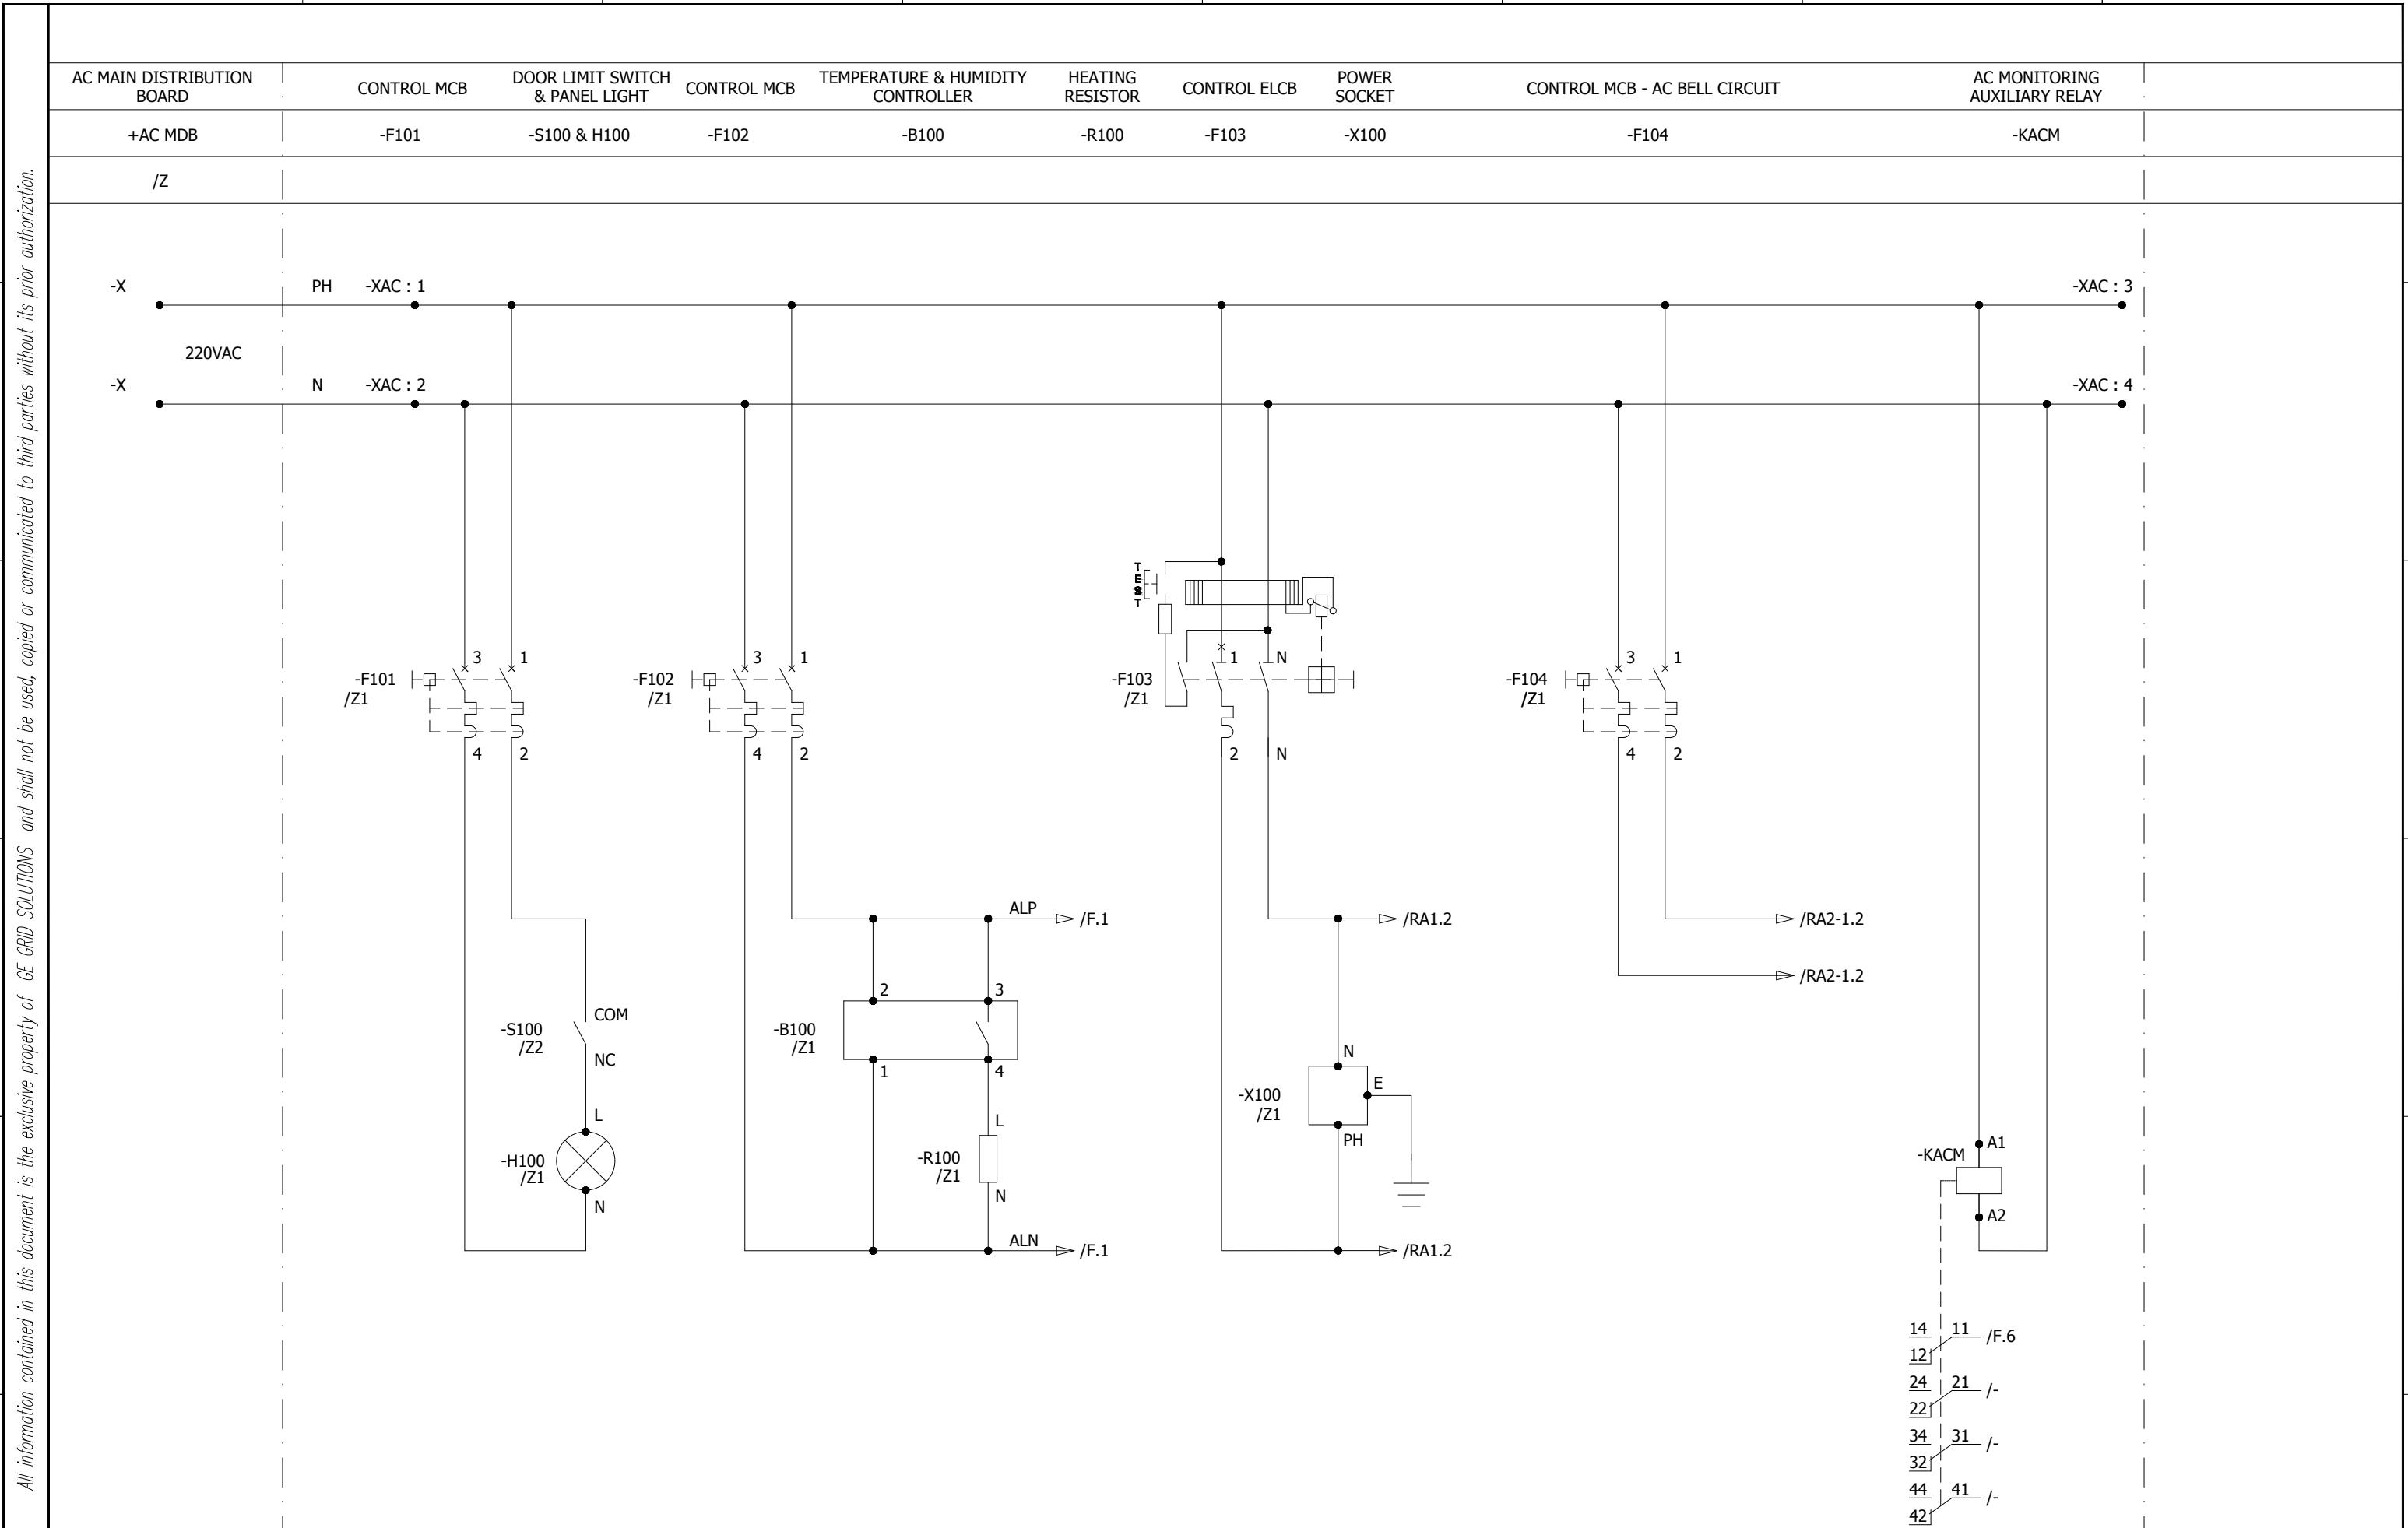

| 0 | AS BUILT | 18.08.2018 | MSC | Manufacturer | Contractor | Client | Project | Title | Drawing no. |
|------|-------------|------------|--------|-----------------------------------------------------------------------------|-----------------------------------------------------|-------------------------------------------------------------------------|--------------------------------------------------|------------------------------------------------------------------|-----------------------------------------------|
| | | | | EPESOL 71-B Garden Block, New Garden Town, Lahore, Pakistan | Grid Solutions A GE and Alstom joint venture | NATIONAL TRANSMISSION & DISPATCH COMPANY LIMITED (NTDC-WAPDA) | 220kV/132kV GIS SUBSTATION GHAZI ROAD, LAHORE | 220kV SYNCHRONIZING PANEL (=D00+C6) AC SUPPLY DISTRIBUTION | P60194-E-DSC-SC-001 |
| REV. | DESCRIPTION | DATE | DRAWER | | | | | | Project no. P-60194 Sheet type D Sheet no. 06 |

14 11 /F.6
 12 21 /-
 24 31 /-
 22 32 /-
 34 41 /-
 32 42 /-

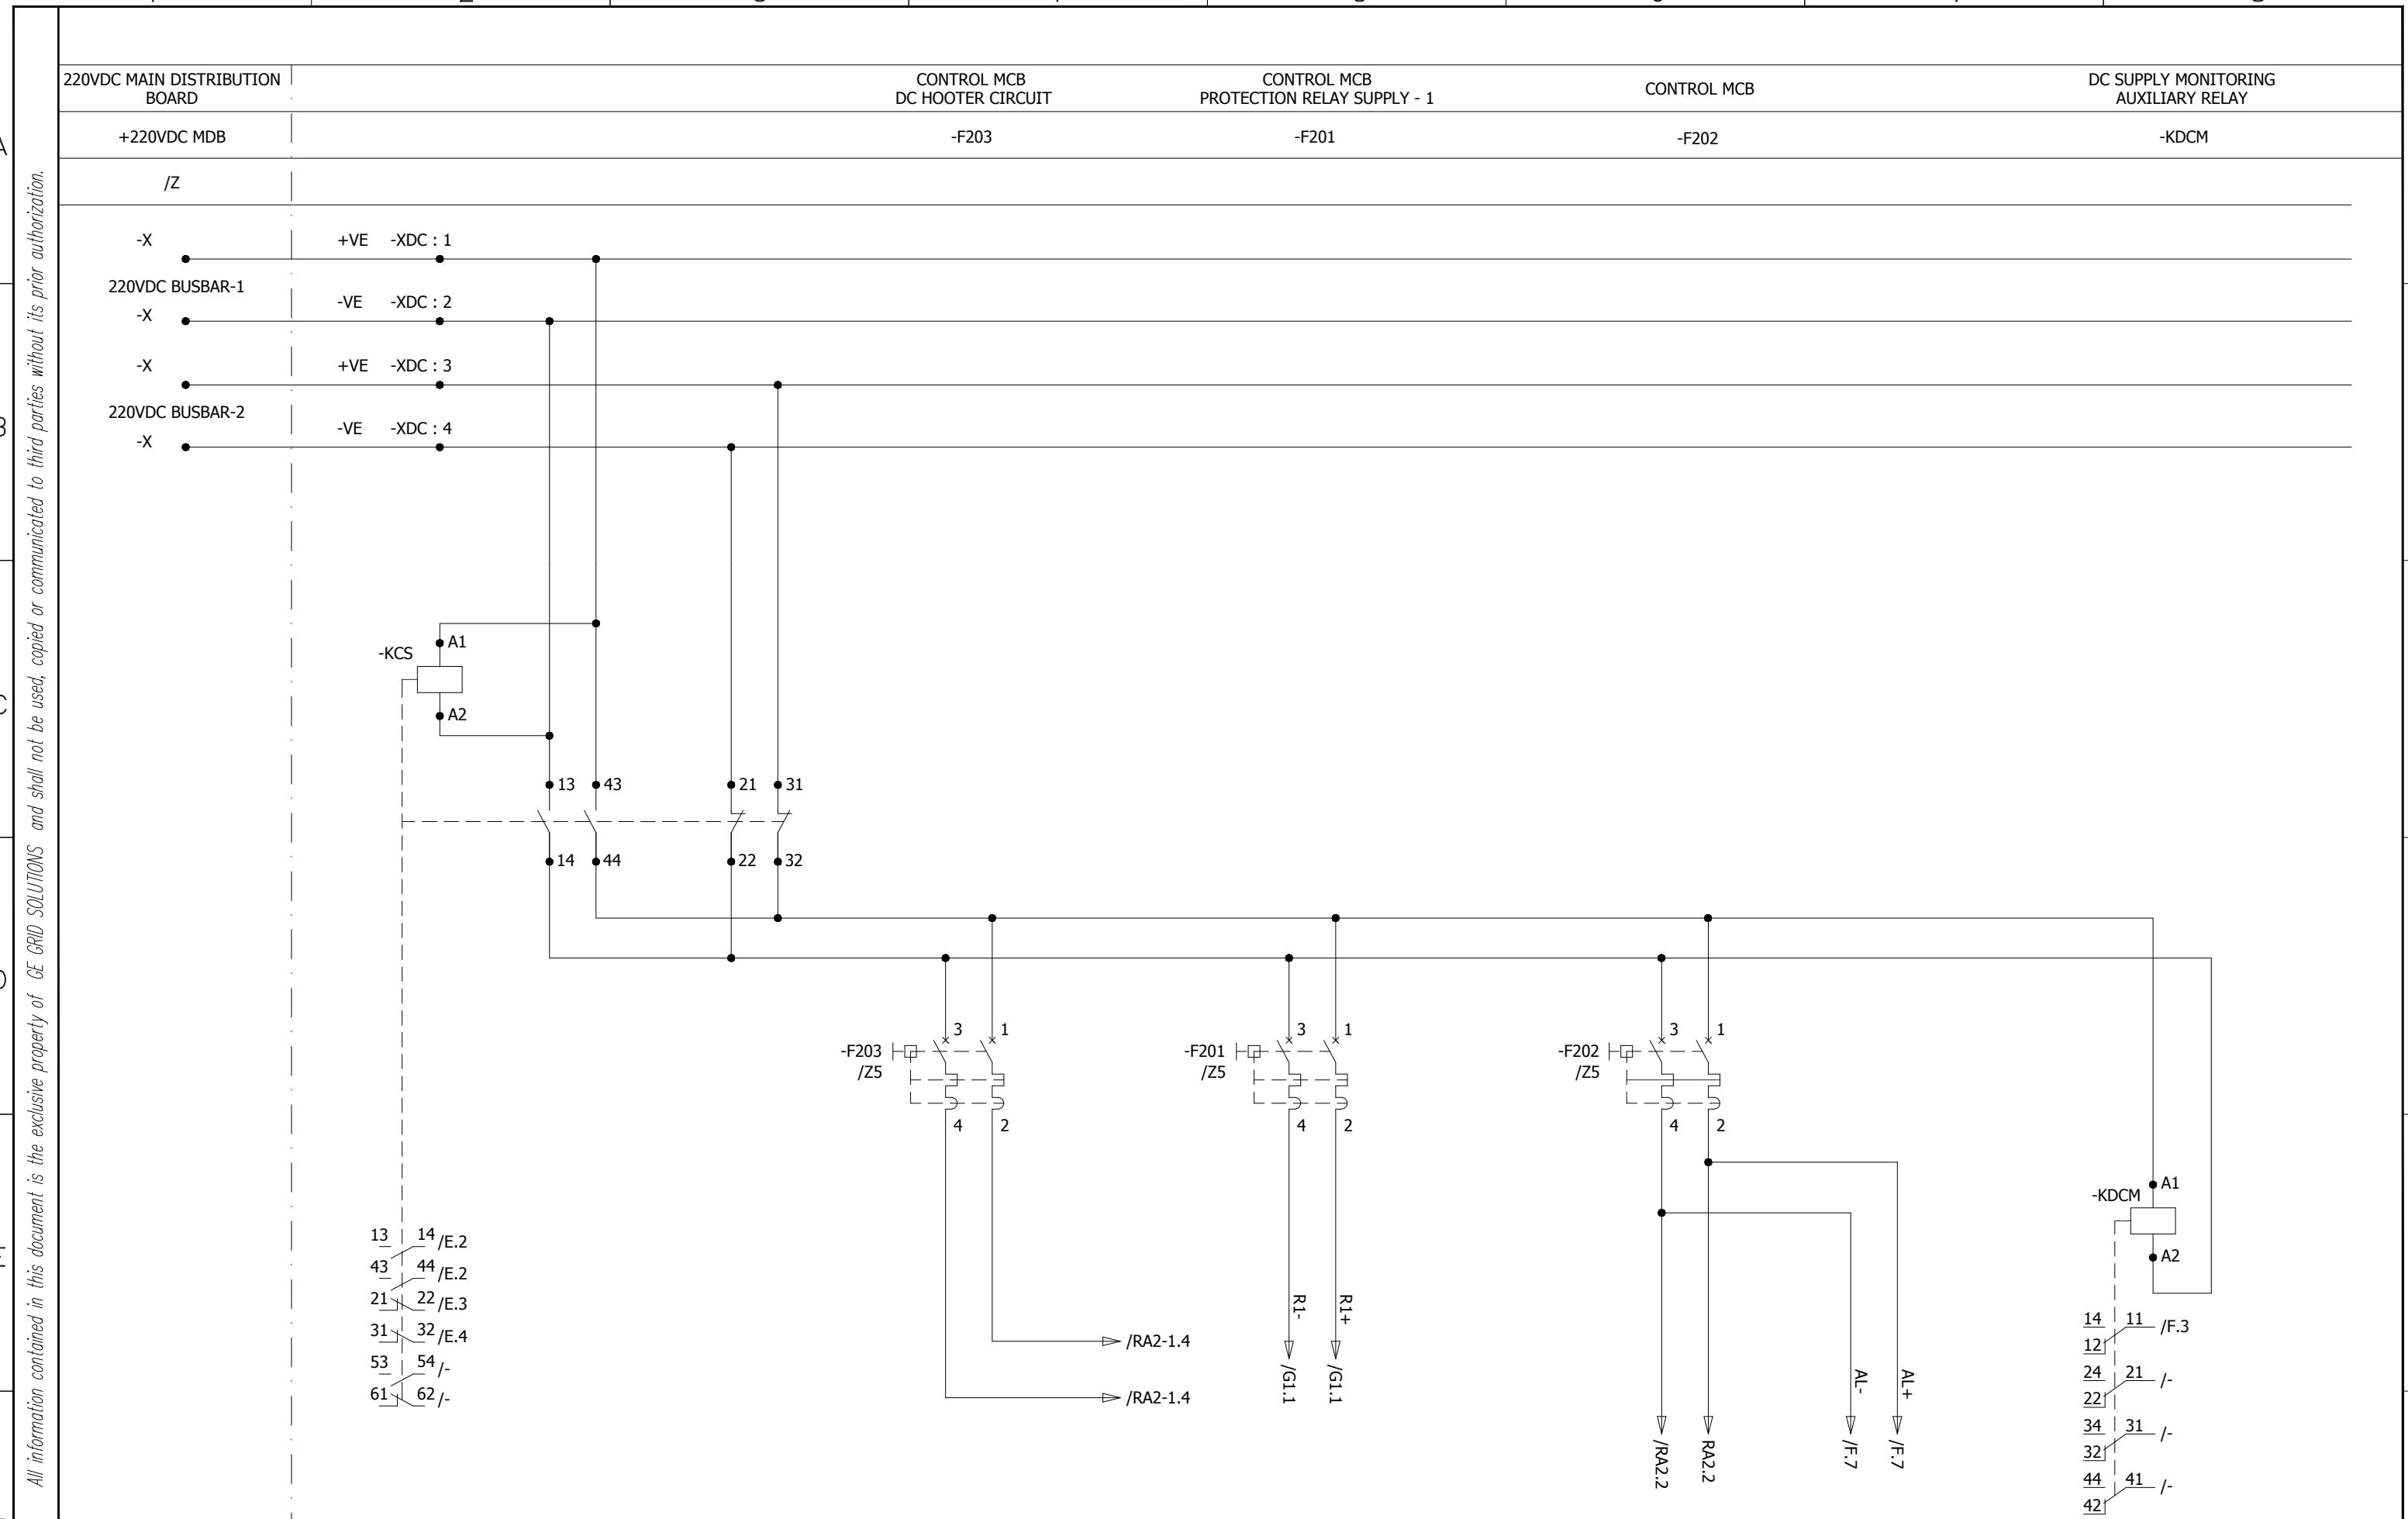

| | | | | | | | | | |
|------|-------------|------------|--------|---------------------------------------------------------------------------------------------|----------------------------------------------------------------------|------------------------------------------------------------------------------------|-------------------------------------------------------------|---------------------------------------------------------------------------|------------------------------------|
| 0 | AS BUILT | 18.08.2018 | MSC | Manufacturer EPESOL 71-B Garden Block, New Garden Town, Lahore, Pakistan | Contractor Grid Solutions A GE and Alstom joint venture | Client NATIONAL TRANSMISSION & DISPATCH COMPANY LIMITED (NTDC-WAPDA) | Project 220kV/132kV GIS SUBSTATION GHAZI ROAD, LAHORE | Title 220kV SYNCHRONIZING PANEL (=D00+C6) DC SUPPLY DISTRIBUTION | Drawing no. P60194-E-DSC-SC-001 |
| REV. | DESCRIPTION | DATE | DRAWER | | | | | | Project no. P-60194 |
| | | | | | | | | | Sheet type E |
| | | | | | | | | | Sheet no. 07 |

All information contained in this document is the exclusive property of GE GRID SOLUTIONS and shall not be used, copied or communicated to third parties without its prior authorization.

220V DC CIRCUIT FAULTY

220V DC CIRCUIT FAULTY INDICATION


220V AC CIRCUIT FAULTY

-KDC


-H200

-KAC

/D.4 ➤ ALP

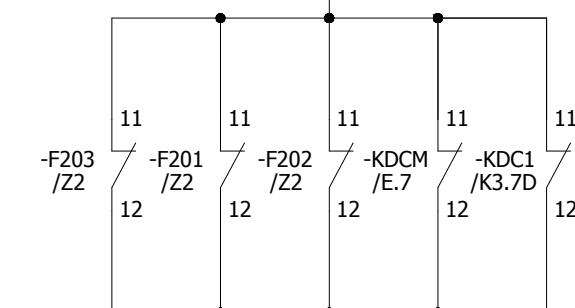

-KDC
/F.3
41
44

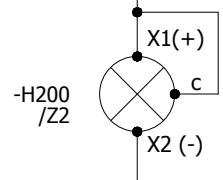

/D.4 ➤ ALN

-KDC

A1

A2

14 11 /RA1.4
12
24 21 /RA3.7
22
34 31 /RA3.8
32
44 41 /5C
42

-F203
/Z2

-F201
/Z2

-F202
/Z2

-KDCM
/E.7

-KDC1
/K3.7D

11
12

11
12


11
12

11
12

11
12

/E.7 ➤ AL+

➡ /I1.1

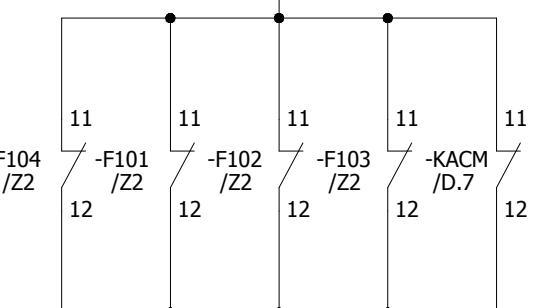

/E.7 ➤ AL-

➡ /I1.1

-KAC

A1

A2

14 11 /RA2.3
12
24 21 /RA3.6
22
34 31 /RA3.8
32
44 41 /-
42

14 11 /RA2.3
12

24 21 /RA3.6
22

34 31 /RA3.8
32

44 41 /-

42

Project
220kV/132kV GIS SUBSTATION
GHAZI ROAD, LAHORE
Title
220V SYNCHRONIZING PANEL
(=D00+C6)
AC/DC SUPPLY FAILURE CIRCUIT

Drawing no.
P60194-E-DSC-SC-001


Project no.
P-60194

Sheet type
F

Sheet no.
08

SYNC CHECK

RELAY SUPPLY

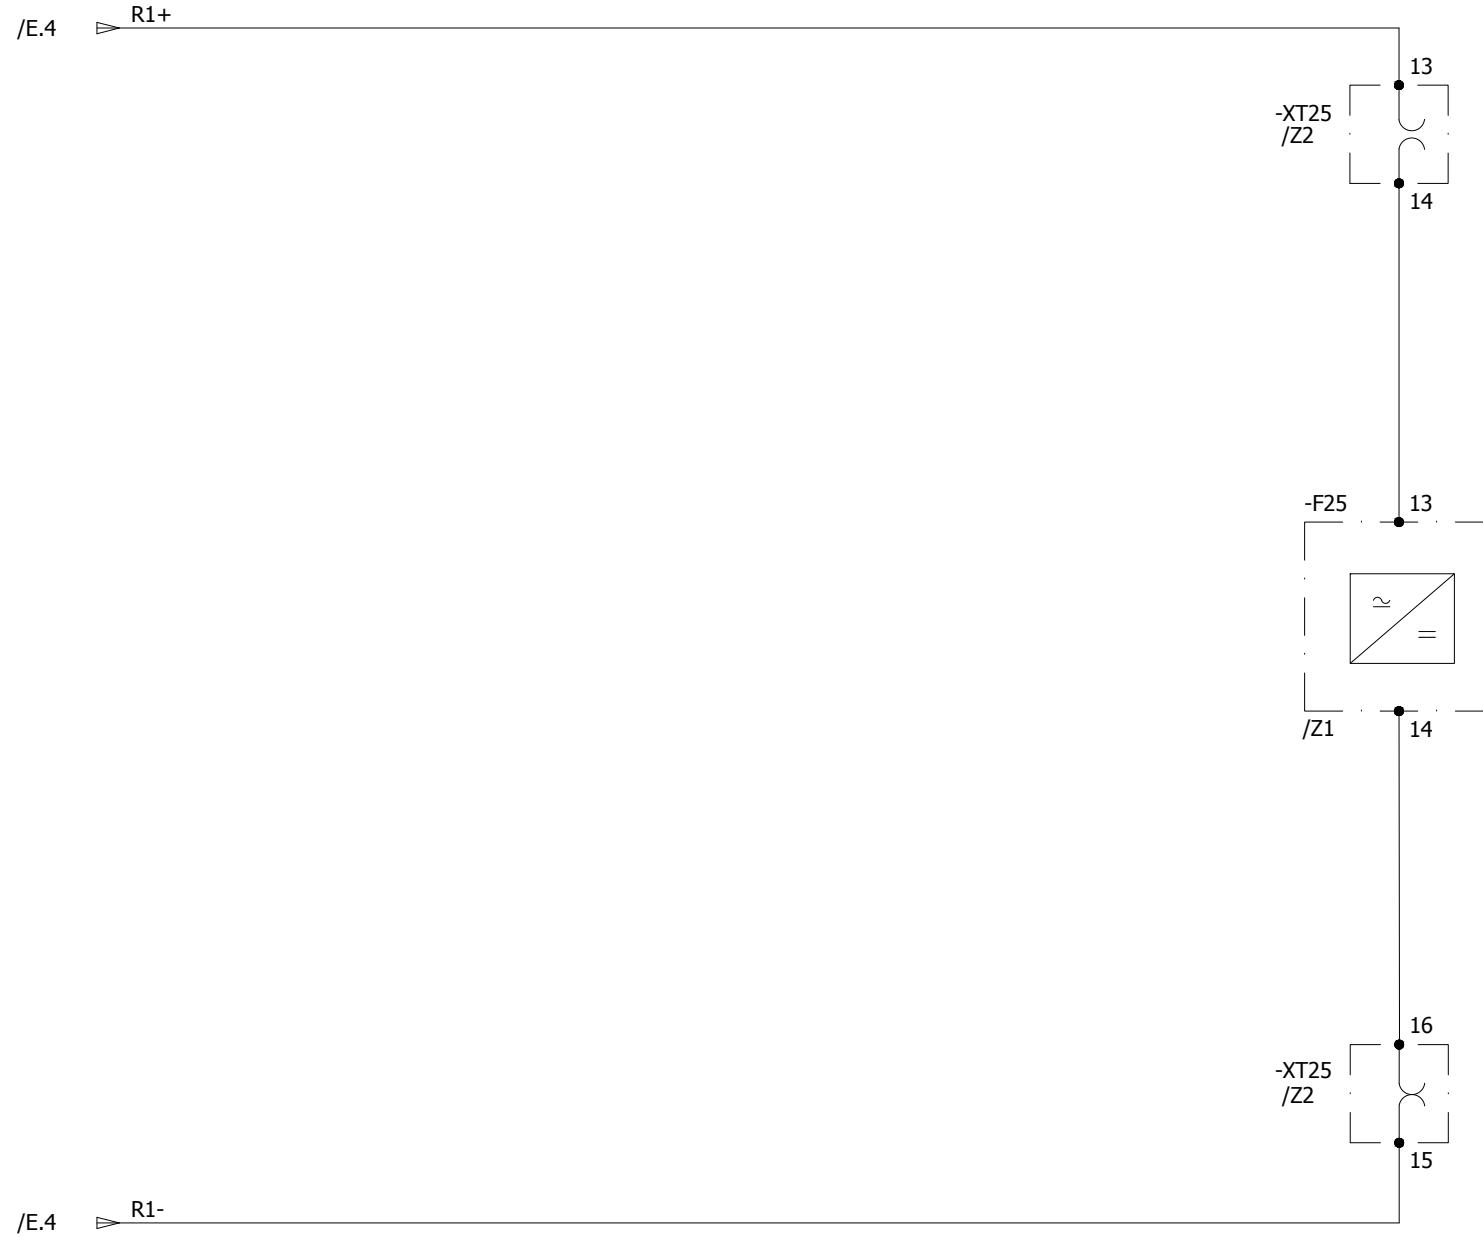

All information contained in this document is the exclusive property of GE GRID SOLUTIONS and shall not be used, copied or communicated to third parties without its prior authorization.

A

A

B

B

C

C

D

D

E

E

F

F

1

2

3

4

5


6

7

8

| | | | | | | | | | | |
|------|-------------|------------|--------|----------------------------------------------------------------------------------------------------------------------------------------------------------------|---------------------------------------------------------------------------------------------------------------------------------------|---------------------------------------------------------------------------------------|---------------------------------------------------------------|-----------------------------------------------|---------------------------------------------------------------|---------------------|
| 0 | AS BUILT | 18.08.2018 | MSC | Manufacturer | Contractor | Client | Project | Title | Drawing no. | |
| | | | |  EPESOL 7-8 Garden Block, New Garden Town, Lahore, Pakistan |  Grid Solutions A GE and Alstom joint venture |  | NATIONAL TRANSMISSION & DISPATCH COMPANY LIMITED (NTDC-WAPDA) | 220kV/132kV GIS SUBSTATION GHAZI ROAD, LAHORE | 220kV SYNCHRONIZING PANEL (=D00+C6) RELAY CONTROL & SUPPLY | P60194-E-DSC-SC-001 |
| REV. | DESCRIPTION | DATE | DRAWER | | | | | | Project no. P-60194 Sheet type G1 Sheet no. 09 | |

1 2 3 4 5 6 7 8

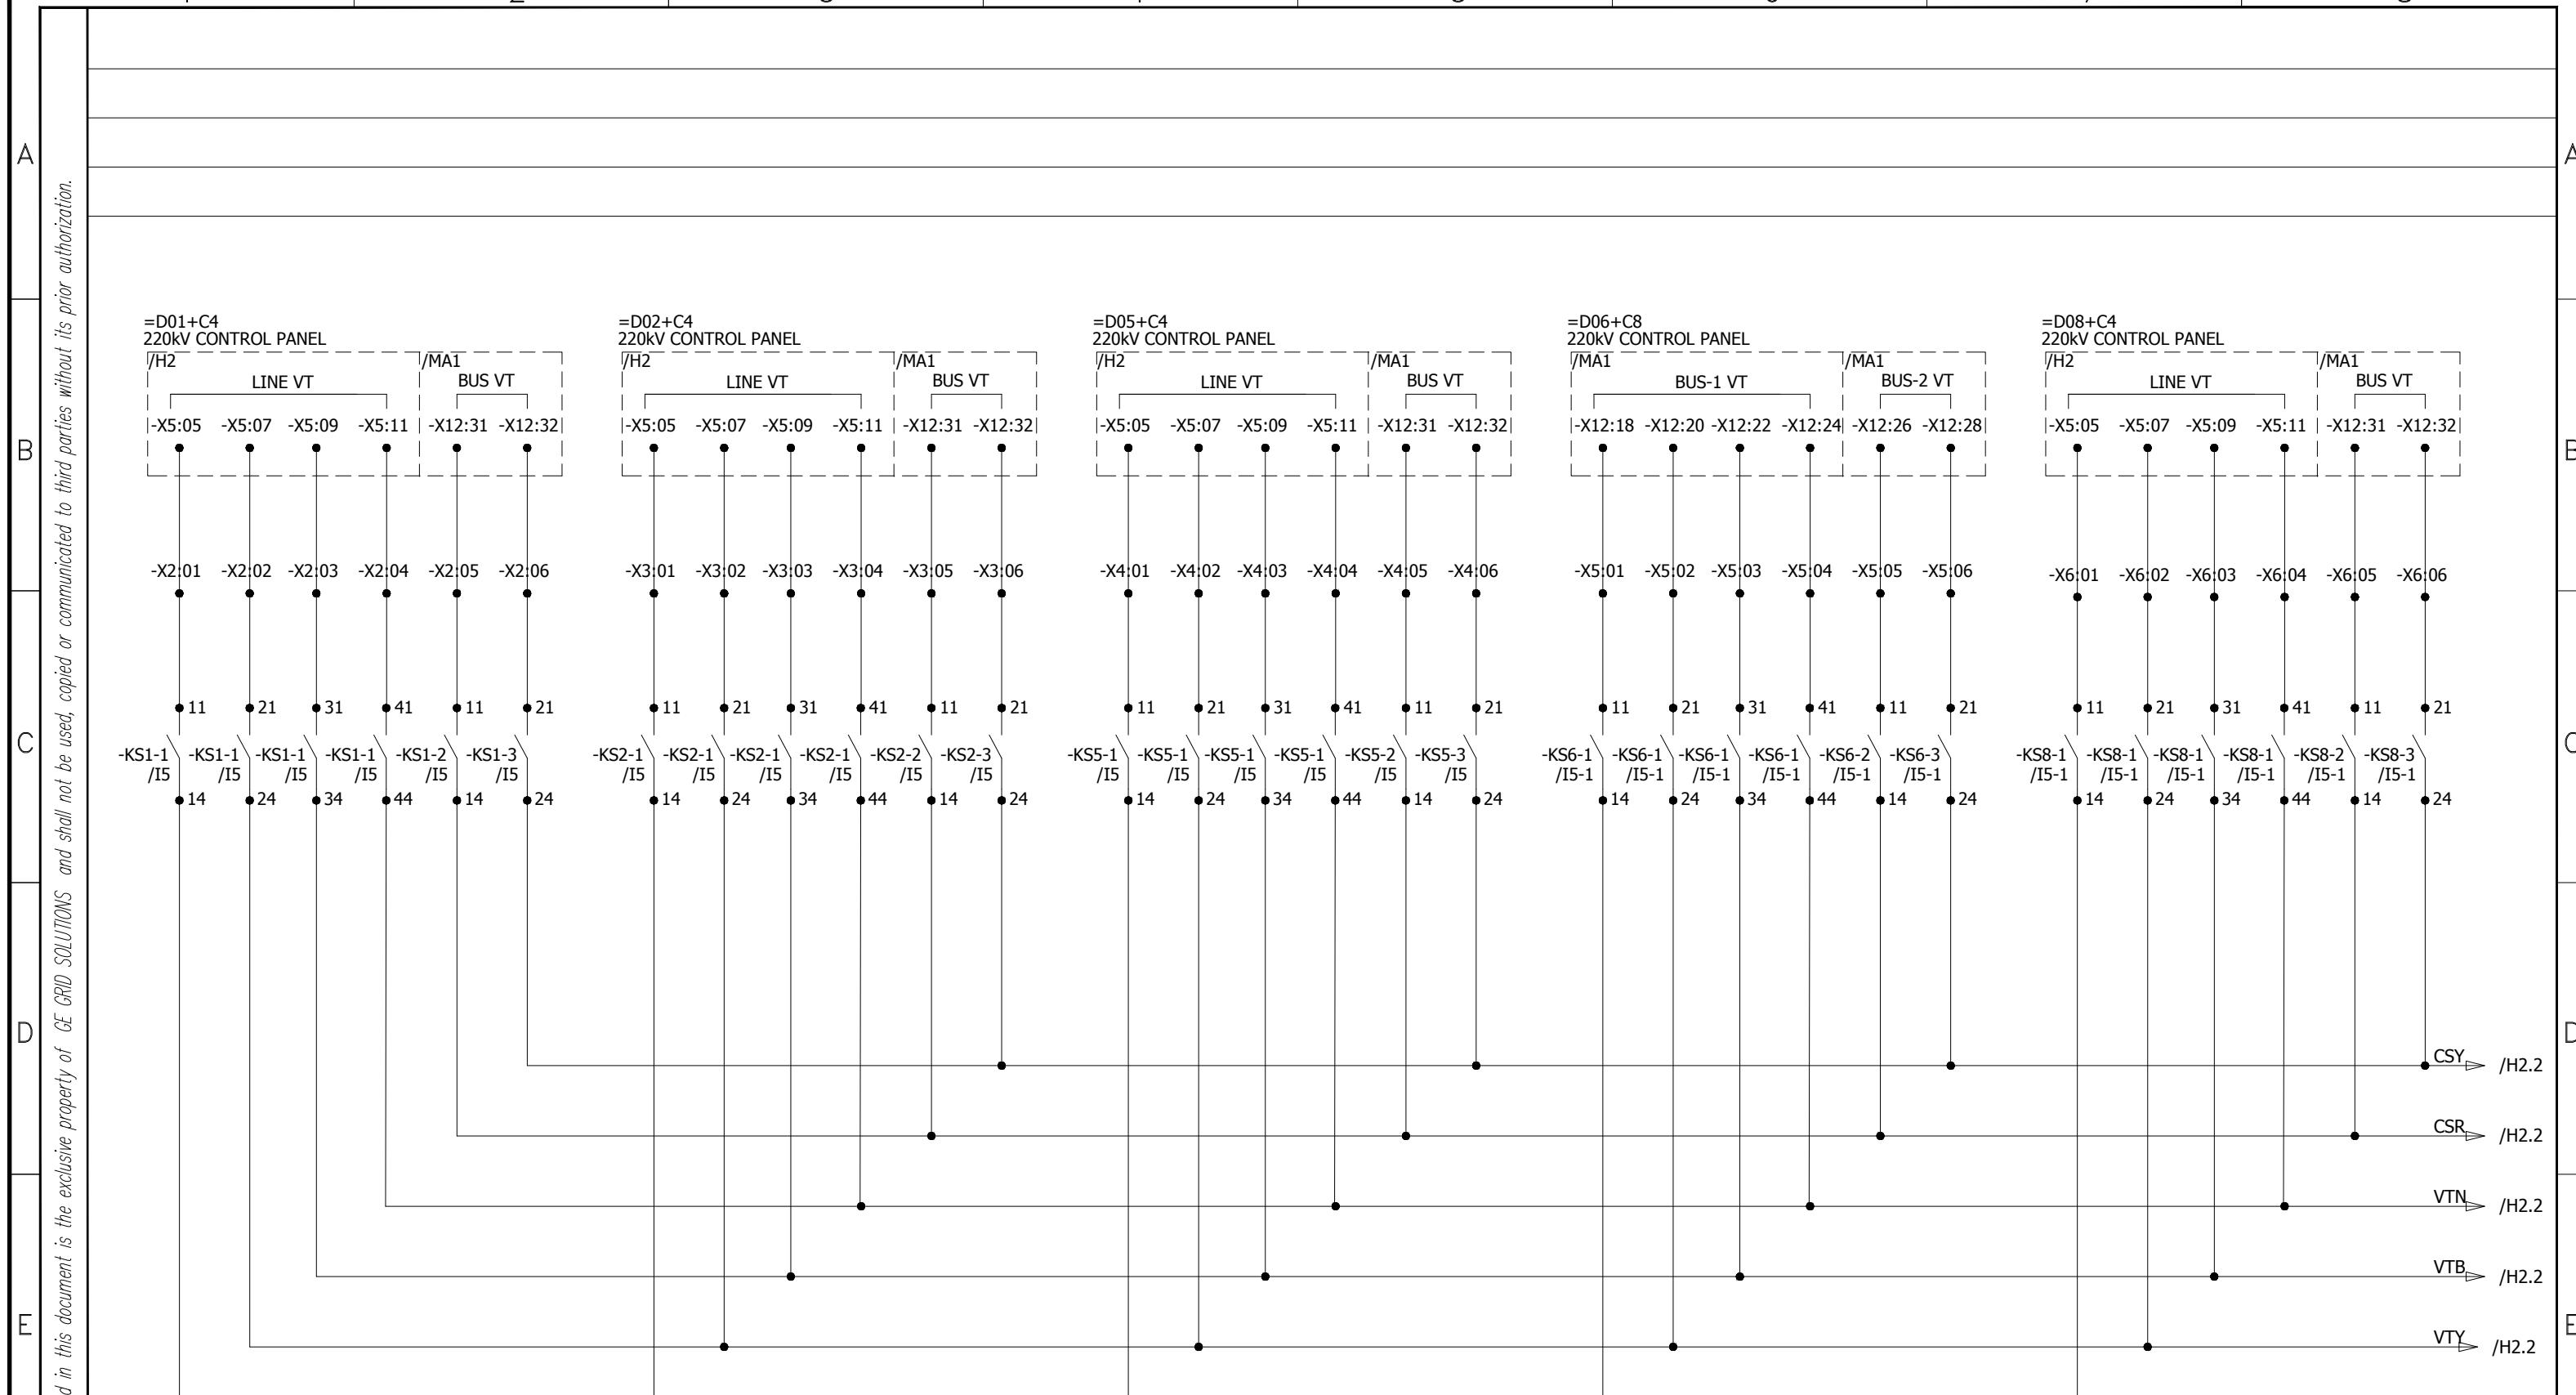

| | | | | | | | | | | | |
|------|-------------|------------|--------|--------------------------------------------------------------------------------------------------------------------------------------------------------------------------|-----------------------------------------------------------------------------------------------------------------------------------------------------|---------------------------------------------------------------------------------------------------------------------------------------------------------------------|-------------------------------------------------------------|--------------------------------------------------------------------|------------------------------------|------------------|-----------------|
| 0 | AS BUILT | 18.08.2018 | MSC | Manufacturer  EPESOL 71-B Garden Block, New Garden Town, Lahore, Pakistan | Contractor  Grid Solutions A GE and Alstom joint venture | Client  NATIONAL TRANSMISSION & DISPATCH COMPANY LIMITED (NTDC-WAPDA) | Project 220kV/132kV GIS SUBSTATION GHAZI ROAD, LAHORE | Title 220kV SYNCHRONIZING PANEL (=D00+C6) SYNC VT CIRCUIT | Drawing no. P60194-E-DSC-SC-001 | | |
| REV. | DESCRIPTION | DATE | DRAWER | | | | | | Project no. P-60194 | Sheet type H1 | Sheet no. 10 |
| 1 | 2 | 3 | 4 | 5 | 6 | 7 | 8 | | | | |

TEST BLOCK


SYNC CHECK
RELAY

-XT25

-F25

/Z2


/Z1

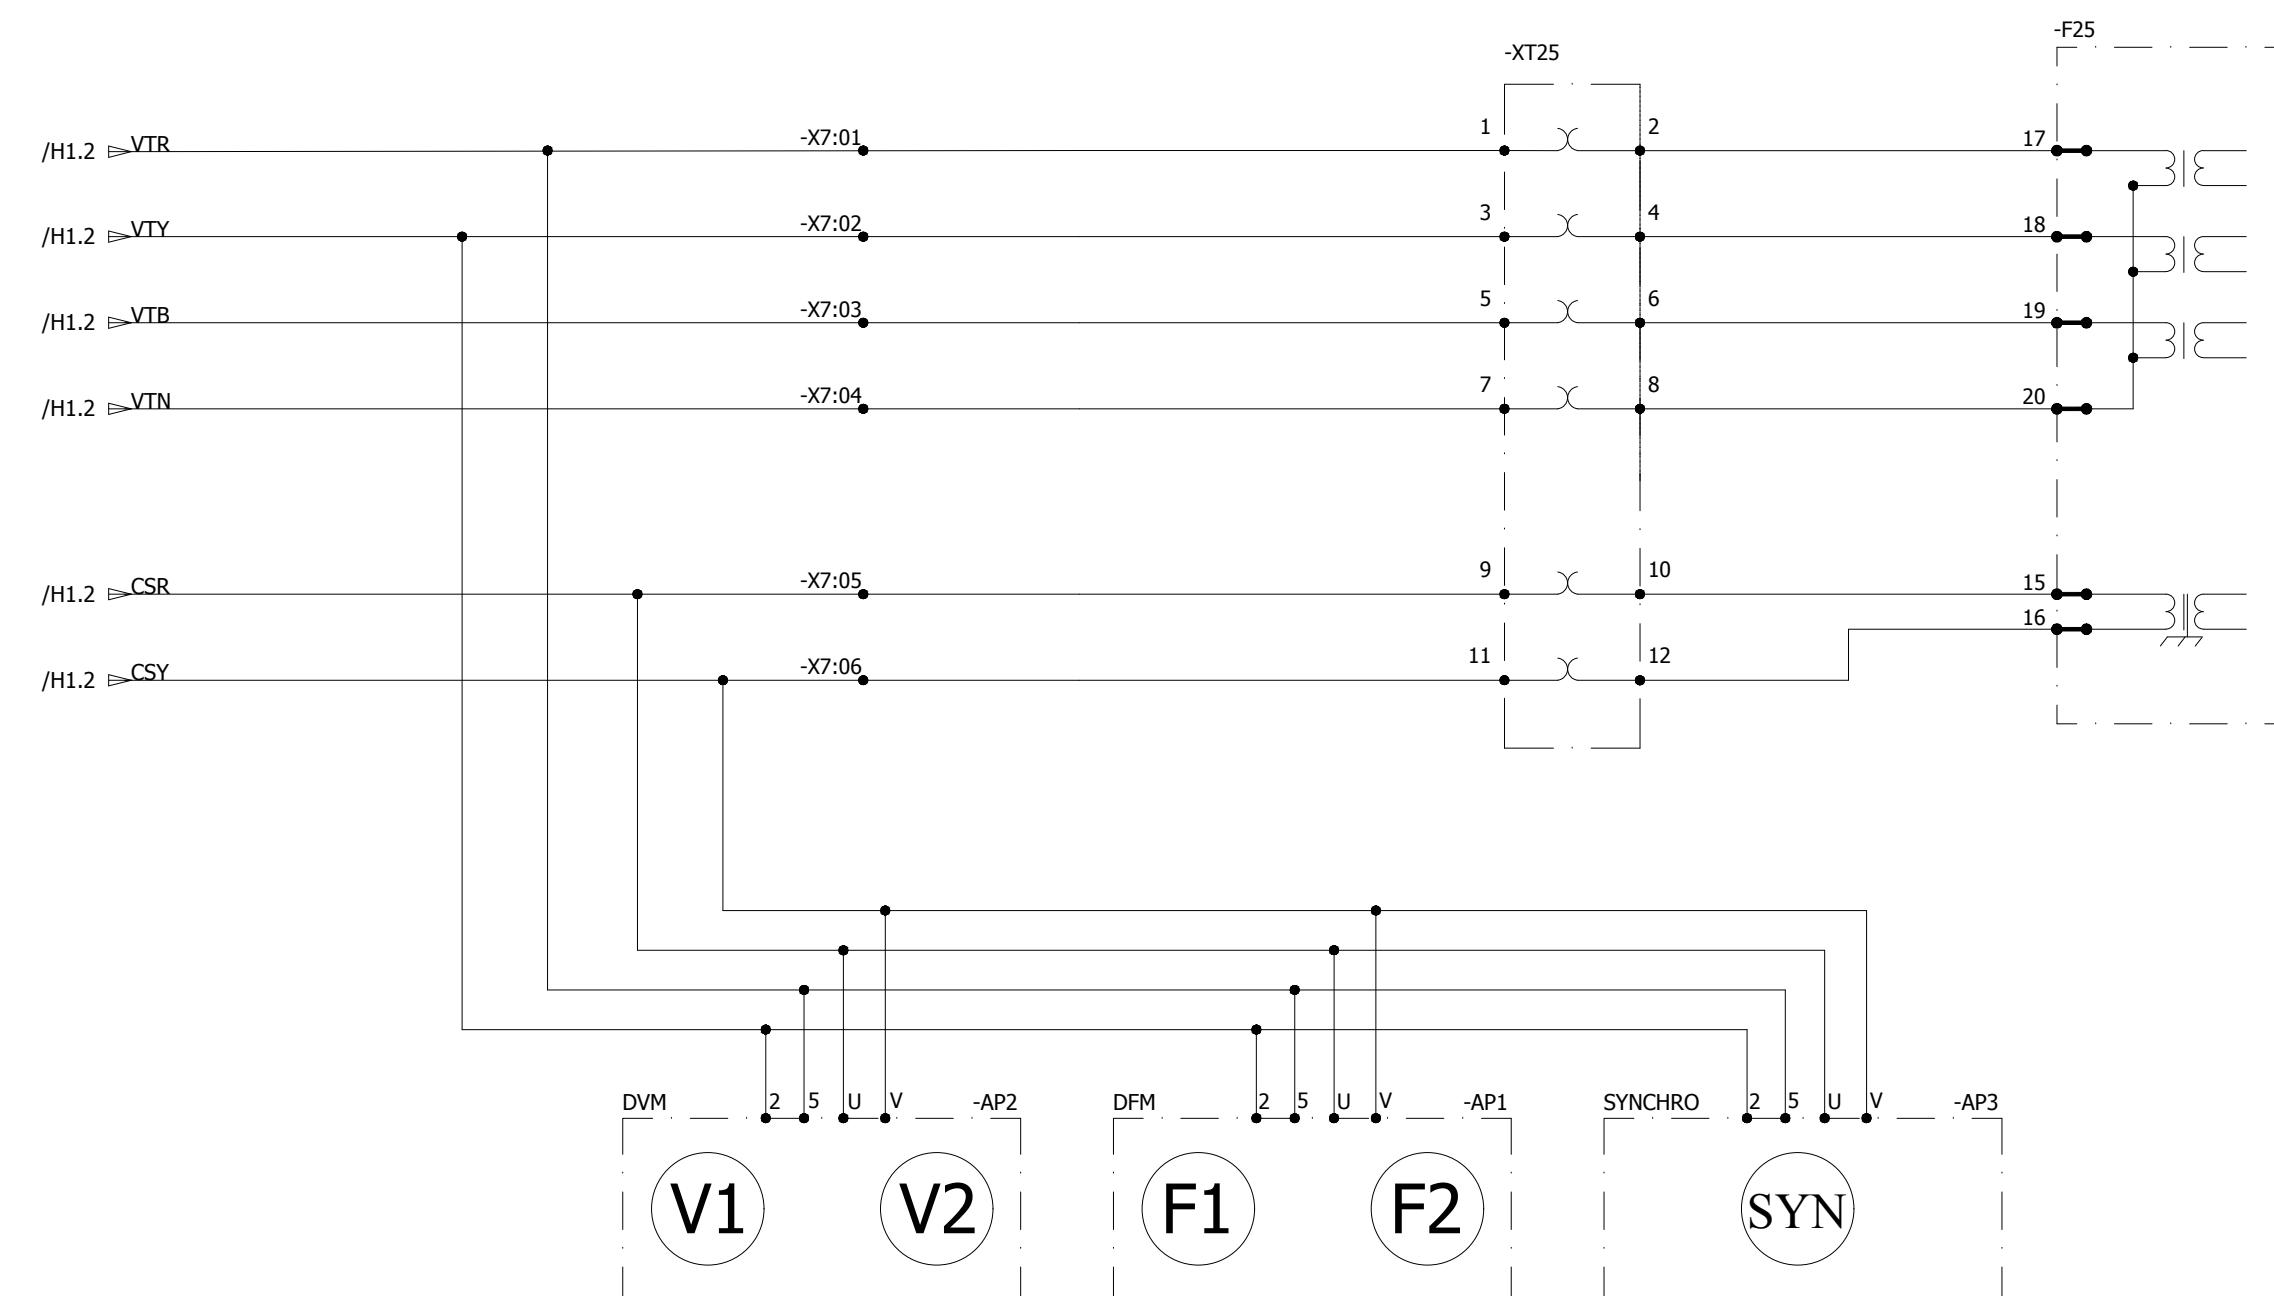

| | | | | | | | | | |
|------|-------------|------------|--------|--------------------------------------------------------------------------------------------|----------------------------------------------------------------------------|-------------------------------------------------------------------------------|-------------------------------------------------------------|--------------------------------------------------------------------|------------------------------------|
| 0 | AS BUILT | 18.08.2018 | MSC | Manufacturer EPESOL 7-B Garden Block, New Garden Town, Lahore, Pakistan | Contractor GE Grid Solutions A GE and Alstom joint venture | Client NATIONAL TRANSMISSION & DISPATCH COMPANY LIMITED (NTDC-WAPDA) | Project 220kV/132kV GIS SUBSTATION GHAZI ROAD, LAHORE | Title 220kV SYNCHRONIZING PANEL (=D00+C6) SYNC VT CIRCUIT | Drawing no. P60194-E-DSC-SC-001 |
| REV. | DESCRIPTION | DATE | DRAWER | | | | | | Project no. P-60194 |
| | | | | | | | | | Sheet type H2 |
| | | | | | | | | | Sheet no. 11 |

TIMER INITIALIZATION ON ANY CB SELECTION


All information contained in this document is the exclusive property of GE GRID SOLUTIONS and shall not be used, copied or communicated to third parties without its prior authorization.

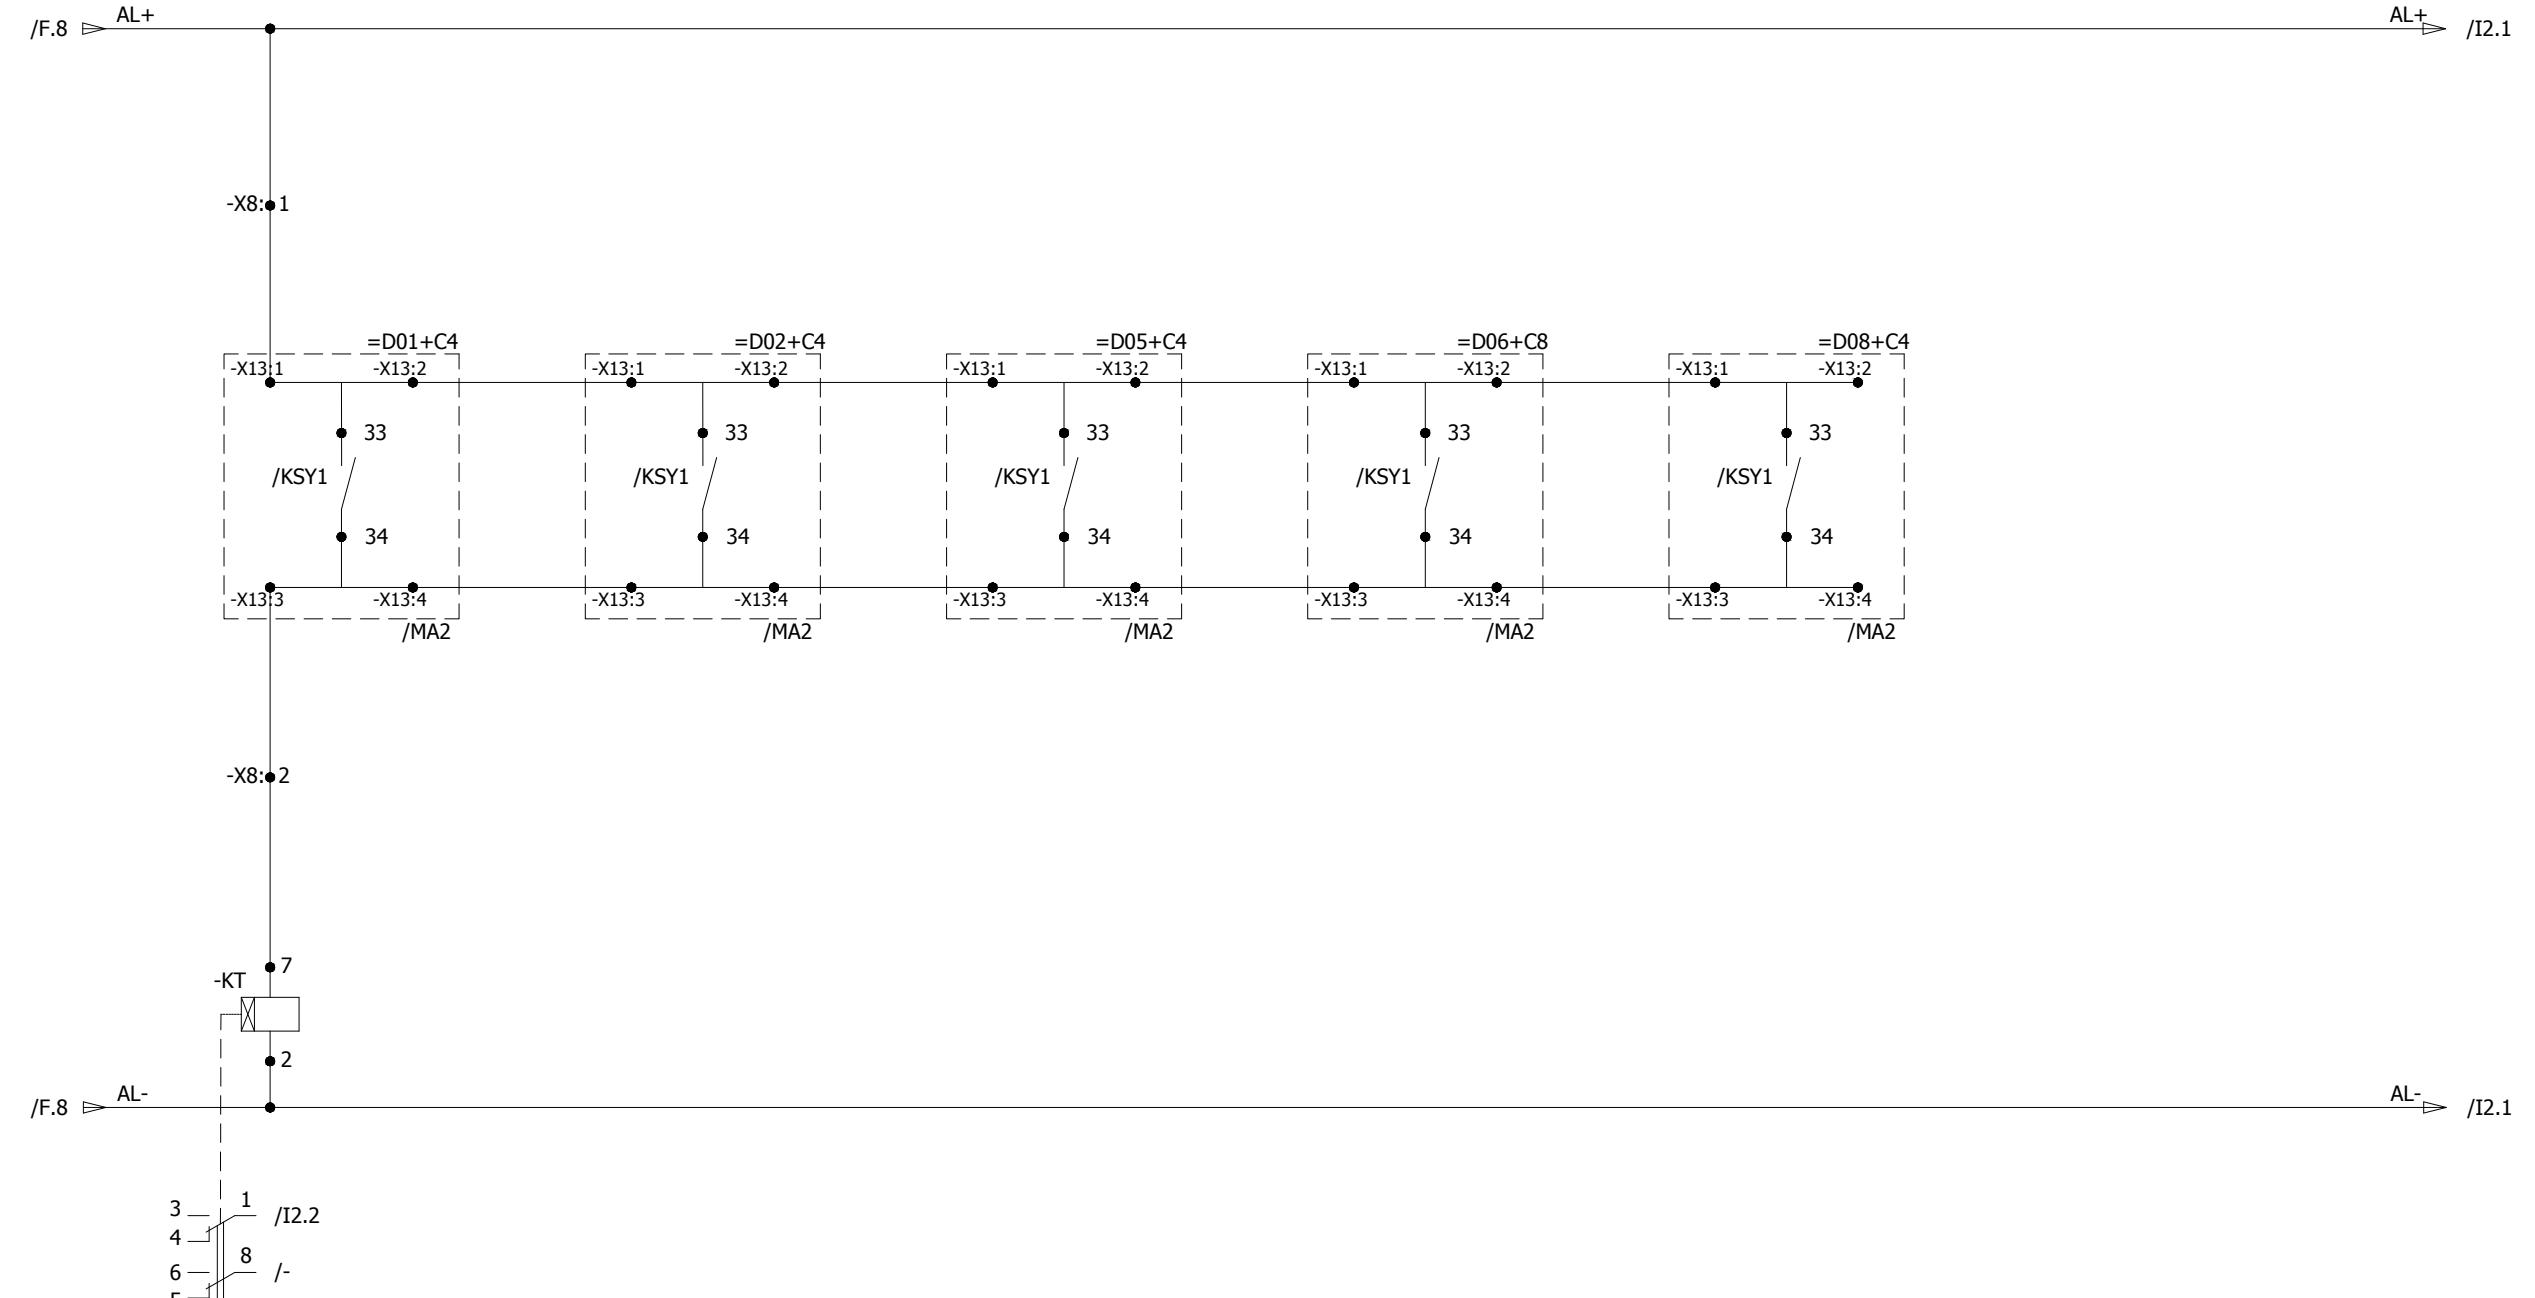

| | | | | | | | | | |
|------|-------------|------------|--------|---------------------------------------------------------------------------------------------|----------------------------------------------------------------------|-------------------------------------------------------------------------------|------------------------------------------------------------|------------------------------------------------------------------|------------------------------------|
| 0 | AS BUILT | 18.08.2018 | MSC | Manufacturer EPESOL 77-B Garden Block, New Garden Town, Lahore, Pakistan | Contractor Grid Solutions A GE and Alstom joint venture | Client NATIONAL TRANSMISSION & DISPATCH COMPANY LIMITED (NTDC-WAPDA) | Project 220kV/132kV GIS SUBSTATION GAZI ROAD, LAHORE | Title 220kV SYNCHRONIZING PANEL (=D00+C6) TIMER CIRCUIT | Drawing no. P60194-E-DSC-SC-001 |
| | | | | | | | | | Project no. P-60194 |
| REV. | DESCRIPTION | DATE | DRAWER | | | | | | Sheet type I1 |

TIMER CONTACT MULTIPLICATION


All information contained in this document is the exclusive property of GE GRID SOLUTIONS and shall not be used, copied or communicated to third parties without its prior authorization.

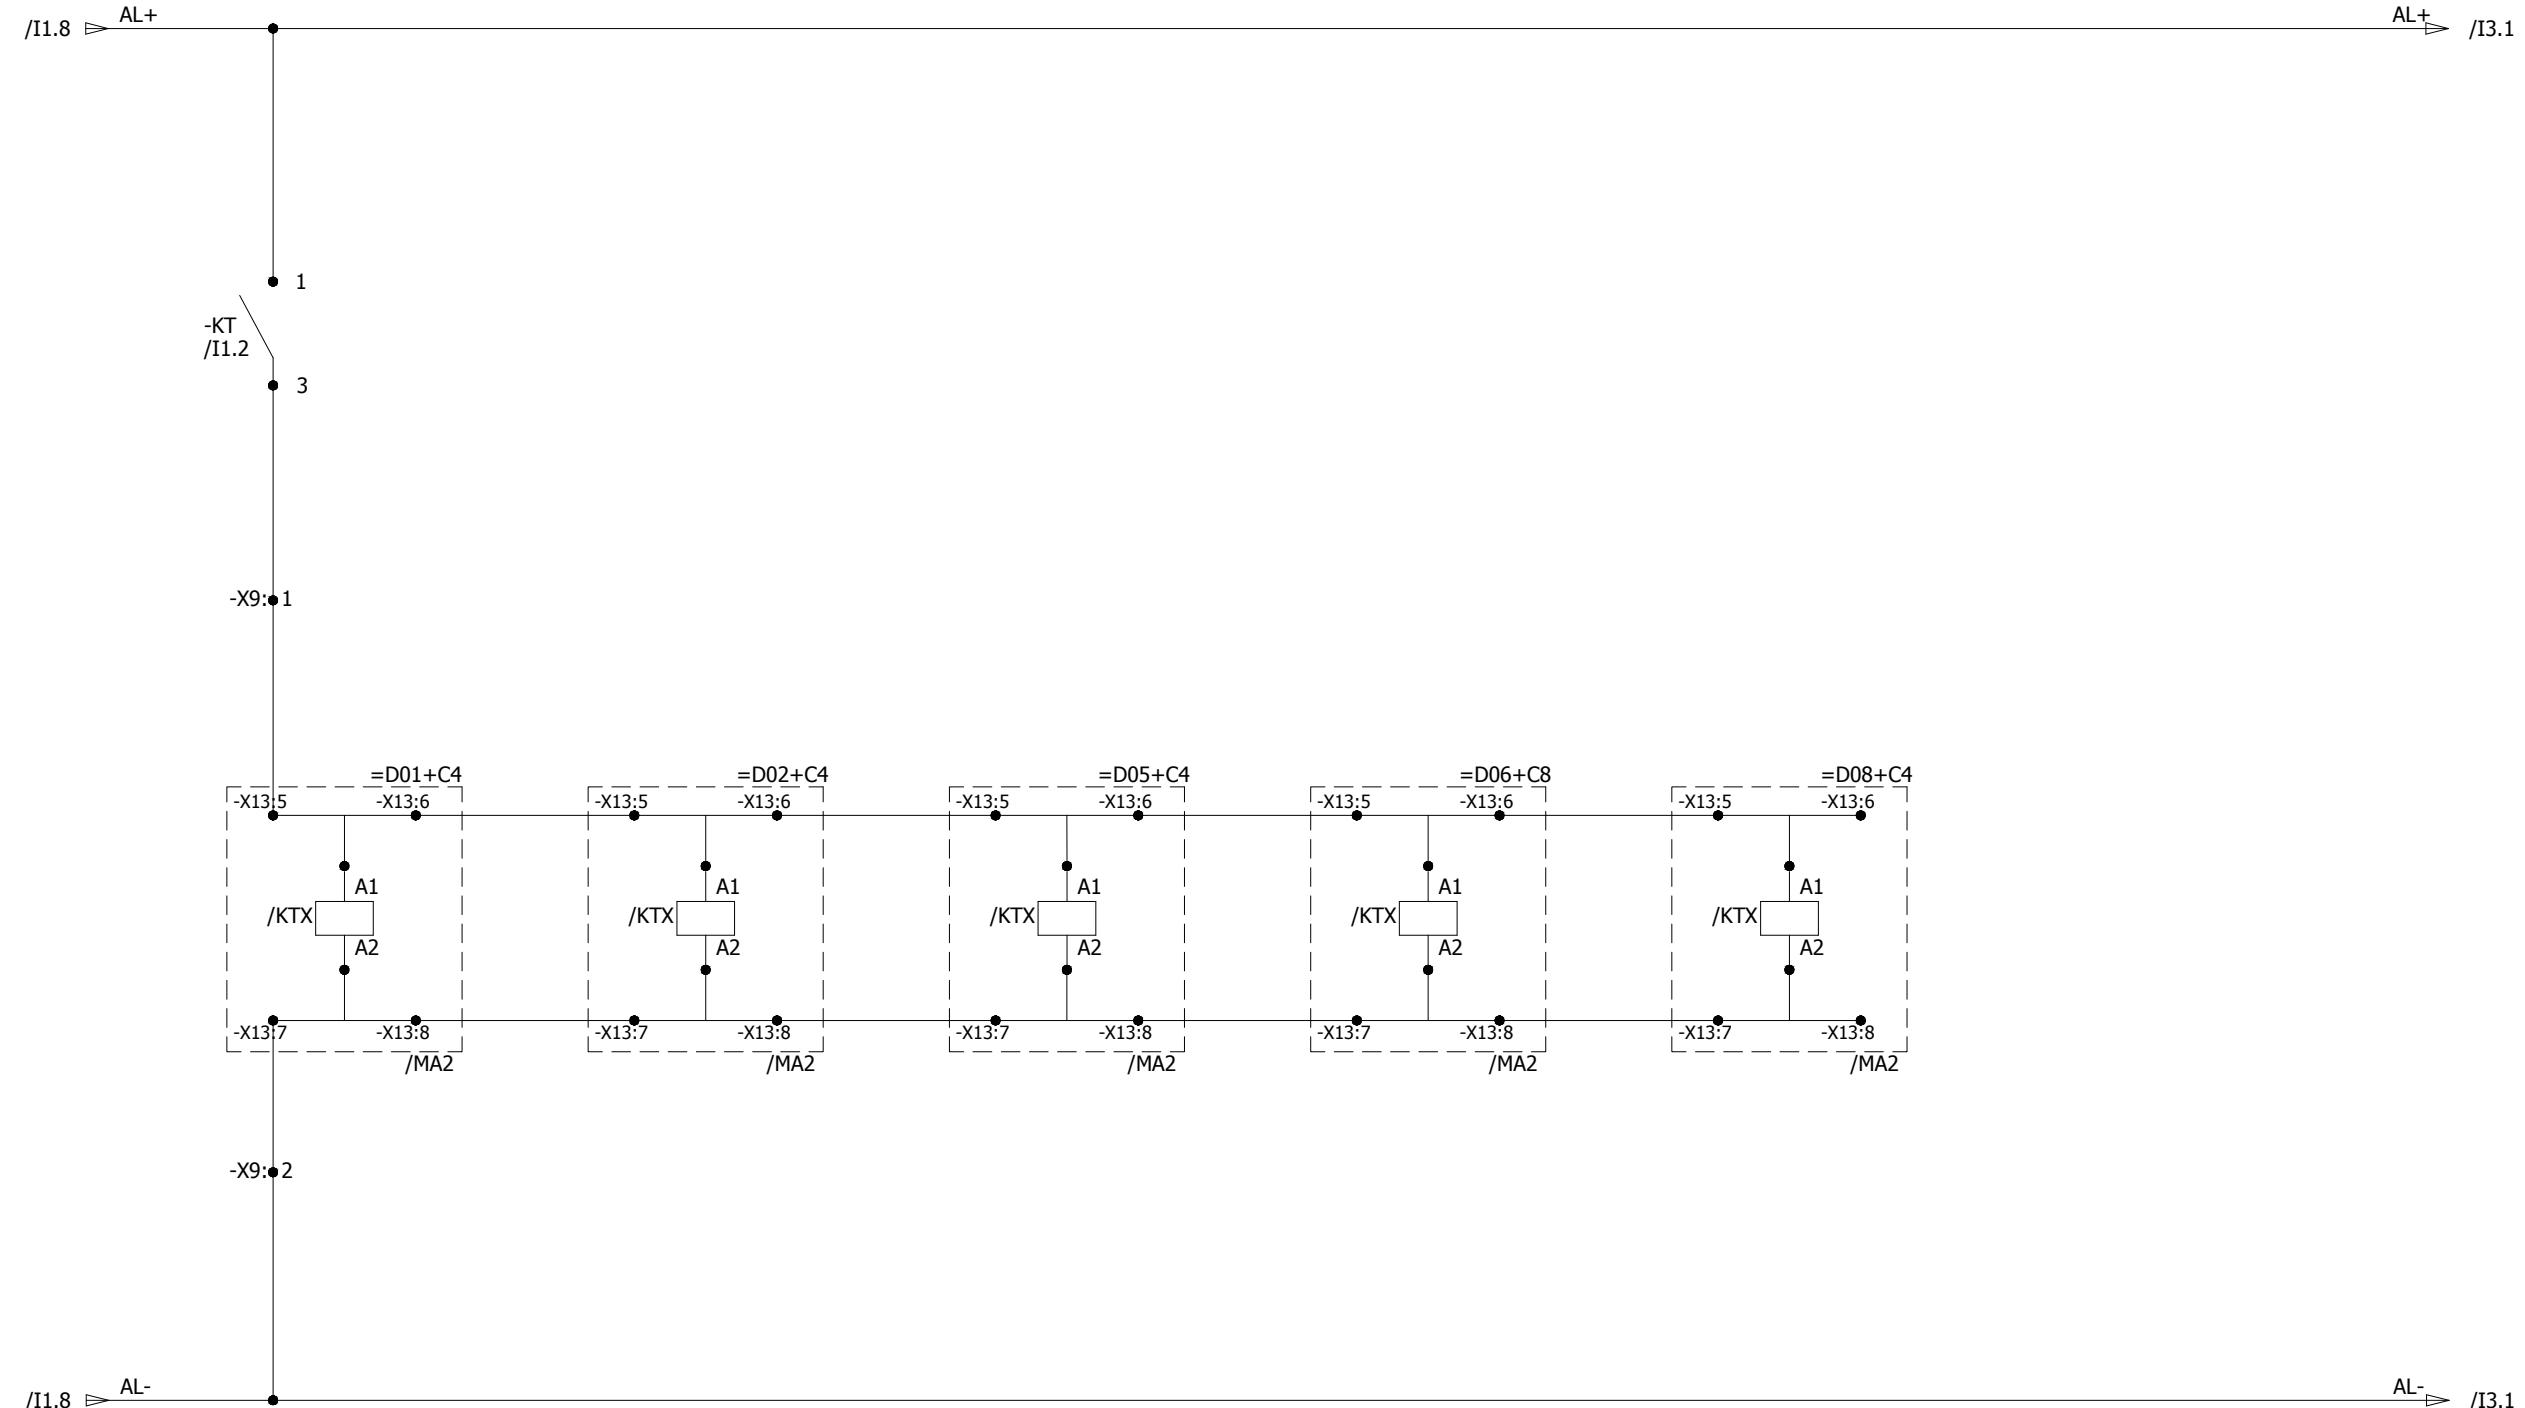

| | | | | | | | | | |
|------|-------------|------------|--------|---------------------------------------------------------------------------------------------|----------------------------------------------------------------------|-------------------------------------------------------------------------------|------------------------------------------------------------|------------------------------------------------------------------|------------------------------------|
| 0 | AS BUILT | 18.08.2018 | MSC | Manufacturer EPESOL 71-B Garden Block, New Garden Town, Lahore, Pakistan | Contractor Grid Solutions A GE and Alstom joint venture | Client NATIONAL TRANSMISSION & DISPATCH COMPANY LIMITED (NTDC-WAPDA) | Project 220kV/132kV GIS SUBSTATION GAZI ROAD, LAHORE | Title 220kV SYNCHRONIZING PANEL (=D00+C6) TIMER CIRCUIT | Drawing no. P60194-E-DSC-SC-001 |
| | | | | | | | | | Project no. P-60194 |
| | DESCRIPTION | DATE | DRAWER | | | | | | Sheet type I2 |
| REV. | | | | | | | | | Sheet no. 13 |

SYNCHRO CHECK ENABLE

LOGIC INPUT

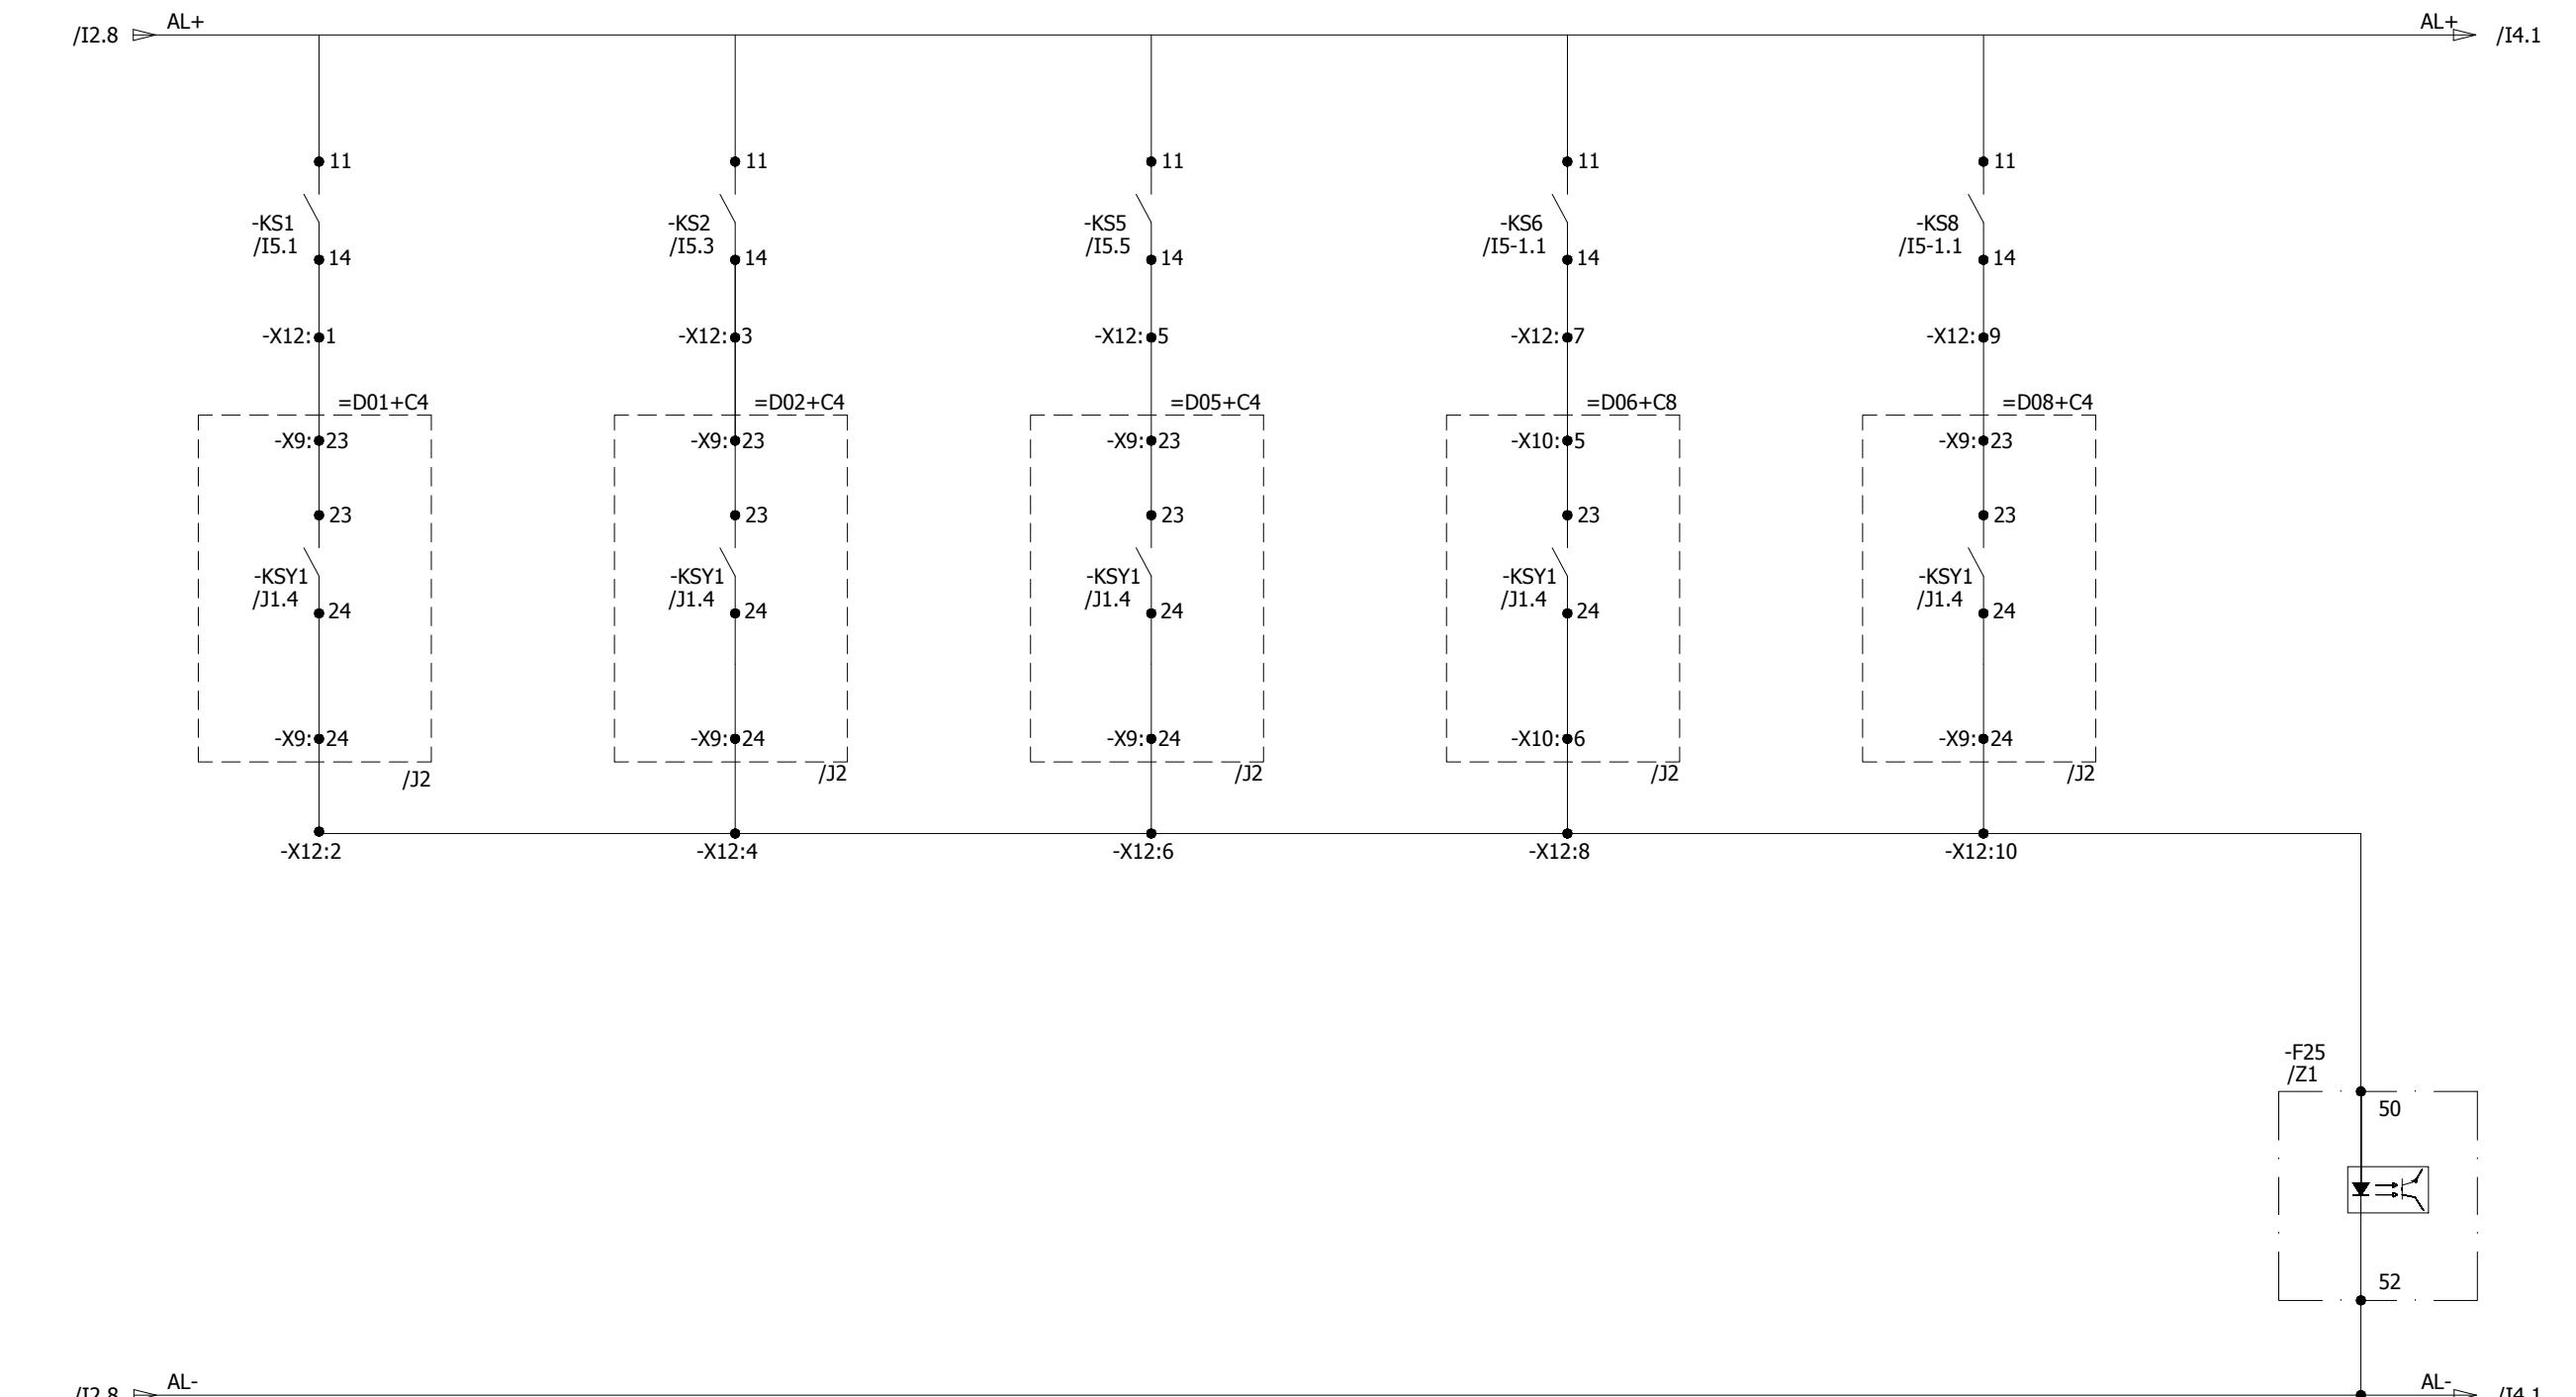

All information contained in this document is the exclusive property of GRID SOLUTIONS and shall not be used, copied or communicated to third parties without its prior authorization.

A

B

C

D

E

F

A

B

C

D


E

F

| | | | | | | | | | |
|------|-------------|------------|--------|-----------------------------------------------------------------------------------------------------------------------------------------------------------------------------|--------------------------------------------------------------------------------------------------------------------------------------------------------|------------------------------------------------------------------------------------------------------------------------------------------------------------------------|-------------------------------------------------------------|------------------------------------------------------------------------|------------------------------------|
| 0 | AS BUILT | 18.08.2018 | MSC | Manufacturer  EPESOL 27-B Garden Block, New Garden Town, Lahore, Pakistan | Contractor  Grid Solutions A GE and Alstom joint venture | Client  NATIONAL TRANSMISSION & DISPATCH COMPANY LIMITED (NTDC-WAPDA) | Project 220kV/132kV GIS SUBSTATION GHAZI ROAD, LAHORE | Title 220kV SYNCHRONIZING PANEL (=D00+C6) SYNC ENABLE CIRCUIT | Drawing no. P60194-E-DSC-SC-001 |
| REV. | DESCRIPTION | DATE | DRAWER | | | | | | Project no. P-60194 |
| | | | | | | | | | Sheet type I3 |
| | | | | | | | | | Sheet no. 14 |

DE SELECTION OF CIRCUIT AFTER SELECTION OF ANY CB

All information contained in this document is the exclusive property of GRID SOLUTIONS and shall not be used, copied or communicated to third parties without its prior authorization.

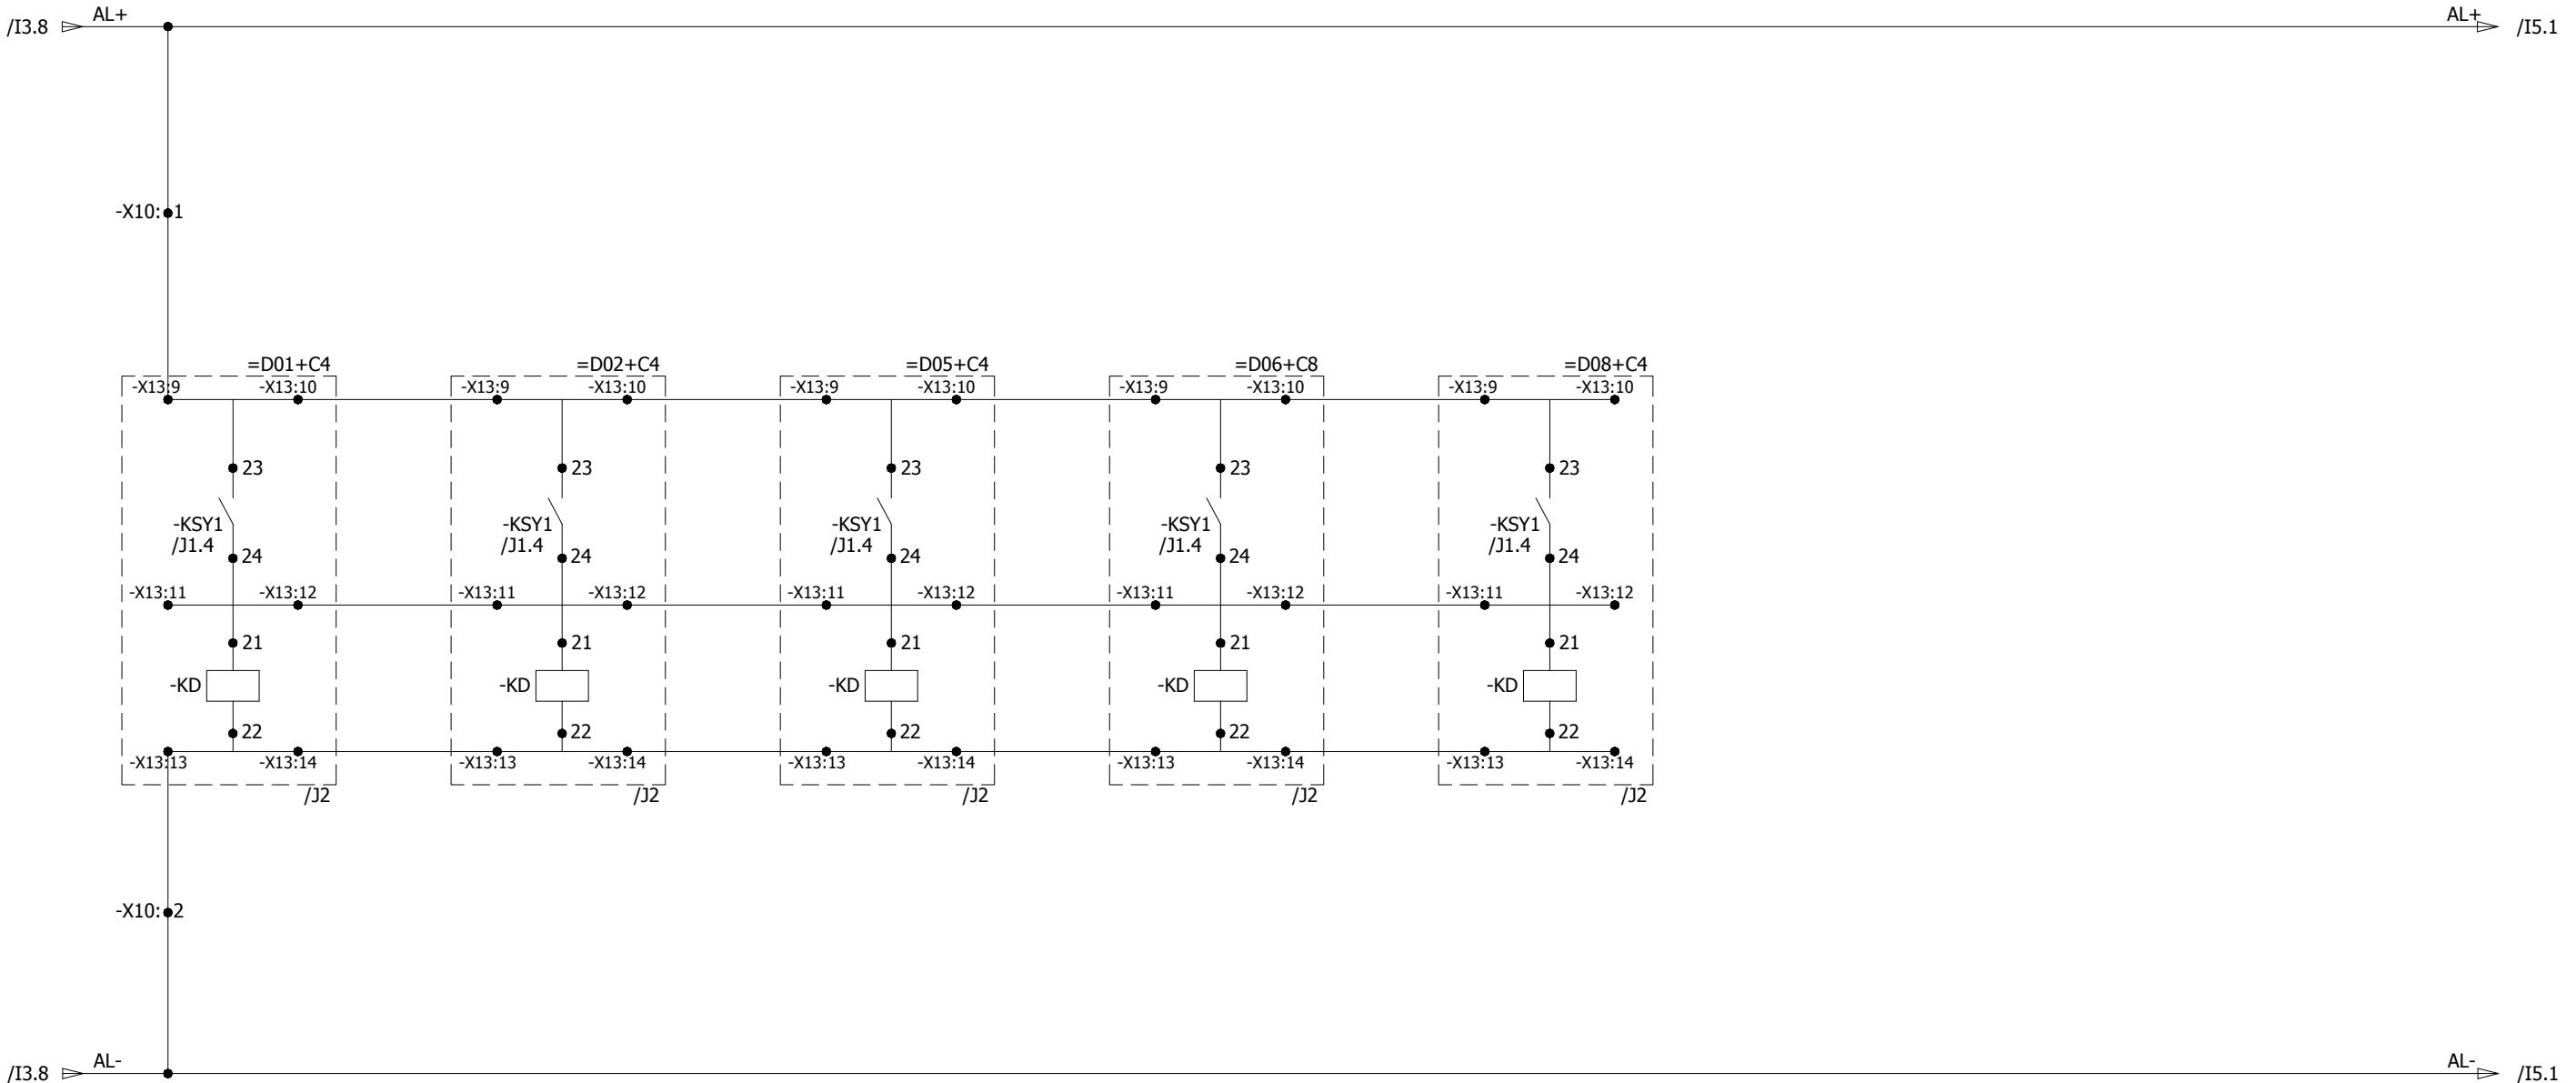

| | | | | | | | | | |
|------|-------------|------------|--------|-----------------------------------------------------------------------------------------------------------------------------------------------------------------------------|--------------------------------------------------------------------------------------------------------------------------------------------------------|------------------------------------------------------------------------------------------------------------------------------------------------------------------------|-------------------------------------------------------------|----------------------------------------------------------------------------------|------------------------------------|
| 0 | AS BUILT | 18.08.2018 | MSC | Manufacturer  EPESOL 27-B Garden Block, New Garden Town, Lahore, Pakistan | Contractor  Grid Solutions A GE and Alstom joint venture | Client  NATIONAL TRANSMISSION & DISPATCH COMPANY LIMITED (NTDC-WAPDA) | Project 220kV/132kV GIS SUBSTATION GHAZI ROAD, LAHORE | Title 220kV SYNCHRONIZING PANEL (=D00+C6) CB SELECTION CIRCUIT FOR SYNC | Drawing no. P60194-E-DSC-SC-001 |
| REV. | DESCRIPTION | DATE | DRAWER | | | | | | Project no. P-60194 |

1

2

1

4

5

6

7


8

SYNC KEY INTERLOCKING CIRCUIT

=D01

=D0]

=D05

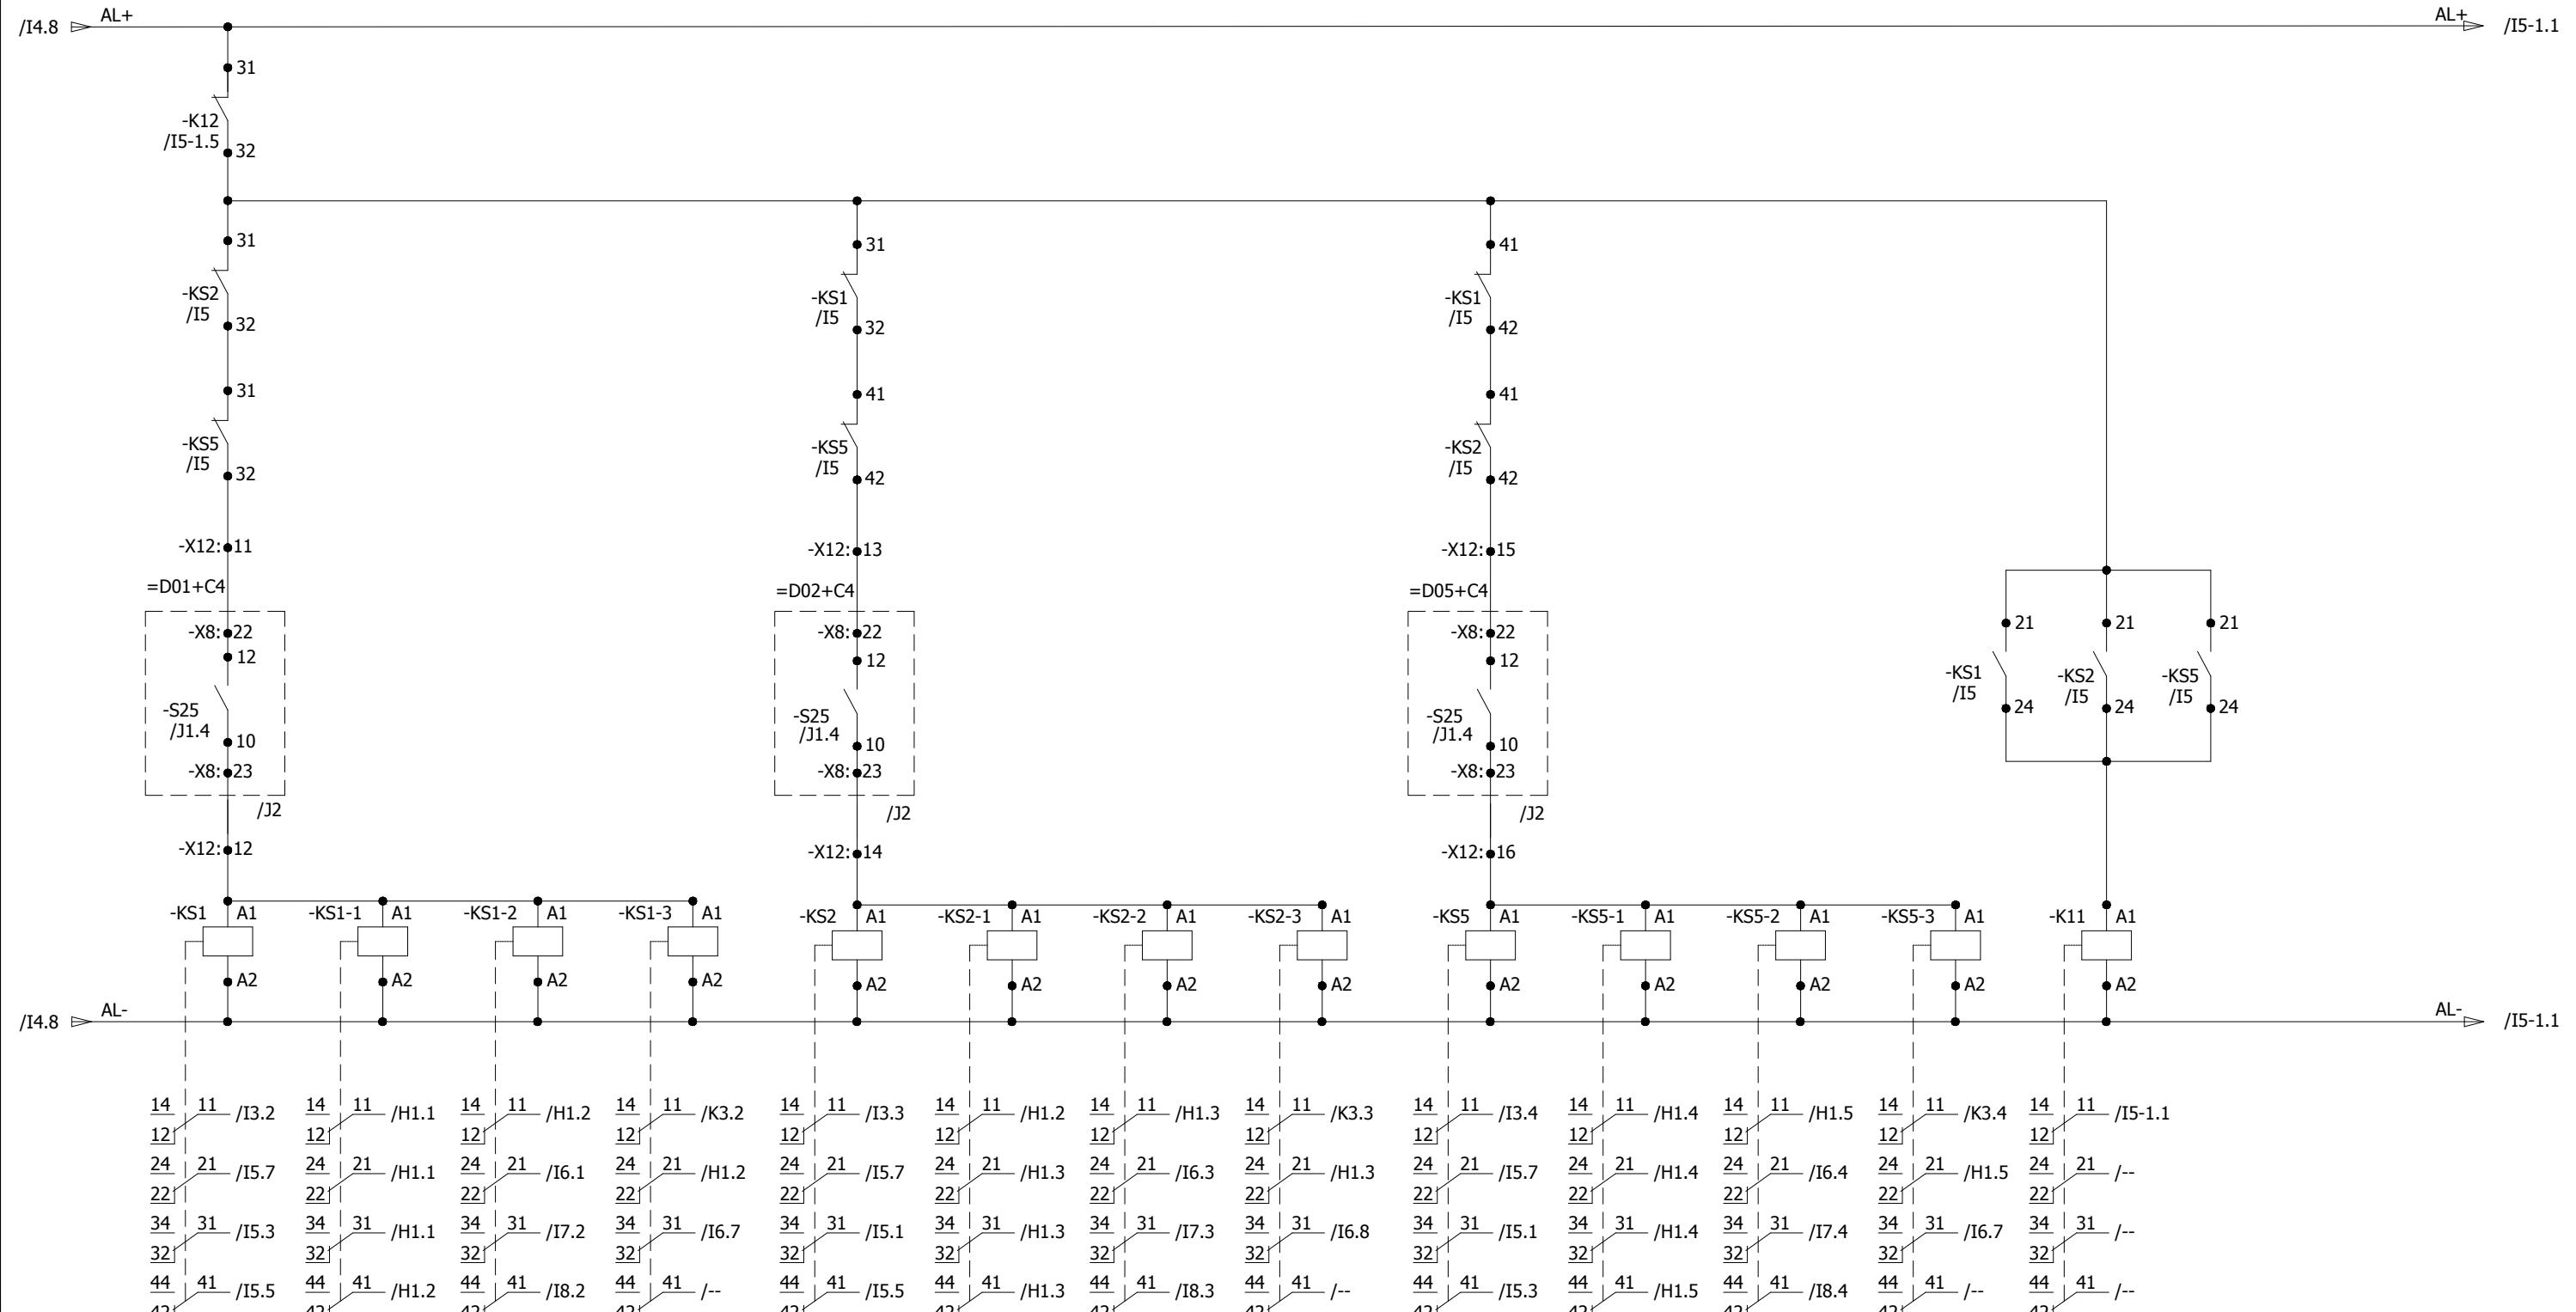







All information contained in this document is the exclusive property of GE GRID SOLUTIONS and shall not be used, copied or communicated to third parties without its prior authorization.

BUS-1 VT STATUS

BUS-1 VT STATUS

LOGIC INPUT

All information contained in this document is the exclusive property of GRID SOLUTIONS and shall not be used, copied or communicated to third parties without its prior authorization.

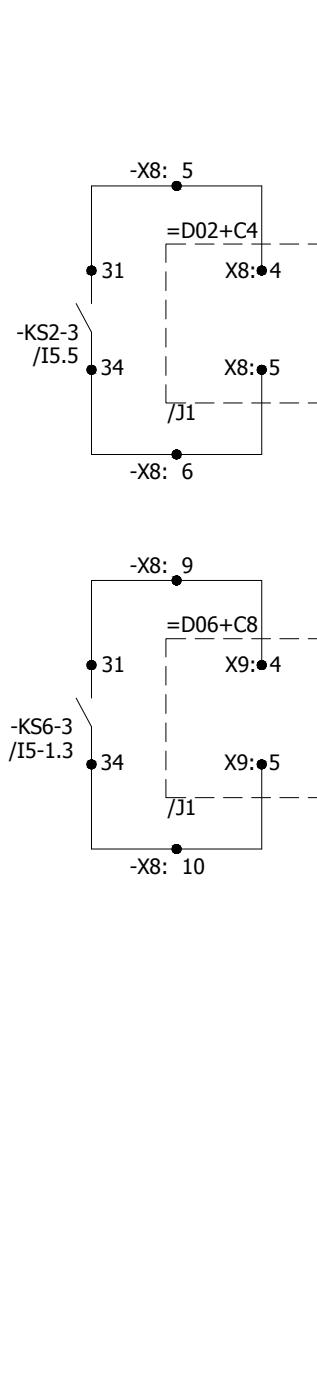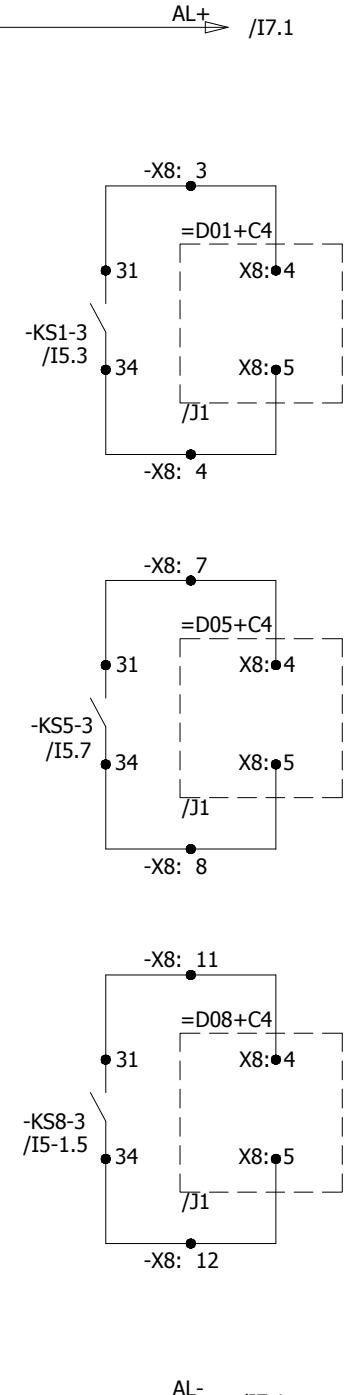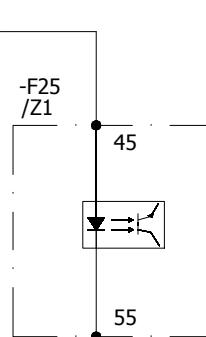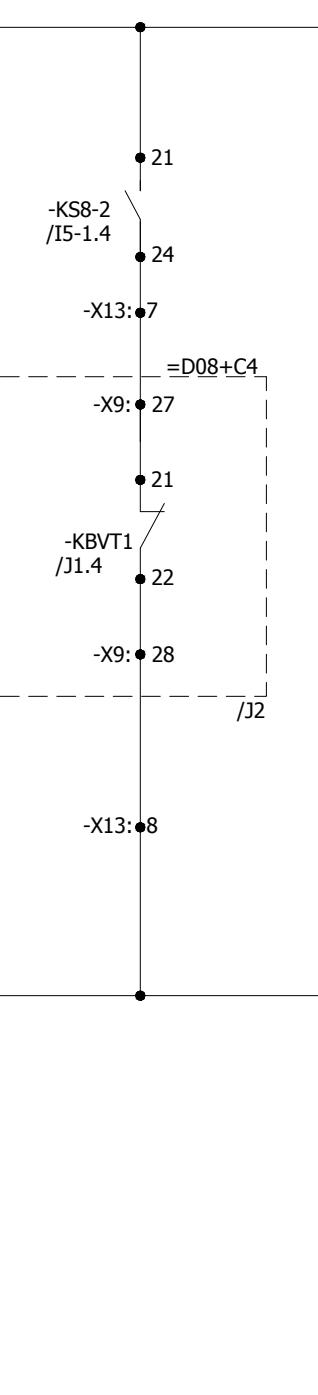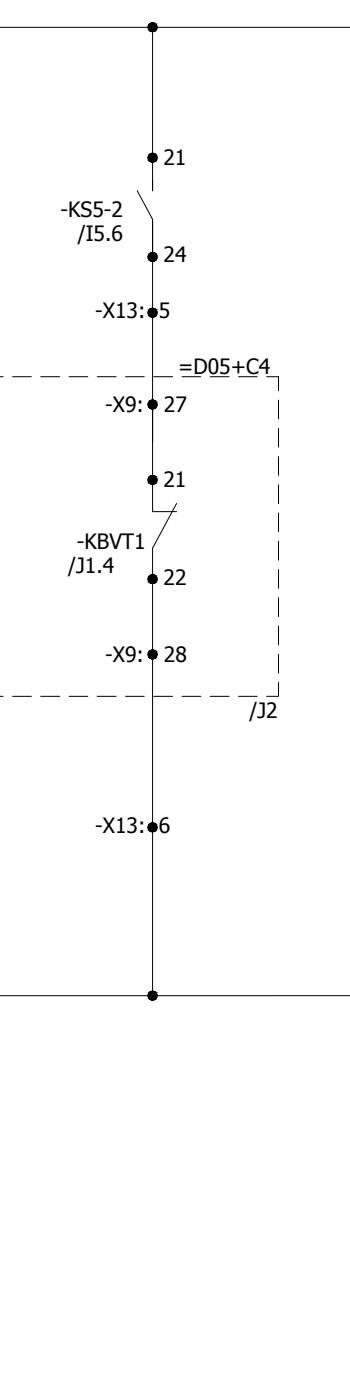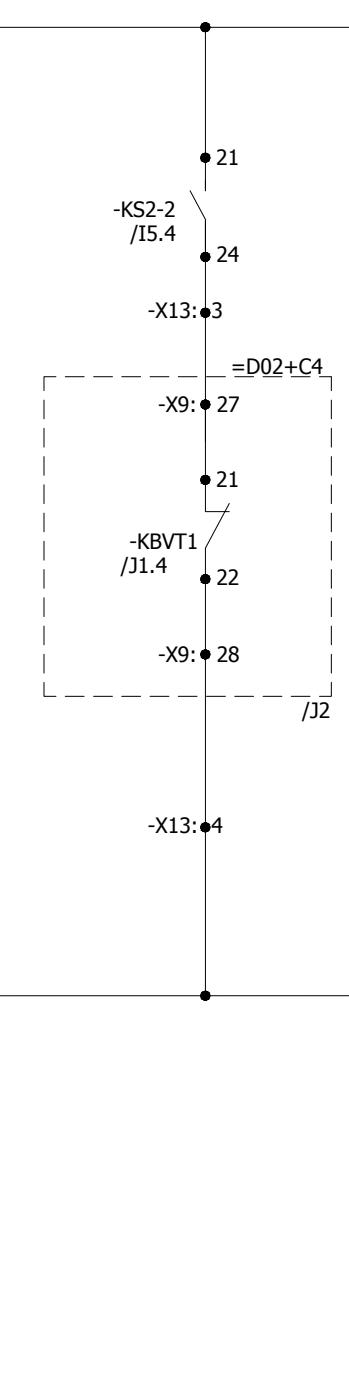


| 0 | AS BUILT | 18.08.2018 | MSC | Manufacturer  EPESOL 27-B Garden Block, New Garden Town, Lahore, Pakistan | Contractor  Grid Solutions A GE and Alstom joint venture | Client  NATIONAL TRANSMISSION & DISPATCH COMPANY LIMITED (NTDC-WAPDA) | Project 220kV/132kV GIS SUBSTATION GHAZI ROAD, LAHORE | Title 220kV SYNCHRONIZING PANEL (=D00+C6) BUS-1 VT HEALTH STATUS | Drawing no. P60194-E-DSC-SC-001 | | |
|------|-------------|------------|--------|-----------------------------------------------------------------------------------------------------------------------------------------------------------------------------|--------------------------------------------------------------------------------------------------------------------------------------------------------|------------------------------------------------------------------------------------------------------------------------------------------------------------------------|-------------------------------------------------------------|---------------------------------------------------------------------------|------------------------------------|------------------|-----------------|
| REV. | DESCRIPTION | DATE | DRAWER | | | | | | Project no. P-60194 | Sheet type I6 | Sheet no. 17 |
| 1 | 2 | 3 | 4 | 5 | 6 | 7 | 8 | | | | |

BUS-2 VT STATUS

BUS-2 VT STATUS

LOGIC INPUT

All information contained in this document is the exclusive property of GE GRID SOLUTIONS and shall not be used, copied or communicated to third parties without its prior authorization.

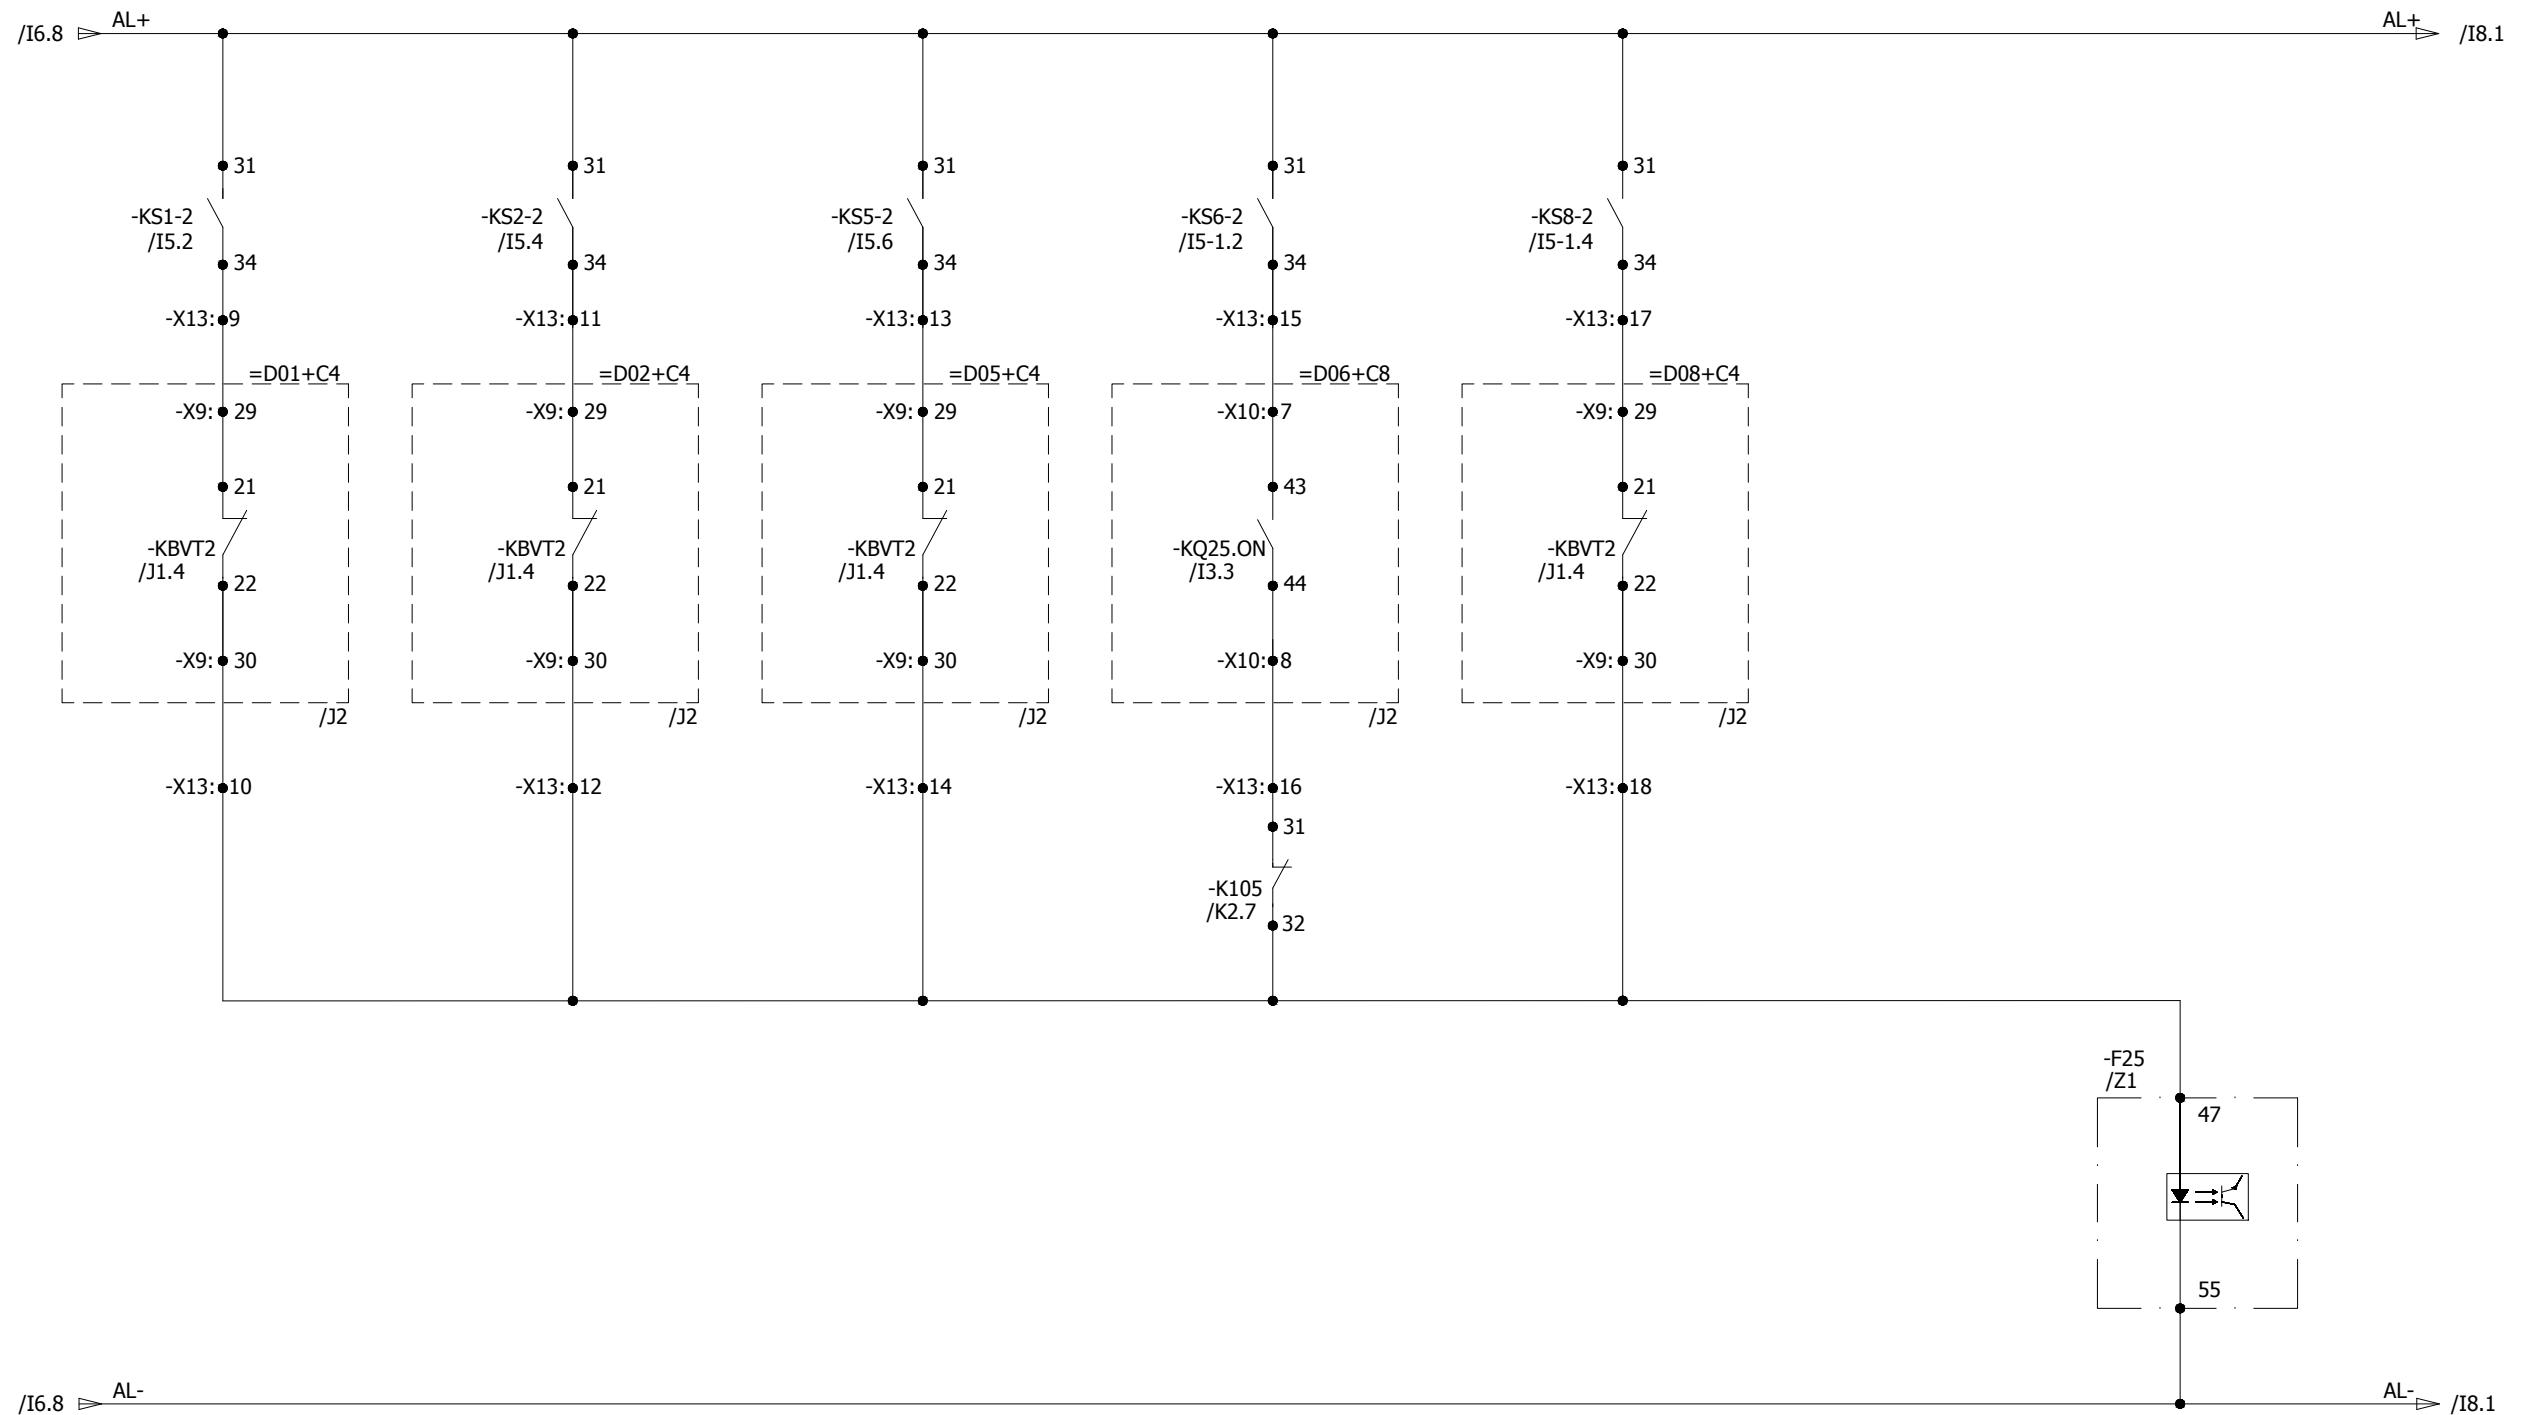

/I6.8 ▷ AL-


AL- ▷ /I8.1

| | | | | | | | | | |
|------|-------------|------------|--------|-----------------------------------------------------------------------------------------------------------------------------------------------------------------------------|--------------------------------------------------------------------------------------------------------------------------------------------------------|------------------------------------------------------------------------------------------------------------------------------------------------------------------------|------------------------------------------------------------|---------------------------------------------------------------------------|------------------------------------|
| 0 | AS BUILT | 18.08.2018 | MSC | Manufacturer  EPESOL 7-B Garden Block, New Garden Town, Lahore, Pakistan | Contractor  Grid Solutions A GE and Alstom joint venture | Client  NATIONAL TRANSMISSION & DISPATCH COMPANY LIMITED (NTDC-WAPDA) | Project 220kV/132kV GIS SUBSTATION GAZI ROAD, LAHORE | Title 220kV SYNCHRONIZING PANEL (=D00+C6) BUS-2 VT HEALTH STATUS | Drawing no. P60194-E-DSC-SC-001 |
| REV. | DESCRIPTION | DATE | DRAWER | | | | | | Project no. P-60194 |
| | | | | | | | | | Sheet type I7 |
| | | | | | | | | | Sheet no. 18 |

LINE VT STATUS

LINE VT STATUS

LOGIC INPUT

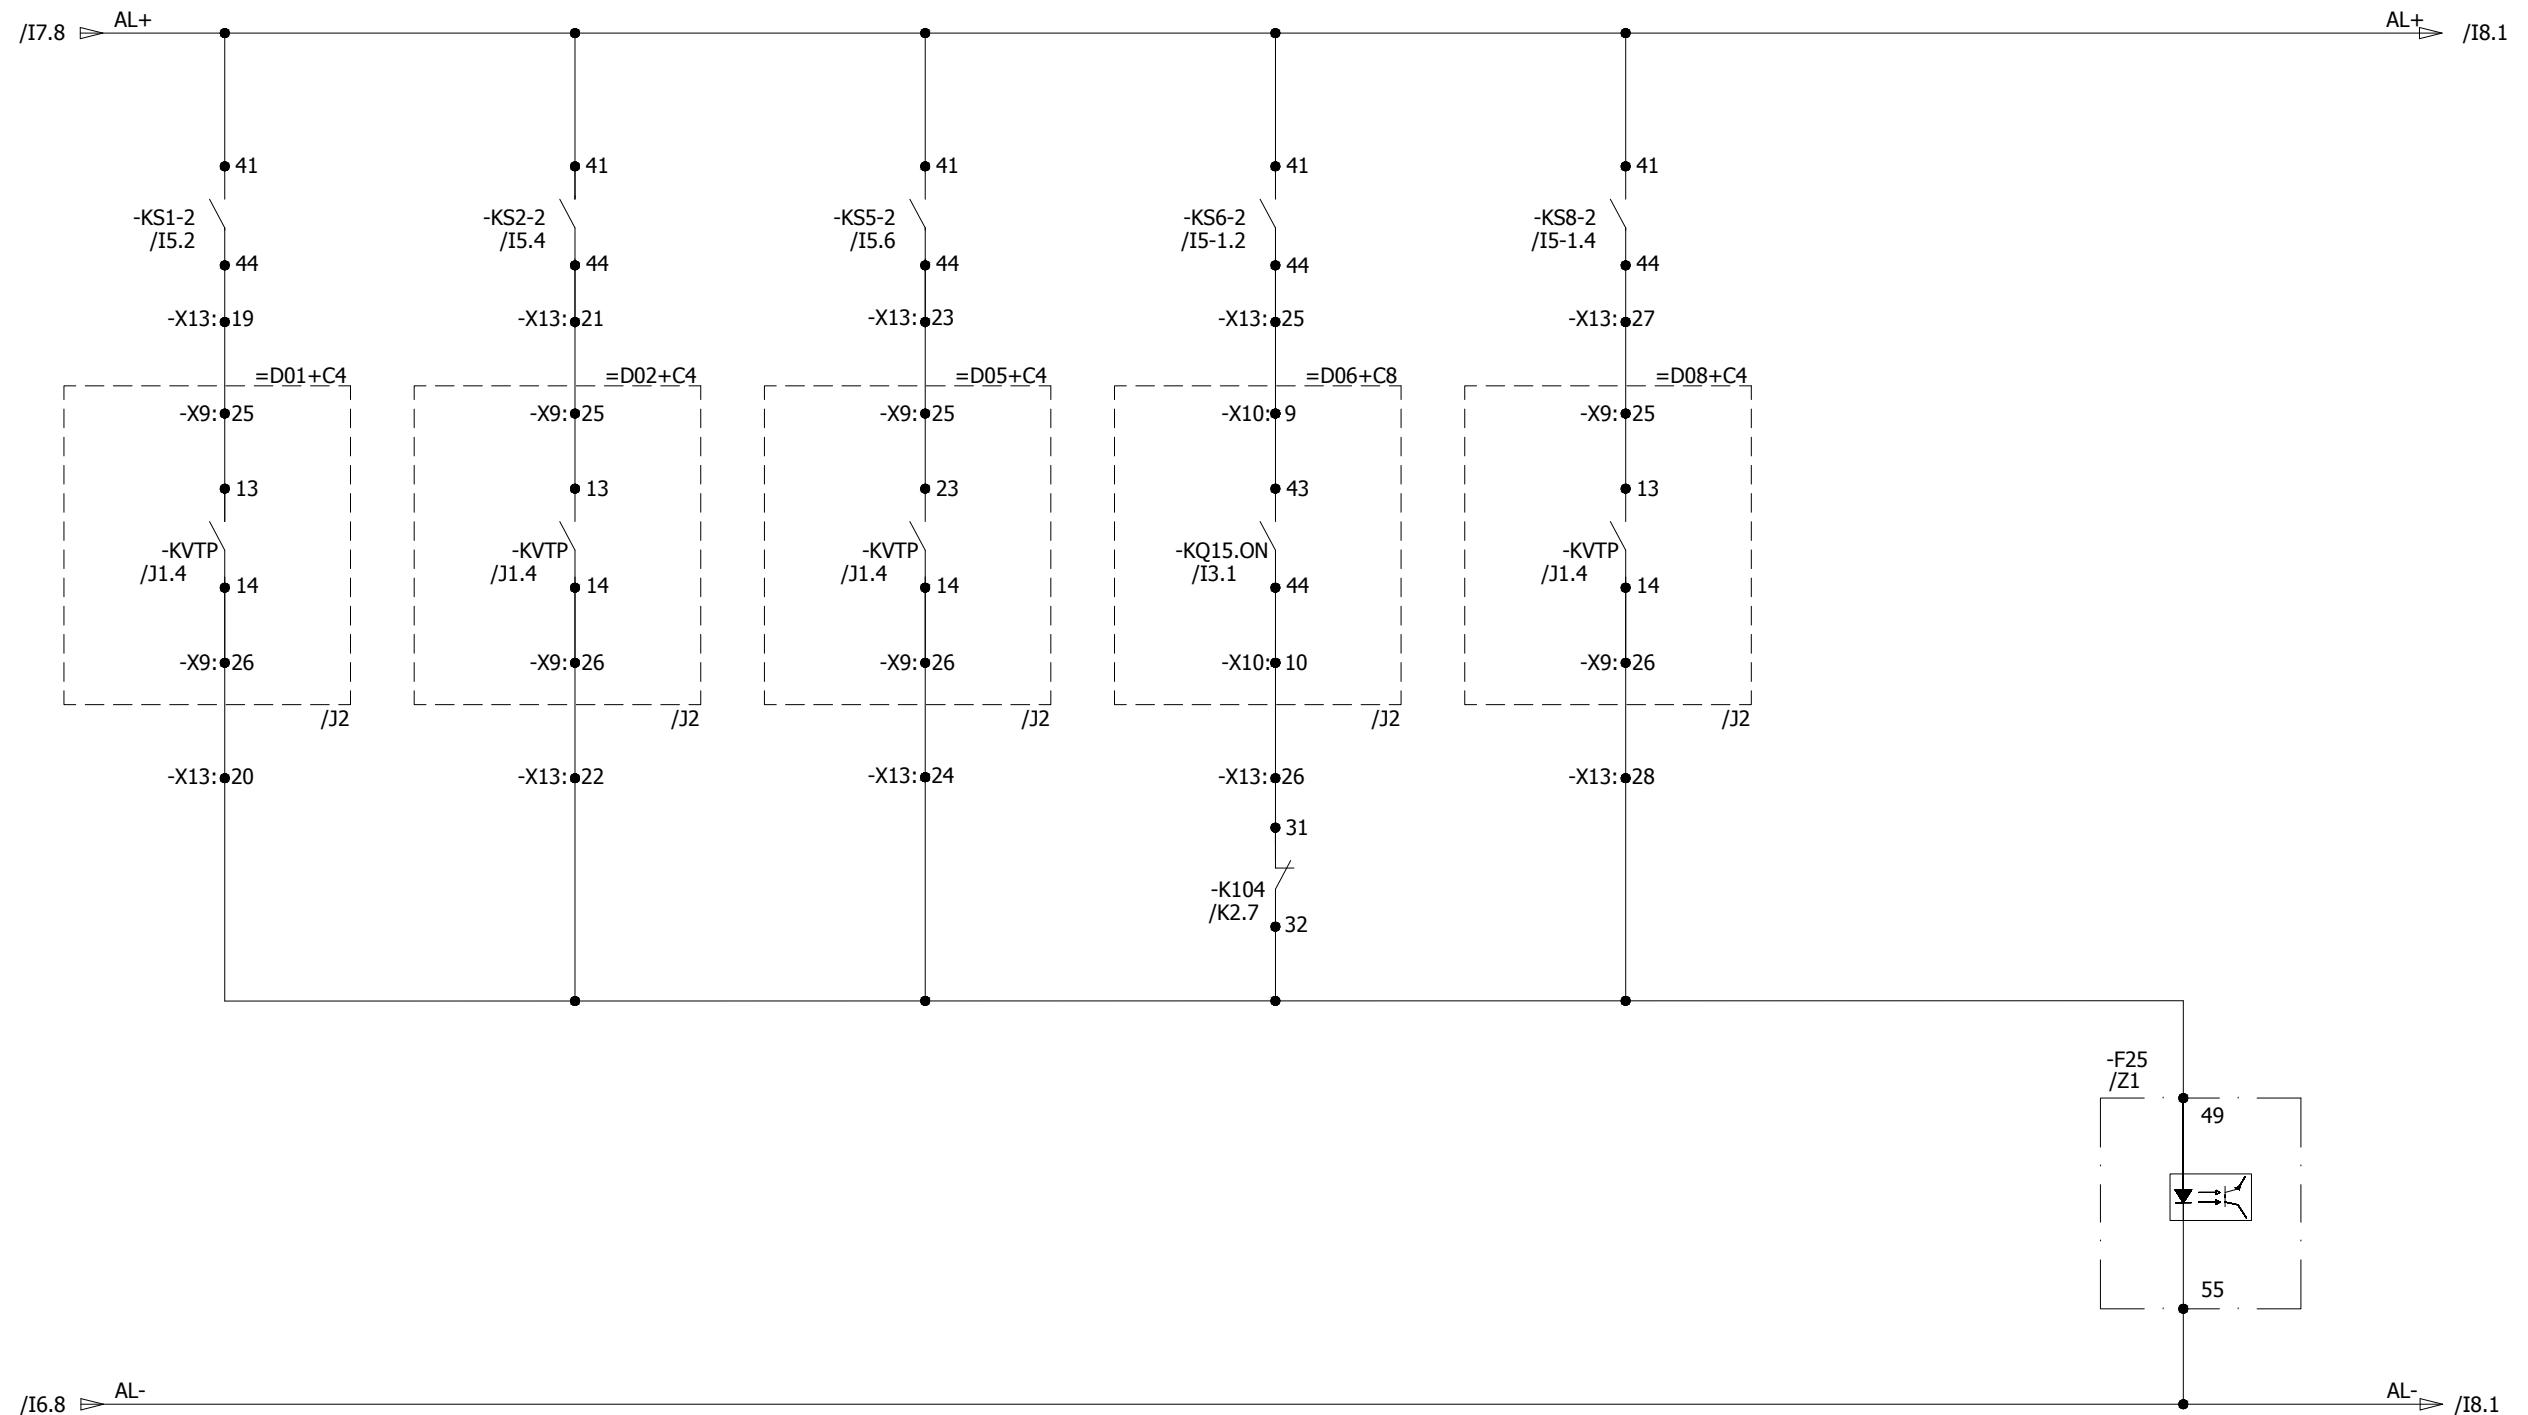


SYNC CHECK CONTACT

SYNCH CHECK RELAY

HEALTH STATUS

All information contained in this document is the exclusive property of GE GRID SOLUTIONS and shall not be used, copied or communicated to third parties without its prior authorization.

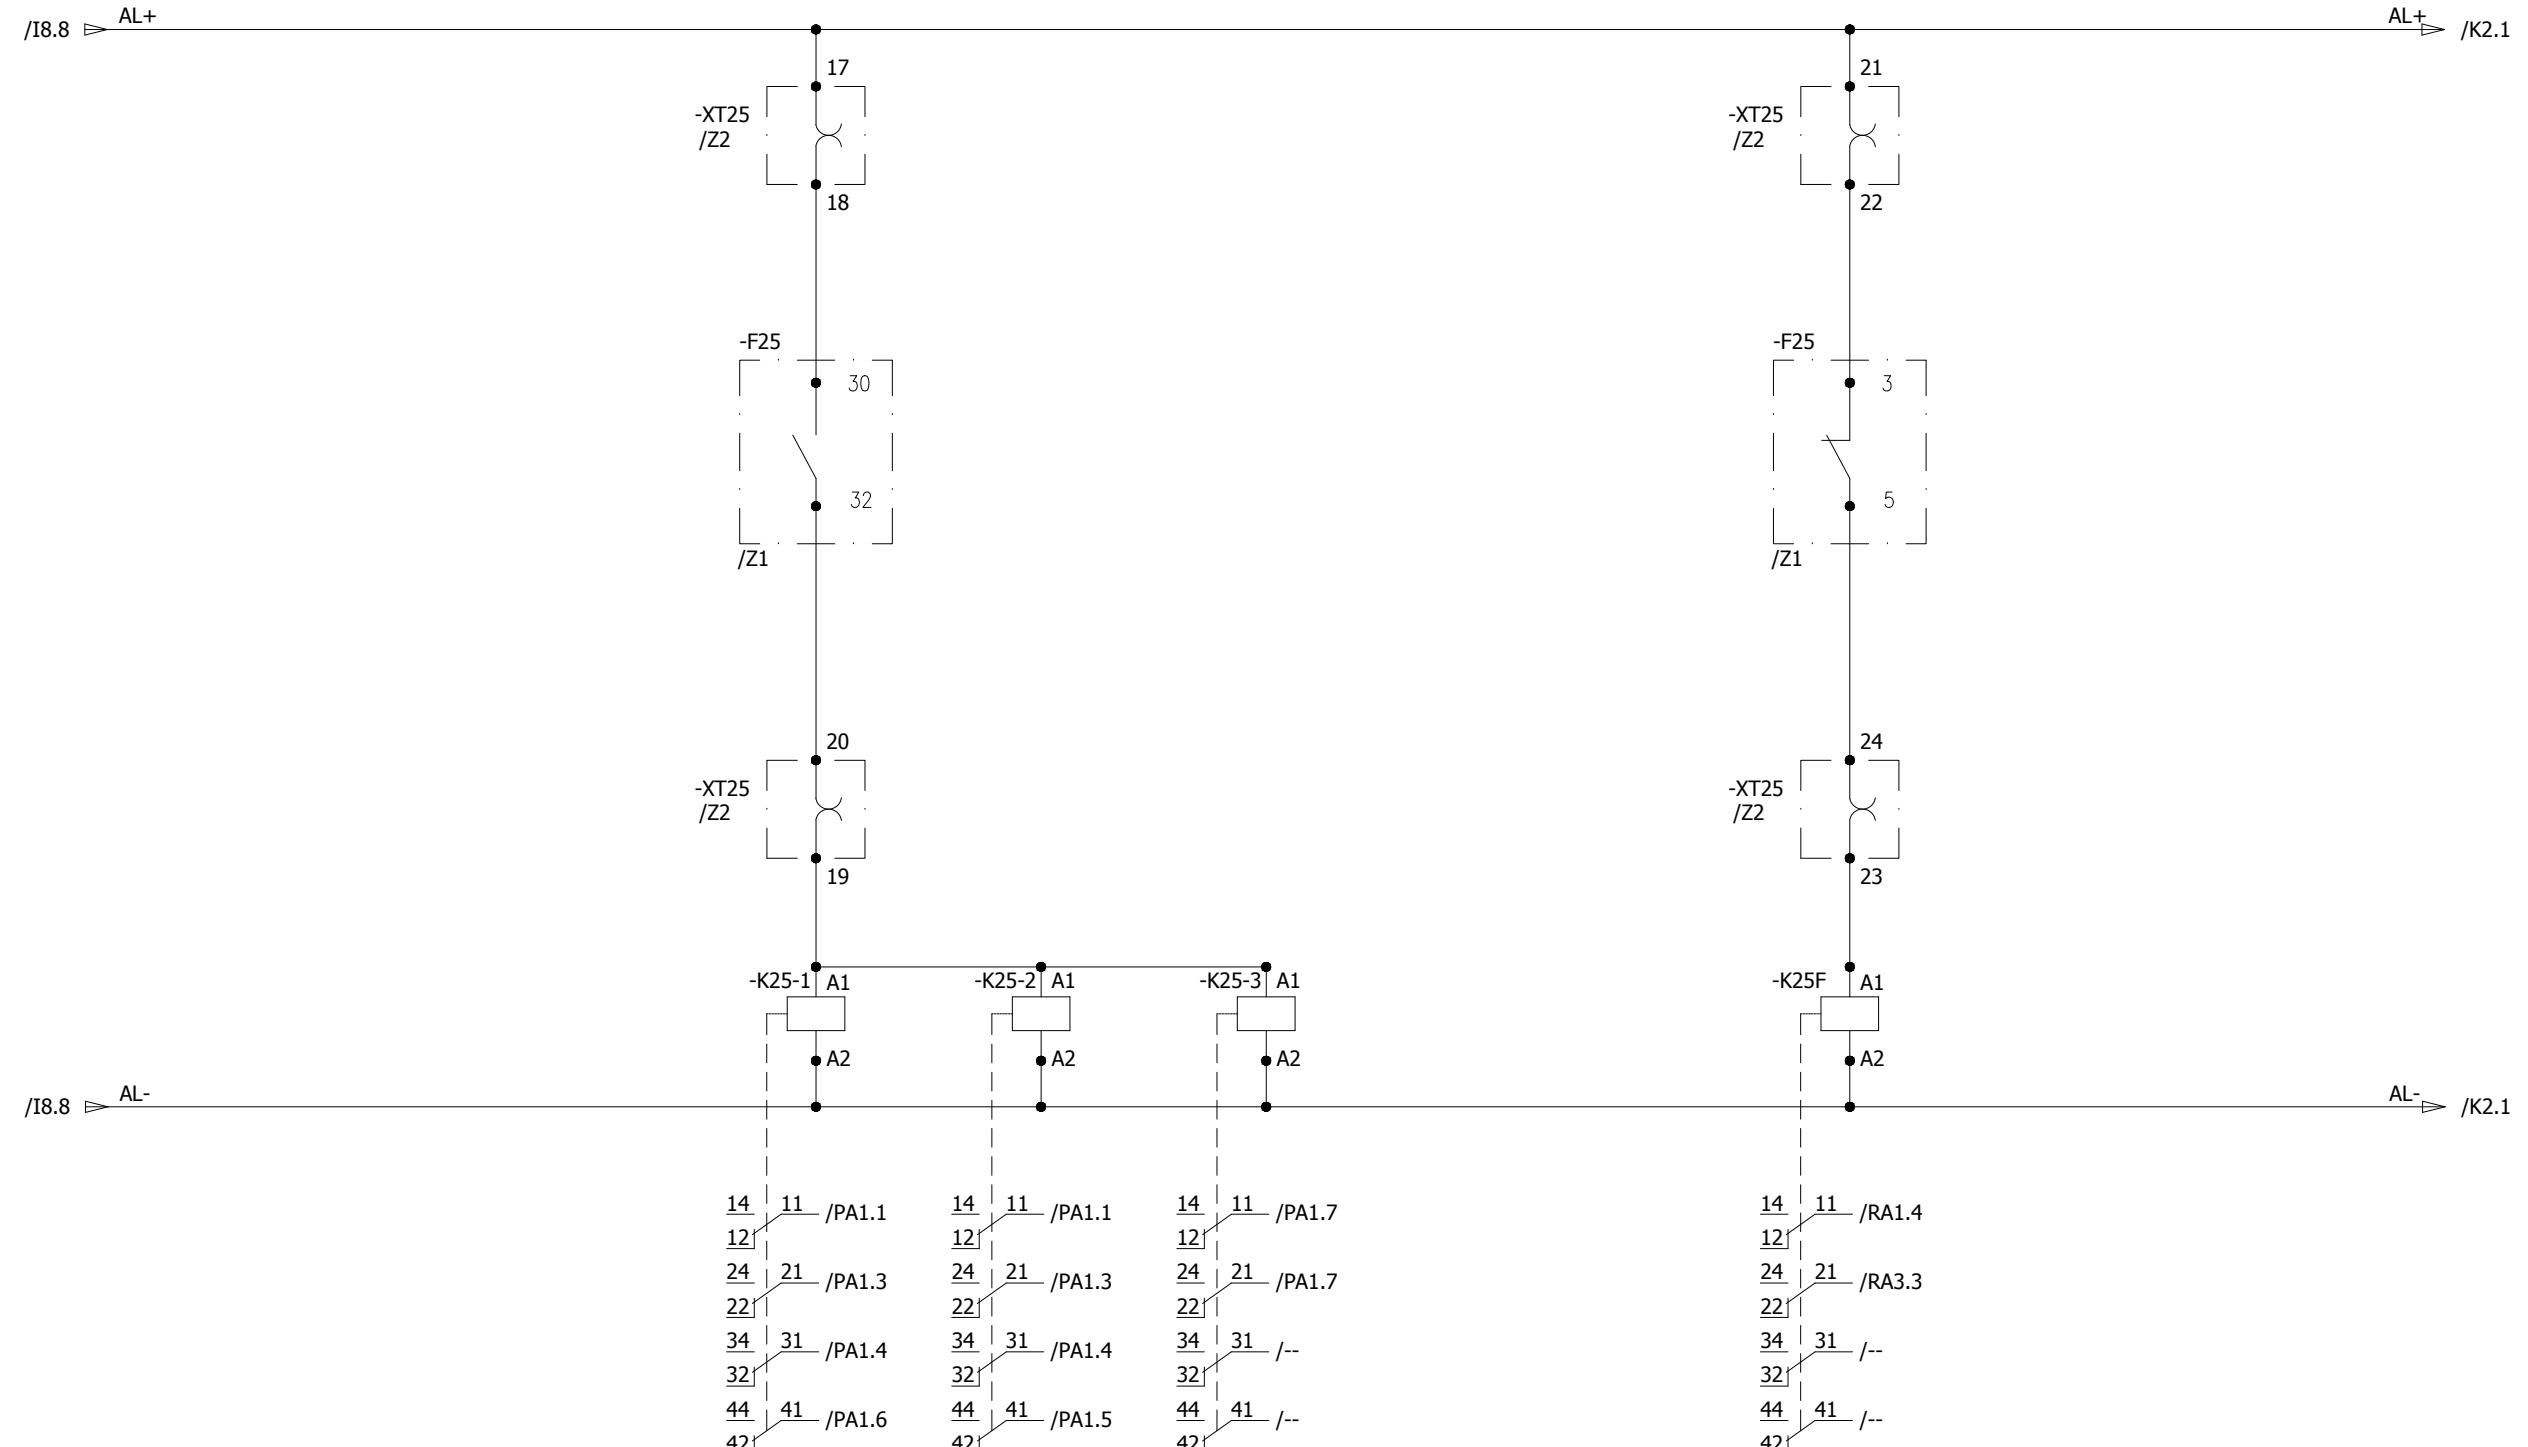

A

A

B

B

C

C

D

D

E

E


F

F

| | | | | | | | | | |
|------|-------------|------------|--------|---------------------------------------------------------------------------------------------|----------------------------------------------------------------------|-------------------------------------------------------------------------------|------------------------------------------------------------|--------------------------------------------------------------------------------|------------------------------------|
| 0 | AS BUILT | 18.08.2018 | MSC | Manufacturer EPESOL 71-B Garden Block, New Garden Town, Lahore, Pakistan | Contractor Grid Solutions A GE and Alstom joint venture | Client NATIONAL TRANSMISSION & DISPATCH COMPANY LIMITED (NTDC-WAPDA) | Project 220kV/132kV GIS SUBSTATION GAZI ROAD, LAHORE | Title 220kV SYNCHRONIZING PANEL (=D00+C6) SYNCHRO CHECK RELAY CONTACT | Drawing no. P60194-E-DSC-SC-001 |
| REV. | DESCRIPTION | DATE | DRAWER | | | | | Project no. P-60194 | Sheet type K1 |
| | | | | | | | | | Sheet no. 20 |

All information contained in this document is the exclusive property of GE GRID SOLUTIONS and shall not be used, copied or communicated to third parties without its prior authorization.

| | | | | |
|-------------|-------------|-----------|---------------|---------------|
| E/F 220V DC | E/F 220V DC | PLC PANEL | 220KV BB-1 VT | 220KV BB-2 VT |
| SYSTEM 1 | SYSTEM 2 | FAILURE | FAILURE | FAILURE |

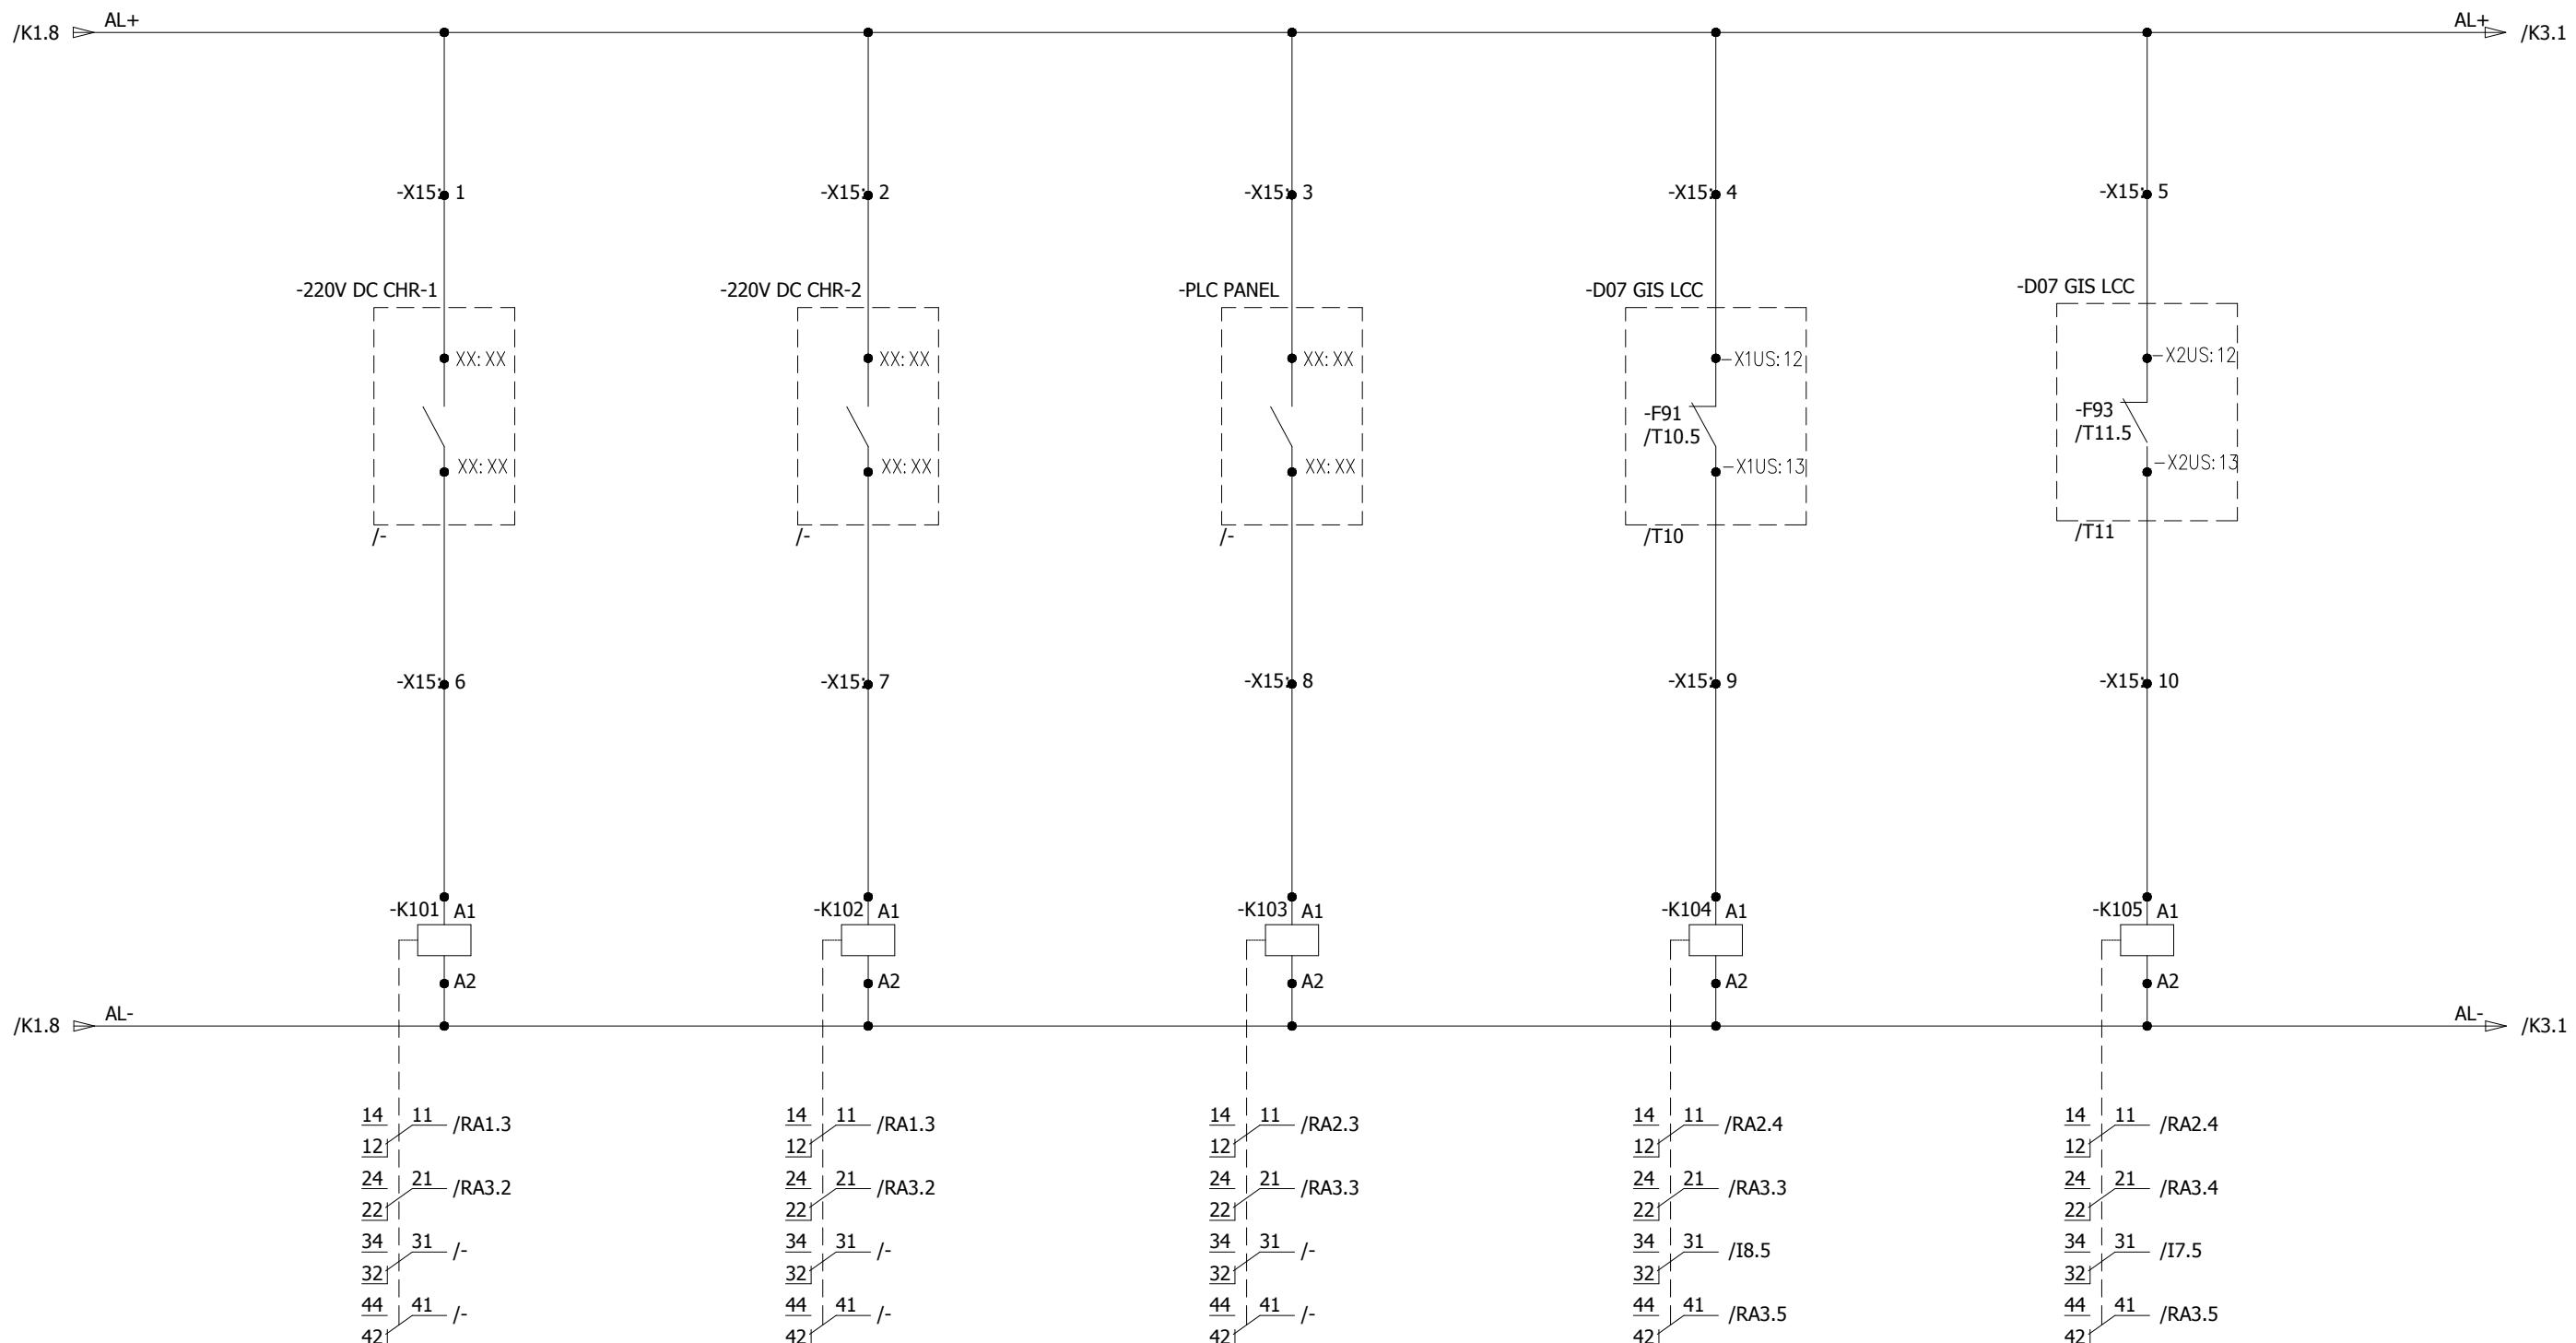

A A
B B
C C
D D
E E
F F

| | | | | | | | | | |
|------|-------------|------------|--------|--------------------------------------------------------------------------------------------|----------------------------------------------------------------------|-------------------------------------------------------------------------------|------------------------------------------------------------|-------------------------------------------------------------------------|------------------------------------|
| 0 | AS BUILT | 18.08.2018 | MSC | Manufacturer EPESOL 7-B Garden Block, New Garden Town, Lahore, Pakistan | Contractor Grid Solutions A GE and Alstom joint venture | Client NATIONAL TRANSMISSION & DISPATCH COMPANY LIMITED (NTDC-WAPDA) | Project 220KV/132kV GIS SUBSTATION GAZI ROAD, LAHORE | Title 220KV SYNCHRONIZING PANEL (=D00+C6) COMMON ALARM SIGNALS | Drawing no. P60194-E-DSC-SC-001 |
| REV. | DESCRIPTION | DATE | DRAWER | | | | | | Project no. P-60194 |
| | | | | | | | | | Sheet type K2 |
| | | | | | | | | | Sheet no. 21 |

SYNC UNSUCCESSFUL SIGNALS

DC MONITORING

=D01+Q0


=D02+Q0

=D05+Q0

=D06+Q0

=D08+Q0






CIRCUIT

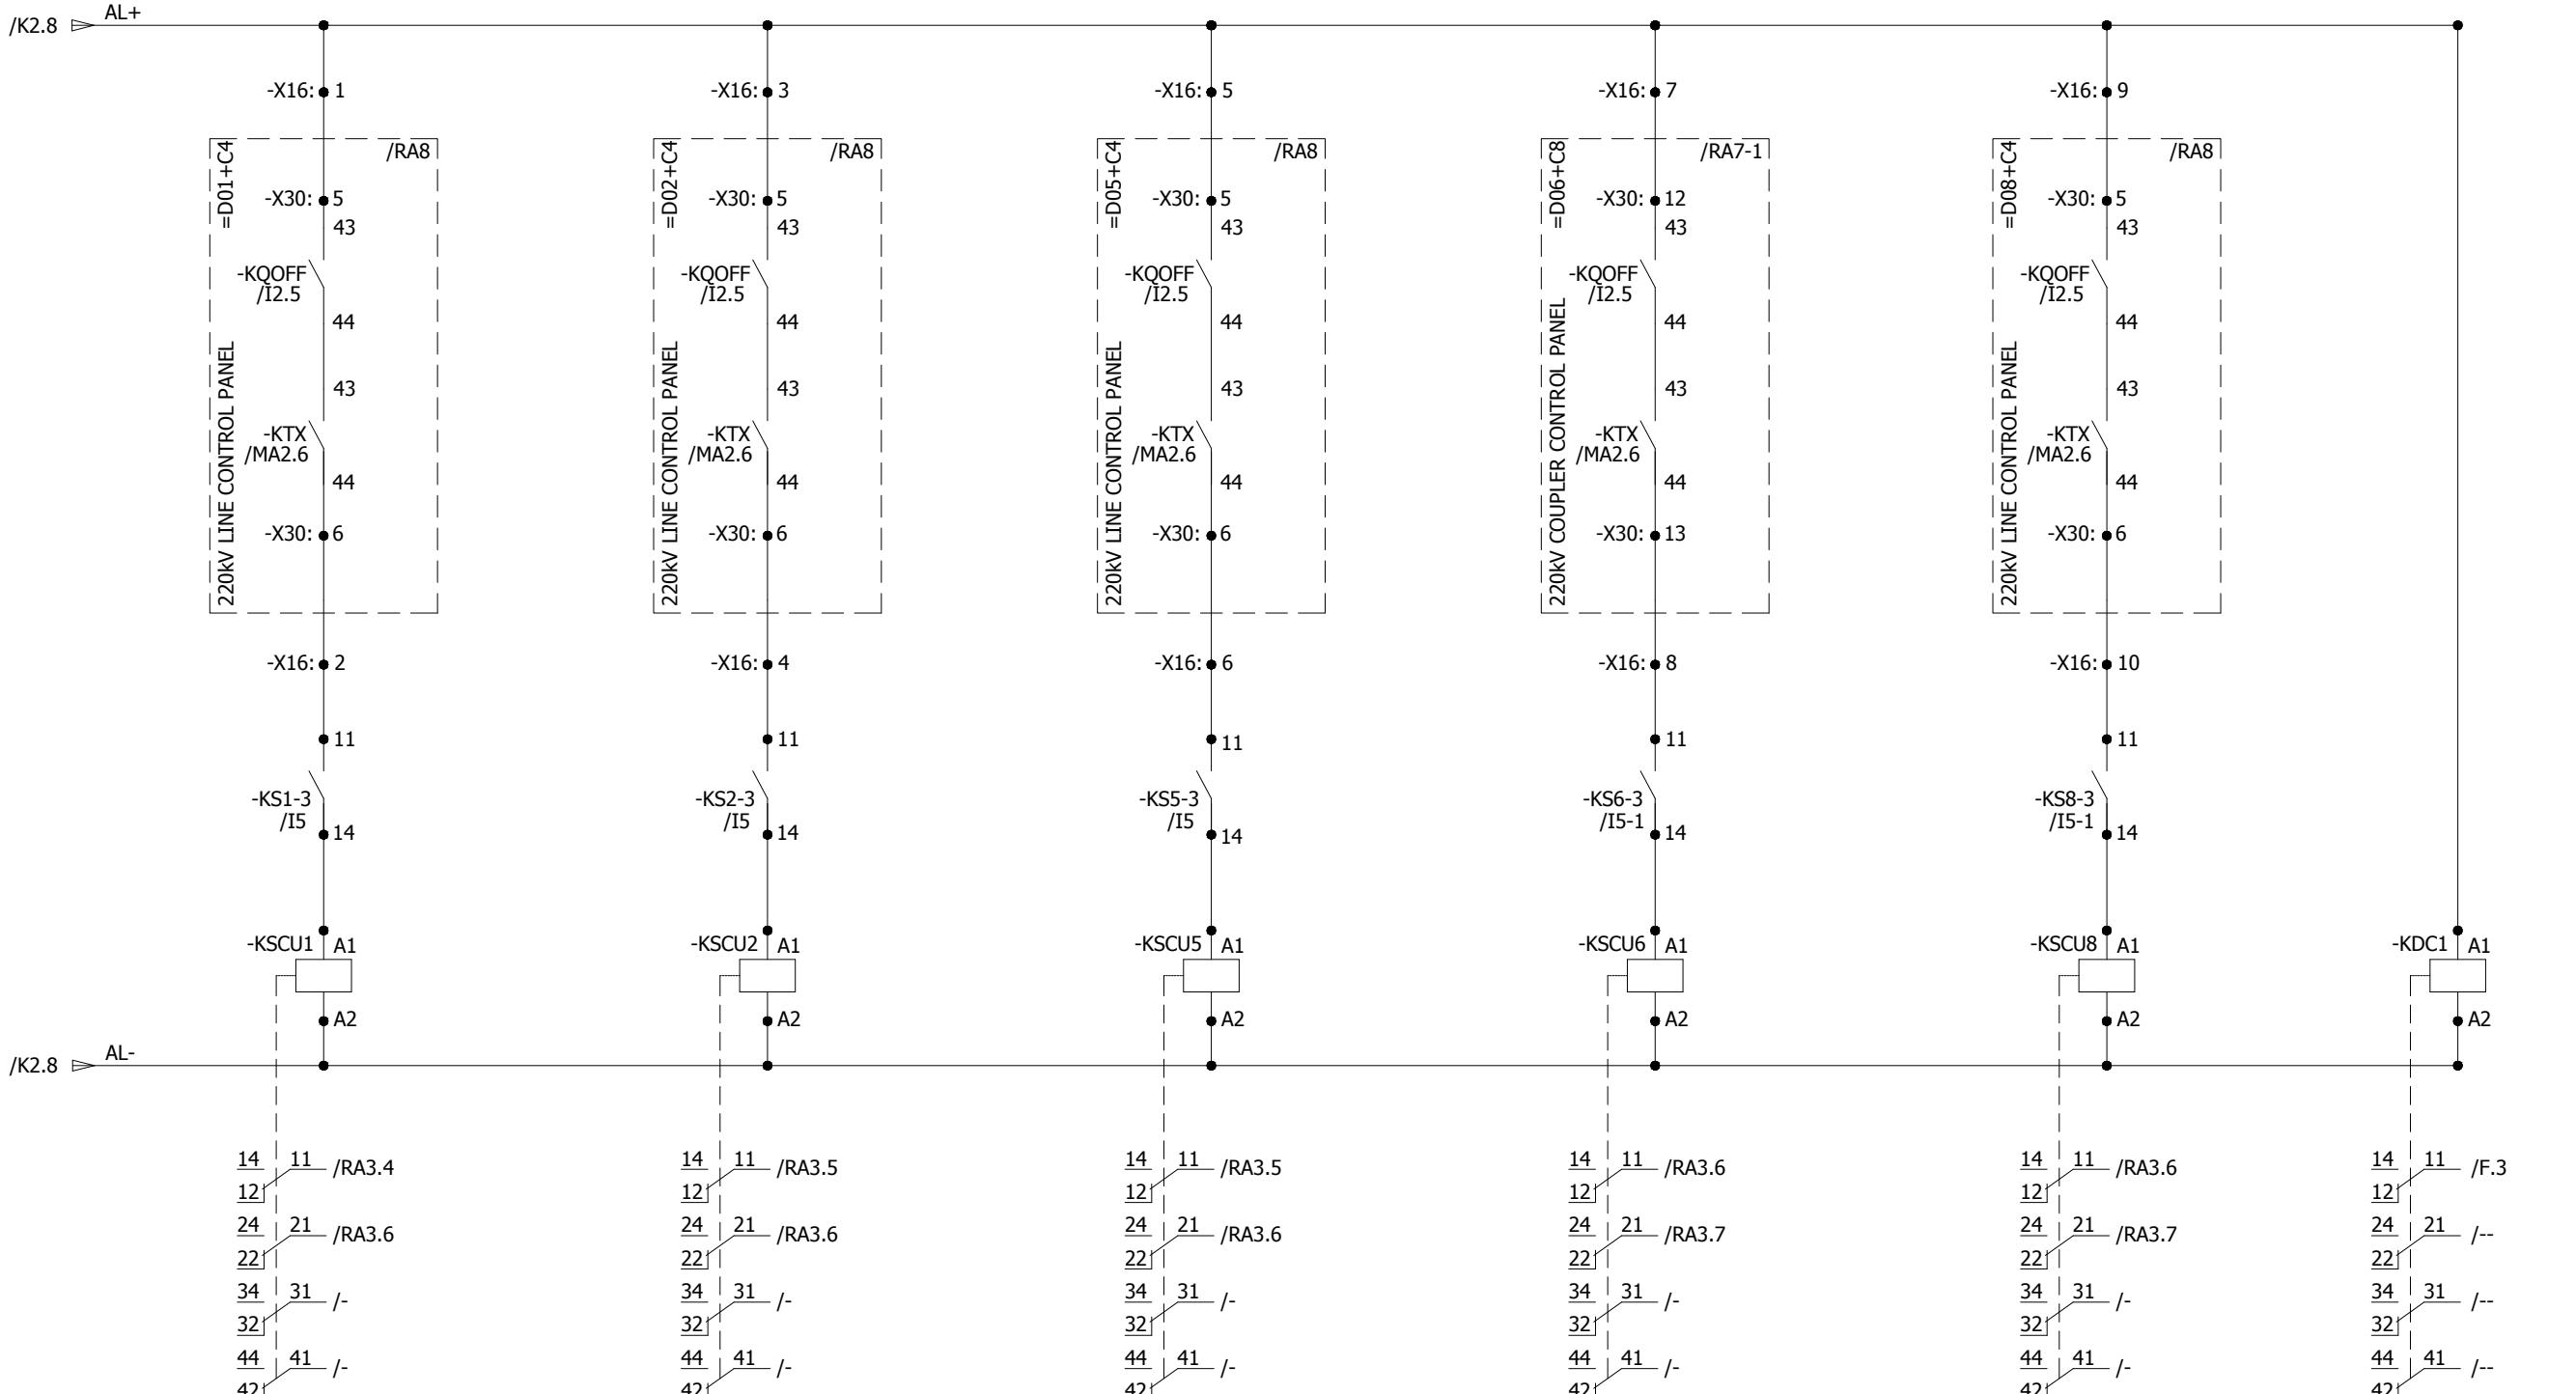






All information contained in this document is the exclusive property of GE GRID SOLUTIONS and shall not be used, copied or communicated to third parties without its prior authorization.

| | | | | | | | | | |
|------|-------------|------------|--------|-----------------------------------------------------------------------------------------------------------------------------------------------------------------------------|--------------------------------------------------------------------------------------------------------------------------------------------------------|------------------------------------------------------------------------------------------------------------------------------------------------------------------------|------------------------------------------------------------|-------------------------------------------------------------------------|------------------------------------|
| 0 | AS BUILT | 18.08.2018 | MSC | Manufacturer  EPESOL 71-B Garden Block, New Garden Town, Lahore, Pakistan | Contractor  Grid Solutions A GE and Alstom joint venture | Client  NATIONAL TRANSMISSION & DISPATCH COMPANY LIMITED (NTDC-WAPDA) | Project 220kV/132kV GIS SUBSTATION GAZI ROAD, LAHORE | Title 220kV SYNCHRONIZING PANEL (=D00+C6) COMMON ALARM SIGNALS | Drawing no. P60194-E-DSC-SC-001 |
| REV. | DESCRIPTION | DATE | DRAWER | | | | | | Project no. P-60194 |
| | | | | | | | | | Sheet type K3 |
| | | | | | | | | | Sheet no. 22 |

All information contained in this document is the exclusive property of GE GRID SOLUTIONS and shall not be used, copied or communicated to third parties without its prior authorization.

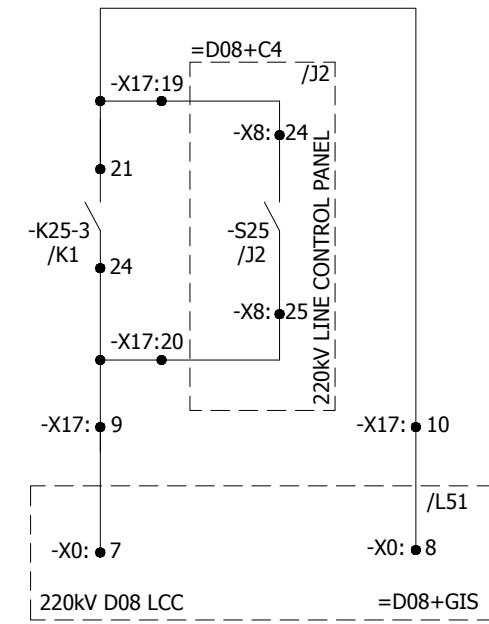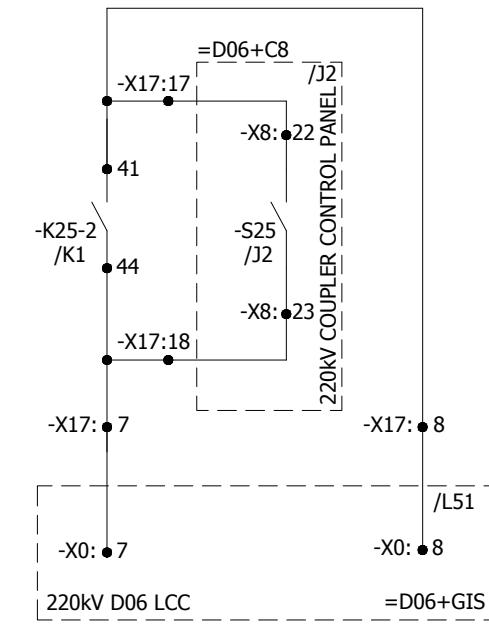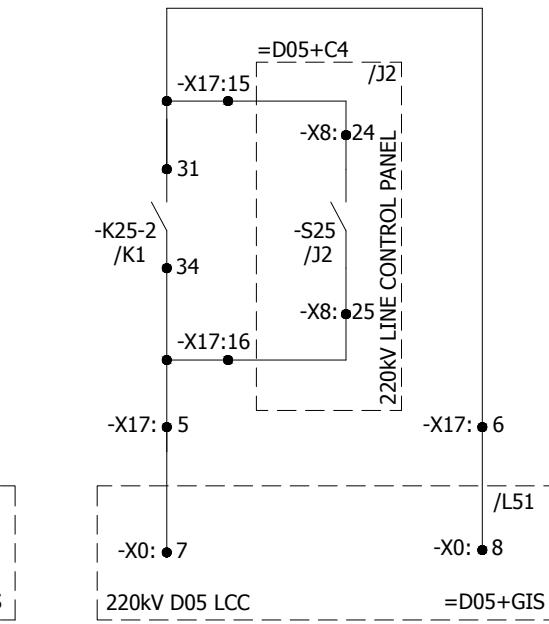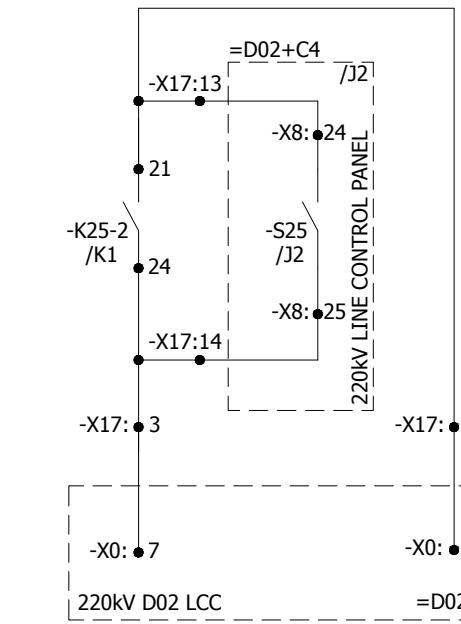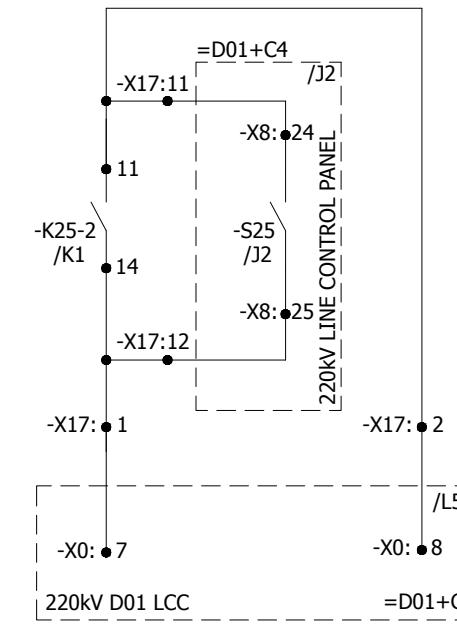


CB CLOSING PERMISSION
FROM SYNCHRO CHECK

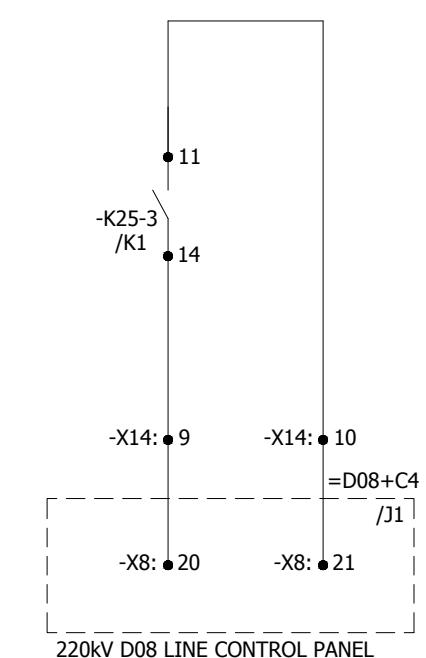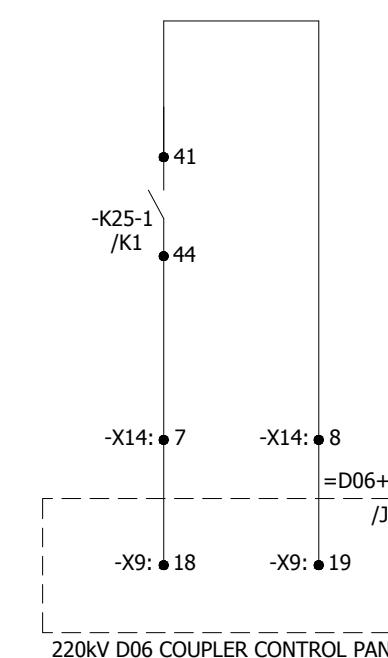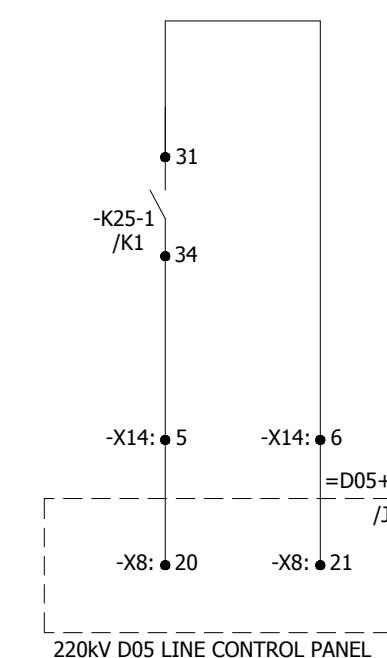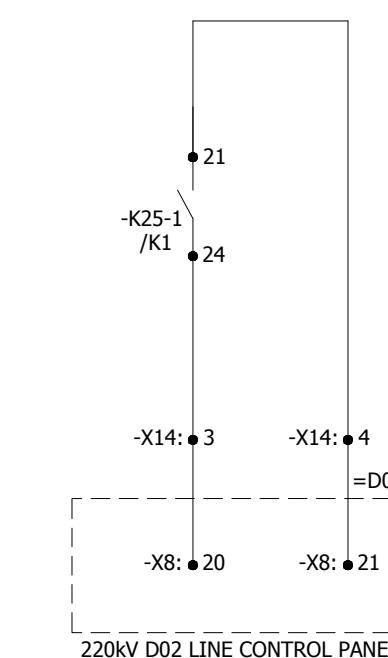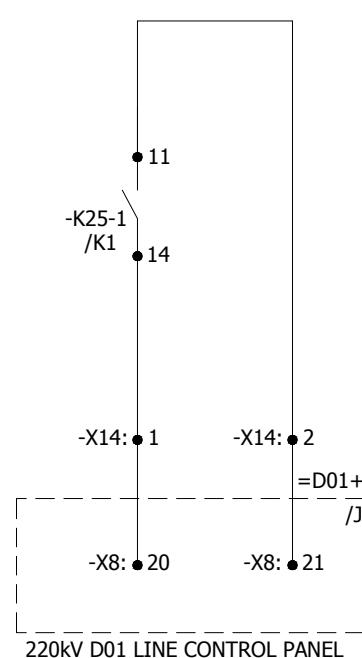


| | | | | | | | | | | | |
|------|-------------|------------|--------|-----------------------------------------------------------------------------------------------------------------------------------------------------------------------------|--------------------------------------------------------------------------------------------------------------------------------------------------------|------------------------------------------------------------------------------------------------------------------------------------------------------------------------|-------------------------------------------------------------|--------------------------------------------------------------------------|------------------------------------|------------|-----------|
| 0 | AS BUILT | 18.08.2018 | MSC | Manufacturer  EPESOL 7-B Garden Block, New Garden Town, Lahore, Pakistan | Contractor  Grid Solutions A GE and Alstom joint venture | Client  NATIONAL TRANSMISSION & DISPATCH COMPANY LIMITED (NTDC-WAPDA) | Project 220kV/132kV GIS SUBSTATION GHAZI ROAD, LAHORE | Title 220kV SYNCHRONIZING PANEL (=D00+C6) CB CLOSING PERMISSION | Drawing no. P60194-E-DSC-SC-001 | | |
| | | | | | | | | | Project no. | Sheet type | Sheet no. |
| REV. | DESCRIPTION | DATE | DRAWER | | | | | | P-60194 | PA1 | 23 |

All information contained in this document is the exclusive property of GE GRID SOLUTIONS and shall not be used, copied or communicated to third parties without its prior authorization.

ANNUNCIATION CIRCUIT

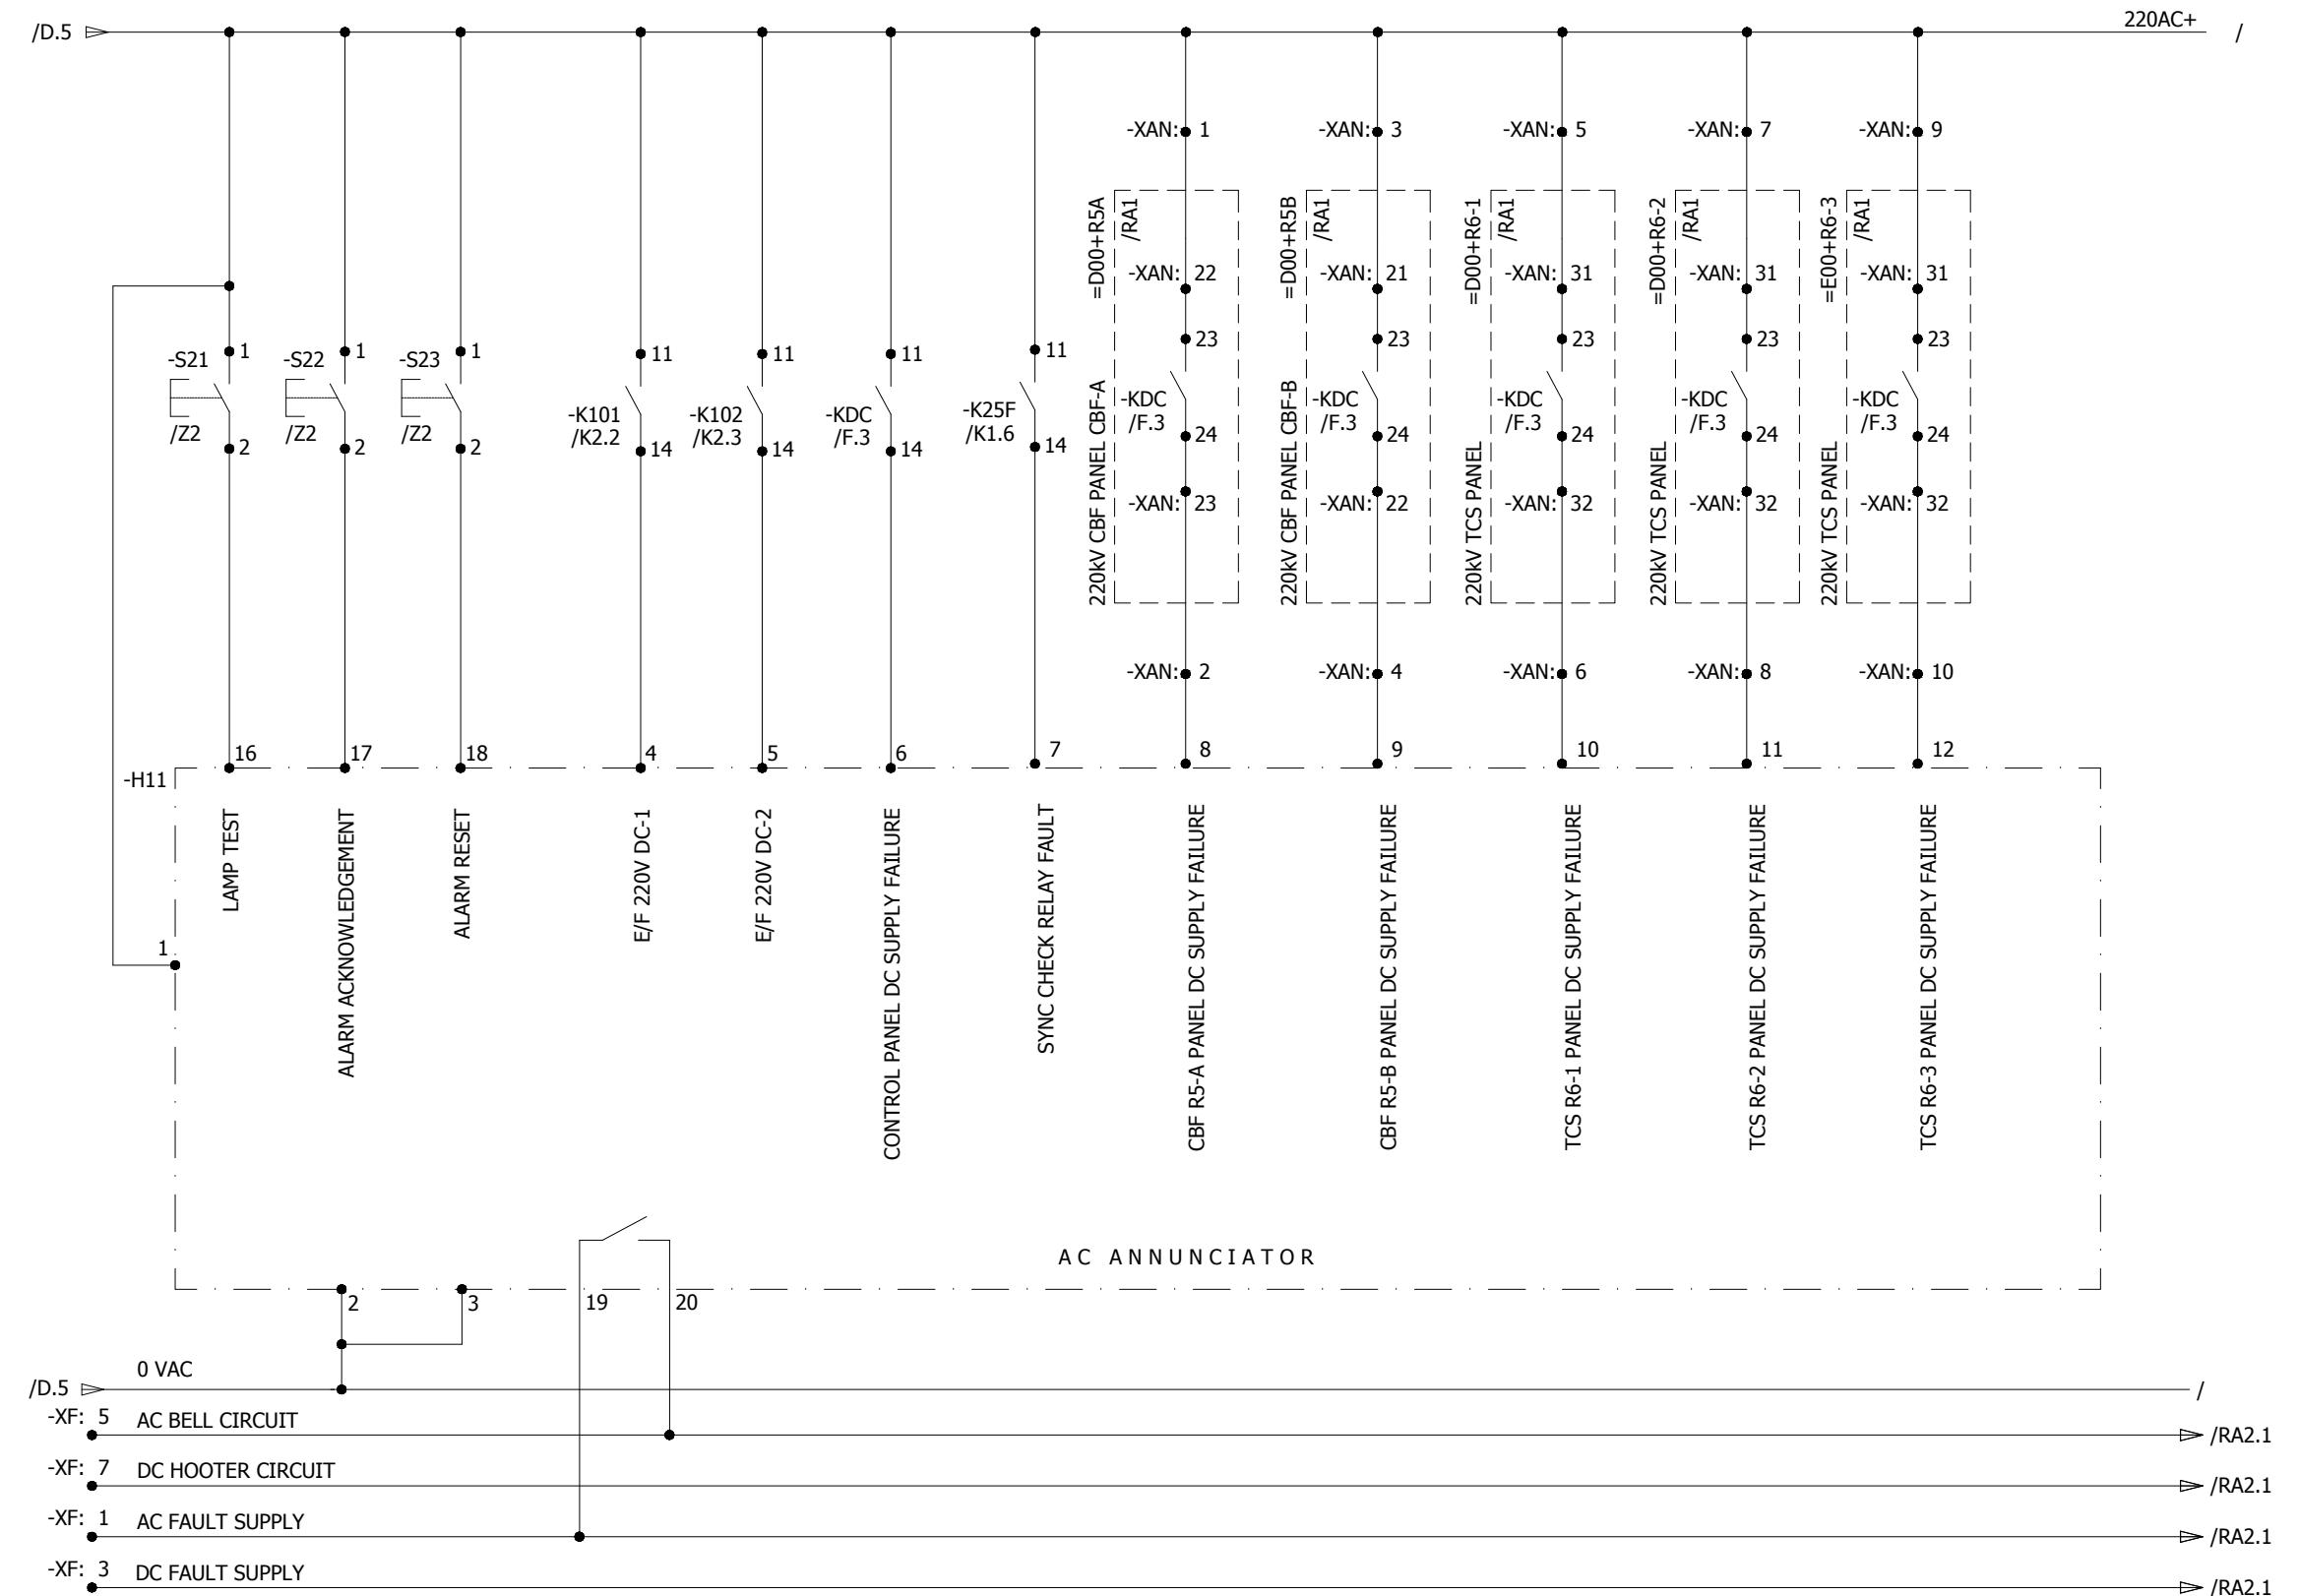


| | | | | | | | | | | | |
|------|-------------|------------|--------|----------------------------------------------------------------------------------------------------------------------------------------------------------------------------------|------------------------------------------------------------------------------------------------------------------------------------------------------------|-----------------------------------------------------------------------------------------------------------------------------------------------------------------------------|-------------------------------------------------------------|---------------------------------------------------------------------|------------------------------------|------------|-----------|
| 0 | AS BUILT | 18.08.2018 | MSC | Manufacturer  EPESOL 71-B Garden Block, New Garden Town, Lahore, Pakistan | Contractor  Grid Solutions A GE and Alstom joint venture | Client  NATIONAL TRANSMISSION & DISPATCH COMPANY LIMITED (NTDC-WAPDA) | Project 220kV/132kV GIS SUBSTATION GHAZI ROAD, LAHORE | Title 220kV SYNCHRONIZING PANEL (=D00+C6) AC ANNUNCIATIONS | Drawing no. P60194-E-DSC-SC-001 | | |
| | | | | | | | | | Project no. | Sheet type | Sheet no. |
| | | | | | | | | | P-60194 | RA1 | 24 |
| REV. | DESCRIPTION | DATE | DRAWER | | | | | | | | |

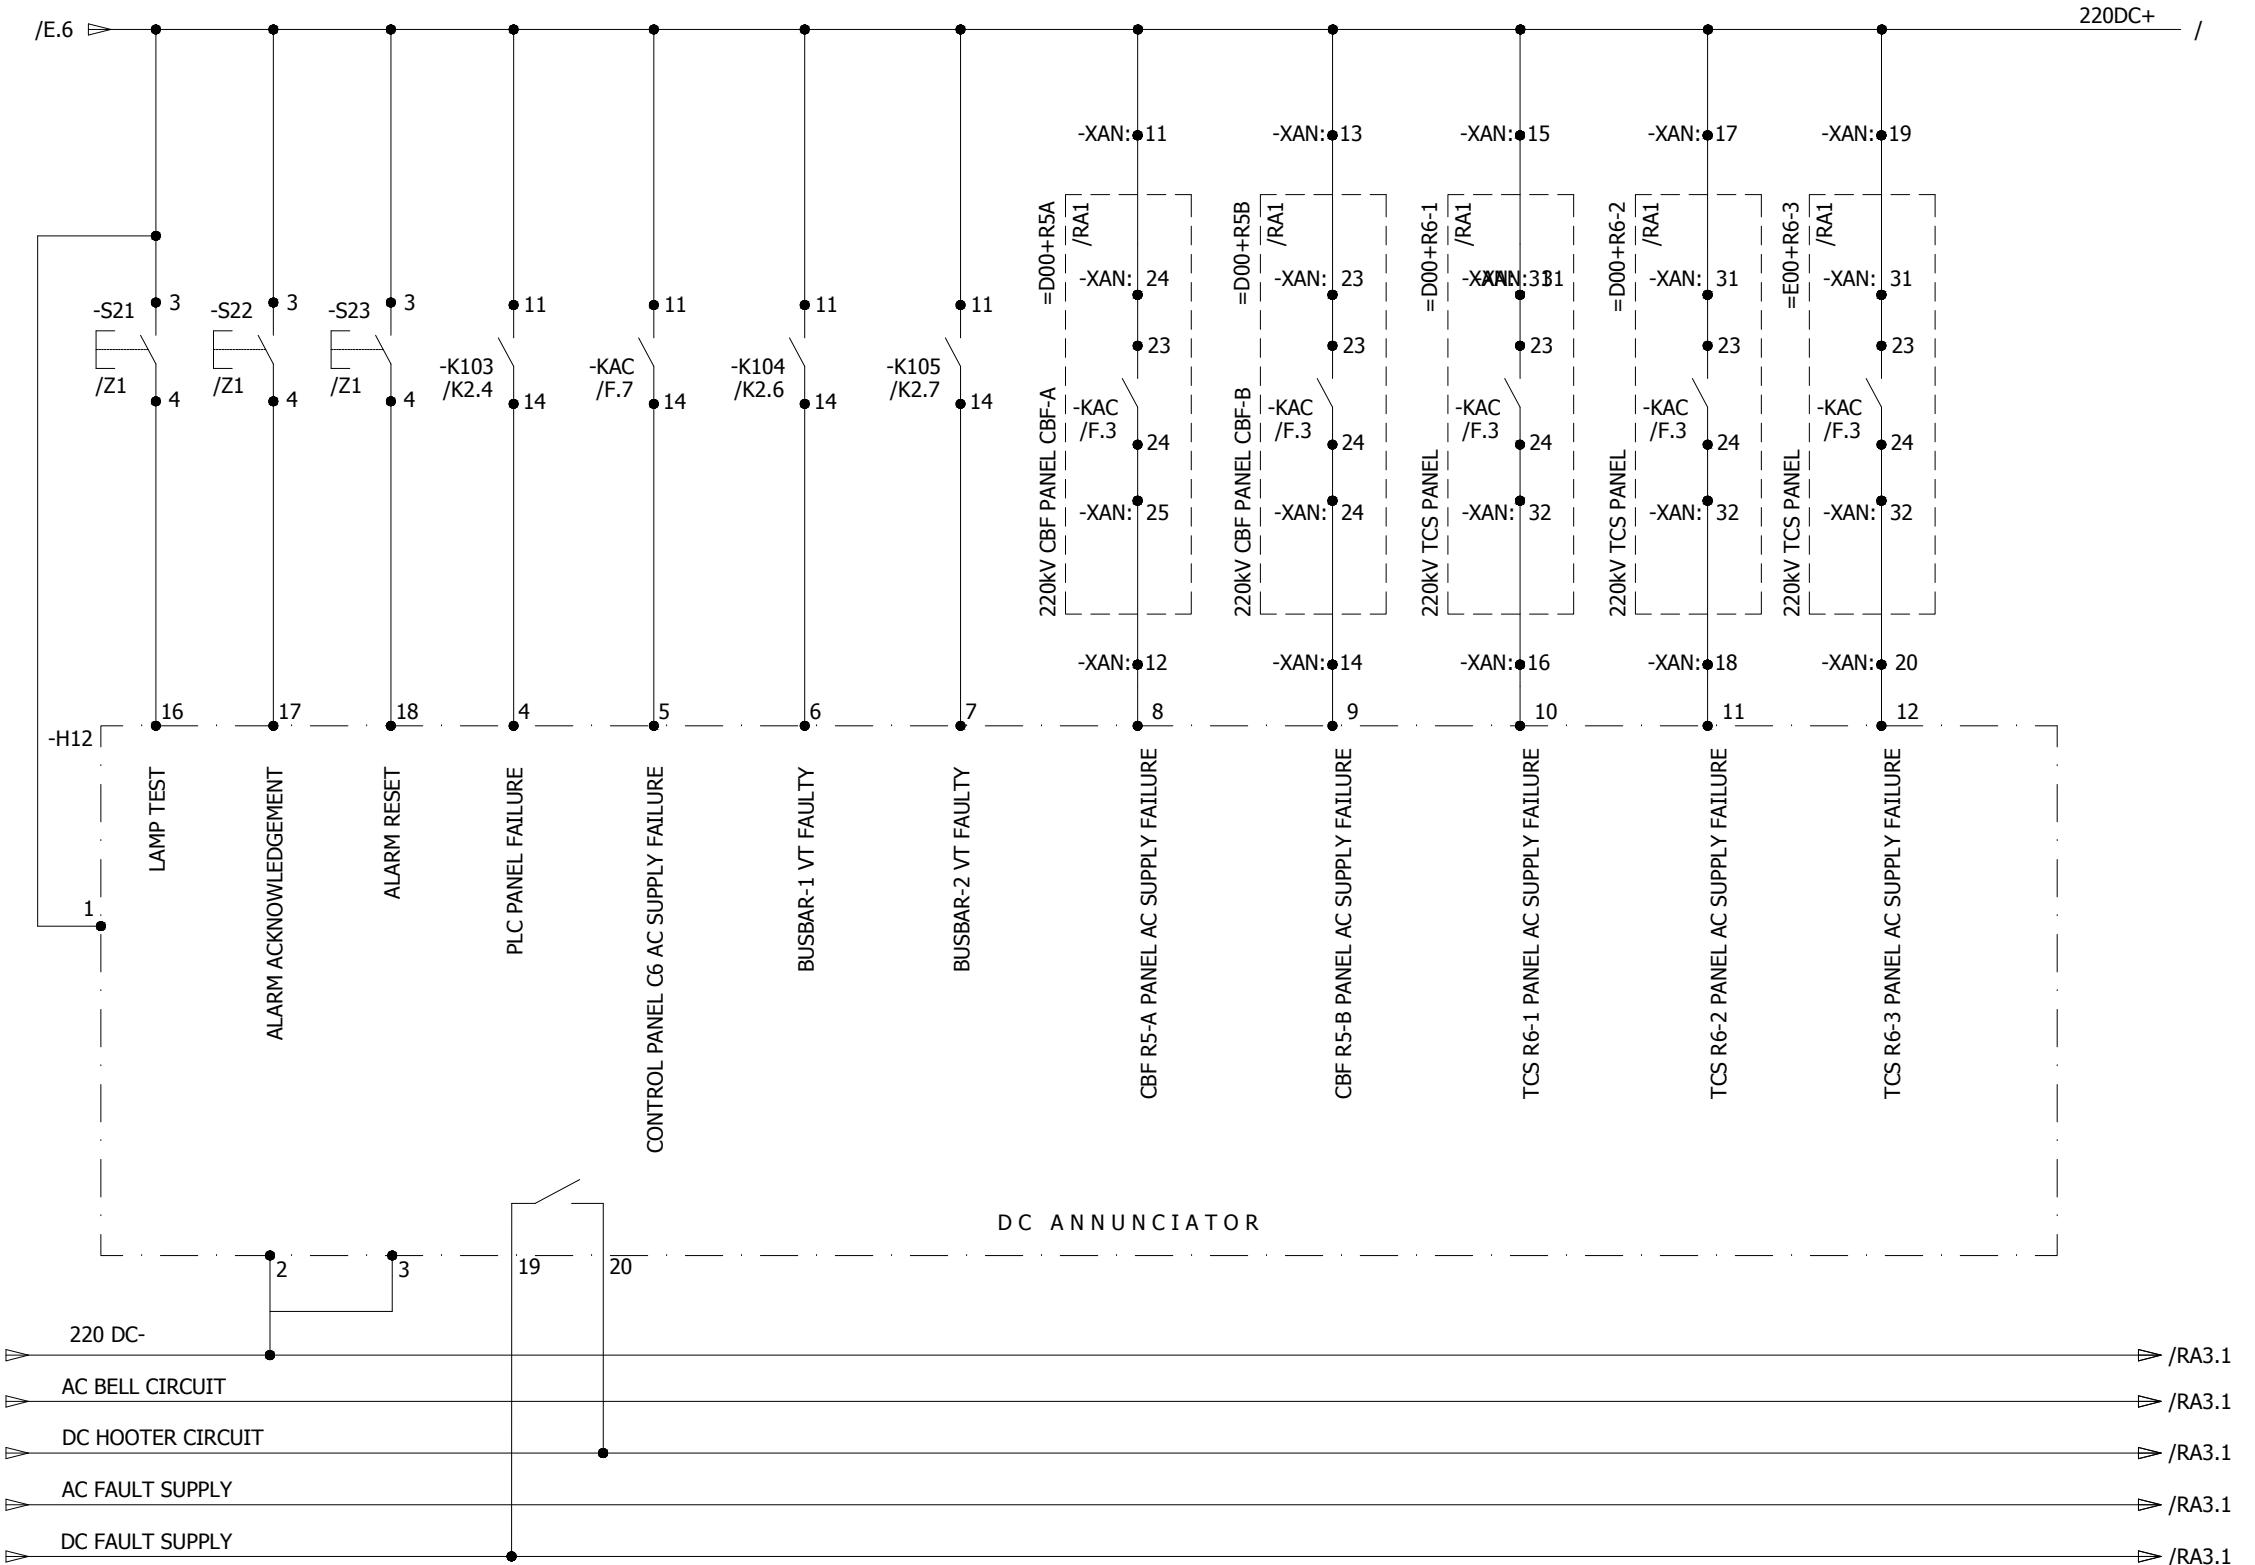

| 0 | AS BUILT | 18.08.2018 | MSC | Manufacturer  EPESOL 71-B Garden Block, New Garden Town, Lahore, Pakistan | Contractor  Grid Solutions A GE and Alstom joint venture | Client  NATIONAL TRANSMISSION & DISPATCH COMPANY LIMITED (NTDC-WAPDA) | Project 220kV/132kV GIS SUBSTATION GAZI ROAD, LAHORE | Title 220kV SYNCHRONIZING PANEL (=D00+C6) DC ANNOUNCEMENTS | Drawing no. P60194-E-DSC-SC-001 | | |
|------|-------------|------------|--------|------------------------------------------------------------------------------------------------------------------------------------------------------------------------------|-----------------------------------------------------------------------------------------------------------------------------------------------------|---------------------------------------------------------------------------------------------------------------------------------------------------------------------|------------------------------------------------------------|---------------------------------------------------------------------|------------------------------------|-------------------|-----------------|
| REV. | DESCRIPTION | DATE | DRAWER | | | | | | Project no. P-60194 | Sheet type RA2 | Sheet no. 25 |

| | | | | | | | | | | |
|-------------------------------------------------------------------------------------------------------------------------------------------------------------------------------------------|--------------------------------------------------------------------------------------------------------|------------------------------------------------------------------------------|-----------|--------------------------------------------------------------------------------------------------------------------------------------------------------------------------|-----------------------------------------------------------------------------------------------------------------------------------------------------|---------------------------------------------------------------------------------------------------------------------------------------------------------------------|------------------------------------------------------------|---------------------------------------------------------------------|------------------------------------|-----------------|
| All information contained in this document is the exclusive property of GE GRID SOLUTIONS and shall not be used, copied or communicated to third parties without its prior authorization. | AC BELL | | DC HOOTER | | 220kV LINE CONTROL PANEL | | | | | |
| | -B1 | | -H1 | | =D01+C4 | | | | | |
| | | | | | /RA1 | | | | | |
| B | | | C | D | E | F | | | | |
| C | -XF: 5 AC BELL CIRCUIT -XF: 7 DC Hooter CIRCUIT -XF: 1 AC FAULT SUPPLY -XF: 3 DC FAULT SUPPLY | -XF: 6 -XF: 8 -XF: 2 -XF: 4 -XF: 5 -XF: 7 -XF: 1 -XF: 3 | F | | | | | | | |
| 0 | AS BUILT | 18.08.2018 | MSC | Manufacturer  EPESOL 71-B Garden Block, New Garden Town, Lahore, Pakistan | Contractor  Grid Solutions A GE and Alstom joint venture | Client  NATIONAL TRANSMISSION & DISPATCH COMPANY LIMITED (NTDC-WAPDA) | Project 220kV/132kV GIS SUBSTATION GAZI ROAD, LAHORE | Title 220kV SYNCHRONIZING PANEL (=D00+C6) AC ANNOUNCEMENTS | Drawing no. P60194-E-DSC-SC-001 | |
| REV. | DESCRIPTION | DATE | DRAWER | | | | | Project no. P-60194 | Sheet type RA2-1 | Sheet no. 26 |
| 1 | 2 | 3 | 4 | 5 | 6 | 7 | 8 | | | |

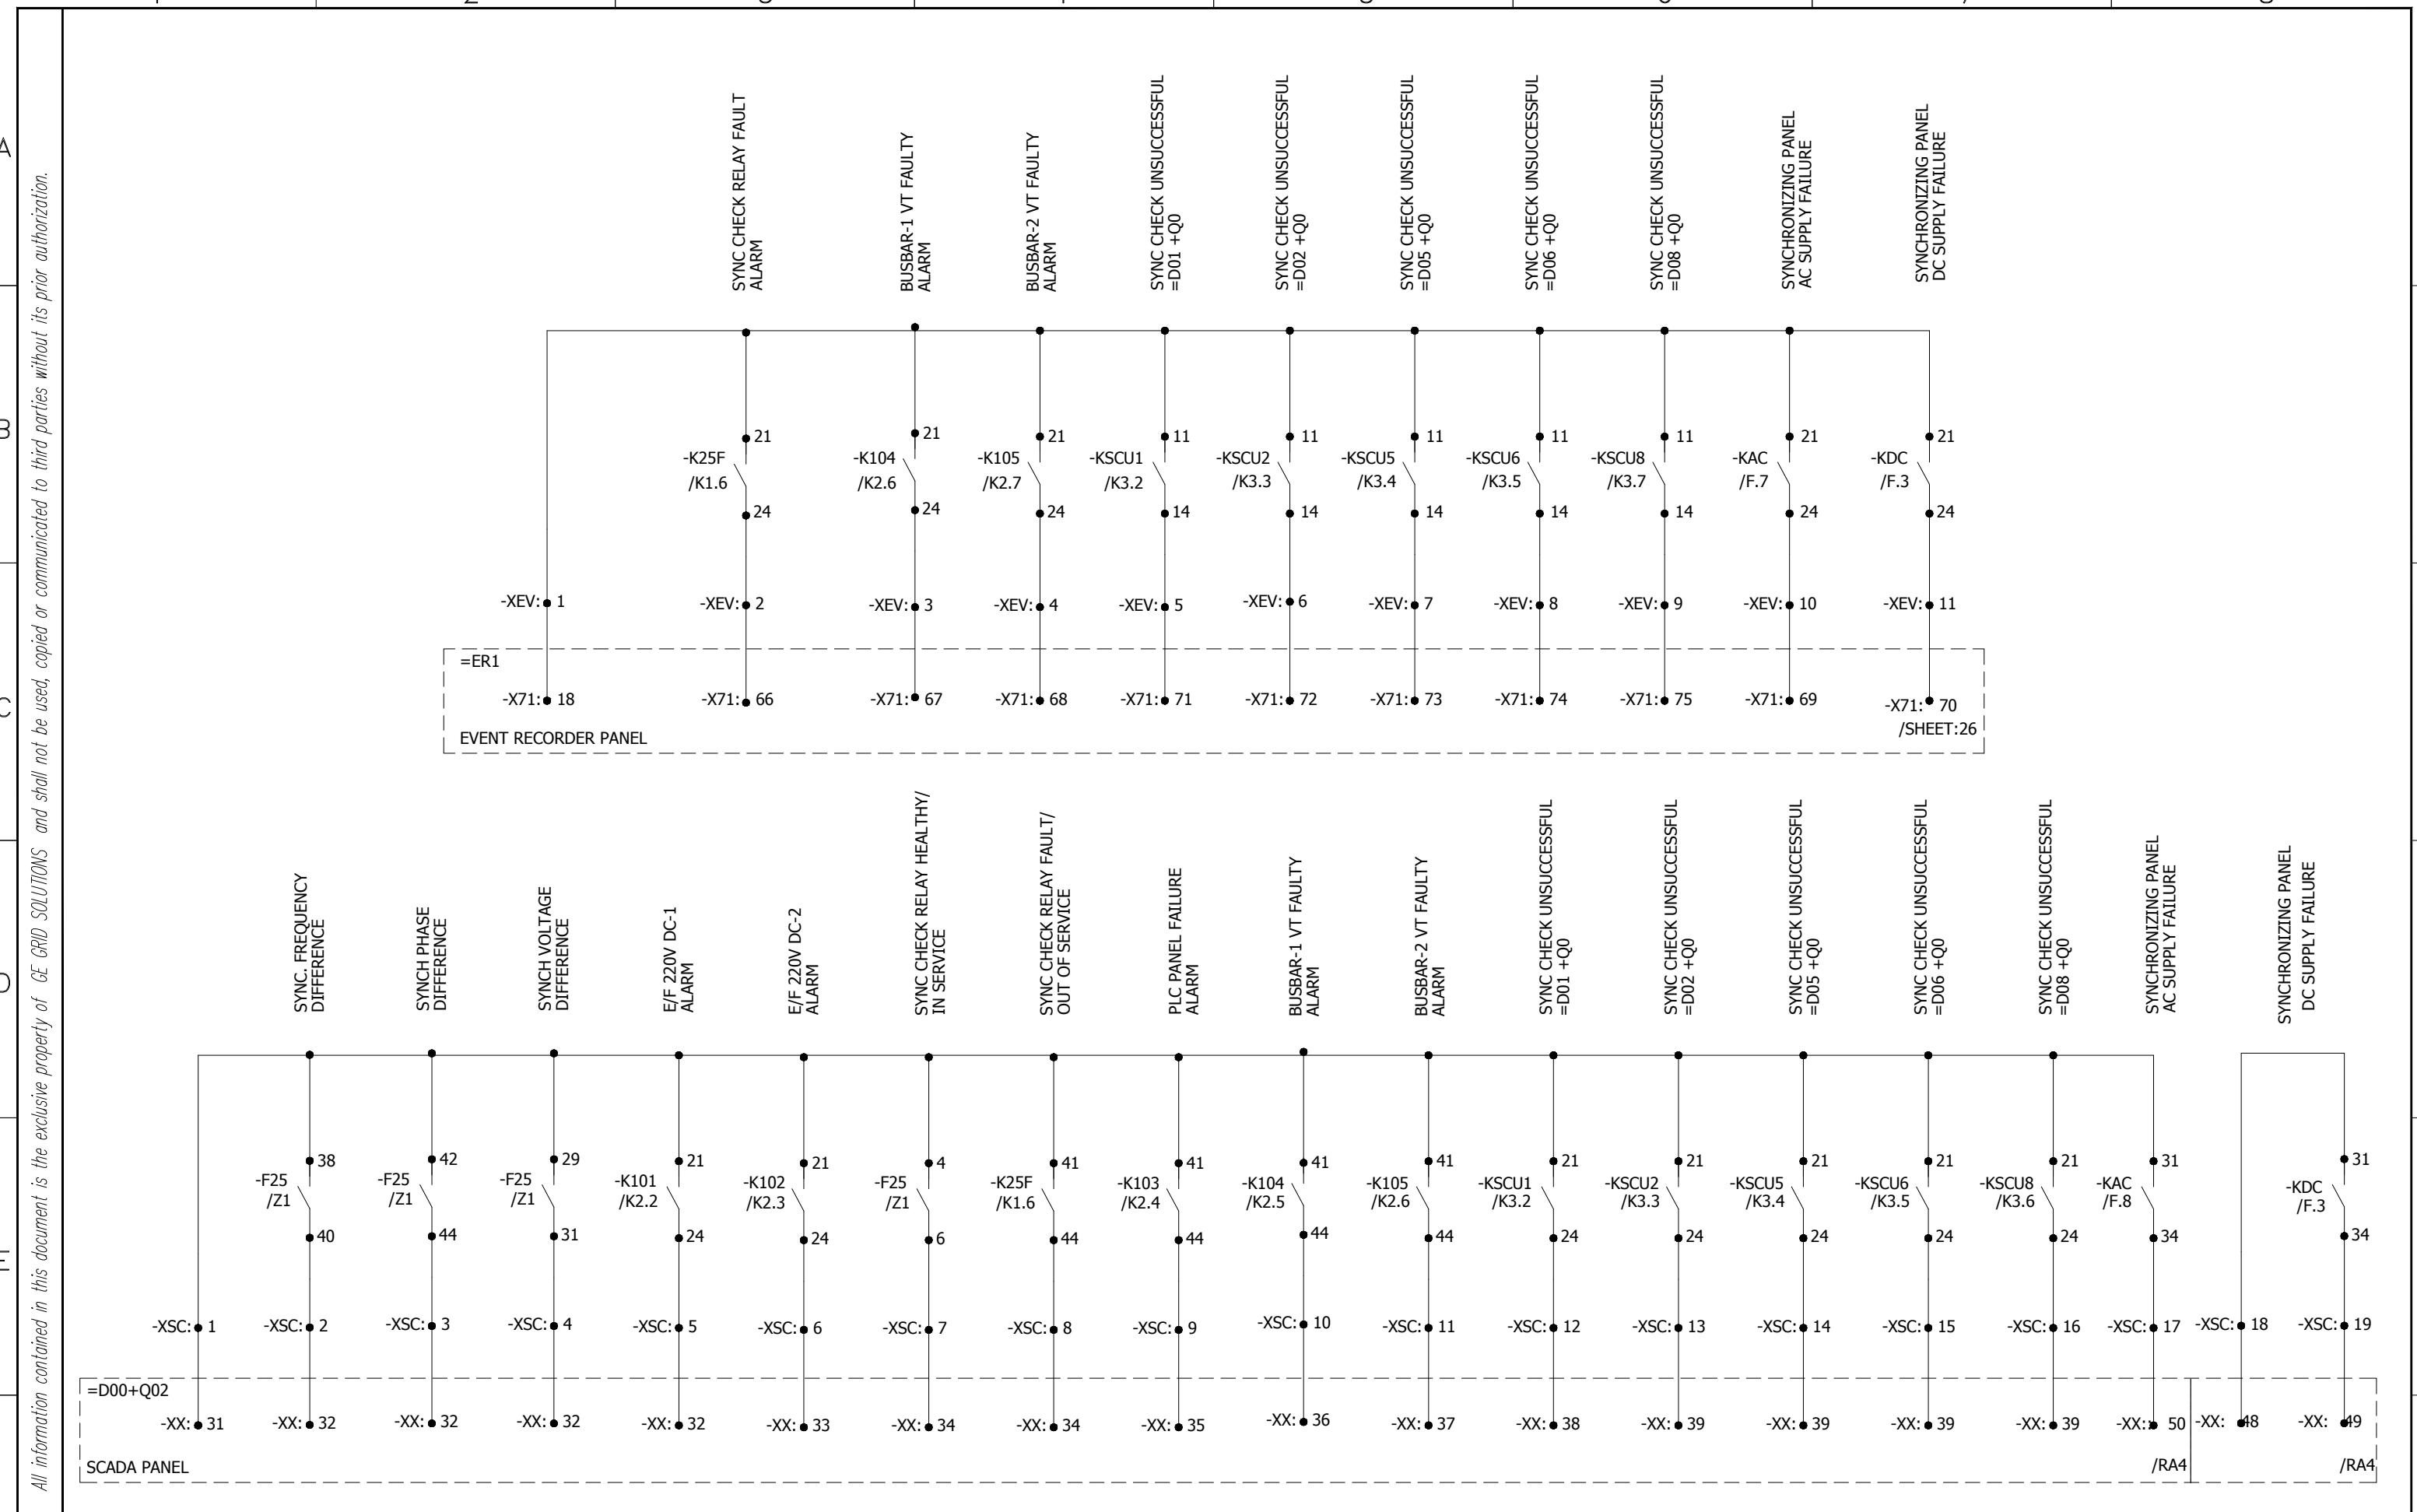

| | | | | | | | | | |
|------|-------------|------------|--------|---------------------------------------------------------------------------------------------|-------------------------------------------------------------------------|-------------------------------------------------------------------------|------------------------------------------------------------|------------------------------------------------------------------|------------------------------------|
| 0 | AS BUILT | 18.08.2018 | MSC | Manufacturer EPESOL 75-B Garden Block, New Garden Town, Lahore, Pakistan | Contractor GE Grid Solutions A GE and Alstom joint venture | Client NATIONAL TRANSMISSION & DISPATCH COMPANY LIMITED (NTDC-WAPDA) | Project 220kV/132kV GIS SUBSTATION GAZI ROAD, LAHORE | Title 220kV SYNCHRONIZING PANEL (=D00+C6) SCADA CIRCUIT | Drawing no. P60194-E-DSC-SC-001 |
| REV. | DESCRIPTION | DATE | DRAWER | | | | | | Project no. P-60194 |
| | | | | | | | | | Sheet type RA3 |

All information contained in this document is the exclusive property of GE GRID SOLUTIONS and shall not be used, copied or communicated to third parties without its prior authorization.

A

B

C

D

E

F

A


B

C

D

E


F

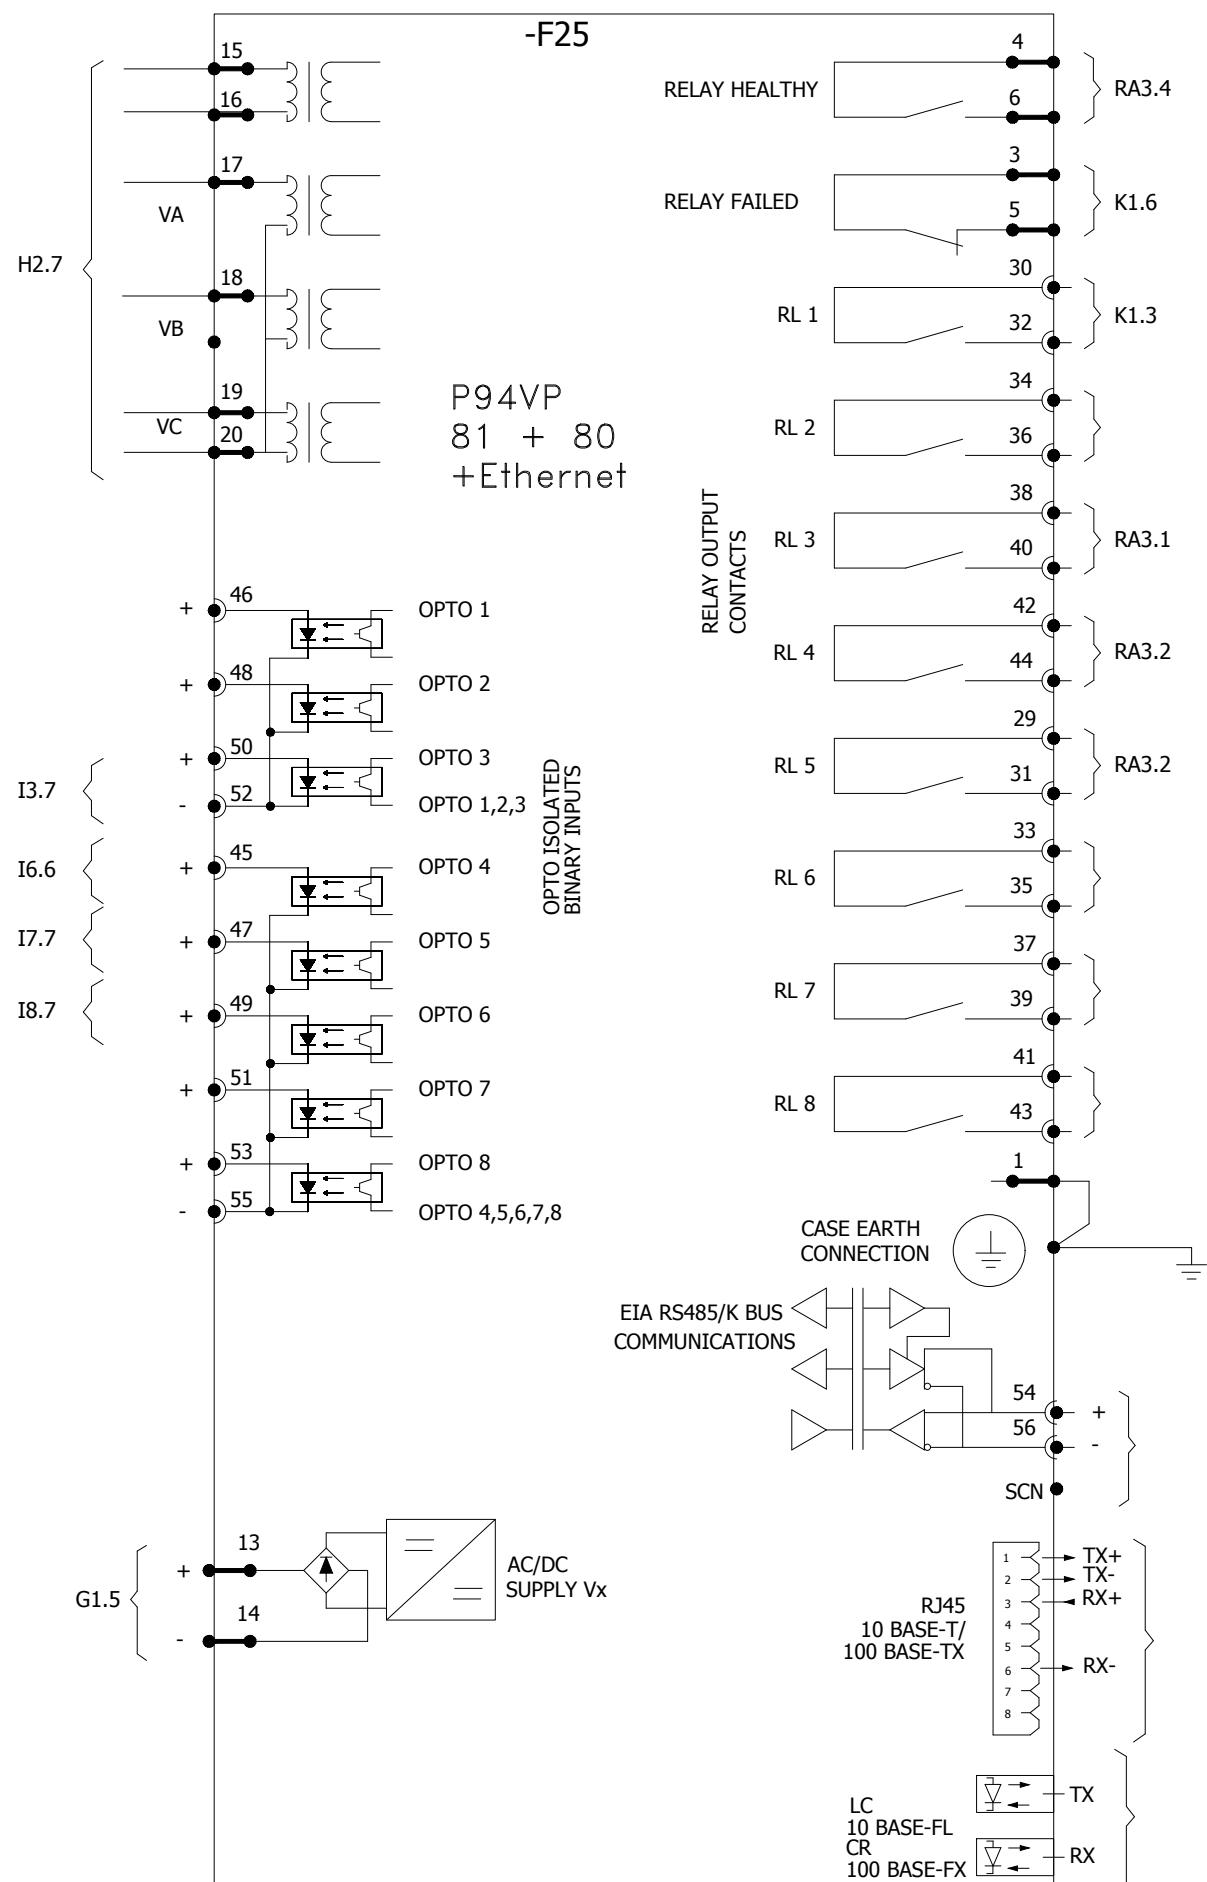

| 0 | AS BUILT | 18.08.2018 | MSC | Manufacturer EPESOL 71-B Garden Block, New Garden Town, Lahore, Pakistan | Contractor GE Grid Solutions A GE and Alstom joint venture | Client NATIONAL TRANSMISSION & DISPATCH COMPANY LIMITED (NTDC-WAPDA) | Project 220kV/132kV GIS SUBSTATION GAZI ROAD, LAHORE | Title 220kV SYNCHRONIZING PANEL (=D00+C6) COMPONENT DIAGRAM | Drawing no. P60194-E-DSC-SC-001 |
|------|-------------|------------|--------|---------------------------------------------------------------------------------------------|----------------------------------------------------------------------------|-------------------------------------------------------------------------|------------------------------------------------------------|----------------------------------------------------------------------|------------------------------------|
| REV. | DESCRIPTION | DATE | DRAWER | | | | | Project no. P-60194 | Sheet type Z1 |
| 1 | | 2 | | | | | | Sheet no. 28 | |

All information contained in this document is the exclusive property of GE GRID SOLUTIONS and shall not be used, copied or communicated to third parties without its prior authorization.


A

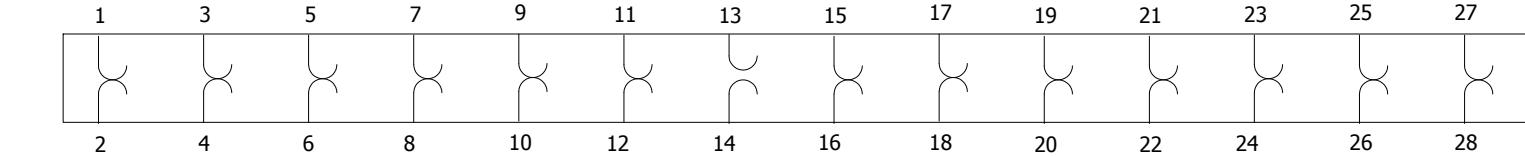


B

| | | | | | | |
|-------|------|------|------|------|------|------|
| -XT25 | H2.5 | H2.5 | G1.5 | K1.3 | K1.6 | K3.4 |
|-------|------|------|------|------|------|------|

C

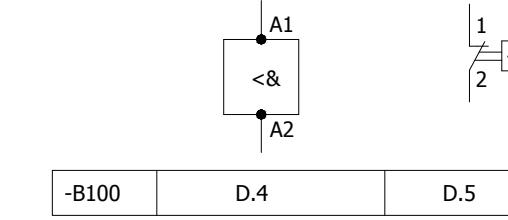


| | | |
|-------|-----|-----|
| -B100 | D.4 | D.5 |
|-------|-----|-----|

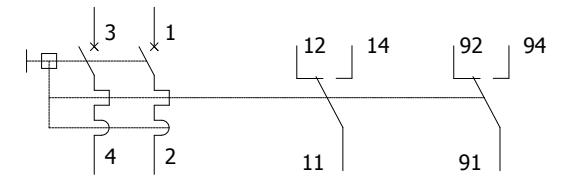


| | | | |
|-------|-----|-----|--|
| -F101 | D.2 | F.6 | |
| -F102 | D.4 | F.6 | |
| -F103 | D.6 | F.6 | |
| -F104 | D.6 | F.2 | |
| -F201 | E.3 | F.2 | |
| -F202 | E.4 | F.2 | |
| -F203 | E.3 | F.3 | |

D

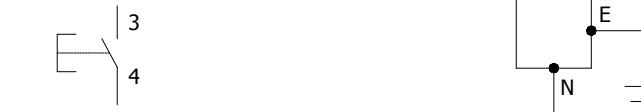

| | | | |
|------|----|-------|-----|
| -S6D | O1 | -X100 | D.7 |
|------|----|-------|-----|

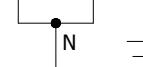

| | | | |
|-------|-----|-----|--|
| -F101 | D.2 | F.6 | |
| -F102 | D.4 | F.6 | |
| -F103 | D.6 | F.6 | |
| -F104 | D.6 | F.2 | |
| -F201 | E.3 | F.2 | |
| -F202 | E.4 | F.2 | |
| -F203 | E.3 | F.3 | |

E

21

22

| | |
|-------|-----|
| -S100 | D.3 |
|-------|-----|



| | |
|-------|-----|
| -H100 | D.3 |
| -H200 | F.4 |

| | | | | | | | | | |
|------|-------------|------------|--------|----------------------------------------------------------------------------------------------------------------------------------------------------------------------------|--------------------------------------------------------------------------------------------------------------------------------------------------------|------------------------------------------------------------------------------------------------------------------------------------------------------------------------|-------------------------------------------------------------|----------------------------------------------------------------------|------------------------------------|
| 0 | AS BUILT | 18.08.2018 | MSC | Manufacturer  EPESOL 7-B Garden Block, New Garden Town, Lahore, Pakistan | Contractor  Grid Solutions A GE and Alstom joint venture | Client  NATIONAL TRANSMISSION & DISPATCH COMPANY LIMITED (NTDC-WAPDA) | Project 220kV/132kV GIS SUBSTATION GHAZI ROAD, LAHORE | Title 220kV SYNCHRONIZING PANEL (=D00+C6) COMPONENT DIAGRAM | Drawing no. P60194-E-DSC-SC-001 |
| REV. | DESCRIPTION | DATE | DRAWER | | | | | | Project no. P-60194 |
| | | | | | | | | | Sheet type Z2 |

| |
|-----------------|
| Sheet no. 29 |
|-----------------|

F

1

2

3

4

5

6

7

8