



Grid Solutions
A GE and Alstom joint venture

220kV/132kV GIS SUBSTATION GHAZI ROAD , LAHORE

132kV LINE CONTROL PANEL SCHEMATIC DRAWINGS

DOC / DWG REVIEW CODE	
<input type="checkbox"/> A	Approved, Issue IFC.
<input type="checkbox"/> B	Approved with comments as noted, Issue IFC after incorporation of these comments.
<input type="checkbox"/> C	Revise and re-submit for approval.
<input type="checkbox"/> D	Rejected.
Signed	
Date	
Permission to proceed does not constitute acceptance of approval of design details, analysers, test methods or materials/ selected by the CONTRACTOR and does not relieve the CONTRACTOR from full compliance with AGREEMENT obligations.	

REFERENCE DRAWINGS					
SR. NO.	DRAWING TITLE			DOCUMENT NO.	
1.	220kV / 132kV Metering & Protection SLD			P60194-E-SLMP-001	
REVISION HISTORY					
REV	DATE	DRW. BY	CHK. BY	APR. BY	REVISION DESCRIPTION
0	19.10.2018	ASJ	MFT	NAH	AS BUILT
Scale NOT-TO-SCALE				Sheet size A3	
Client		 NATIONAL TRANSMISSION & DISPATCH COMPANY LIMITED (NTDC-WAPDA)			
Contractor		 Grid Solutions A GE and Alstom joint venture			
Manufacturer		 EPESOL 71-B Garden Block, New Garden Town, Lahore Pakistan			
Project 220kV / 132kV GIS SUBSTATION GHAZI ROAD , LAHORE					
Title 132kV LINE CONTROL PANEL (=E03+CP31) SCHEMATIC DRAWINGS					
Order no P-60194		Document no P60194-E-ELC-SC-002			
Sheet type A		Total sheets 27		Sheet no 1	

	1	2	3	4	5	6	7	8				
	PAGE NO.	SHEET NAME	SHEET DESCRIPTION			ISSUE / REVISION						
						A	B	C	D	E	F	01
A	01	A	COVER SHEET			X	X					
	02	AA	LIST OF CONTENTS			X	X					
	03	AB	SYMBOL AND LEGENDS			X	X					
	04	AC1	COMPONENT LIST			X	X					
	05	AC2	COMPONENT LIST			X	X					
B	06	AD	PANEL VIEW			X	X					
	07	AE	SINGLE LINE DIAGRAM			X	X					
	08	D	AC SUPPLY DISTRIBUTION CIRCUIT			X	X					
	09	E	DC SUPPLY DISTRIBUTION CIRCUIT			X	X					
	10	F	DC SUPPLY FAILURE ALARM CIRCUIT			X	X					
C	11	G	METERING			X	X					
	12	H1	CB CONTROL CIRCUIT			X	X					
	13	H2	CB CONTROL CIRCUIT			X	X					
	14	I1	DISCONNECTOR & EARTH SWITCH CONTROL			X	X					
	15	I2	DISCONNECTOR & EARTH SWITCH CONTROL			X	X					
	16	K1	DISCONNECTOR CONTACT MULTIPLICATION			X	X					
D	17	NA1	ALARM MULTIPLICATION			X	X					
	18	NA2	DISCREPANCY INITIATION			X	X					
	19	NA3	DISCREPANCY INITIATION			X	X					
	20	NA4	DISCREPANCY INITIATION			X	X					
	21	NA5	DISCREPANCY INDICATIONS			X	X					
	22	RA1	ANNUNCIATOR-1 CIRCUIT			X	X					
	23	RA2	ANNUNCIATOR-2 CIRCUIT			X	X					
	24	RA3	ANNUNCIATOR-3 CIRCUIT			X	X					
	25	RA4	ANNUNCIATOR-4 CIRCUIT			X	X					
	26	RA5	SCADA & ER SIGNALS			X	X					
E	27	Z1	COMPONENT DIAGRAM			X	X					
F	0	AS BUILT	19.10.2018	ASJ	Manufacturer  EPESOL 7-B Garden Block, New Garden Town, Lahore, Pakistan	Contractor  Grid Solutions A GE and Alstom joint venture	Client  NATIONAL TRANSMISSION & DISPATCH COMPANY LIMITED (NTDC-WAPDA)	Project 220KV/132KV GIS SUBSTATION GHAZI ROAD, LAHORE	Title 132KV LINE CONTROL PANEL (=E03+CP31) LIST OF CONTANTS	Drawing no. P60194-E-ELC-SC-002		
	REV.	DESCRIPTION	DATE	DRAWER						Project no. P-60194	Sheet type AA	Sheet no. 02

	SYMBOL	DESCRIPTION	SYMBOL	DESCRIPTION	SYMBOL	DESCRIPTION	SYMBOL	DESCRIPTION
A		CIRCUIT BREAKER		MINIATURE CIRCUIT BREAKER		AUXILIARY CONTACTOR NO+NC	21	DISTANCE
B		SWITCH/ISOLATOR		SELECTOR SWITCH		AMMETER	24	OVEREXCITATION
C		EARTHING		LIMITED SWITCH		VOLTMETER	25	SYCHROCHECK
D		GIS TERMINATION		HUMIDITY & TEMPERATURE CONTROLLER		POWER FACTOR METER	49	THERMAL OVERLOAD
E		SF6 TO AIR BUSHING		PANEL HEATER		DIGITAL PANEL METER	50/51	PHASE OVERCURRENT
F		LINE TRAP		THREE PIN SOCKET		ACTIVE POWER METER	50N/51N	EARTH FAULT
G		SURGE ARRESTOR		INDICATION LIGHT		REACTIVE POWER METER	50BF	CIRCUIT BREAKER FAILURE
H		CURRENT TRANSFORMER		PUSH BUTTON		ENERGY METER	64	RESTRICTED EARTH FAULT
I		COUPLING CAPACITOR VOLTAGE TRANSFORMER		AUXILIARY CONTACTOR COIL			67N	DIRECTIONAL EARTH FAULT
J		POWER TRANSFORMER		POWER SUPPLY AC/DC			68	POWER SWING BLOCKING
K		AUTO TRANSFORMER		TERMINAL			78	OUT OF STEP
L				OPTO CONTACTS			79	AUTO-RECLOSING
M				RELAY CONTACTS			85	COMMUNICATION FAILURE
N				HOOTER			87T	TRAFO DIFFERENTIAL
O				AC BELL			87C	LOW IMPEDANCE DIFFERENTIAL CONNECTION
P							87BB	LOW IMPEDANCE DIFFERENTIAL BUSBAR

All information contained in this document is the exclusive property of GE GRID SOLUTIONS and shall not be used, copied or communicated to third parties without its prior authorization.




0	AS BUILT	19.10.2018	ASJ	Manufacturer EPE SOL 71-B Garden Block, New Garden Town, Lahore, Pakistan	Contractor Grid Solutions A GE and Alstom joint venture	Client NATIONAL TRANSMISSION & DISPATCH COMPANY LIMITED (NTDC-WAPDA)	Project 220kV/132kV GIS SUBSTATION GHAZI ROAD, LAHORE	Title 132kV LINE CONTROL PANEL (=E03+CP31) SYMBOL AND LEGENDS	Drawing no. P60194-E-ELC-SC-002
REV.	DESCRIPTION	DATE	DRAWER						Project no. P-60194
									Sheet type AB
									Sheet no. 03

	1	2	3	4	5	6	7	8		
	QTY.	DEVICE DESCRIPTION	DEVICE SPECIFICATIONS DEVICE TYPE ; TECHNICAL DATA / SPECIFICATIONS			DEVICE DESIGNITION	MANUFACTURER			
A	01	MWH+MVARH METER	THREE PHASE FOUR WIRE STATIC ENERGY METER, CLASS 0.2, PT RATIO: 132/0.11 KV (L-L), CT RATIO 400:800:1600/1A , MODEL: MT860S-A22R36S33-E12-L21-M3K03-Z7			-P11	ISKRAEMECO			
	02	ANALOG AMMETER	METER: TRANSDUCER OPERATED DIGITAL AMPERE METER, INPUT 0...20/30 mA, ACCURACY CLASS 1, SCALE_1: 0...400/600A, SCALE_2: 0...800/1200A, SCALE_3: 0...1600/2400A. , AUX. VOLTAGE 110 VDC.			-Q1 , -Q3	FRER			
B	02	CURRENT TRANSDUCER	CURRENT TRANSDUCER: 1-INPUT, 2-OUTPUT, NOMINAL INPUT CURRENT 1/1.5A, OUTPUT1: 0...20/30mA, OUTPUT2: 0...20/30mA, AUXILIARY VOLTAGE 110 VDC, ACCURACY CLASS 1, CT RATIO 400:800:1600/1A ORD: A96MMA + MCOEAQ			-U1, -U3	FRER			
	01	DIGITAL AMMETER	METER: TRANSDUCER OPERATED DIGITAL AMPERE METER, INPUT 0...20/30 mA, ACCURACY CLASS 1, SCALE_1: 0...400/600A, SCALE_2: 0...800/1200A, SCALE_3: 0...1600/2400A. , AUX. VOLTAGE 110 VDC.			-Q2	FRER			
C	02	CURRENT TRANSDUCER	CURRENT TRANSDUCER: 1-INPUT, 2-OUTPUT, NOMINAL INPUT CURRENT 1/1.5A, OUTPUT1: 0...20/30mA, OUTPUT2: 0...20/30mA, AUXILIARY VOLTAGE 110 VDC, ACCURACY CLASS 1, CT RATIO 400:800:1600/1A ORD: D96MMA + MCOEAQ			-U2, -U12	FRER			
	01	ANALOG REAL POWER (MW) METER	METER: 240 DEGREE TRANSDUCER OPERATED ANALOGUE MW METER, INPUT -12.5/10...0...+10/12.5 mA, ACCURACY CLASS 1, SCALE_1: 125/100-0-100/125 MW (91.5 MW at 20mA), SCALE_2: 250/200-0-200/250 MW (183 MW at 20mA), SCALE_3: 500/400-0-400/500 MW (366 MW at 20mA).			-Q5	FRER			
D	01	ANALOG REACTIVE POWER (MVAR) METER	METER: 240 DEGREE TRANSDUCER OPERATED ANALOGUE MVAR METER, INPUT -12.5/10...0...+10/12.5 mA, ACCURACY CLASS 1, SCALE_1: 125/100-0-100/125 MVAR (91.5 MVAR at 20mA), SCALE_2: 250/200-0-200/250 MVAR (183 MVAR at 20mA), SCALE_3: 500/400-0-400/500 MVAR (366 MVAR at 20mA).			-Q6	FRER			
	01	PROGRAMMABLE UNIVERSAL TRANSDUCER (for MW and MVAR meters)	TRANSDUCER: 3-PHASE, 4-WIRE BALANCED LOAD, 4 PROGRAMMABLE DC mA OUTPUTS. NOMINAL INPUT VOLTAGE 110/137.5 VAC(L-L), NOMINAL INPUT CURRENT 1/1.25A, AUXILIARY VOLTAGE 110 VDC, ACCURACY CLASS 1, OUTPUT1 to OUTPUT4: -12.5/10...0...+10/12.5 mA, PT RATIO: 132/0.11 KV (L-L), CT RATIO 400:800:1600/1A. ORD: MCOP4			-U5	FRER			
E	01	DIGITAL POWER METER	THREE PHASE DIGITAL POWER METER, ACCURACY CLASS 0.5s, INPUT NOMINAL CURRENT, 1/5A, INPUT NOMINAL VOLTAGE 110 VAC (L-L), AUXILIARY VOLTAGE 110-375 VDC.			-Q7	ENERDIS			
	03	ANNUNCIATOR	TWELVE WINDOW ANNUNCIATOR, RATED VOLTAGE 110 VDC, ORD: AM-101			-H101, -H102, -H103	ELABS			
F	01	ANNUNCIATOR	TWELVE WINDOW ANNUNCIATOR, RATED VOLTAGE 240 VAC, ORD: AM-101			-H106	ELABS			
	01	PUSH BUTTON - LAMP TEST	TYPE: SWITCH (A TYPE:), COLOR : BLACK , SUPPLY : 120VDC, Ord: YS-AP1-2-31-B-D-W			-S21	YONGSUNG			
F	01	PUSH BUTTON - ALARM ACKNOWLEDGMENT	TYPE: SWITCH (A TYPE:), COLOR : RED , SUPPLY : 120VDC, Ord: YS-AP1-2-31-R-D-W			-S22	YONGSUNG			
	0	AS BUILT	19-10-2018	ASJ	Manufacturer  EPESOL 71-B Garden Block, New Garden Town, Lahore, Pakistan	Contractor  GE and Alstom joint venture	Client  NATIONAL TRANSMISSION & DISPATCH COMPANY LIMITED (NTDC-WAPDA)	Project 220KV/132KV GIS SUBSTATION GHAZI ROAD, LAHORE	Title 132KV LINE CONTROL PANEL (=E03+CP31) COMPONENT LIST	Drawing no. P60194-E-ELC-SC-002
	REV.	DESCRIPTION	DATE	DRAWER				Project no. P-60194	Sheet type AC1	Sheet no. 04

	1	2	3	4	5	6	7	8	
	QTY.	DEVICE DESCRIPTION	DEVICE SPECIFICATIONS DEVICE TYPE ; TECHNICAL DATA / SPECIFICATIONS			DEVICE DESIGNITION	MANUFACTURER		
A	01	PUSH BUTTON - ALARM RESET	TYPE: SWITCH(A TYPE:), COLOR : GREEN , SUPPLY : 120VDC, Ord: YS-AP1-2-31-G-D-W			-S23	YONGSUNG		
	01	SELECTOR SWITCH - OPERATION (LOCAL-OFF-SCADA)	3-POSITION (STATION-OFF-SCADA), 110VDC, KEYLOCKABLE TYPE, ORD: YS-AK-2-3-44-D			-S101	YONGSUNG		
	63	AUXILIARY CONTACTOR	COIL VOLTAGE: 110VDC, 4 C/O CONTACTS, ORD: PRC4M40DCJL			-K0E, -K50, -K0A, -KDC-1, -K1, -K2, -K9, -K0, -K11 TO -K21, -K24 TO -K33, -K35 TO -K37, -K42 TO -K46, -K59 -K0OFF, -K0ON, -K0D, -K1OFF, -K1ON, -K1D, -K2OFF, -K2ON, -K2D, -K9OFF, -K9ON, -K9D, -K51OFF, -K51ON, -K51D, -K53OFF, -K53ON, -K53D, -K8OFF, -K8ON, -K8D, -KDC-2, -KS21, -K111, -K222	GE		
B	01	AUXILIARY CONTACTOR - SUPPLY CHANGEOVER	COIL VOLTAGE: 110VDC, 3 NO + 3 NC CONTACTS, ORD: MCRC022ATWJ-B+MARN211AT			-KDC	GE		
	03	AUXILIARY CONTACTOR	COIL VOLTAGE:: 240VAC, 4 C/O CONTACTS, ORD: PRC4M40ANL			-KAMC, -K7, -K8	GE		
	01	CONTROL DISCREPANCY SWITCH - CIRCUIT BREAKER	CONTROL AND DISCREPANCY SWITCH FOR ISOLATOR CONTROL AND INDICATION, SQUARE TYPE FOUR CONTACTS FOR COMMAND AND FOUR CONTACTS FOR INDICATION			-S0	YONGSUNG		
C	06	CONTROL DISCREPANCY SWITCH - ISOLATORS & EARTHING SW.	CONTROL AND DISCREPANCY SWITCH FOR ISOLATOR CONTROL AND INDICATION, ROUND TYPE FOUR CONTACTS FOR COMMAND AND FOUR CONTACTS FOR INDICATION ORD:YS-IC-4456-R4(49)-PM-K-G-D11-G			-S1, -S2, -S9, -S51, -S53, -S8	YONGSUNG		
	01	FLASHER RELAY	FLASHER RELAY, COIL VOLTAGE 110 VDC, ORD: FR-101-110			-K51	ELABS		
	02	TEST BLOCK	YS-CTT-04-S, YS-PTT-04-S			-XTB1, -XTB2	YONGSUNG		
D	02	INDICATION LIGHT - AC AND DC SUPPLY	TYPE: LED , COLOR : RED , SUPPLY : 240VAC ORD: YS-PL-2-AL-22-R-W			-H7, -H8	YONGSUNG		
	01	OPERATION COUNTER	OPERATION COUNTER FOR CIRCUIT BREAKER, RATED VOLTAGE 110VDC			-Q10	ELABS		
	02	CONTROL MCB - PANEL LIGHT & HEATER	2-Pole, Ratings: 2A, 240VAC, 6kA @ 240VAC, 2 C/O Contacts, Ord: G62C02+CAH(2)			-F101, -F102	GE		
E	01	CONTROL ELCB - PANEL SOCKET	2-Pole, Ratings: 16A, 30mA, 240VAC, 1P+N, 2 C/O Contacts, Ord: DM100C16/030+CAH(2)			-F103	GE		
	02	CONTROL MCB - DC DISTRIBUTION	2-Pole, Ratings: 4A, 250VDC, 10kA @ 250VDC, 2 C/O Contacts, Ord: EP102UCC04+CAH(2)			-F201,-F202	GE		
	01	PANEL LIGHT	230VAC @ 50Hz, 05W, Ord: YS-T8-30-5W			-H100	YONGSUNG		
F	01	DOOR SWITCH	230VAC @ 50Hz, 1 NO Contact, Ord: YS P3315GW-B + YS MS-C			-S100	YONGSUNG		
	01	THREE PIN SOCKET	1N+PE, 16A, 230VAC @ 50Hz			-X100	LOCAL		
	0	AS BUILT	19-10-2018	ASJ	Manufacturer  EPESOL 71-B Garden Block, New Garden Town, Lahore, Pakistan	Contractor  GE and Alstom joint venture	Client  NATIONAL TRANSMISSION & DISPATCH COMPANY LIMITED (NTDC-WAPDA)	Project 220KV/132KV GIS SUBSTATION GHAZI ROAD, LAHORE	Title 132KV LINE CONTROL PANEL (=E03+CP31) COMPONENT LIST
REV.	DESCRIPTION		DATE	DRAWER					

	1	2	3	4	5	6	7	8			
	QTY.	DEVICE DESCRIPTION	DEVICE SPECIFICATIONS DEVICE TYPE ; TECHNICAL DATA / SPECIFICATIONS			DEVICE DESIGNITION	MANUFACTURER				
A	01	PANEL HEATER	240VAC @ 50Hz, 50W			-R100	E-LABS				
	01	HUMIDITY & TEMPERATURE CONTROLLER	40-90%RH, 25-50 deg.C, 240VAC @ 50Hz			-B100	E-LABS				
	04	TERMINAL BLOCKS FOR AC SUPPLY	TYPE: CBD-4			-XAC	CABUR				
	02	TERMINAL BLOCKS FOR DC SUPPLY1	TYPE: CBD-4			-XDC-1	CABUR				
	02	TERMINAL BLOCKS FOR DC SUPPLY2	TYPE: CBD-4			-XDC-2	CABUR				
	16	TERMINAL BLOCKS FOR METERING	TYPE: CBD-4			-X3	CABUR				
B	08	TERMINAL BLOCKS FOR CB CONTROL CIRCUIT	TYPE: CBD-4			-X4	CABUR				
	12	TERMINAL BLOCKS FOR CB CONTROL CIRCUIT	TYPE: CBD-4			-X5	CABUR				
	35	TERMINAL BLOCKS FOR DS+ES CONTACTOR MULTIPLICATION	TYPE: CBD-4			-X6	CABUR				
	08	TERMINAL BLOCKS FOR CB/DS CONTACTOR MULTIPLICATION	TYPE: CBD-4			-X7	CABUR				
	40	TERMINAL BLOCKS FOR AUXIALARY MULTIPLICATION	TYPE: CBD-4			-X8	CABUR				
	15	TERMINAL BLOCKS FOR DISCRIPANCY INITIATION	TYPE: CBD-4			-X9					
C	13	TERMINAL BLOCKS FOR ANNUNCIATOR-1	TYPE: CBD-4			-X11	CABUR				
	16	TERMINAL BLOCKS FOR ANNUNCIATOR-2	TYPE: CBD-4			-X12	CABUR				
	18	TERMINAL BLOCKS FOR ANNUNCIATOR-3	TYPE: CBD-4			-X13	CABUR				
	24	TERMINAL BLOCKS FOR ANNUNCIATOR-4	TYPE: CBD-4			-X14	CABUR				
	45	TERMINAL BLOCKS FOR EVENT RECORDER	TYPE: CBD-4			-XEV	CABUR				
	45	TERMINAL BLOCKS FOR SCADA	TYPE: CBD-4			-XSC	CABUR				
D	30	TERMINAL BLOCKS FOR TRANSDUCER TO SCADA	TYPE: CBD-4			-XSA	CABUR				
	30	TERMINAL BLOCKS FOR SCADA	TYPE: CBD-4			-XSP	CABUR				
	08	TERMINAL BLOCKS FOR BELL AND HOOTER	TYPE: CBD-4			-XF	CABUR				
	0	AS BUILT	19-10-2018	ASJ	Manufacturer  EPE SOL 21-B Garden Block, New Garden Town, Lahore, Pakistan	Contractor  GE Grid Solutions A GE and Alstom joint venture	Client  NATIONAL TRANSMISSION & DISPATCH COMPANY LIMITED (NTDC-WAPDA)	Project 220kV/132kV GIS SUBSTATION GHAZI ROAD, LAHORE	Title 132kV LINE CONTROL PANEL (=E03+CP31) COMPONENT LIST	Drawing no. P60194-E-ELC-SC-002	
	REV.	DESCRIPTION	DATE	DRAWER					Project no. P-60194	Sheet type AC3	Sheet no. 05a
	1	2	3	4	5	6	7	8			


	1	2	3	4	5	6	7	8		
	QTY.	DEVICE DESCRIPTION	DEVICE SPECIFICATIONS DEVICE TYPE ; TECHNICAL DATA / SPECIFICATIONS			DEVICE DESIGNITION	MANUFACTURER			
A	08	TERMINAL BLOCKS FOR METERING CT	TYPE: SCB-6			-X2		CABUR		
B	07	TERMINAL BLOCKS WITH DIODE TYPE IN-D4007, RATED MAXIMUM VOLTAGE 350VDC, RATED BREAK DOWN VOLTAGE 430VDC	TYPE: DAS.4/6			-XD		CABUR		
C										
D										
E										
F										
<i>All information contained in this document is the exclusive property of GE GRID SOLUTIONS and shall not be used, copied or communicated to third parties without its prior authorization.</i>										
0	AS BUILT	19-10-2018	ASJ	Manufacturer  EPE SOL 21-B Garden Block, New Garden Town, Lahore, Pakistan	Contractor  Grid Solutions A GE and Alstom joint venture	Client  NATIONAL TRANSMISSION & DISPATCH COMPANY LIMITED (NTDC-WAPDA)	Project 220KV/132KV GIS SUBSTATION GHAZI ROAD, LAHORE	Title 132KV LINE CONTROL PANEL (=E03+CP31) COMPONENT LIST	Drawing no. P60194-E-ELC-SC-002	
REV.	DESCRIPTION	DATE	DRAWER					Project no. P-60194	Sheet type AC3	Sheet no. 05b

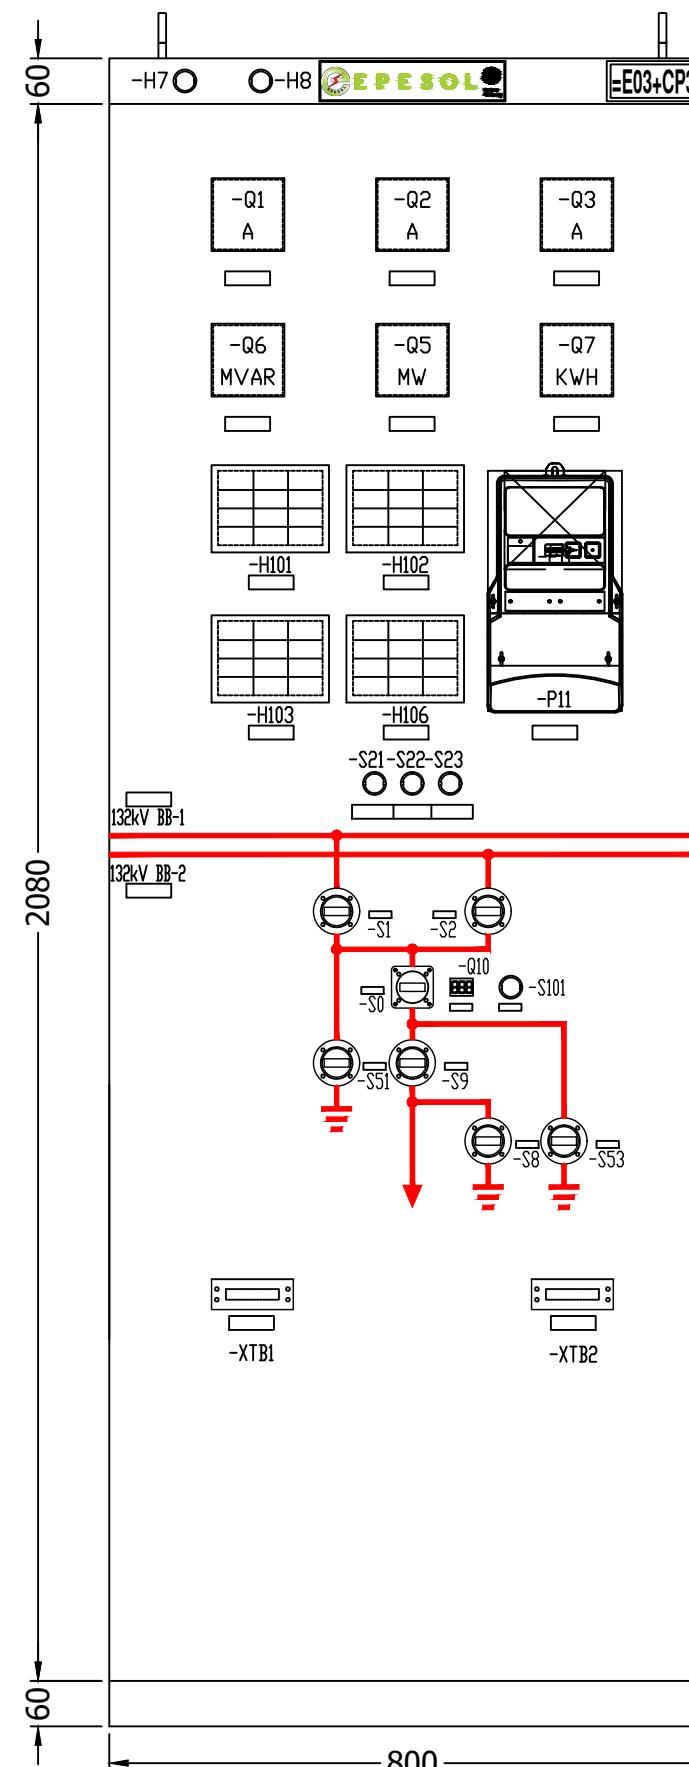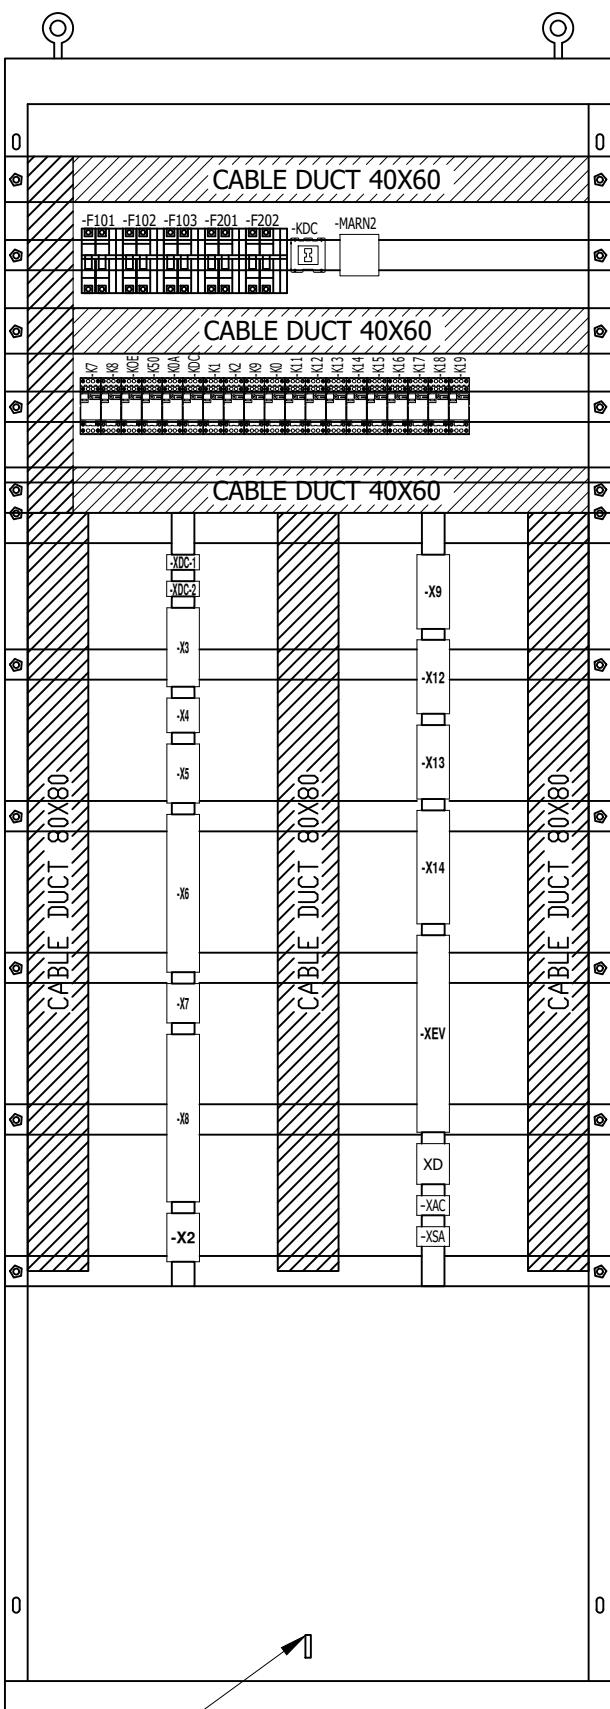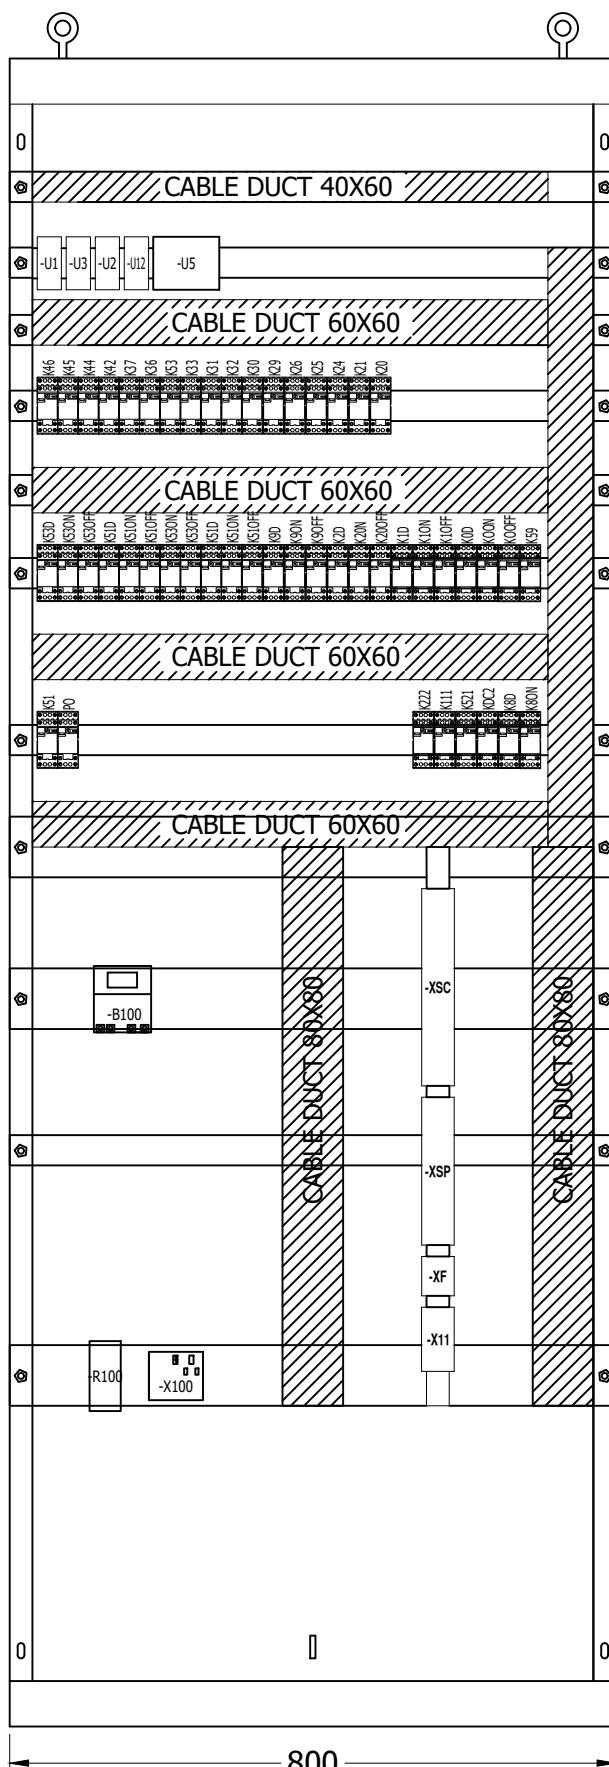FRONT VIEWLEFT SIDE VIEWRIGHT SIDE VIEW


All information contained in this document is the exclusive property of GE GRID SOLUTIONS and shall not be used, copied or communicated to third parties without its prior authorization.

0	AS BUILT	19-10-2018	ASJ	Manufacturer EPESOL 71-B Garden Block, New Garden Town, Lahore, Pakistan	Contractor Grid Solutions A GE and Alstom joint venture	Client NATIONAL TRANSMISSION & DISPATCH COMPANY LIMITED (NTDC-WAPDA)	Project 220kV/132kV GIS SUBSTATION GHAZI ROAD, LAHORE	Title 132kV LINE CONTROL PANEL (=E03+CP31) PANEL VIEWS	Drawing no. P60194-E-ELC-SC-002	
REV.	DESCRIPTION	DATE	DRAWER					Project no. P-60194	Sheet type AD	Sheet no. 06


BACK VIEW WITHOUT DOOR

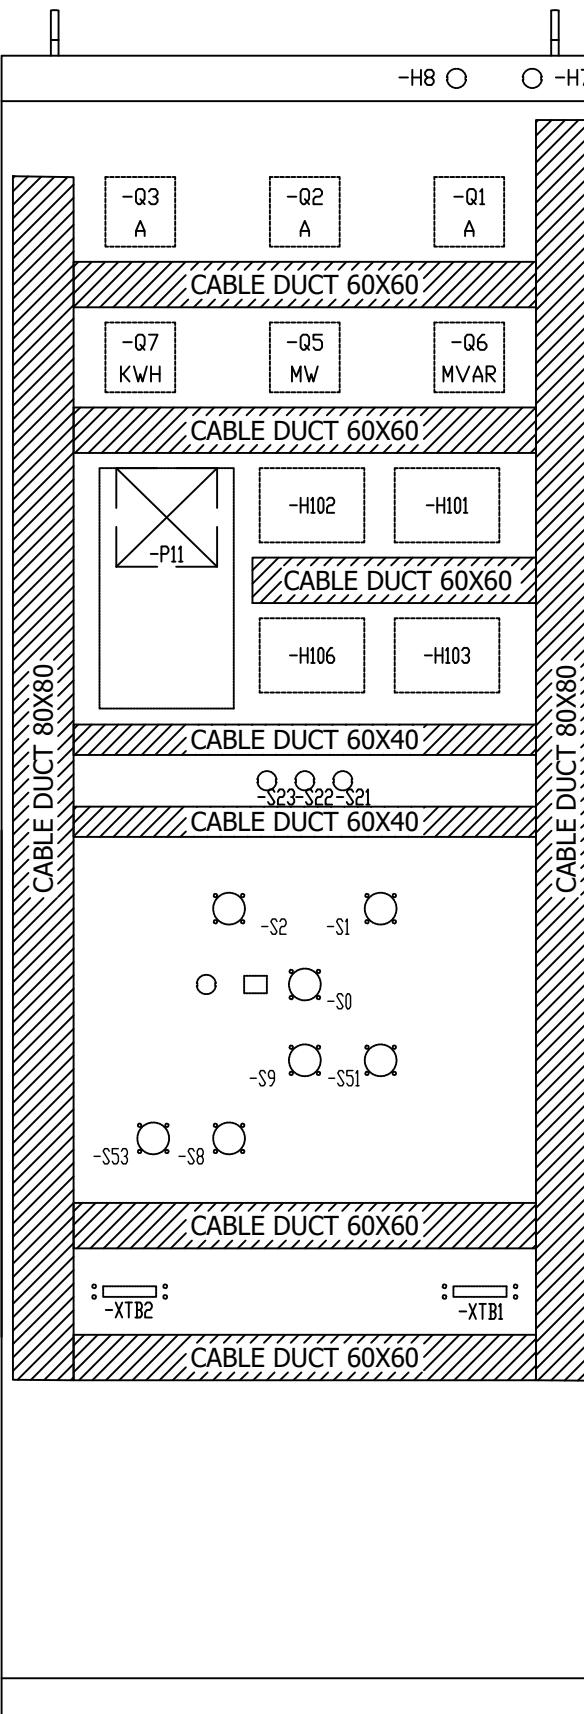

BACK VIEW WITH DOOR

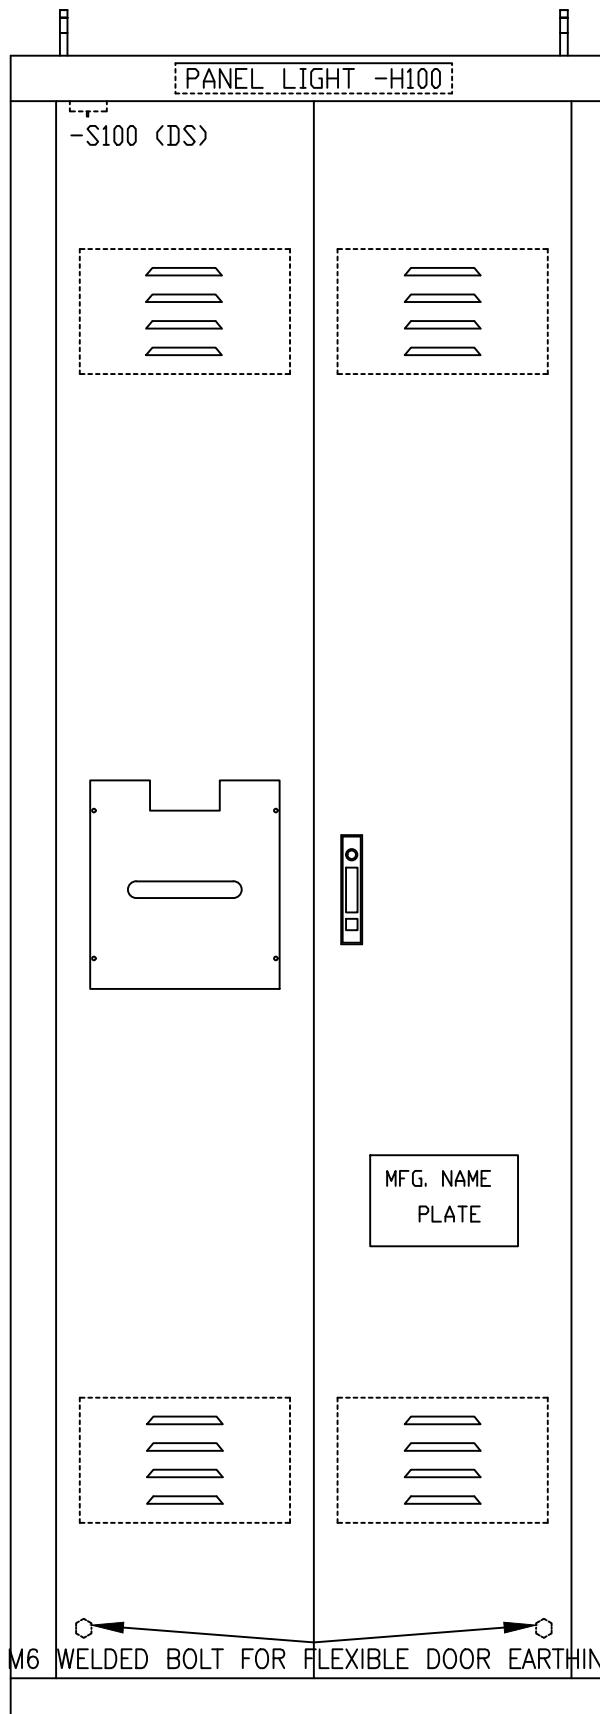

TOP VIEW

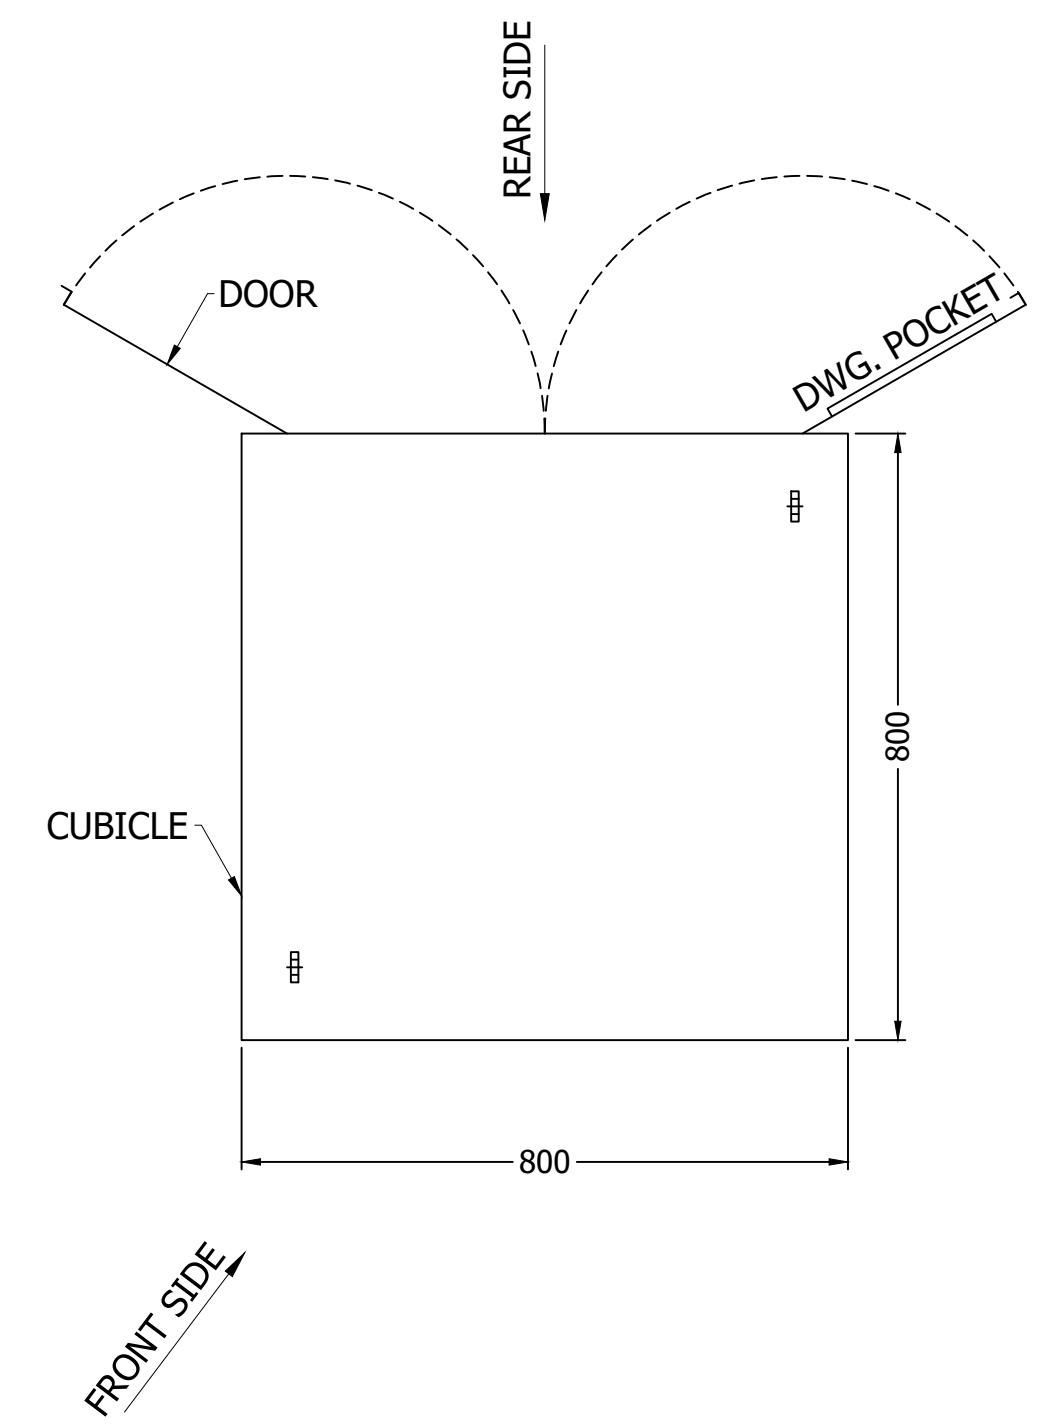


NOTE:-


- 1 - PANEL DIMENSION: 800 x 800 x 2200mm (WxDxH)
- 2 - COLOR : RAL 7032
- 3 - SHEET THICKNESS : 2-2.5 mm
- 4- PROTECTION CLASS : IP-51 (INDOOR TYPE)
- 5 - ALL DOOR FITTED WITH 16mm EARTH STRAP & INSULATED WITH GREEN-YELLOW COLOUR.

All information contained in this document is the exclusive property of GE GRID SOLUTIONS and shall not be used, copied or communicated to third parties without its prior authorization.

0	IFC	19-10-2018	ASJ	Manufacturer  EPESOL 7a-B Garden Block, New Garden Town, Lahore, Pakistan	Contractor  Grid Solutions A GE and Alstom joint venture	Client  NATIONAL TRANSMISSION & DISPATCH COMPANY LIMITED (NTDC-WAPDA)	Project 220kV/132kV GIS SUBSTATION GHAZI ROAD, LAHORE	Title 132kV LINE CONTROL PANEL (=E03+CP31) PANEL VIEWS	Drawing no. P60194-E-ELC-SC-002		
REV.	DESCRIPTION	DATE	DRAWER						Project no. P-60194	Sheet type AD1	Sheet no. 06a
1	2	3	4	5	6	7	8				

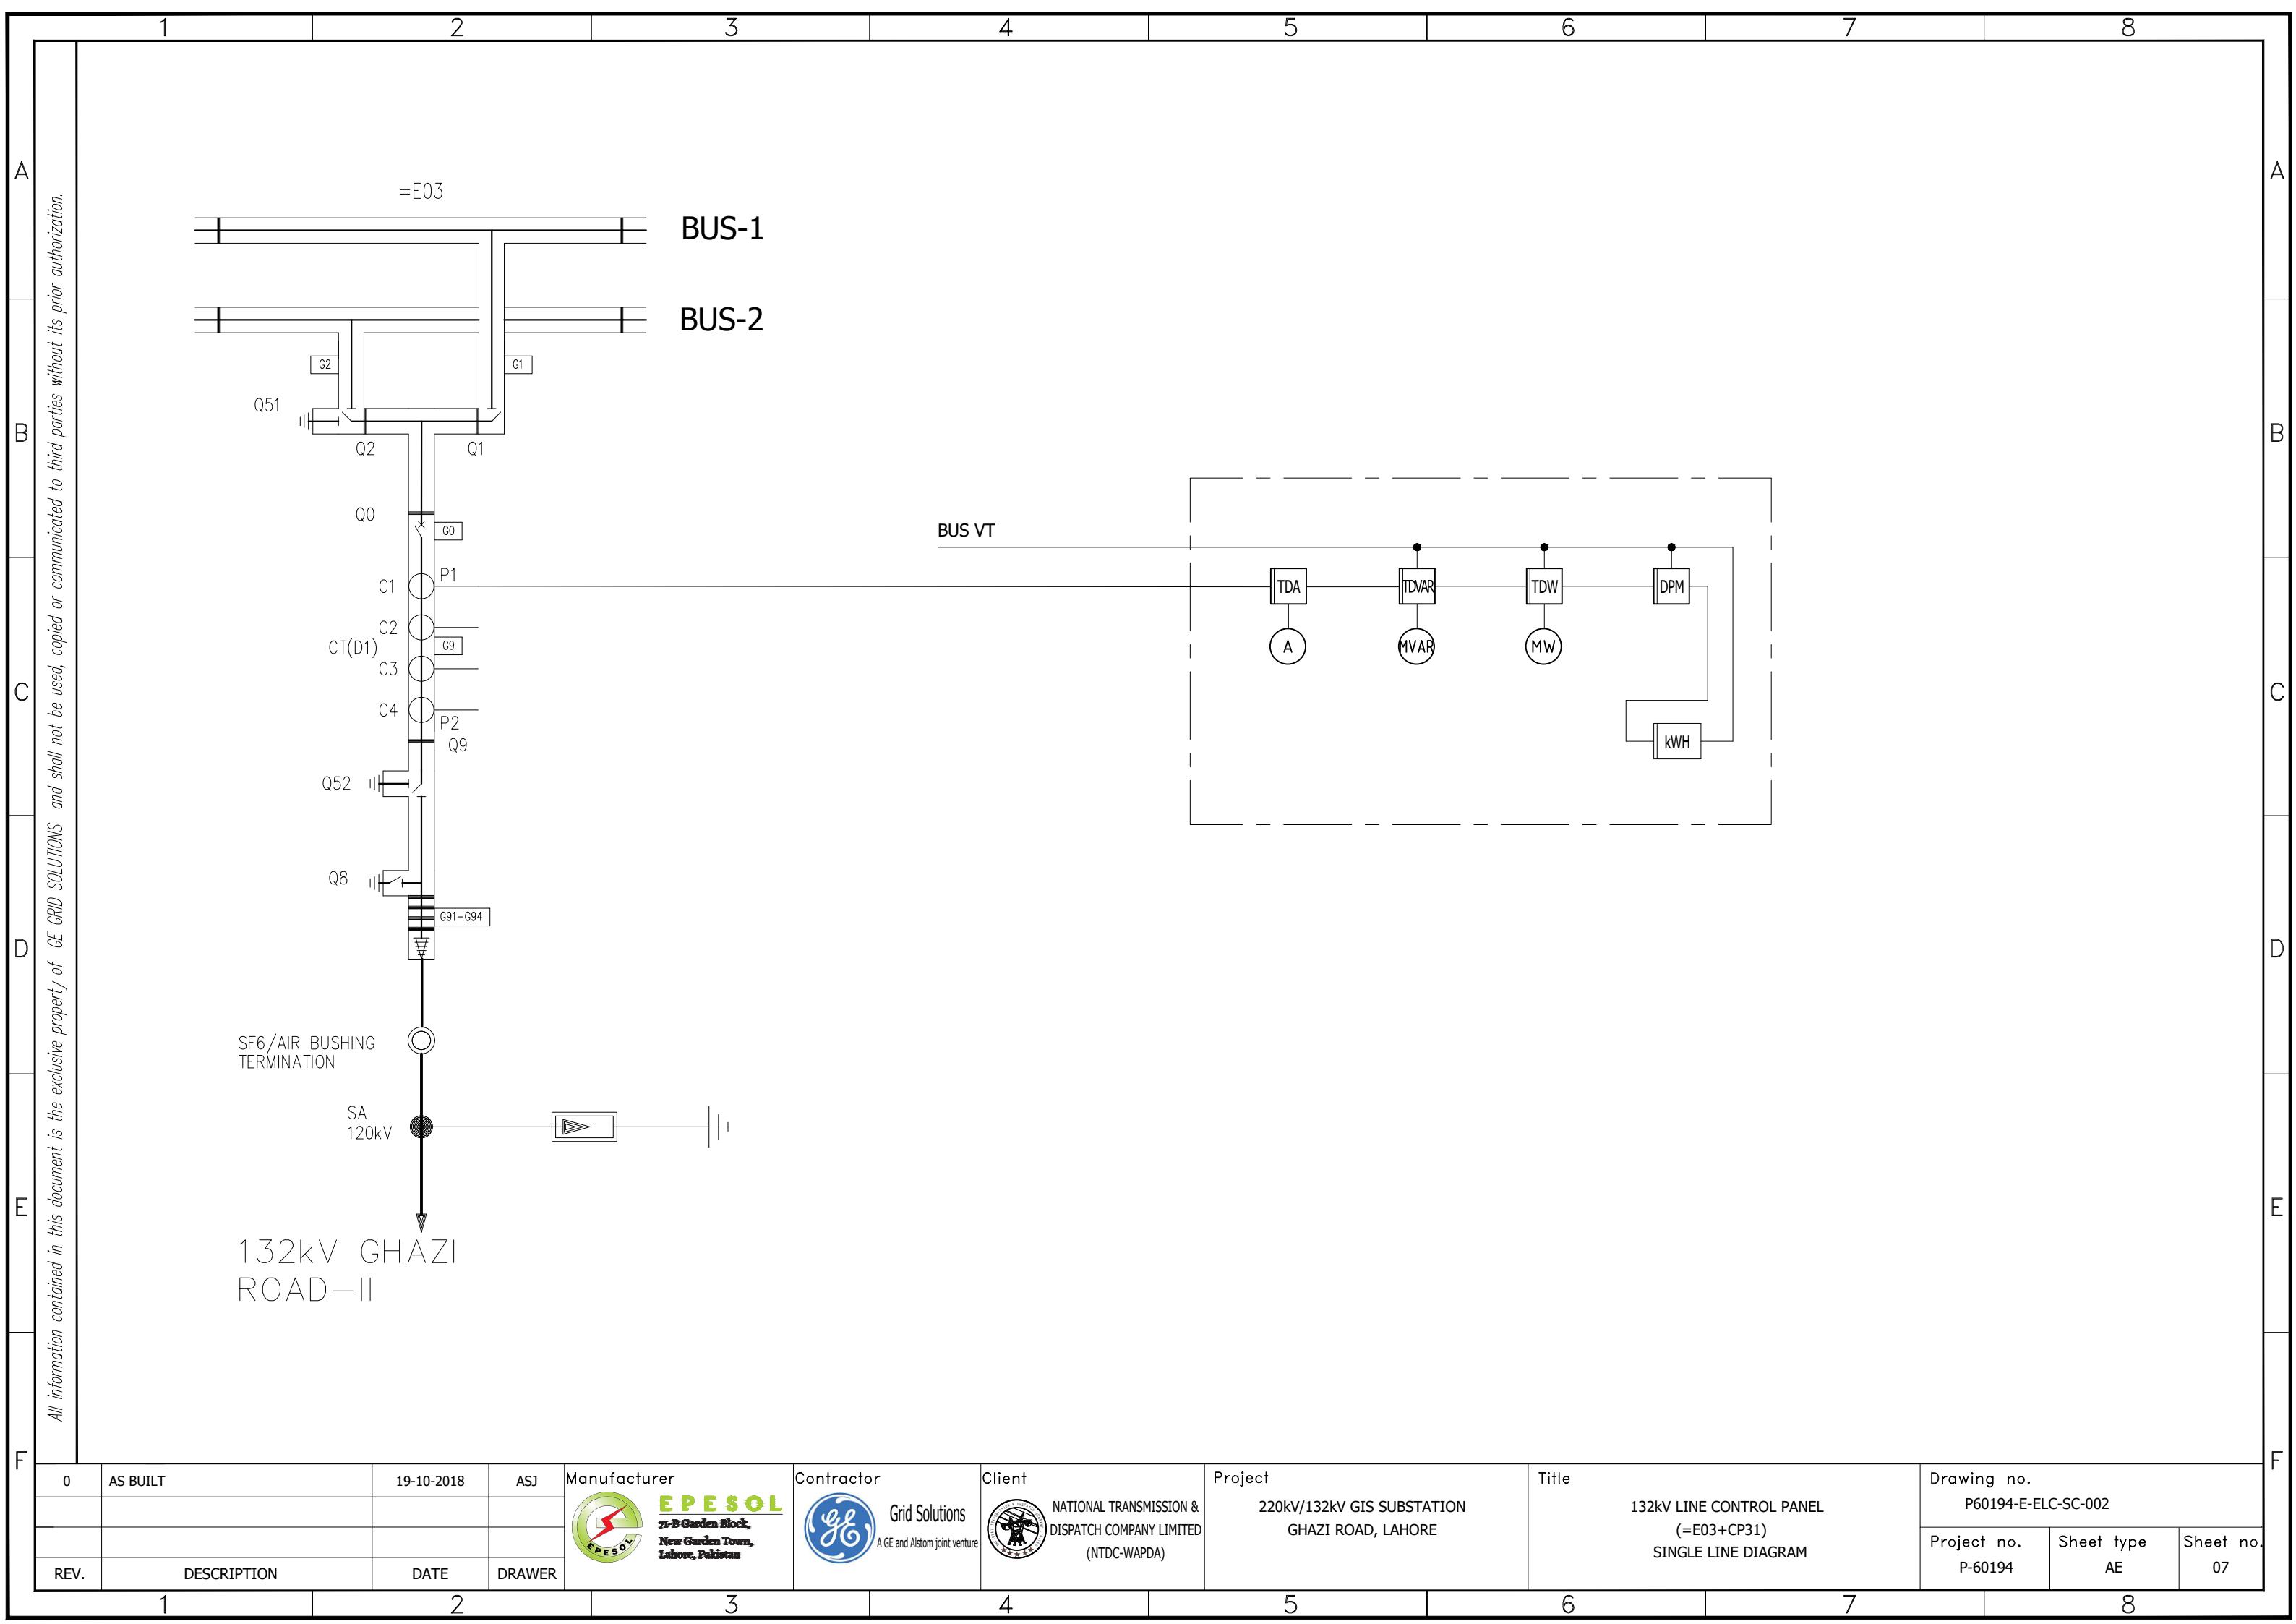

1 2 3 4 5 6 7 8

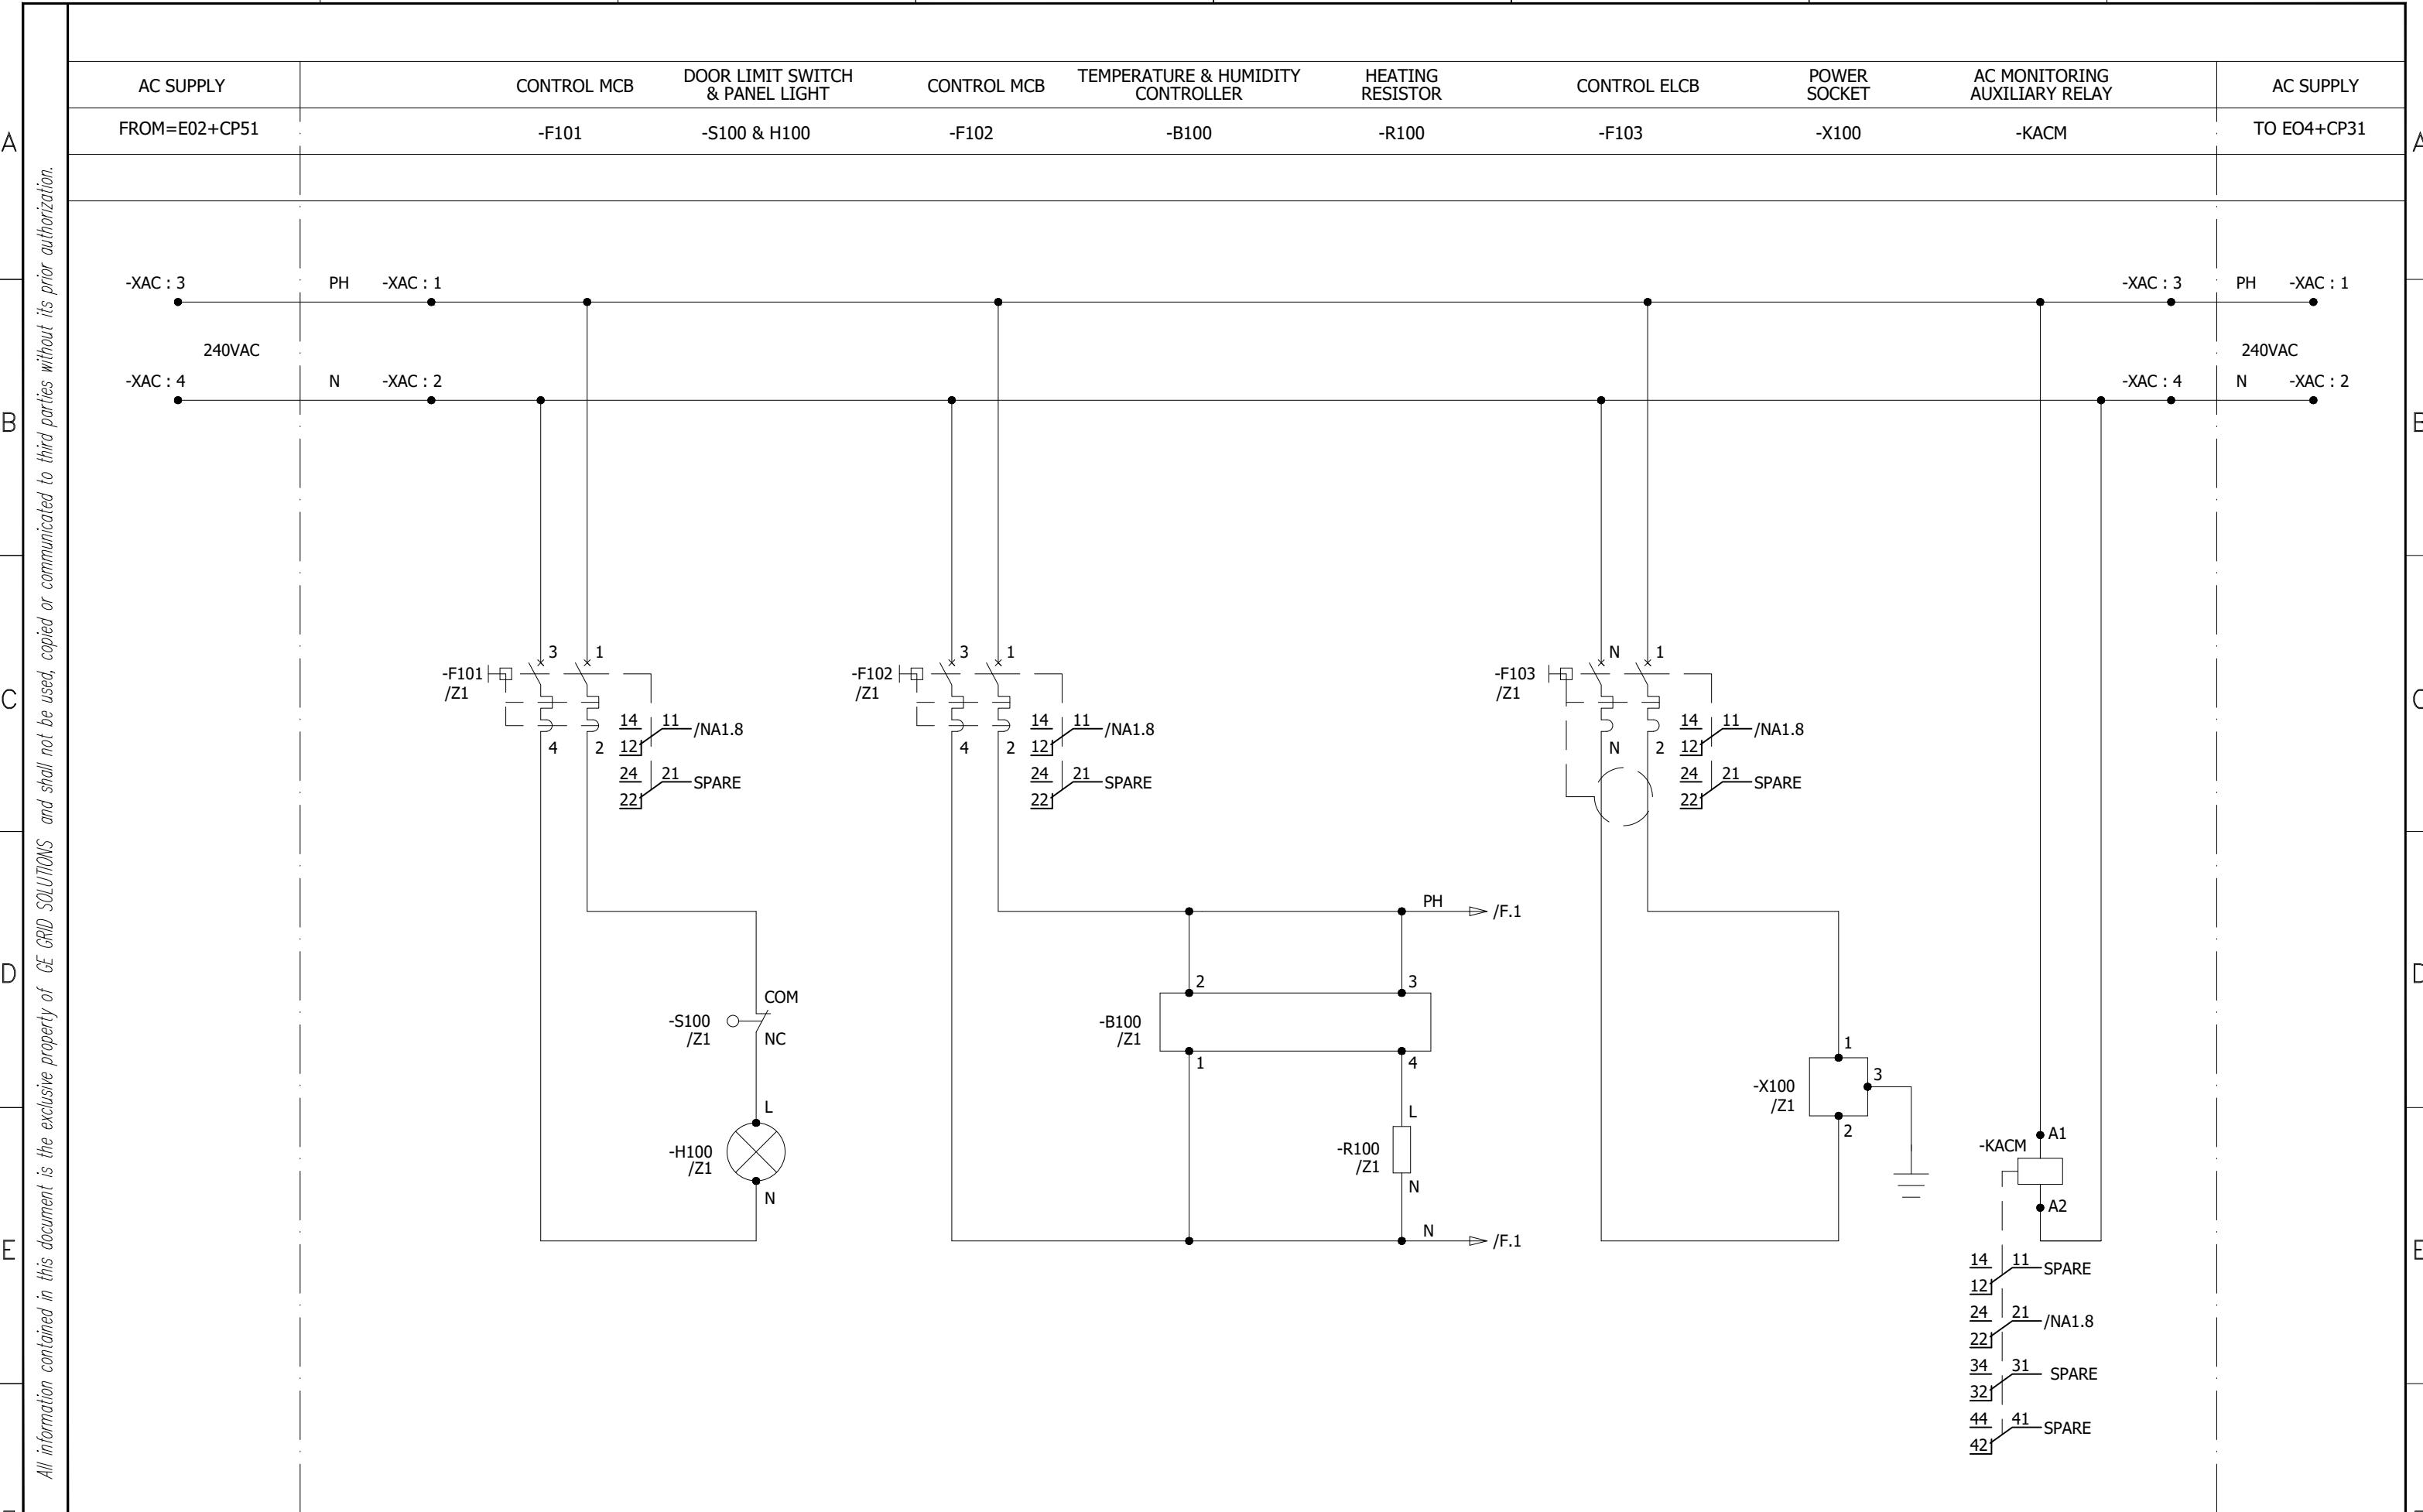

0	AS BUILT	19-10-2018	ASJ	Manufacturer EPESOL 71-B Garden Block, New Garden Town, Lahore, Pakistan	Contractor Grid Solutions A GE and Alstom joint venture	Client NATIONAL TRANSMISSION & DISPATCH COMPANY LIMITED (NTDC-WAPDA)	Project 220KV/132KV GIS SUBSTATION GHAZI ROAD, LAHORE	Title 132KV LINE CONTROL PANEL (=E03+CP31) AC SUPPLY DISTRIBUTION CIRCUIT	Drawing no. P60194-E-ELC-SC-002
REV.	DESCRIPTION	DATE	DRAWER						Project no. P-60194
									Sheet type D
									Sheet no. 08

1 2 3 4 5 6 7 8

1 2 3 4 5 6 7 8



DC MCB FOR 132KV CB
CONTROL

-F201

DC MCB FOR
INDICATION

-F202

All information contained in this document is the exclusive property of GE GRID SOLUTIONS and shall not be used, copied or communicated to third parties without its prior authorization.

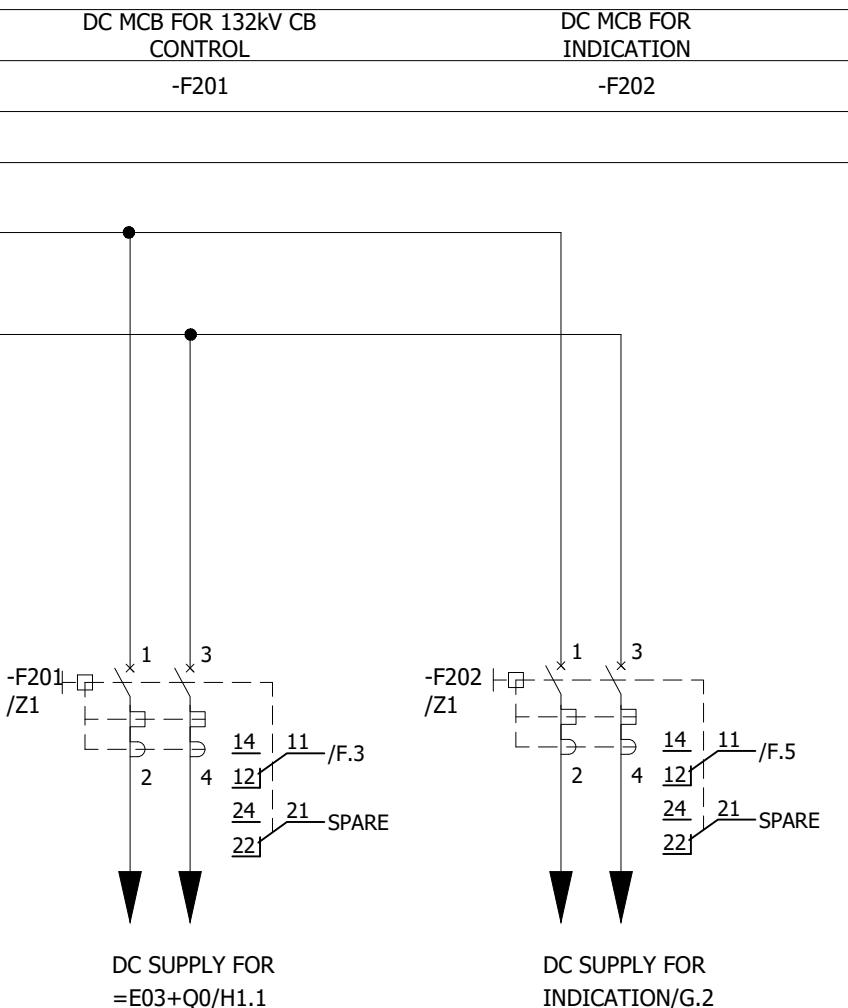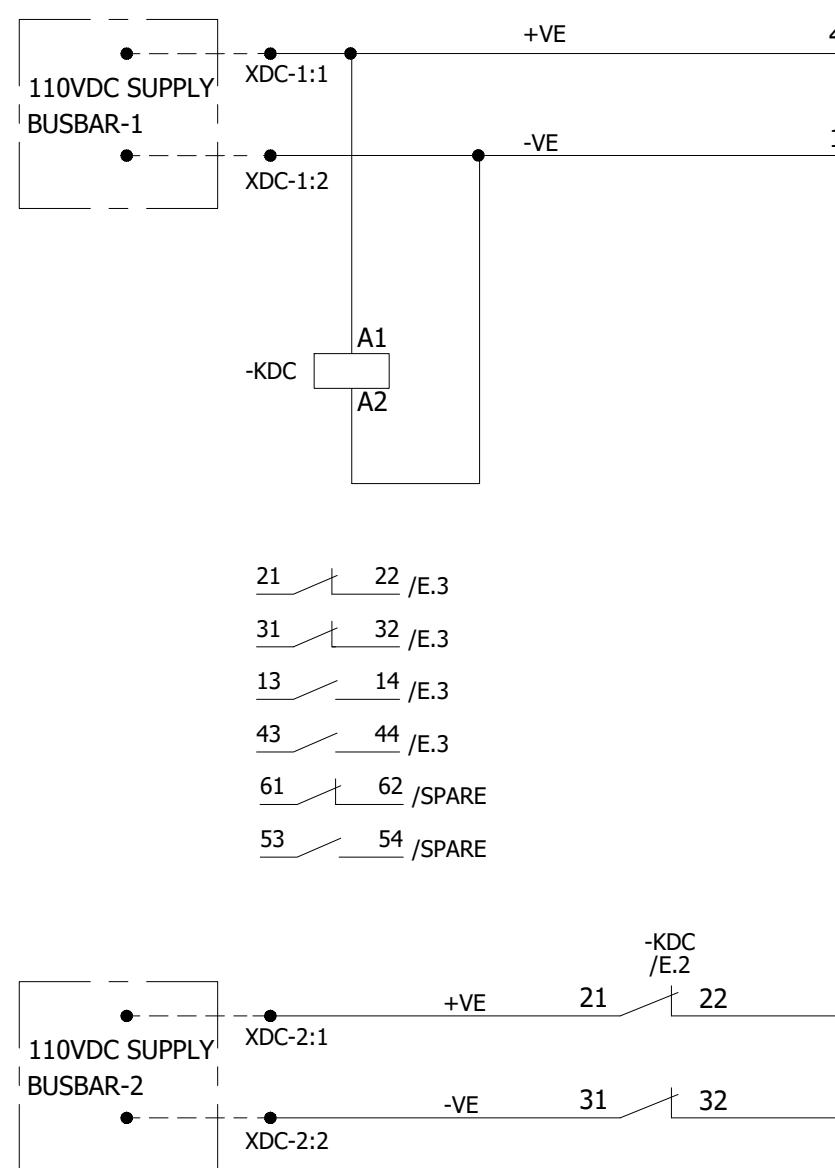

0	AS BUILT	19-10-2018	ASJ	Manufacturer  EPESOL 7-B Garden Block, New Garden Town, Lahore, Pakistan	Contractor  Grid Solutions A GE and Alstom joint venture	Client  NATIONAL TRANSMISSION & DISPATCH COMPANY LIMITED (NTDC-WAPDA)	Project 220KV/132KV GIS SUBSTATION GHAZI ROAD, LAHORE	Title 132KV LINE CONTROL PANEL (=E03+CP31) DC SUPPLY DISTRIBUTION CIRCUIT	Drawing no. P60194-E-ELC-SC-002
REV.	DESCRIPTION	DATE	DRAWER						Project no. P-60194 Sheet type E Sheet no. 09

1 2 3 4 5 6 7 8

1 2 3 4 5 6 7 8

TEST BLOCK

AM METERS

MW METER (-Q5)

MVAR METER (-Q6)

DIGITAL POWER METER

REVENUE METER


TS

(-Q1, -Q2, -Q3) WITH
TRANSDUCERS
(-U1, , -U2, -U3)

WITH TRANSDUCER (-U5)

(-Q7)

(-P11)

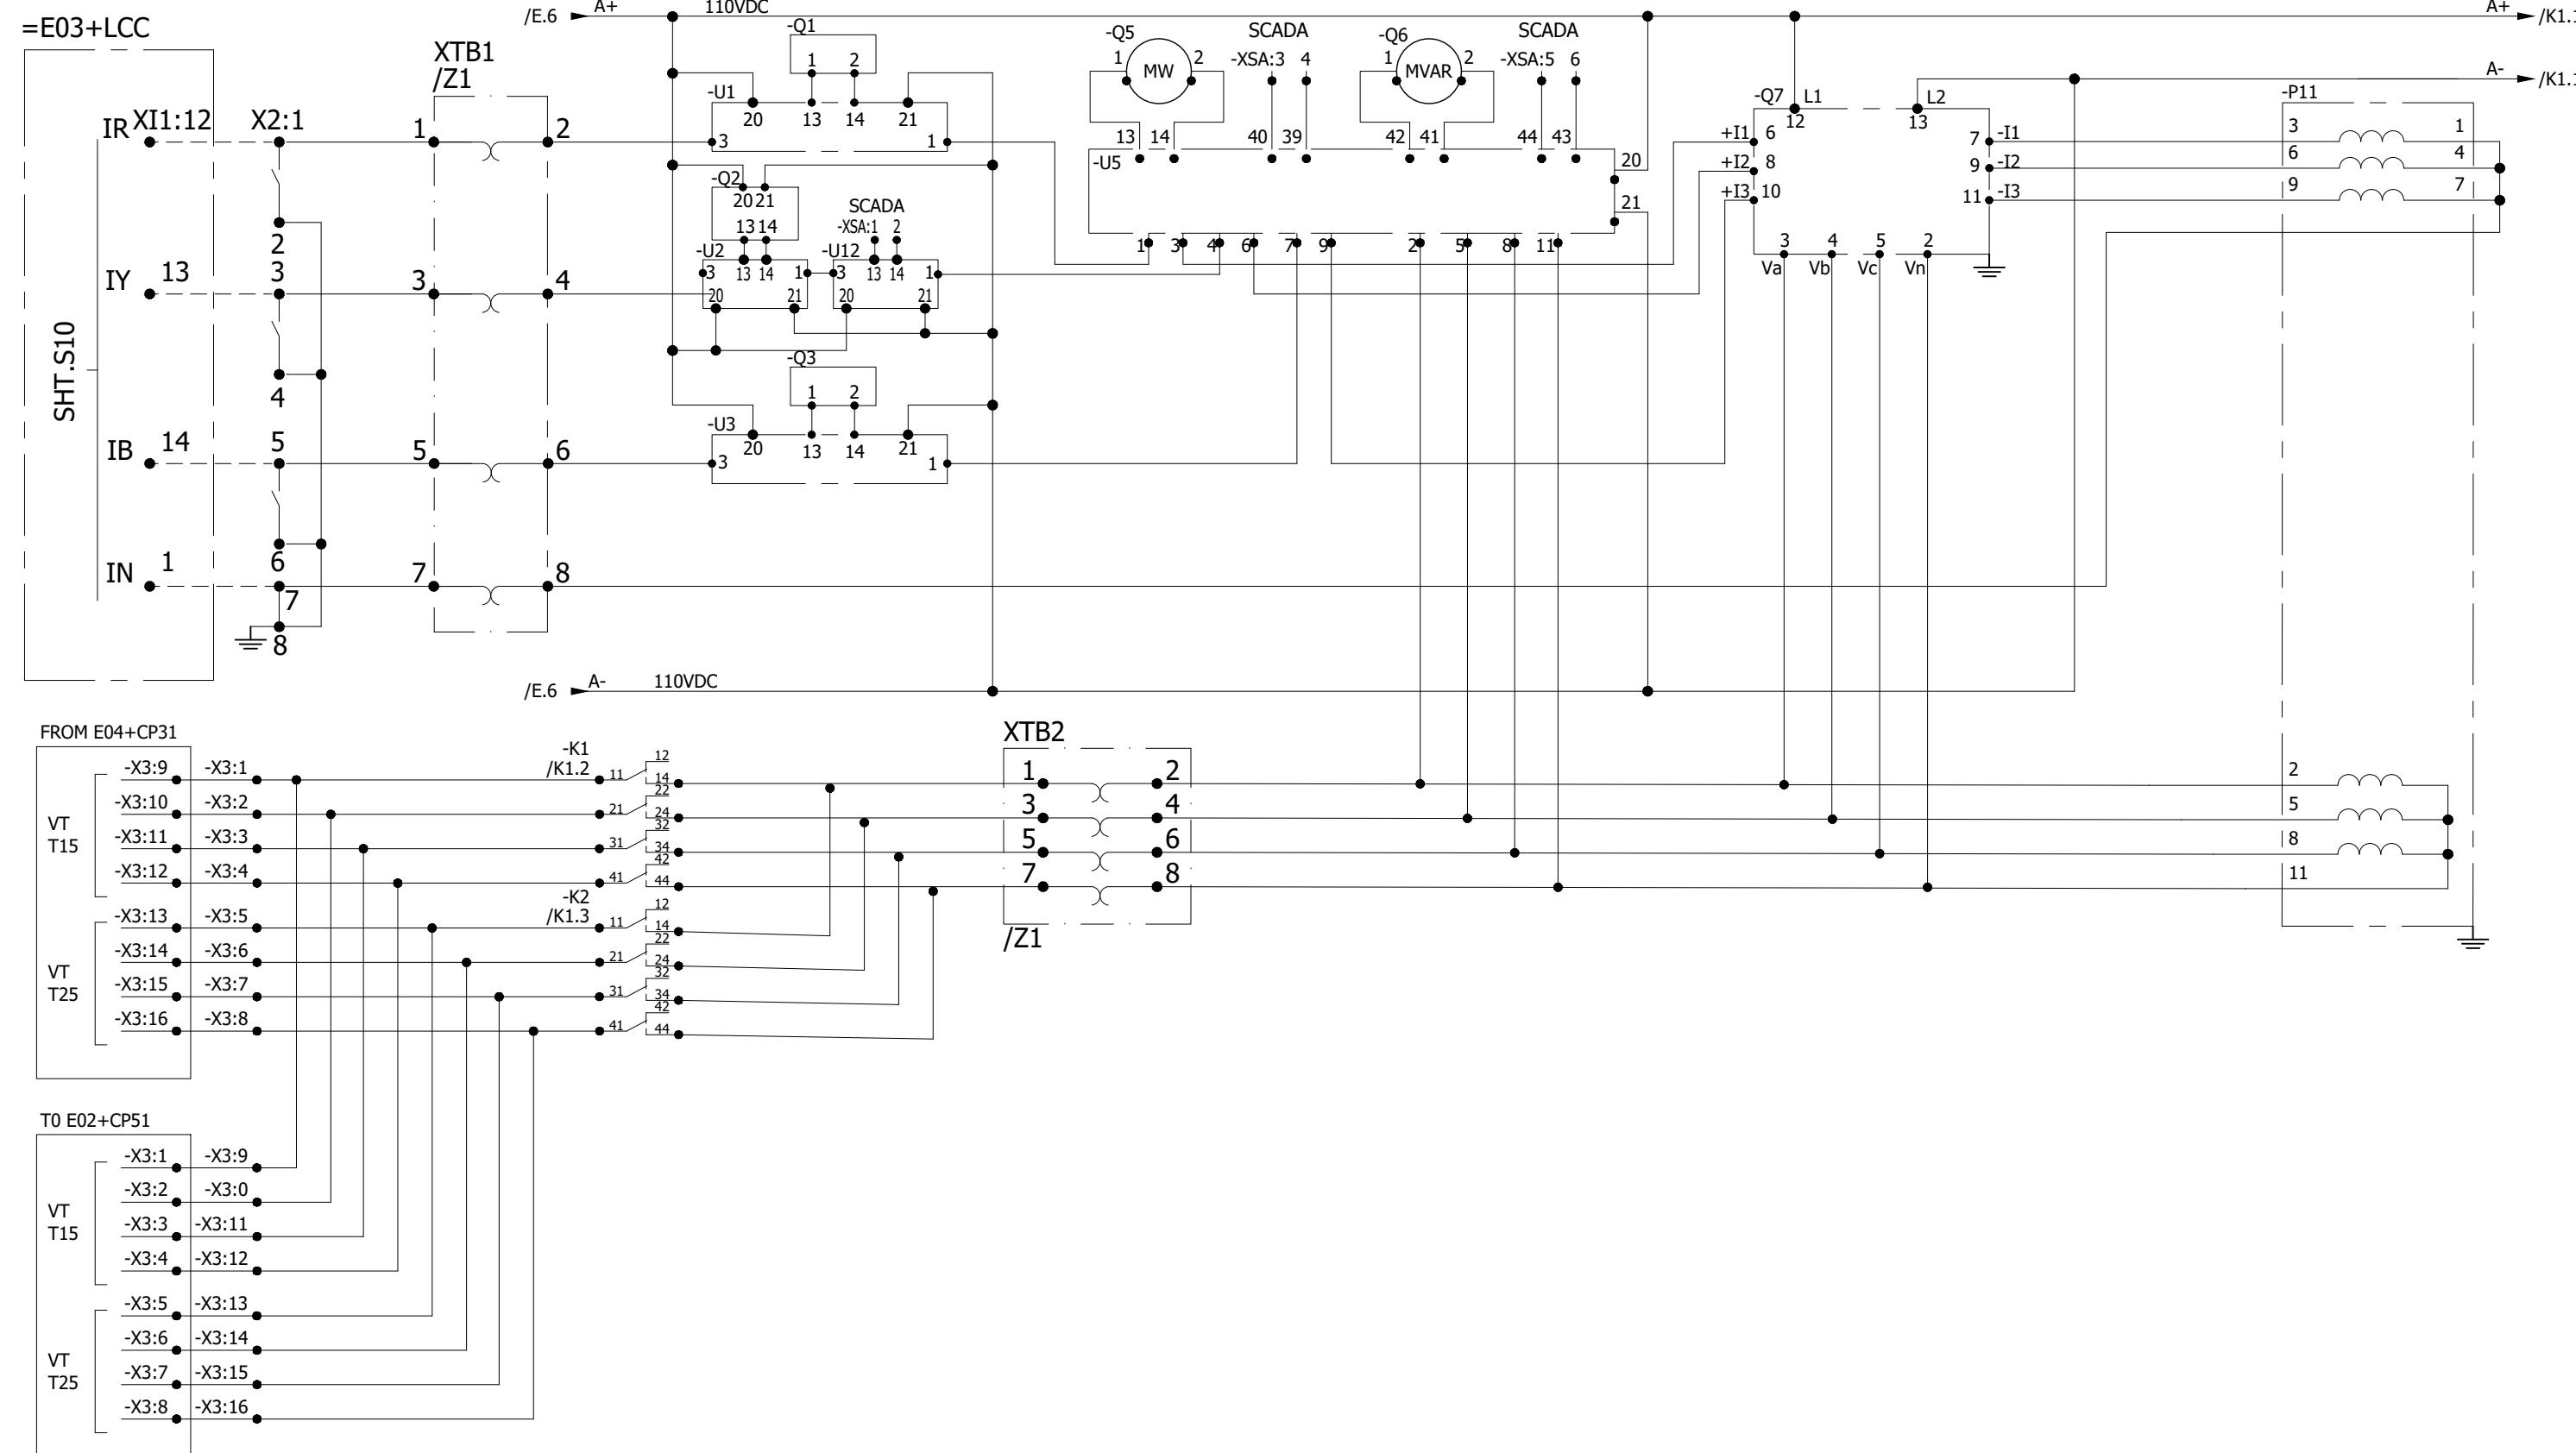

0	AS BUILT	19.10.2018	ASJ	Manufacturer  EPESOL 71-B Garden Block, New Garden Town, Lahore, Pakistan	Contractor  Grid Solutions A GE and Alstom joint venture	Client  NATIONAL TRANSMISSION & DISPATCH COMPANY LIMITED (NTDC-WAPDA)	Project 220kV/132kV GIS SUBSTATION GHAZI ROAD, LAHORE	Title 132kV LINE CONTROL PANEL (-E03+CP31) METERING	Drawing no. P60194-E-ELC-SC-002
REV.	DESCRIPTION	DATE	DRAWER						Project no. P-60194
									Sheet type G
									Sheet no. 11

1 2 3 4 5 6 7 8

C O N T R O L R O O M


DC SUPERVISION
RELAY SCADA
CONTROL

CLOSE

OPEN KDC-1 CLOSE OPEN

All information contained in this document is the exclusive property of GE GRID SOLUTIONS and shall not be used, copied or communicated to third parties without its prior authorization.

A

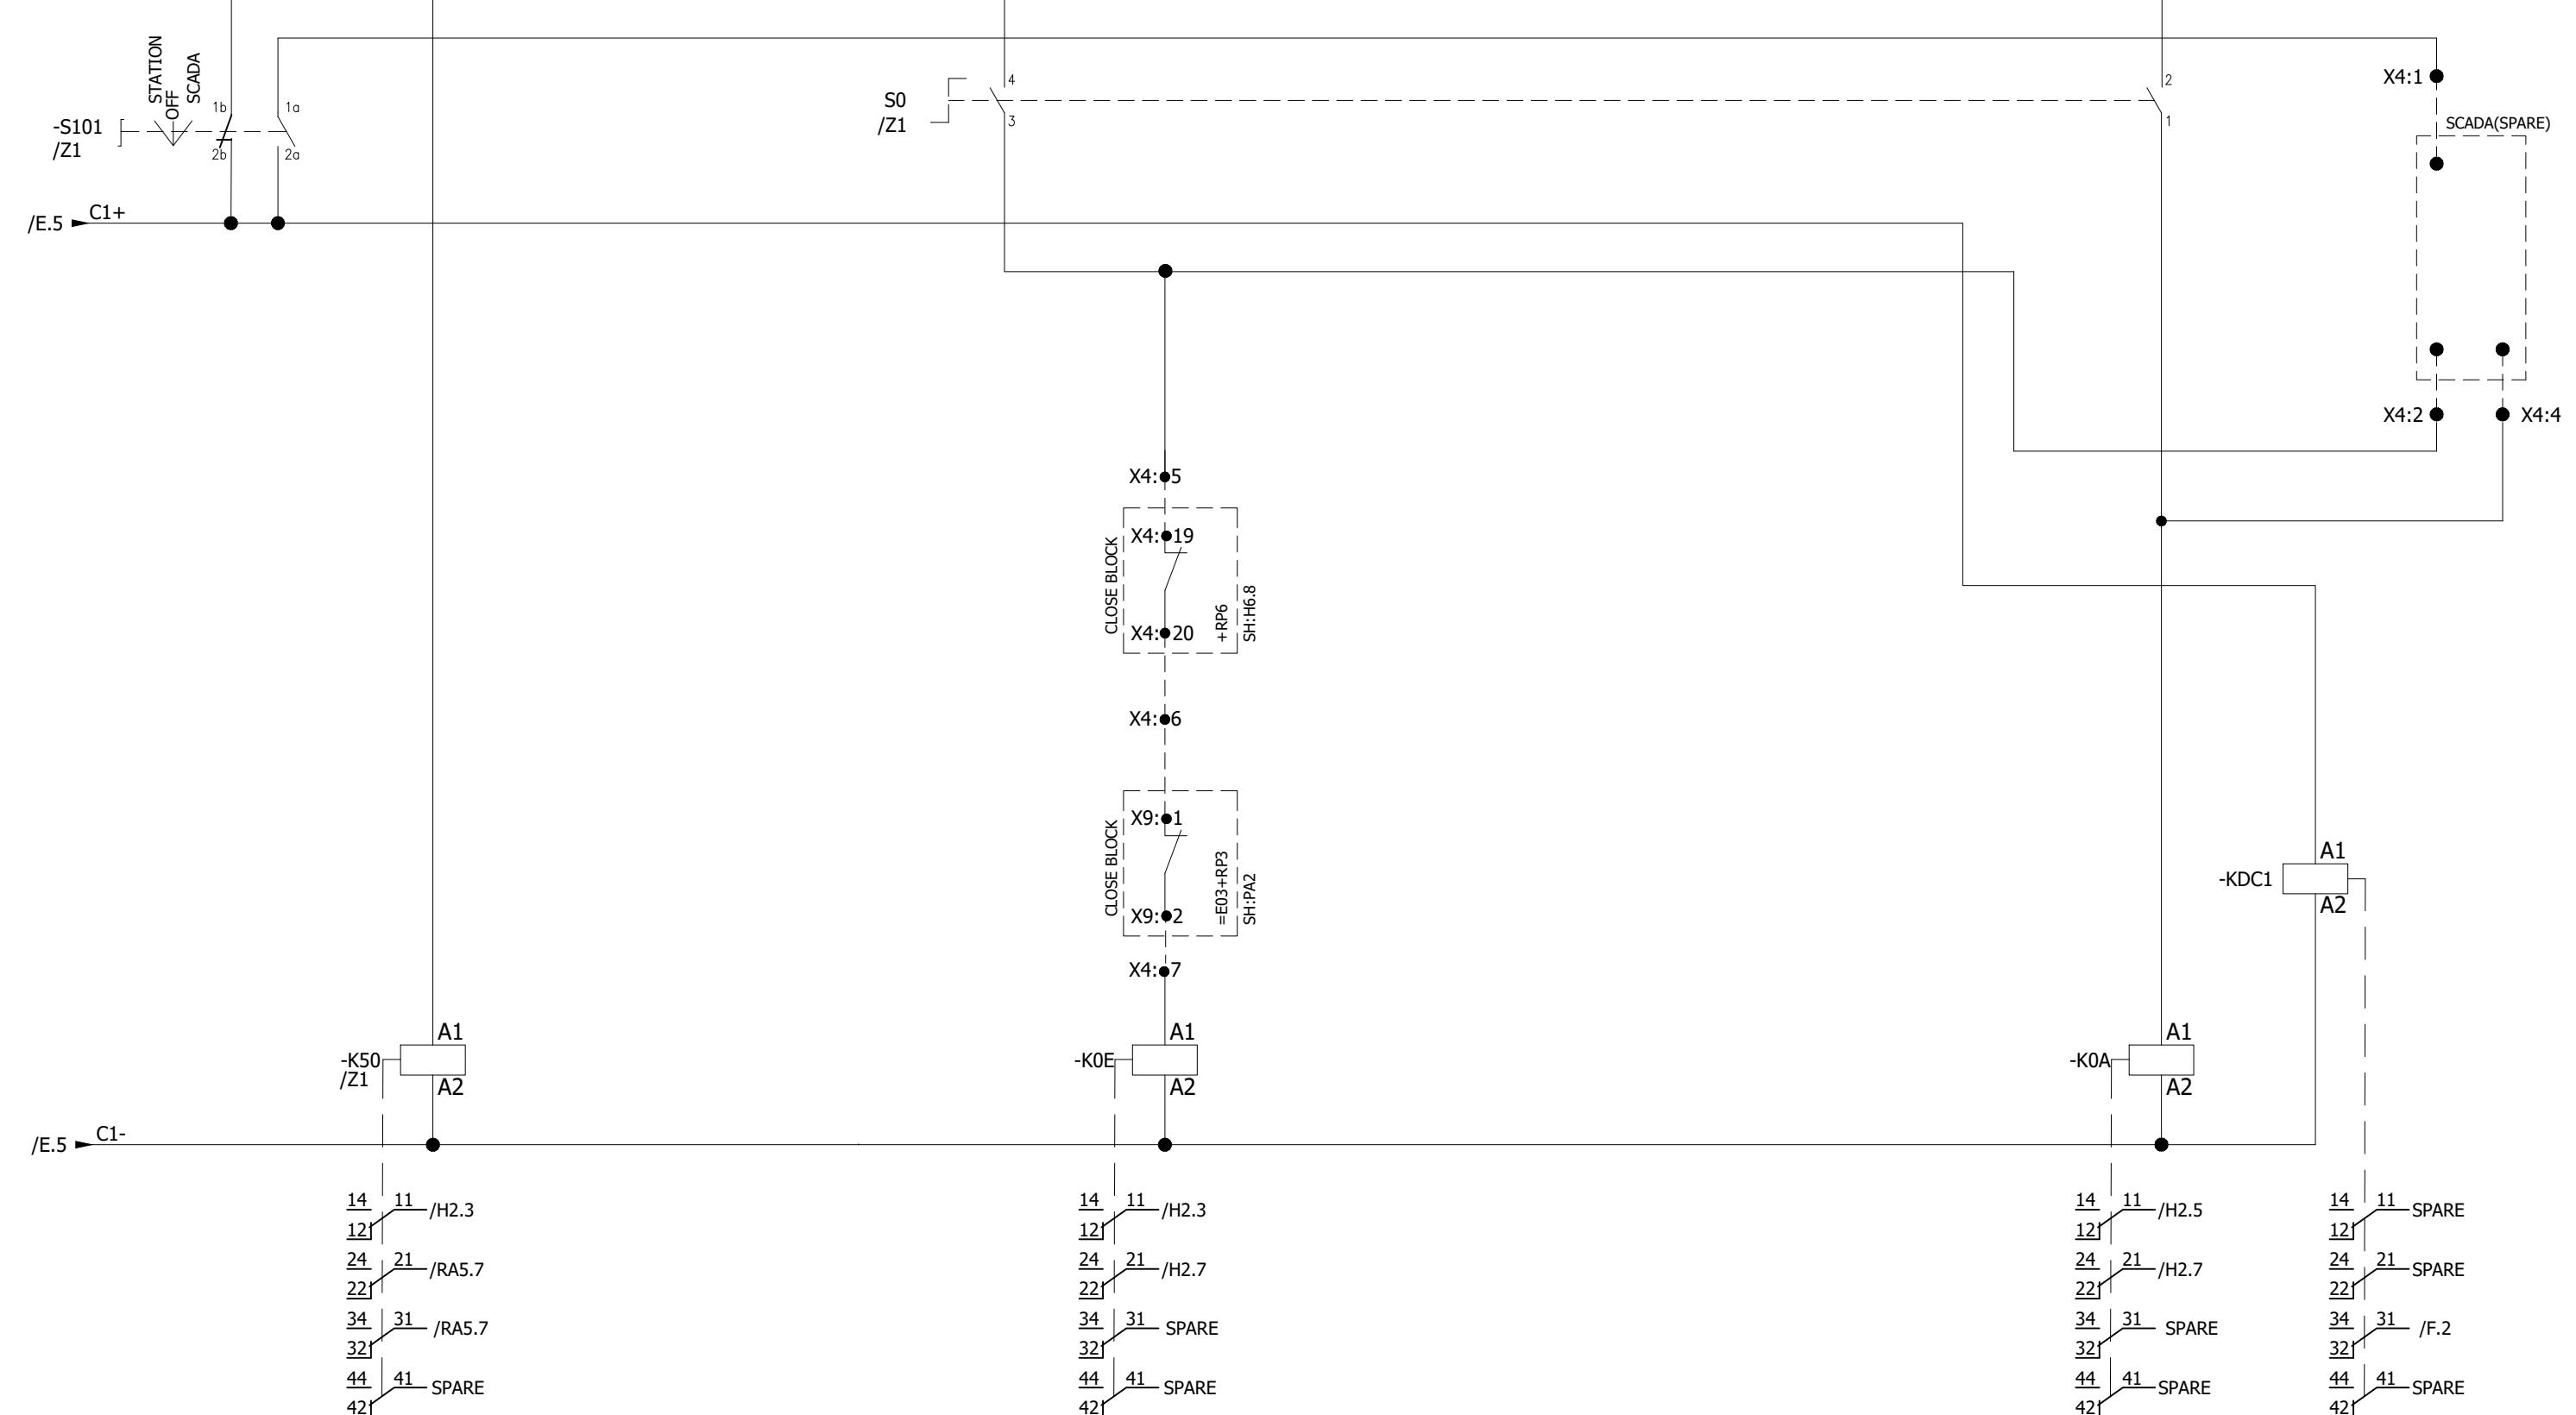

0	AS BUILT	19-10-2018	ASJ	Manufacturer  EPESOL 7-B Garden Block, New Garden Town, Lahore, Pakistan	Contractor  Grid Solutions A GE and Alstom joint venture	Client  NATIONAL TRANSMISSION & DISPATCH COMPANY LIMITED (NTDC-WAPDA)	Project 220kV/132kV GIS SUBSTATION GHAZI ROAD, LAHORE	Title 132kV LINE CONTROL PANEL (=E03+CP31) CB CONTROL CIRCUIT	Drawing no. P60194-E-ELC-SC-002	
REV.	DESCRIPTION	DATE	DRAWER					Project no. P-60194	Sheet type H1	Sheet no. 12



C O N T R O L R O O M C O N T R O L

AUTORECLOSE(SPARE)

CLOSE

OPEN

All information contained in this document is the exclusive property of GE GRID SOLUTIONS and shall not be used, copied or communicated to third parties without its prior authorization.

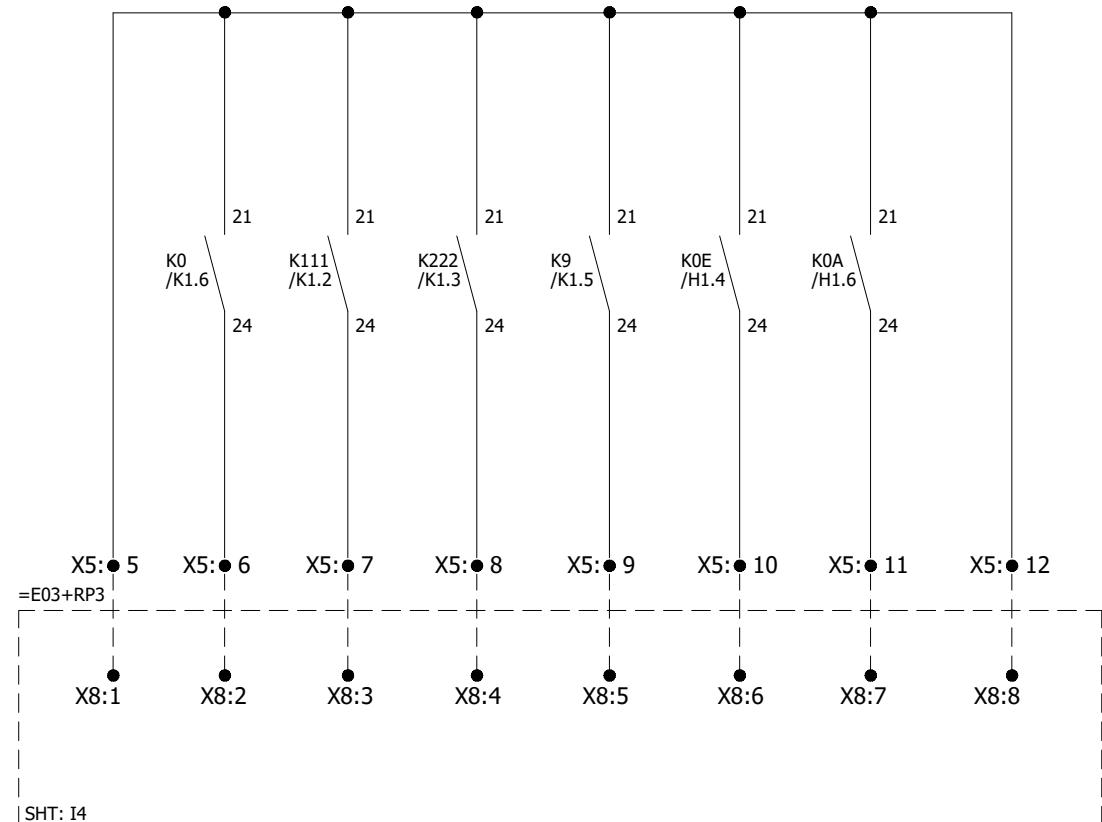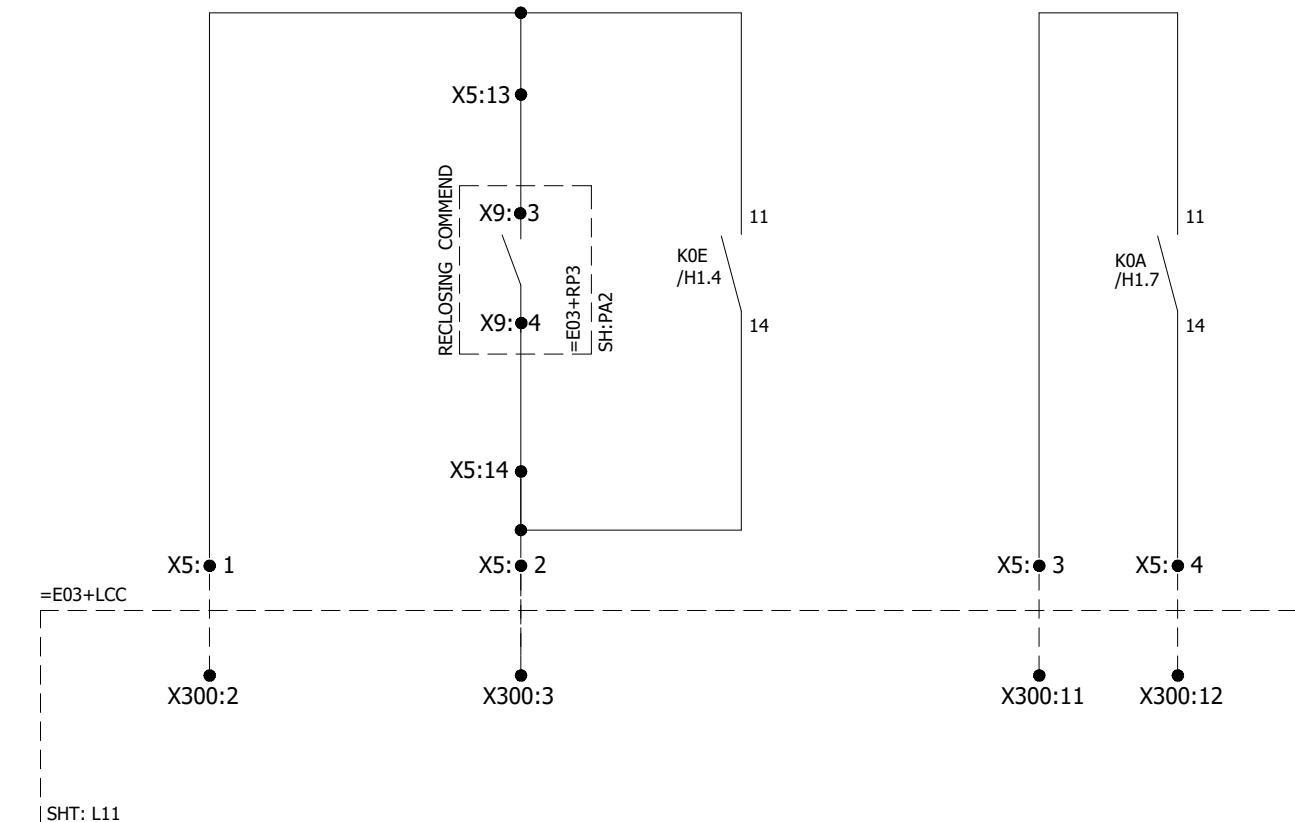

CB CLOSE STATUS

Q1 CLOSE STATUS

Q2 CLOSE STATUS

Q9 CLOSE STATUS

MANUAL CLOSE INPUT FOR DISTANCE RELAY

MANUAL OPEN INPUT FOR DISTANCE RELAY

0	AS BUILT	19-10-2018	ASJ	Manufacturer  EPESOL 7-B Garden Block, New Garden Town, Lahore, Pakistan	Contractor  Grid Solutions A GE and Alstom joint venture	Client  NATIONAL TRANSMISSION & DISPATCH COMPANY LIMITED (NTDC-WAPDA)	Project 220kV/132kV GIS SUBSTATION GHAZI ROAD, LAHORE	Title 132kV LINE CONTROL PANEL (=E03+CP31) CB CONTROL CIRCUIT	Drawing no. P60194-E-ELC-SC-002
REV.	DESCRIPTION	DATE	DRAWER						Project no. P-60194
									Sheet type H2
									Sheet no. 13

1 2 3 4 5 6 7 8

=E03+Q1

=E03+Q2

=E03+Q9

CLOSE

OPEN


CLOSE

OPEN

CLOSE

OPEN

All information contained in this document is the exclusive property of GE GRID SOLUTIONS and shall not be used, copied or communicated to third parties without its prior authorization.

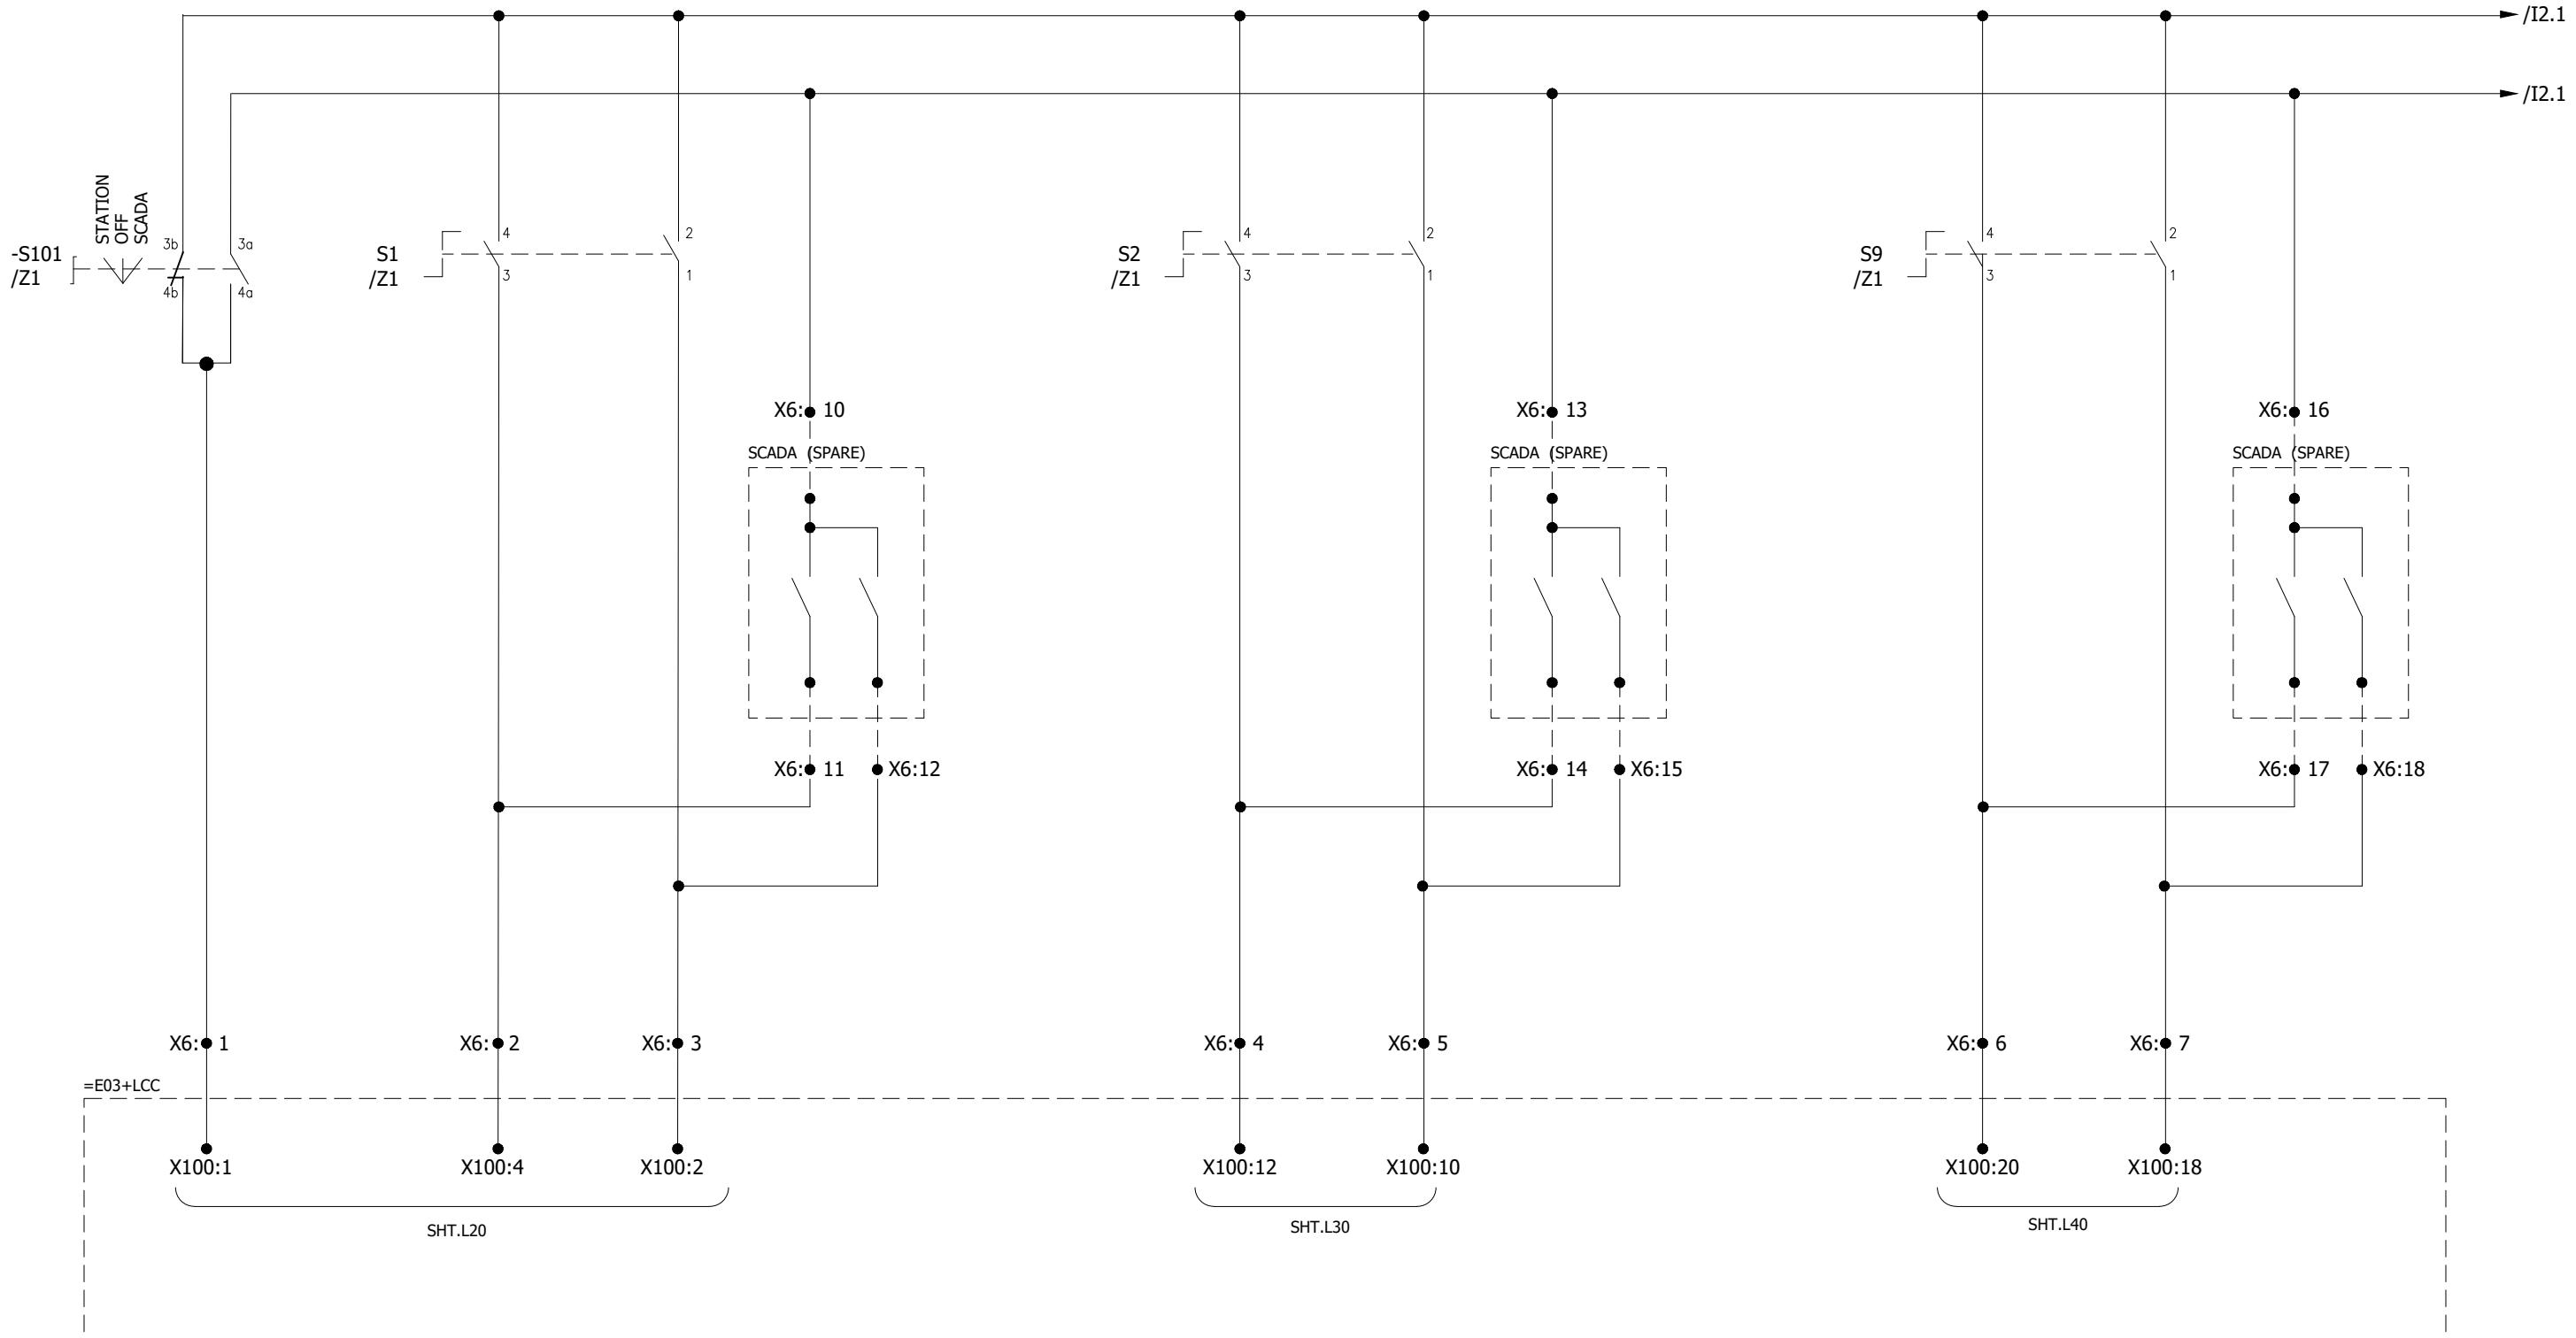

0	AS BUILT	19-10-2018	ASJ	Manufacturer  EPESOL 71-B Garden Block, New Garden Town, Lahore, Pakistan	Contractor  Grid Solutions A GE and Alstom joint venture	Client  NATIONAL TRANSMISSION & DISPATCH COMPANY LIMITED (NTDC-WAPDA)	Project 220KV/132KV GIS SUBSTATION GHAZI ROAD, LAHORE	Title 132KV LINE CONTROL PANEL (=E03+CP31) DISCONNECTOR & EARTH SWITCH CONTROL	Drawing no. P60194-E-ELC-SC-002
REV.	DESCRIPTION	DATE	DRAWER						Project no. P-60194
									Sheet type I1
									Sheet no. 14

1 2 3 4 5 6 7 8

1

1

1

1

4

6

7

1

CLOSE

OP


CLOSE

OPEN

CLOSE

OPEN

All information contained in this document is the exclusive property of GE GRID SOLUTIONS and shall not be used, copied or communicated to third parties without its prior authorization.

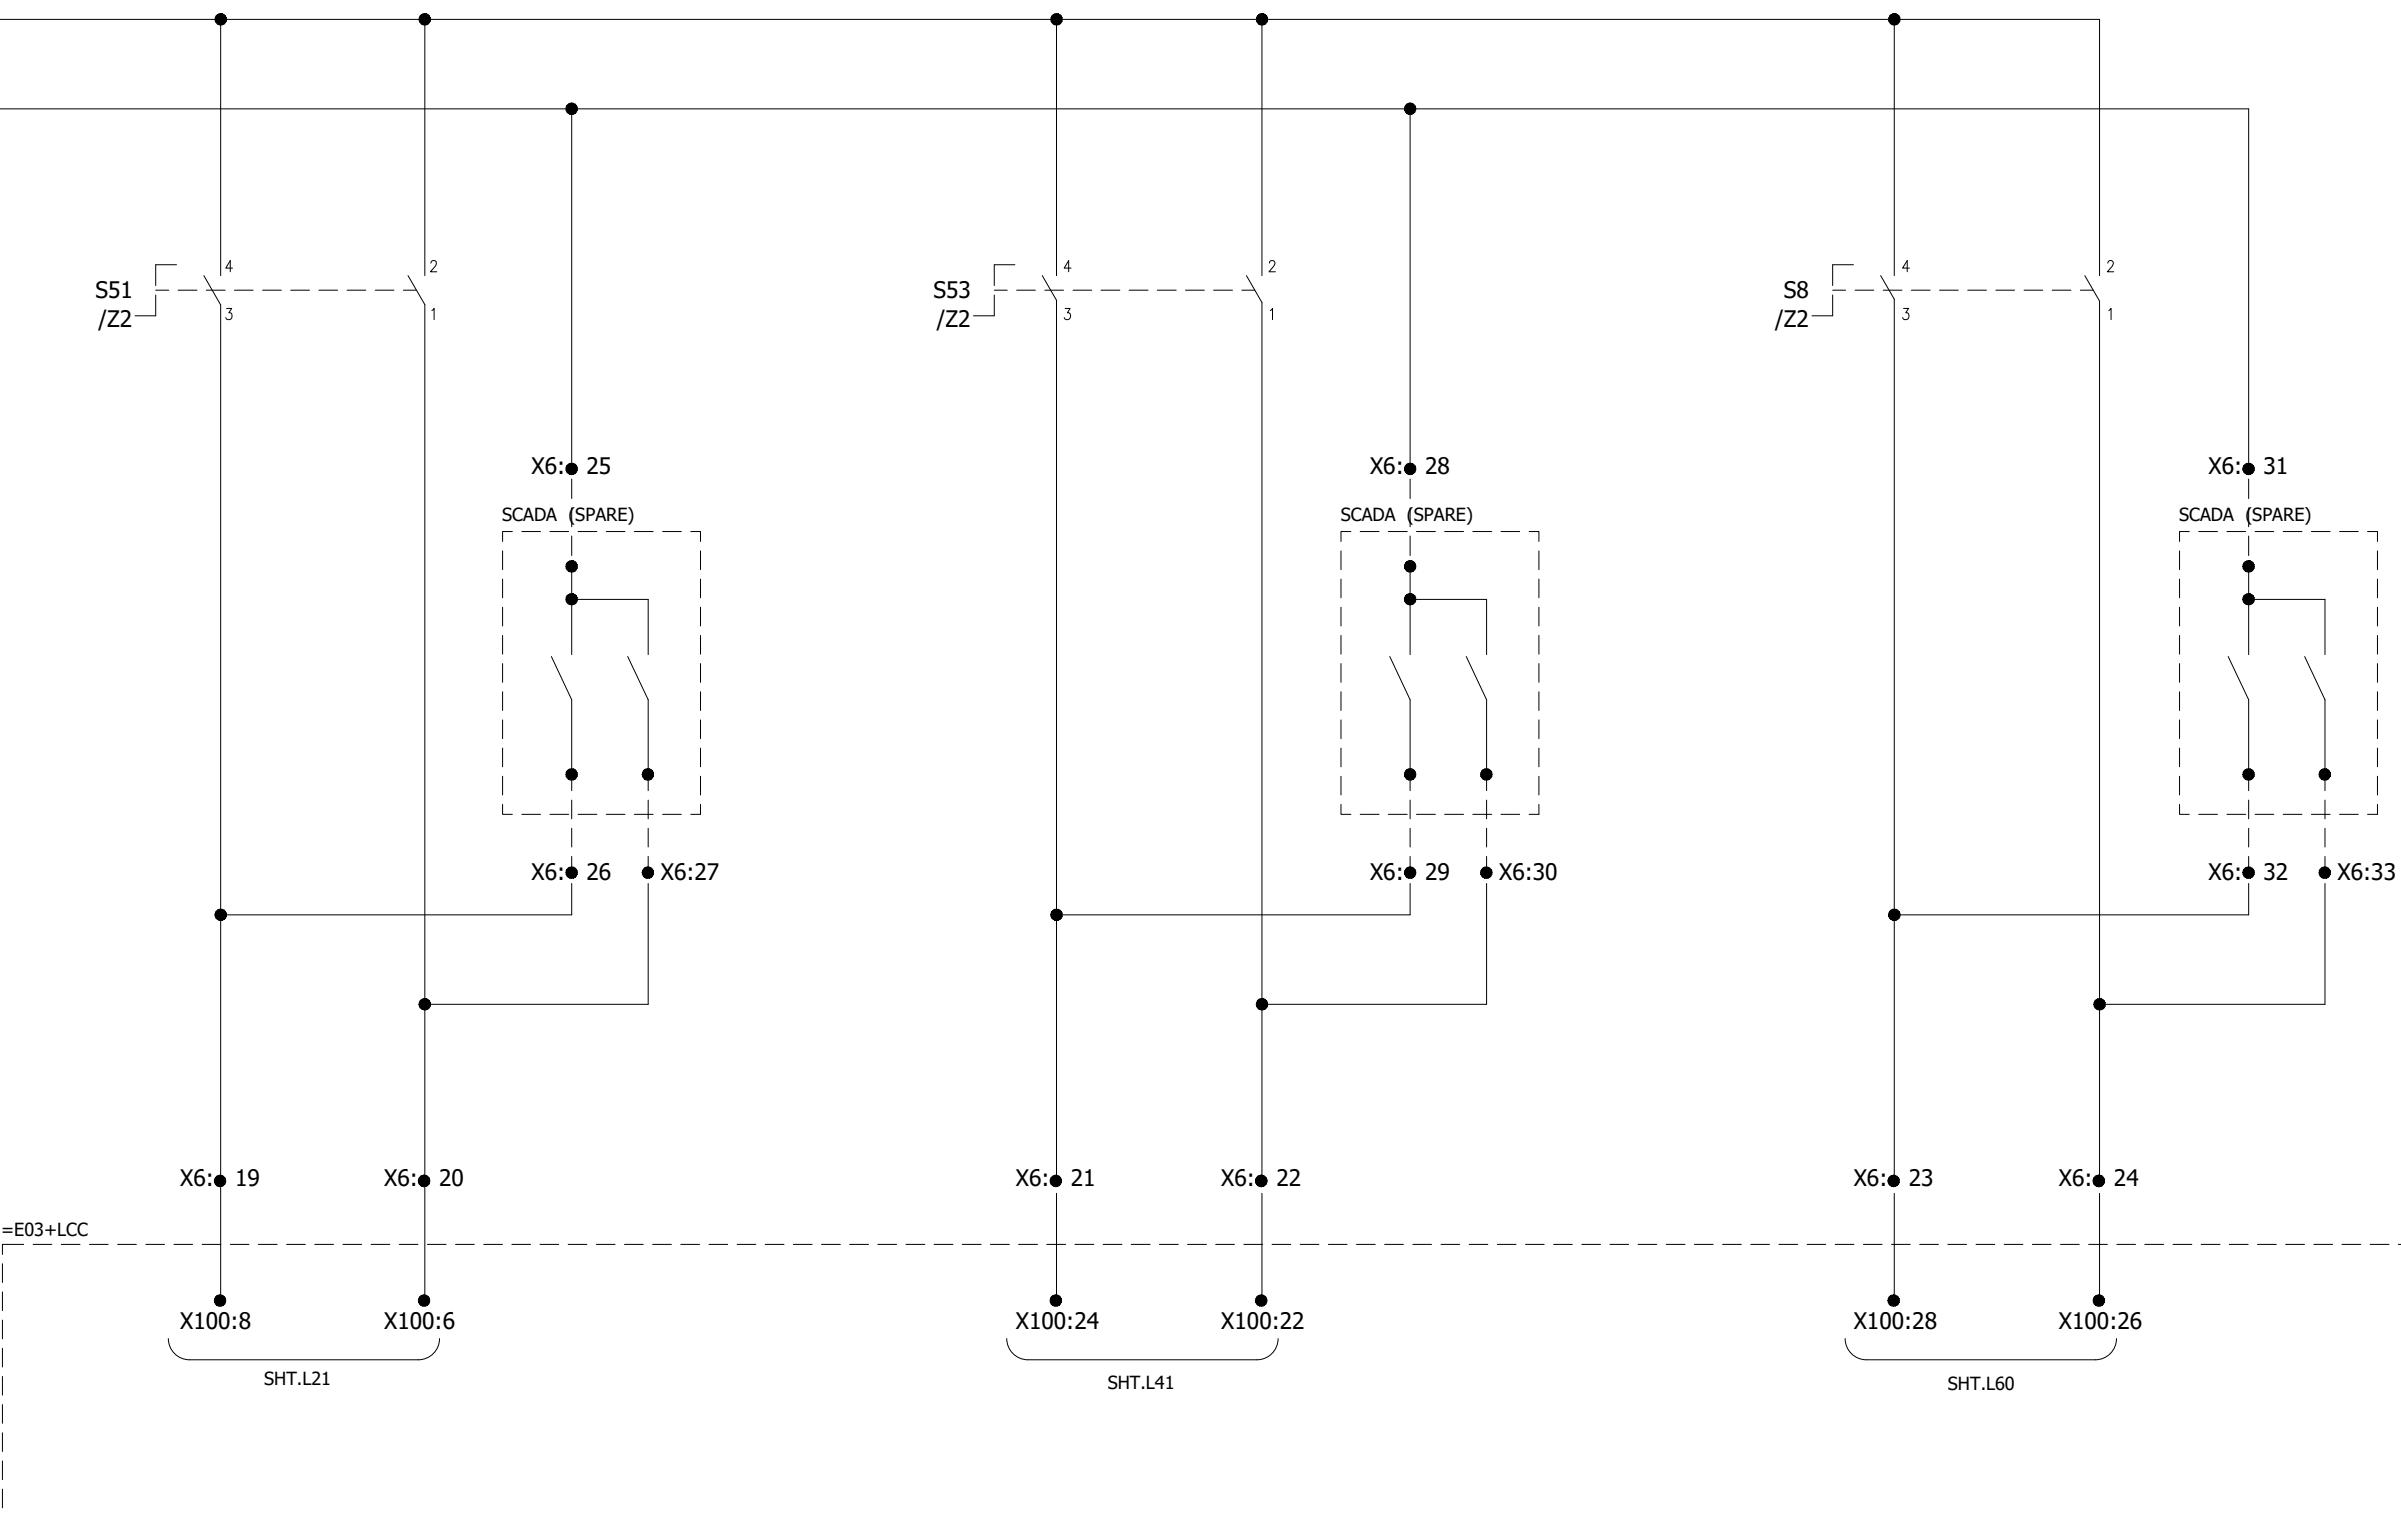

0	AS BUILT	19-10-2018	ASJ	Manufacturer  EPESOL 71-B Garden Block, New Garden Town, Lahore, Pakistan	Contractor  Grid Solutions <small>A GE and Alstom joint venture</small>	Client  NATIONAL TRANSMISSION & DISPATCH COMPANY LIMITED <small>(NTDC-WAPDA)</small>	Project 220kV/132kV GIS SUBSTATION GHAZI ROAD, LAHORE	Title 132kV LINE CONTROL PANEL <small>(=E03+CP31)</small> DISCONNECTOR & EARTH SWITCH CONTROL	Drawing no.		
									P60194-E-ELC-SC-002		
									Project no.	Sheet type	Sheet no.
REV.	DESCRIPTION	DATE	DRAWER						P-60194	I2	15

All information contained in this document is the exclusive property of GE GRID SOLUTIONS and shall not be used, copied or communicated to third parties without its prior authorization.


CONTACT
MULTIPLICATION

BUSBAR-1
ISOLATOR
=E03+Q1

BUSBAR-2
ISOLATOR
=E03+Q2

LINE
ISOLATOR
=E03+Q9

CIRCUIT
BREAKER
=E03+Q0

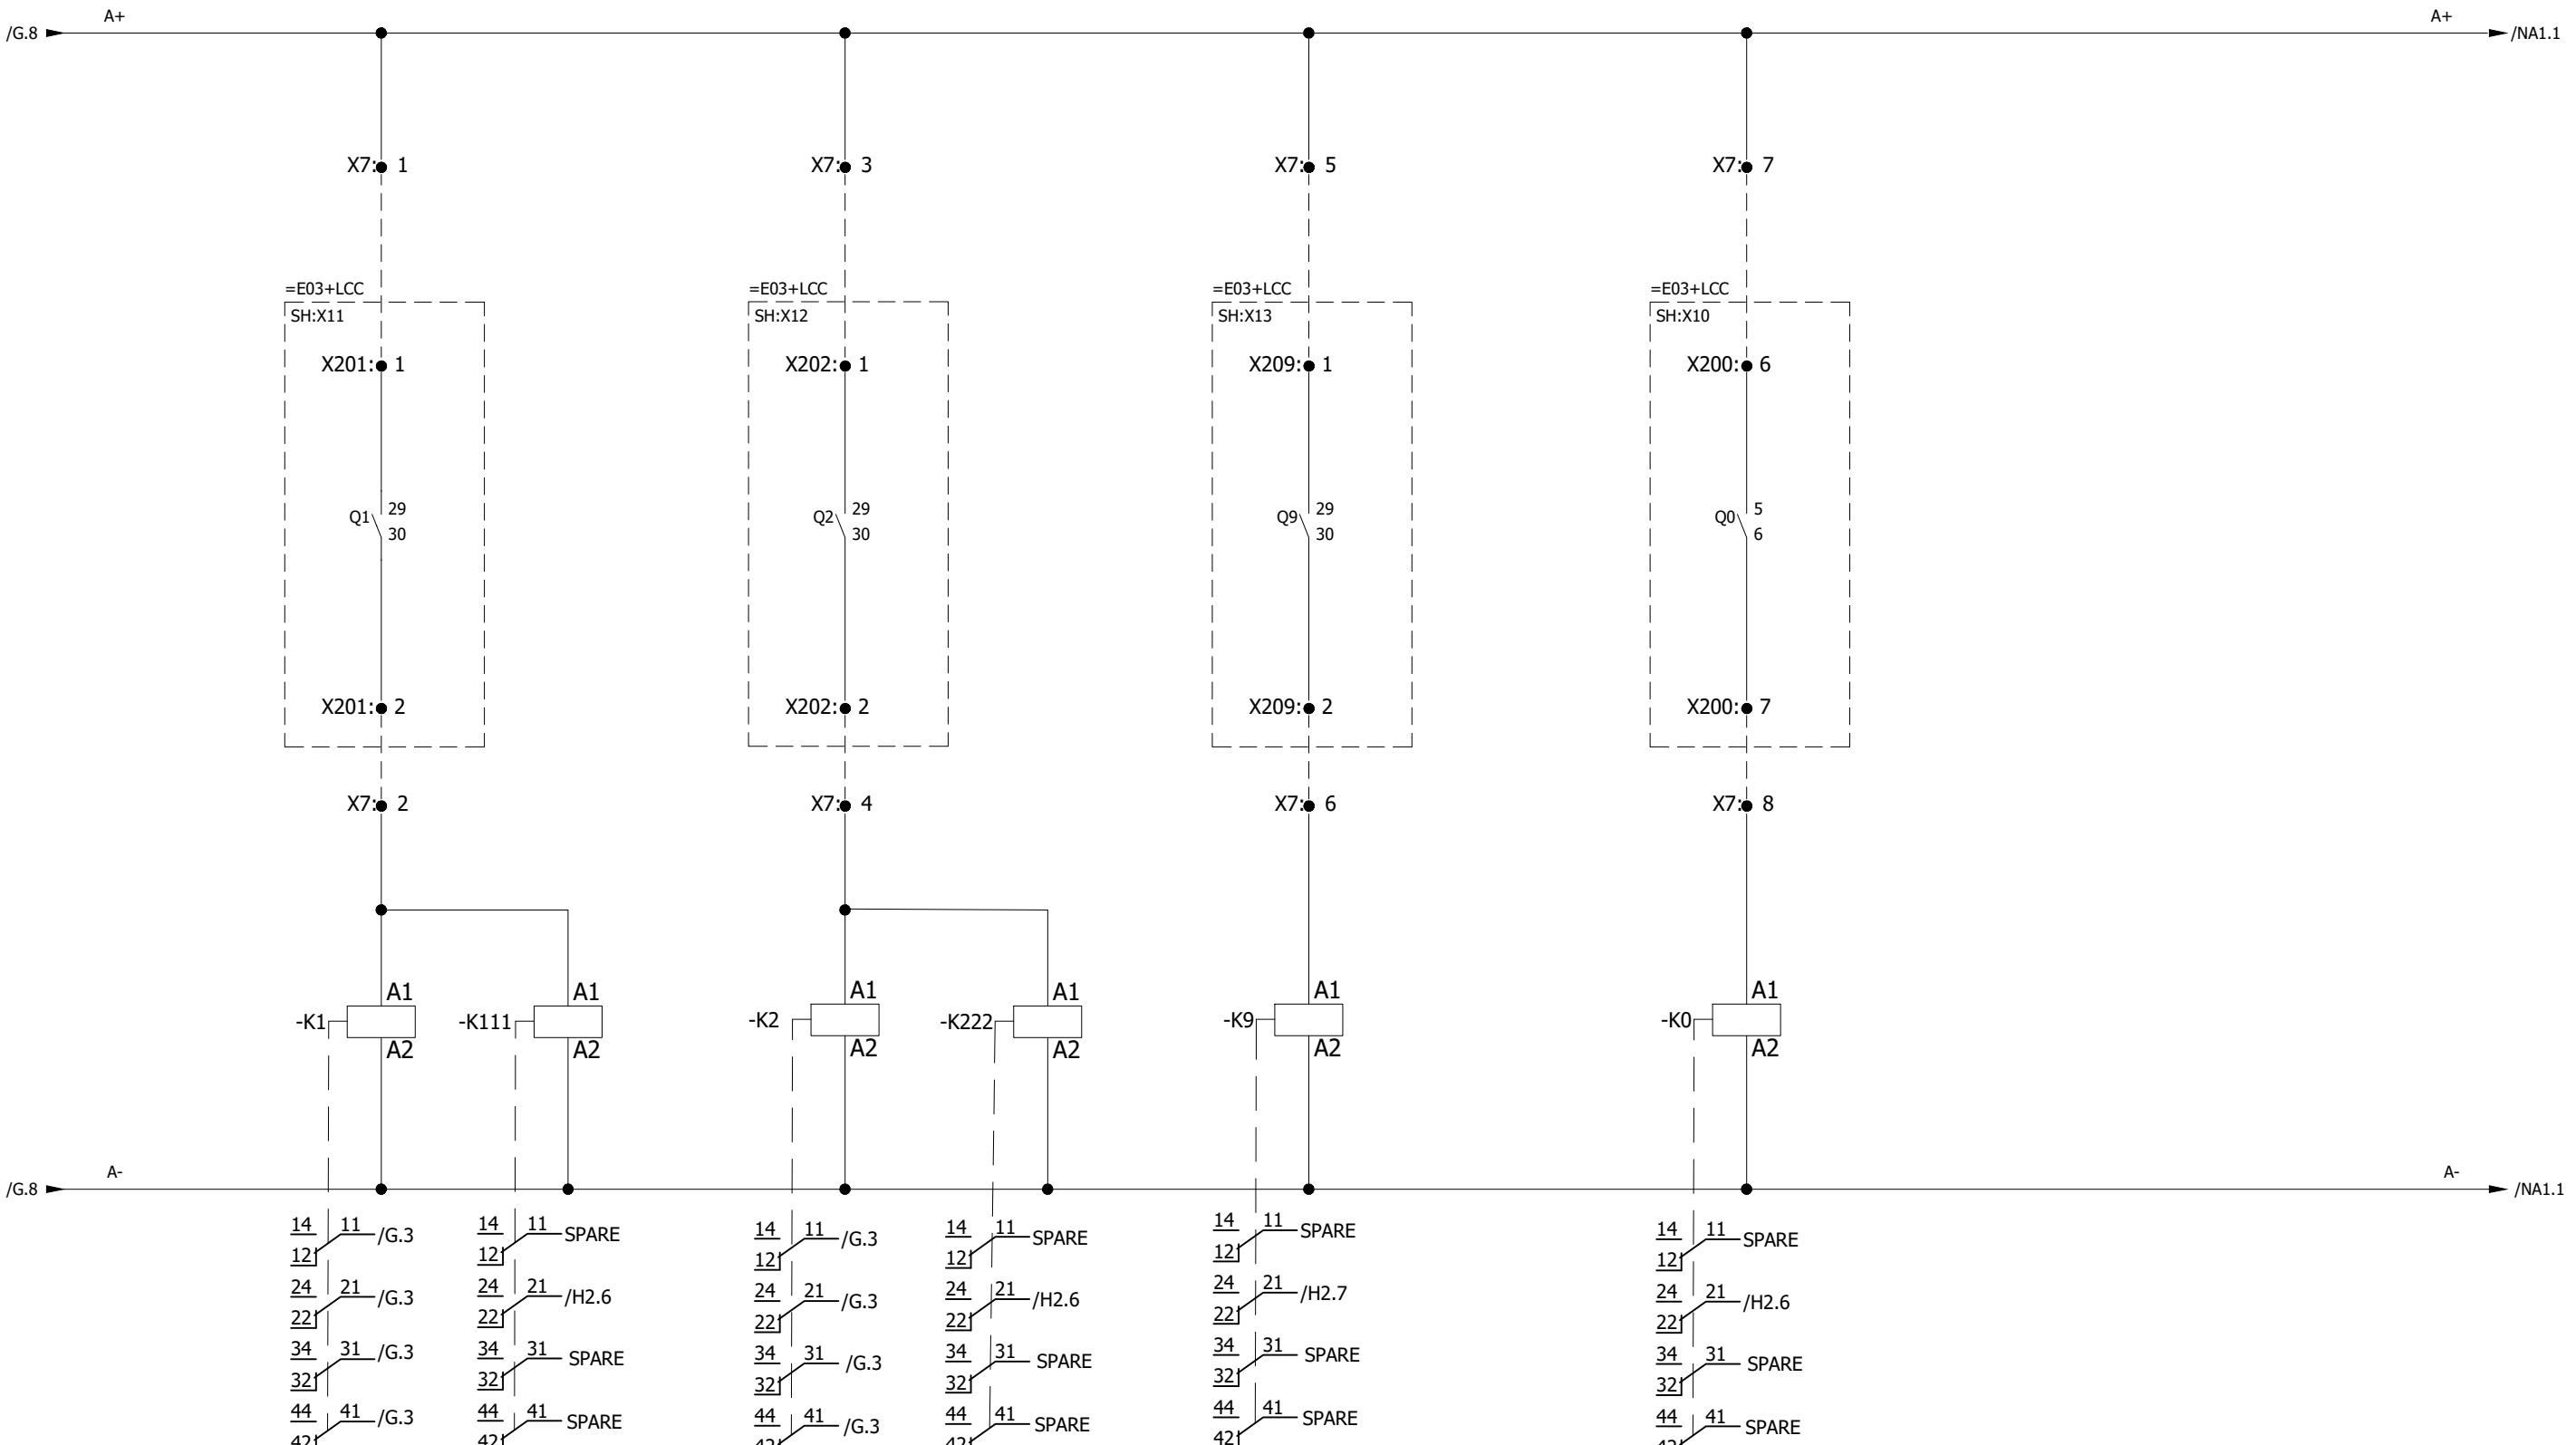

A

A

B

B

C

C

D

D

E

E

F

F

1

2

3

4

5


6



7


8

0	AS BUILT	19-10-2018	ASJ	Manufacturer	Contractor	Client	Project	Title	Drawing no.		
				EPEPSOL 71-B Garden Block, New Garden Town, Lahore, Pakistan	Grid Solutions A GE and Alstom joint venture	NATIONAL TRANSMISSION & DISPATCH COMPANY LIMITED (NTDC-WAPDA)	220kV/132kV GIS SUBSTATION GHAZI ROAD, LAHORE	132kV LINE CONTROL PANEL (=E03+CP31) CB/DISCONNECTOR CONTACT MULTIPLICATION	P60194-E-ELC-SC-002		
REV.	DESCRIPTION	DATE	DRAWER						Project no. P-60194	Sheet type K1	Sheet no. 16

 All information contained in this document is the exclusive property of GE GRID SOLUTIONS and shall not be used, copied or communicated to third parties without its prior authorization.

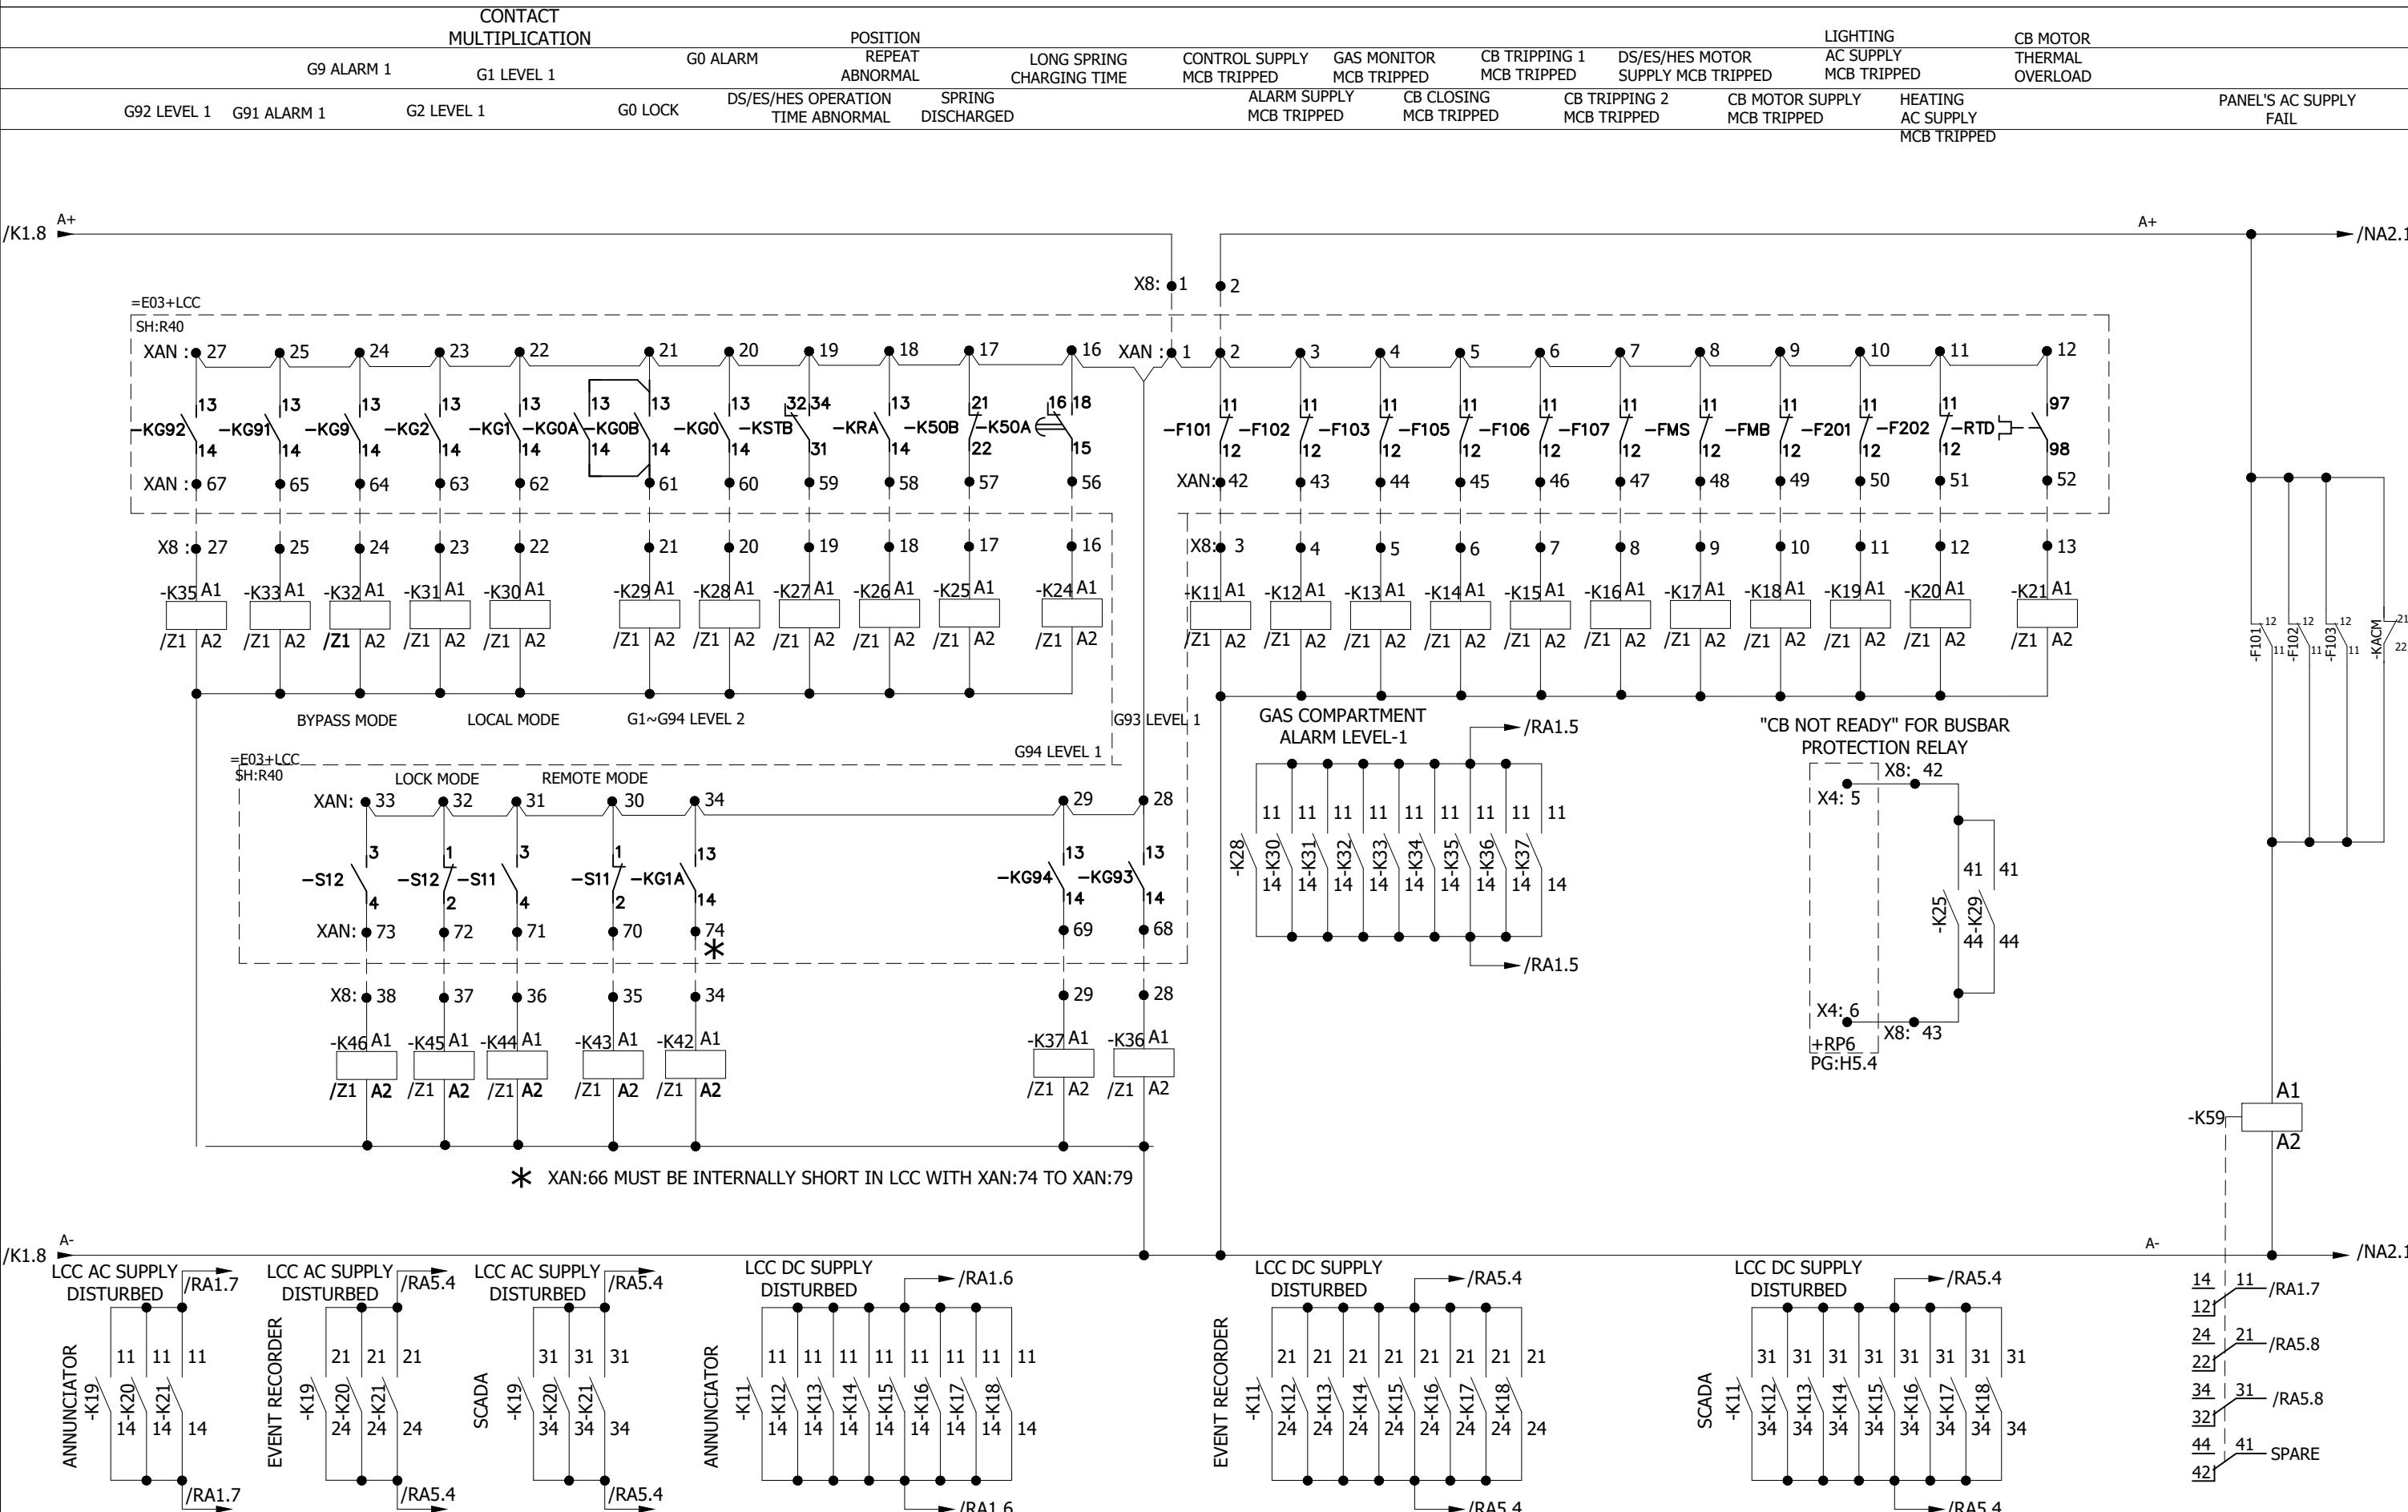


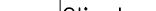0	AS BUILT	19-10-2018	ASJ	Manufacturer  EPESOL 71-B Garden Block, New Garden Town, Lahore, Pakistan	Contractor  Grid Solutions A GE and Alstom joint venture	Client  NATIONAL TRANSMISSION & DISPATCH COMPANY LIMITED (NTDC-WAPDA)	Project 220KV/132kV GIS SUBSTATION GHAZI ROAD, LAHORE	Title 132kV LINE CONTROL PANEL (=E03+CP31) ALARM MULTIPLICATION	Drawing no. P60194-E-ELC-SC-002		
REV.	DESCRIPTION	DATE	DRAWER						Project no. P-60194	Sheet type NA1	Sheet no. 17

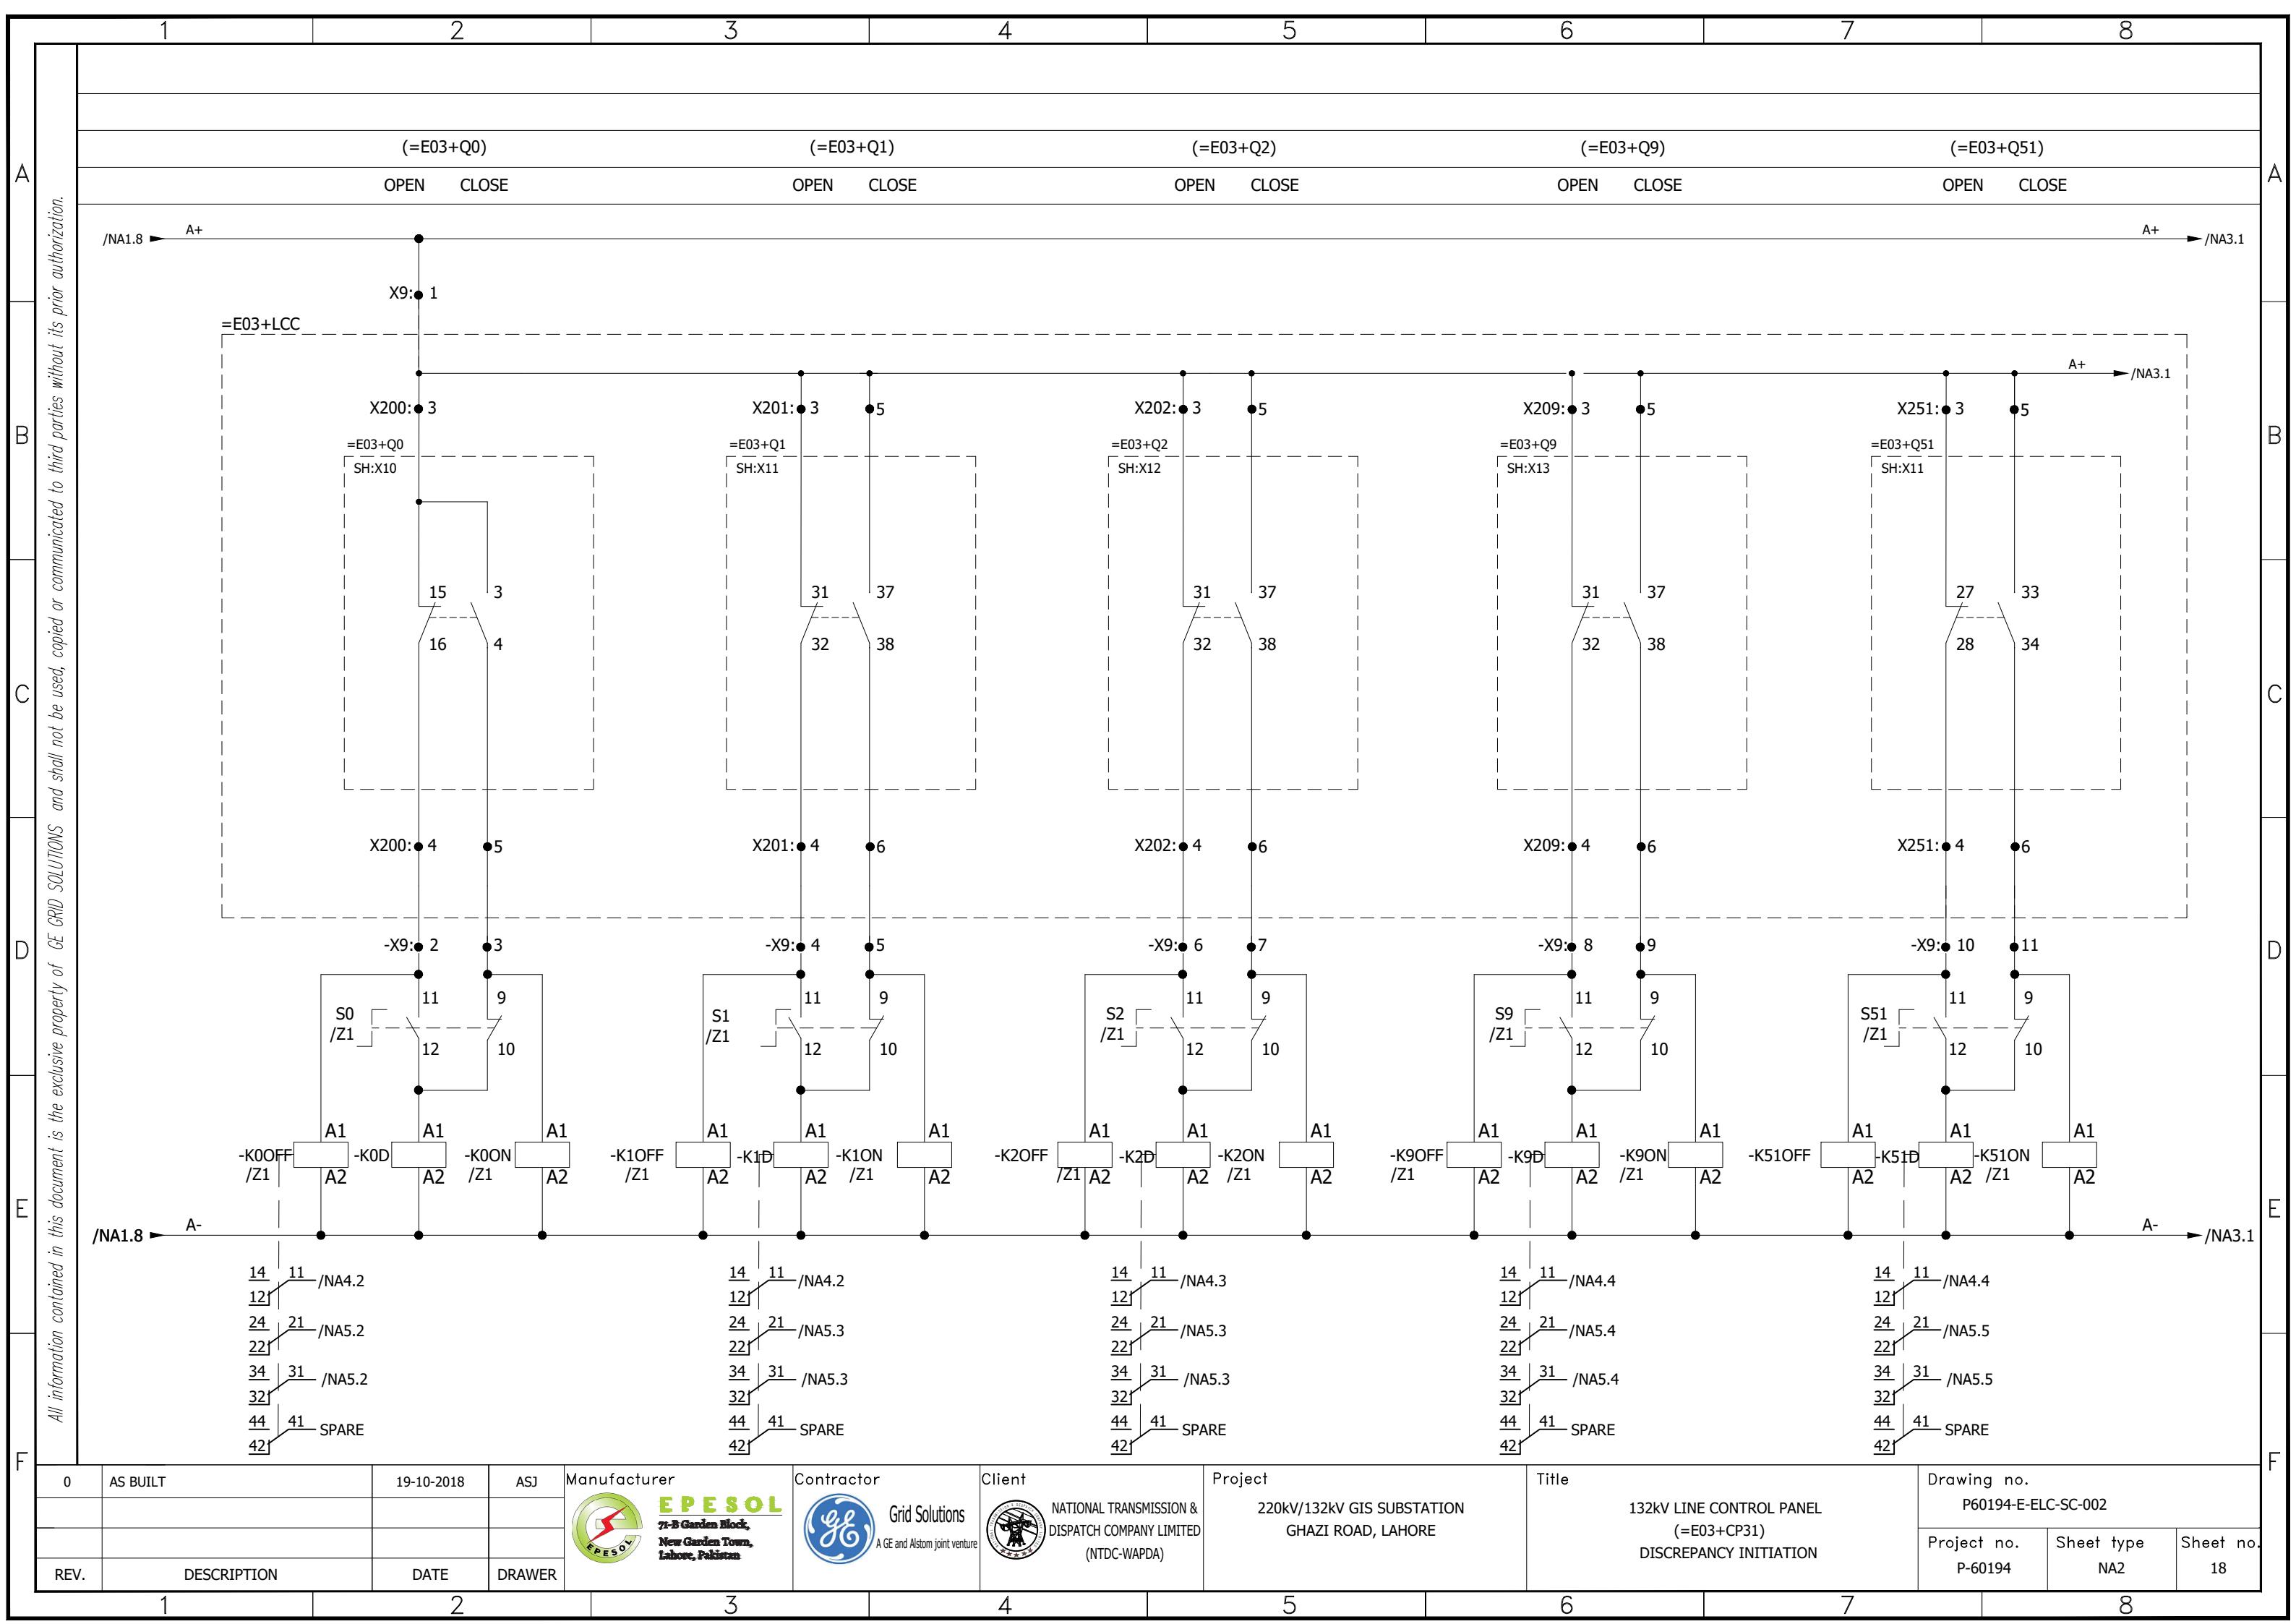

1 2 3 4 5 6 7 8

OFF/ON (=E03+Q0)	OFF/ON (=E03+Q1)	OFF/ON (=E03+Q2)	OFF/ON (=E03+Q9)	OFF/ON (=E03+Q51)	OFF/ON (=E03+Q53)	OFF/ON (=E03+Q8)	CIRCUIT BREAKER OPERATION COUNTER (-Q10)
---------------------	---------------------	---------------------	---------------------	----------------------	----------------------	---------------------	--

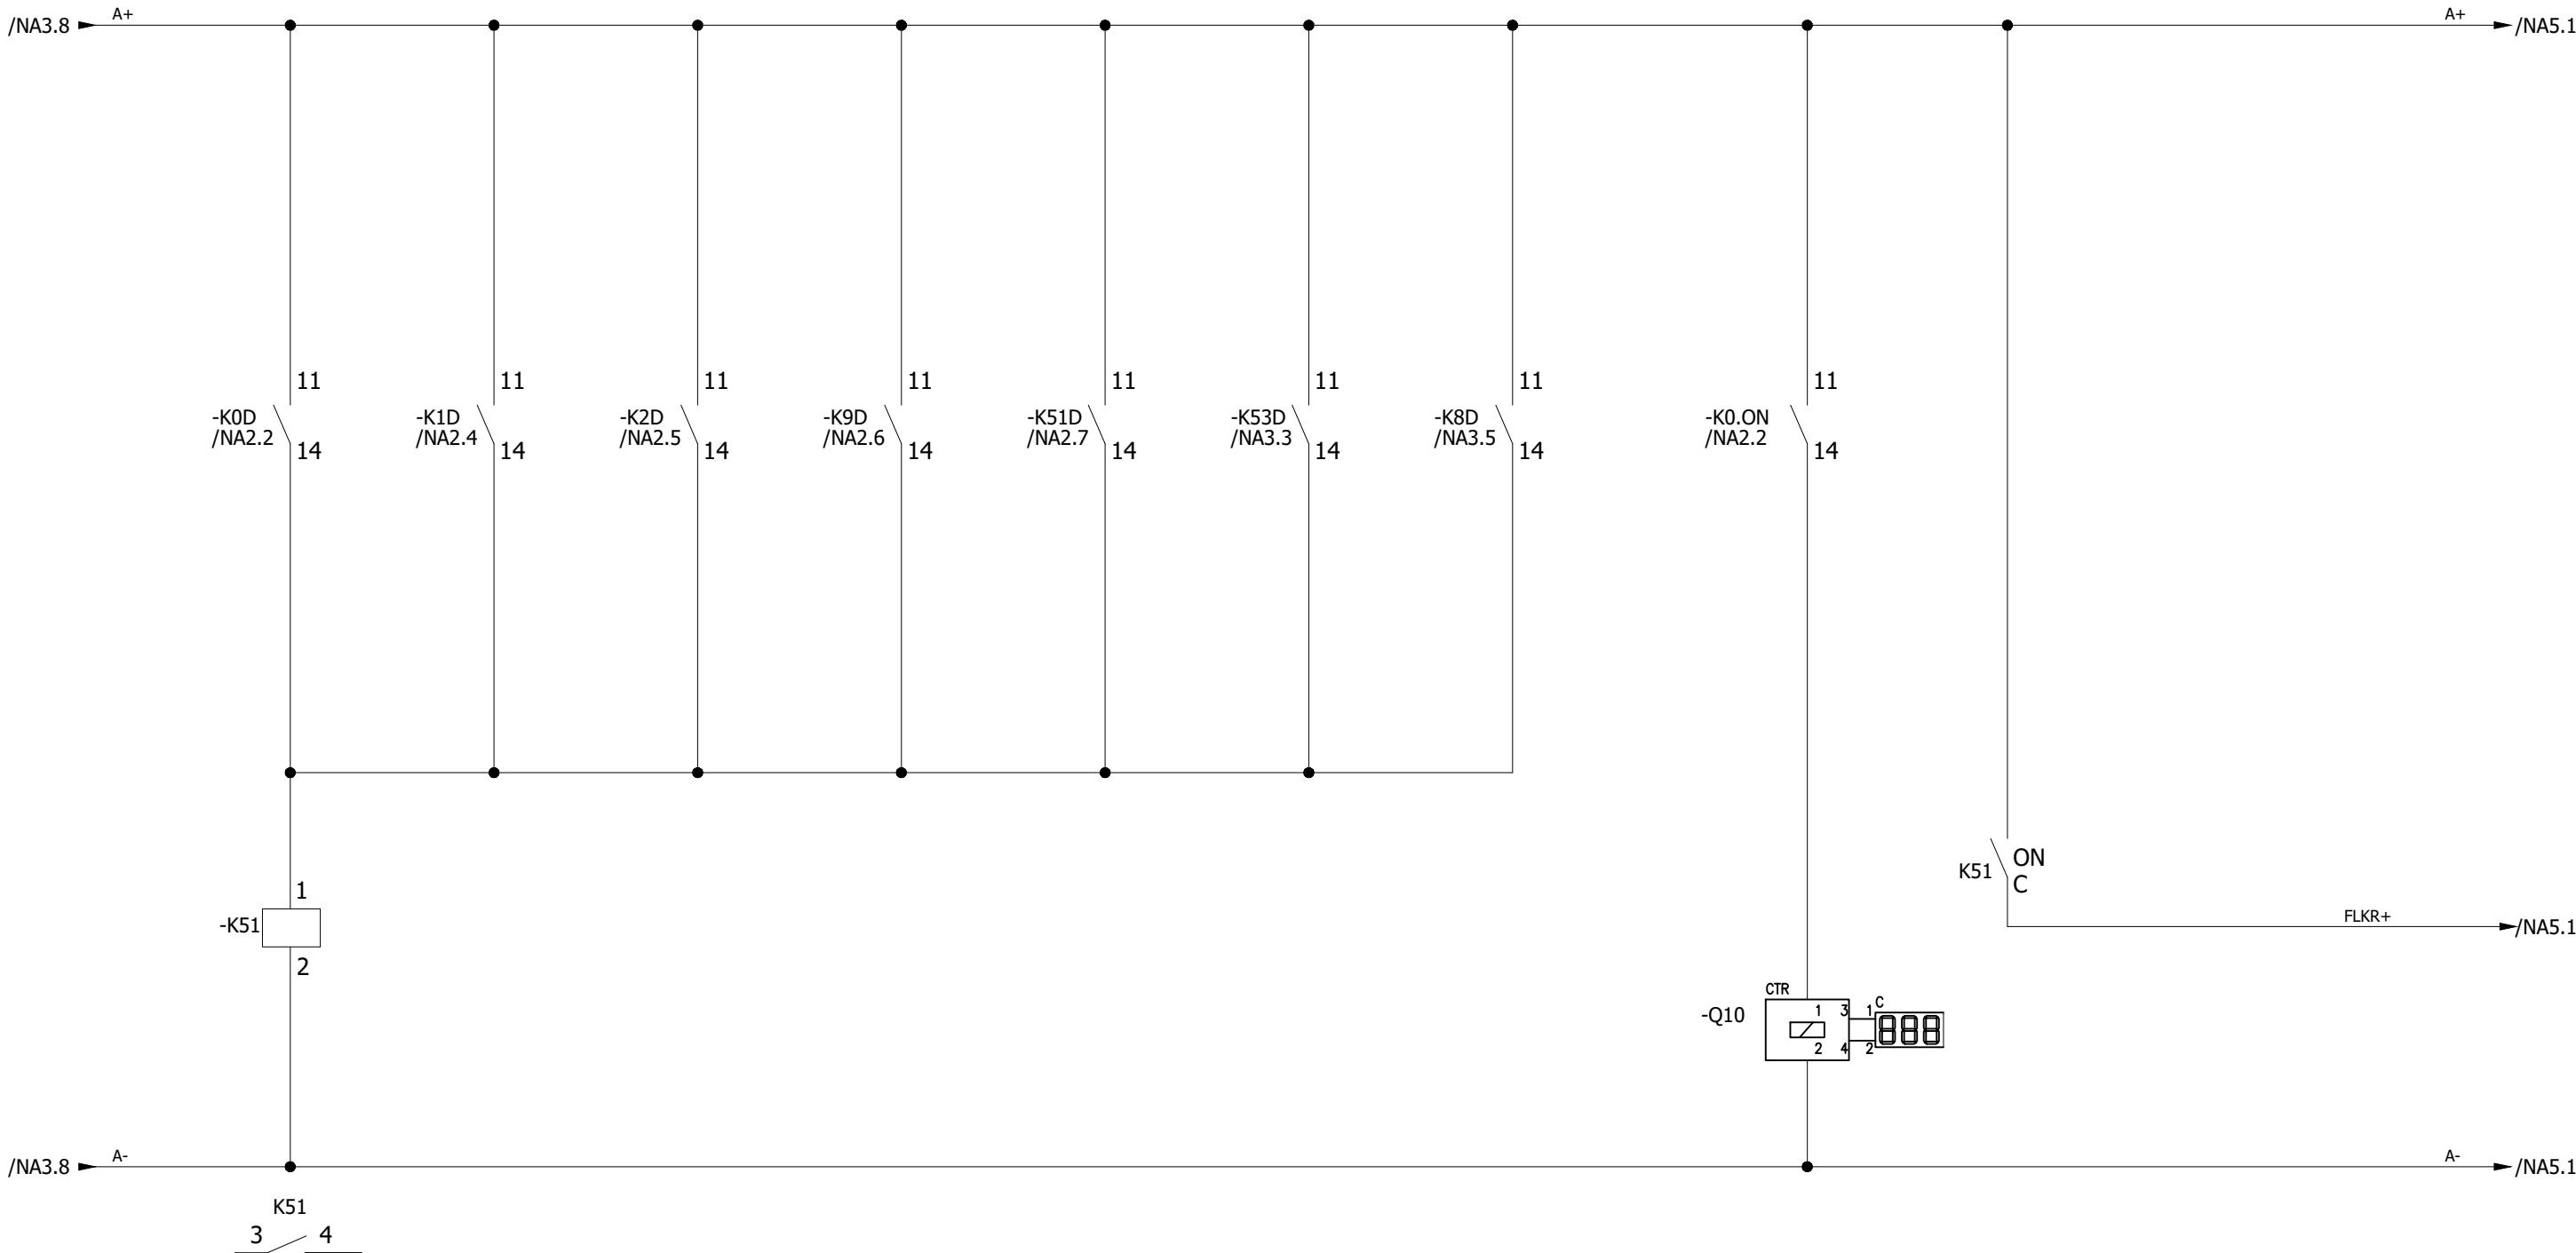

0	AS BUILT	19-10-2018	ASJ	Manufacturer  EPESOL 71-B Garden Block, New Garden Town, Lahore, Pakistan	Contractor  Grid Solutions A GE and Alstom joint venture	Client  NATIONAL TRANSMISSION & DISPATCH COMPANY LIMITED (NTDC-WAPDA)	Project 220kV/132kV GIS SUBSTATION GHAZI ROAD, LAHORE	Title 132kV LINE CONTROL PANEL (=E03+CP31) DISCREPANCY INITIATION	Drawing no. P60194-E-ELC-SC-002
REV.	DESCRIPTION	DATE	DRAWER						Project no. P-60194
									Sheet type NA4
									Sheet no. 20

1 2 3 4 5 6 7 8

1

2

3

4

5


6

7


8

(=E03+Q0) (=E03+Q1) (=E03+Q2) (=E03+Q9) (=E03+Q51) (=E03+Q53) (=E03+Q8)

All information contained in this document is the exclusive property of GE GRID SOLUTIONS and shall not be used, copied or communicated to third parties without its prior authorization.

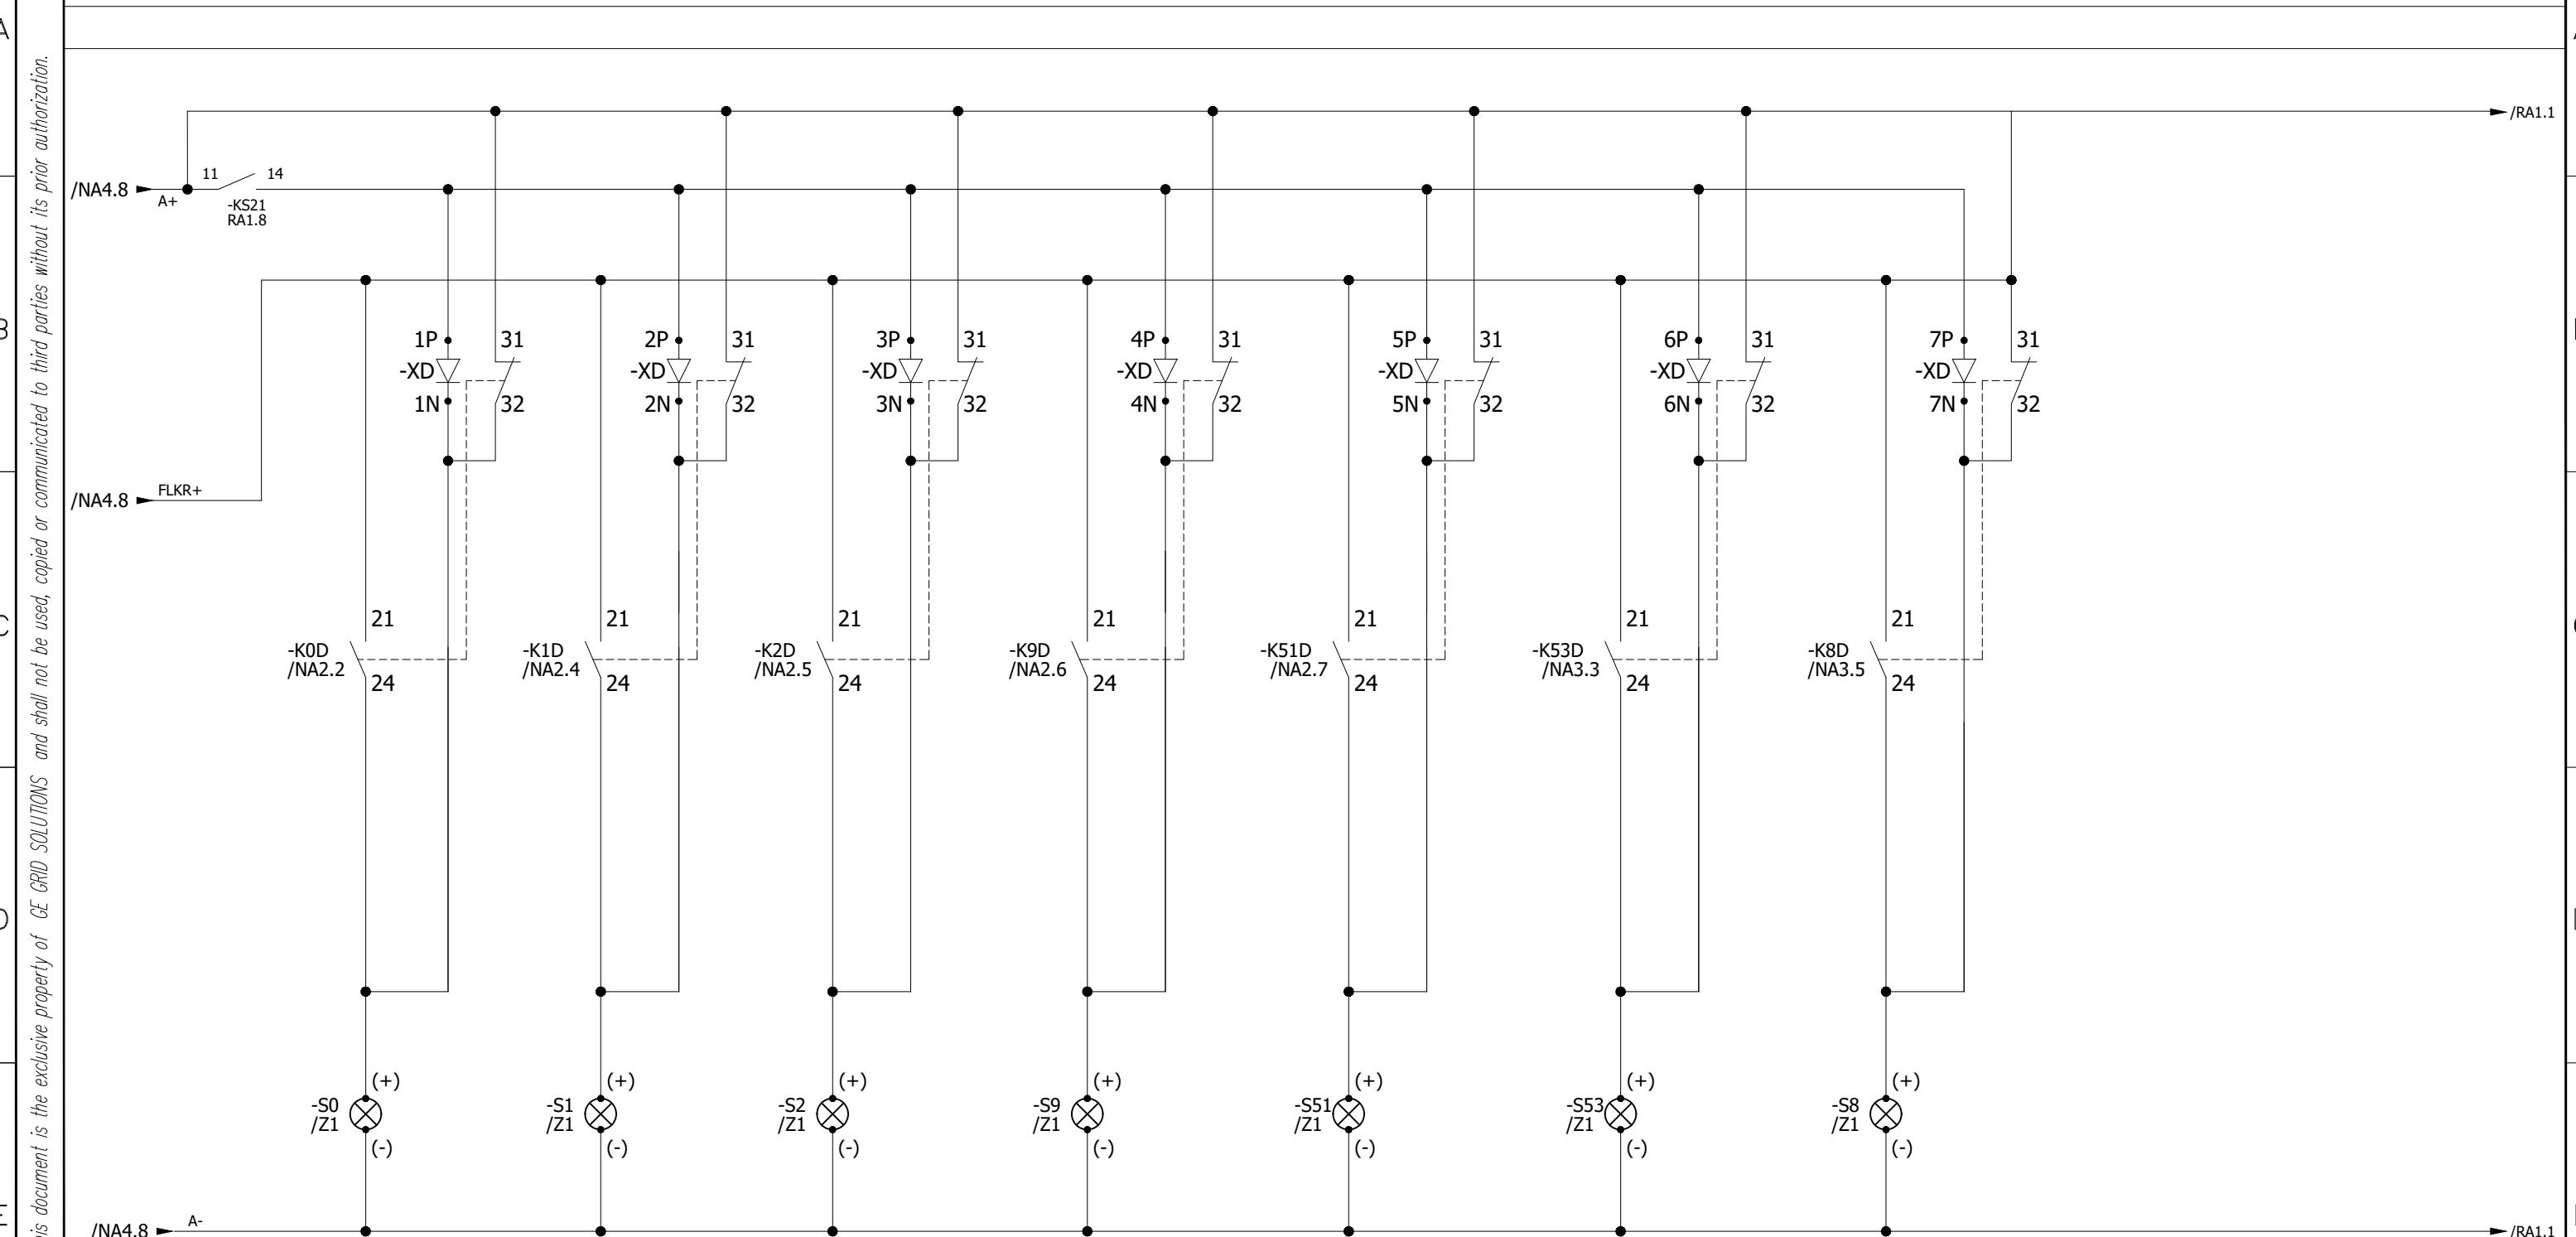


0	AS BUILT		19-10-2018	ASJ	Manufacturer  EPESOL 71-B Garden Block, New Garden Town, Lahore, Pakistan	Contractor  Grid Solutions A GE and Alstom joint venture	Client  NATIONAL TRANSMISSION & DISPATCH COMPANY LIMITED (NTDC-WAPDA)	Project 220KV/132KV GIS SUBSTATION GHAZI ROAD, LAHORE	Title 132KV LINE CONTROL PANEL (=E03+CP31) DISCREPANCY INDICATIONS	Drawing no. P60194-E-ELC-SC-002		
REV.	DESCRIPTION		DATE	DRAWER						Project no. P-60194	Sheet type NA5	Sheet no. 21
1	2	3	4	5	6	7	8					

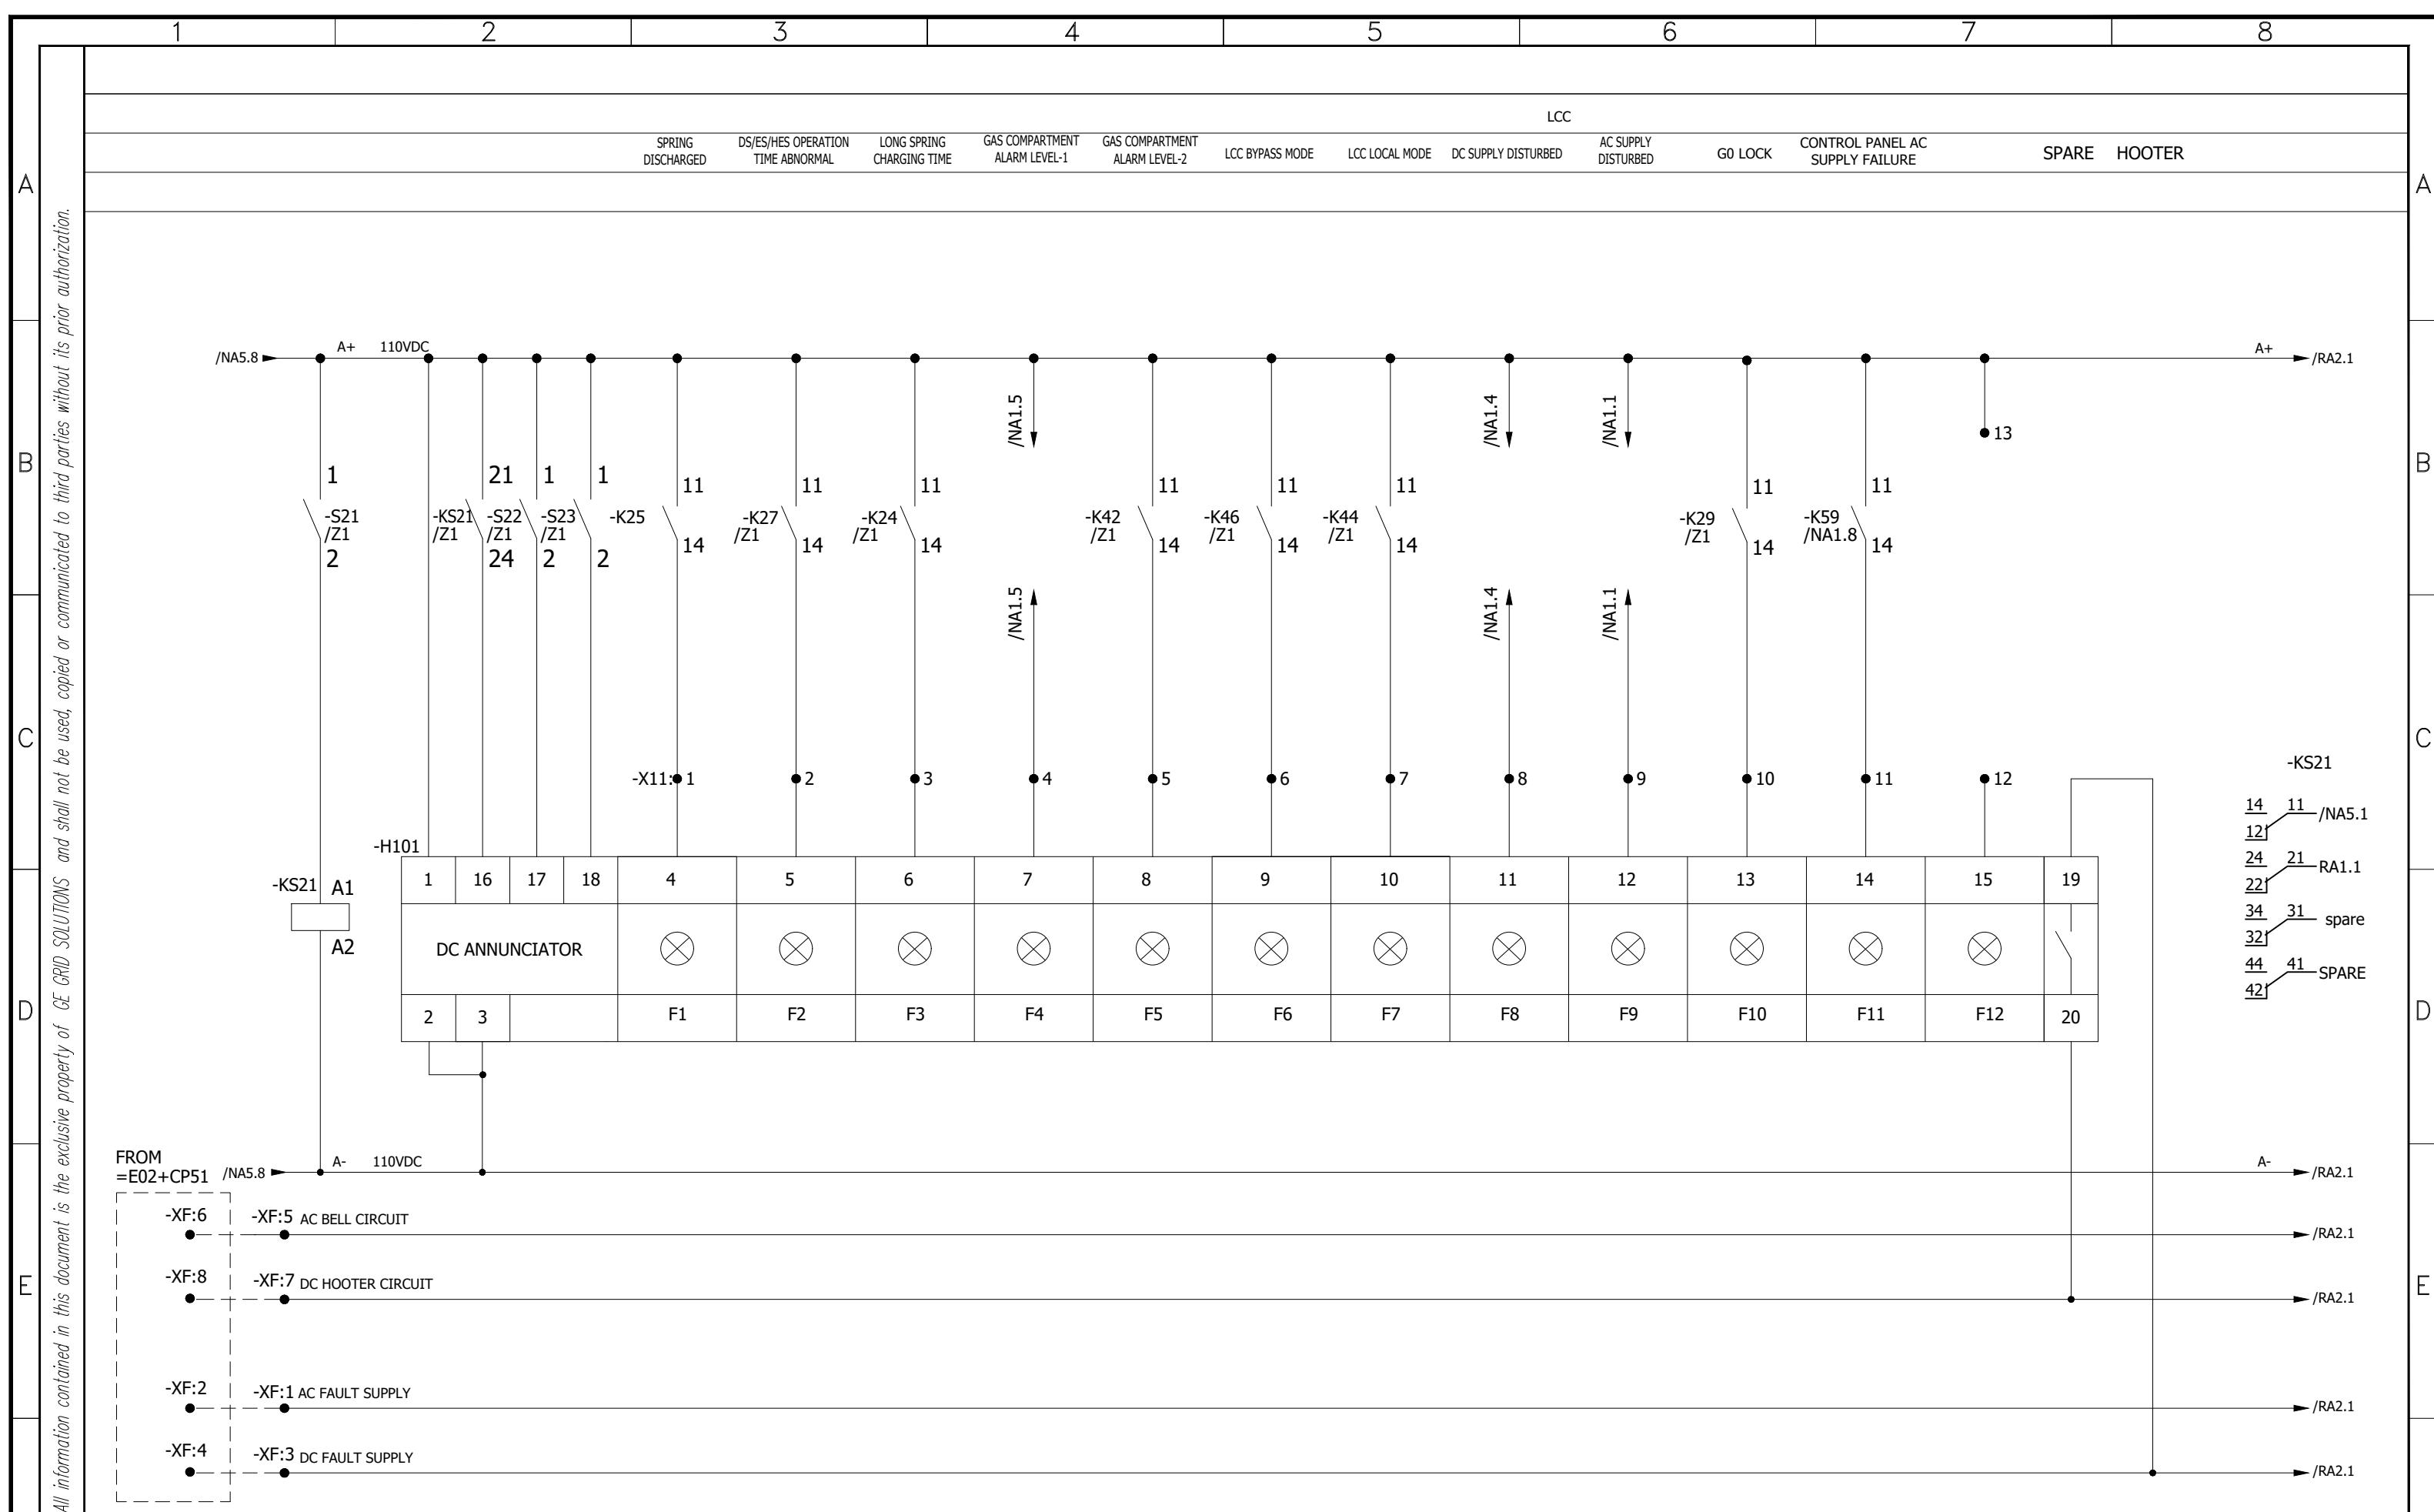

All information contained in this document is the exclusive property of GE GRID SOLUTIONS and shall not be used, copied or communicated to third parties without its prior authorization.


RED PHASE TRIP	YELLOW PHASE TRIP	BLUE PHASE TRIP	ZONE-1 TRIP	ZONE-2/3 TRIP	SPARE	POWER SWING DETECTED	SOTF OPERATED	AUTORECLOSE OPERATED	AUTORECLOSE BLOCKED	LINE DIFFERENTIAL PROTECTION	SPARE	HOOTER
											RELAY FAULTY	

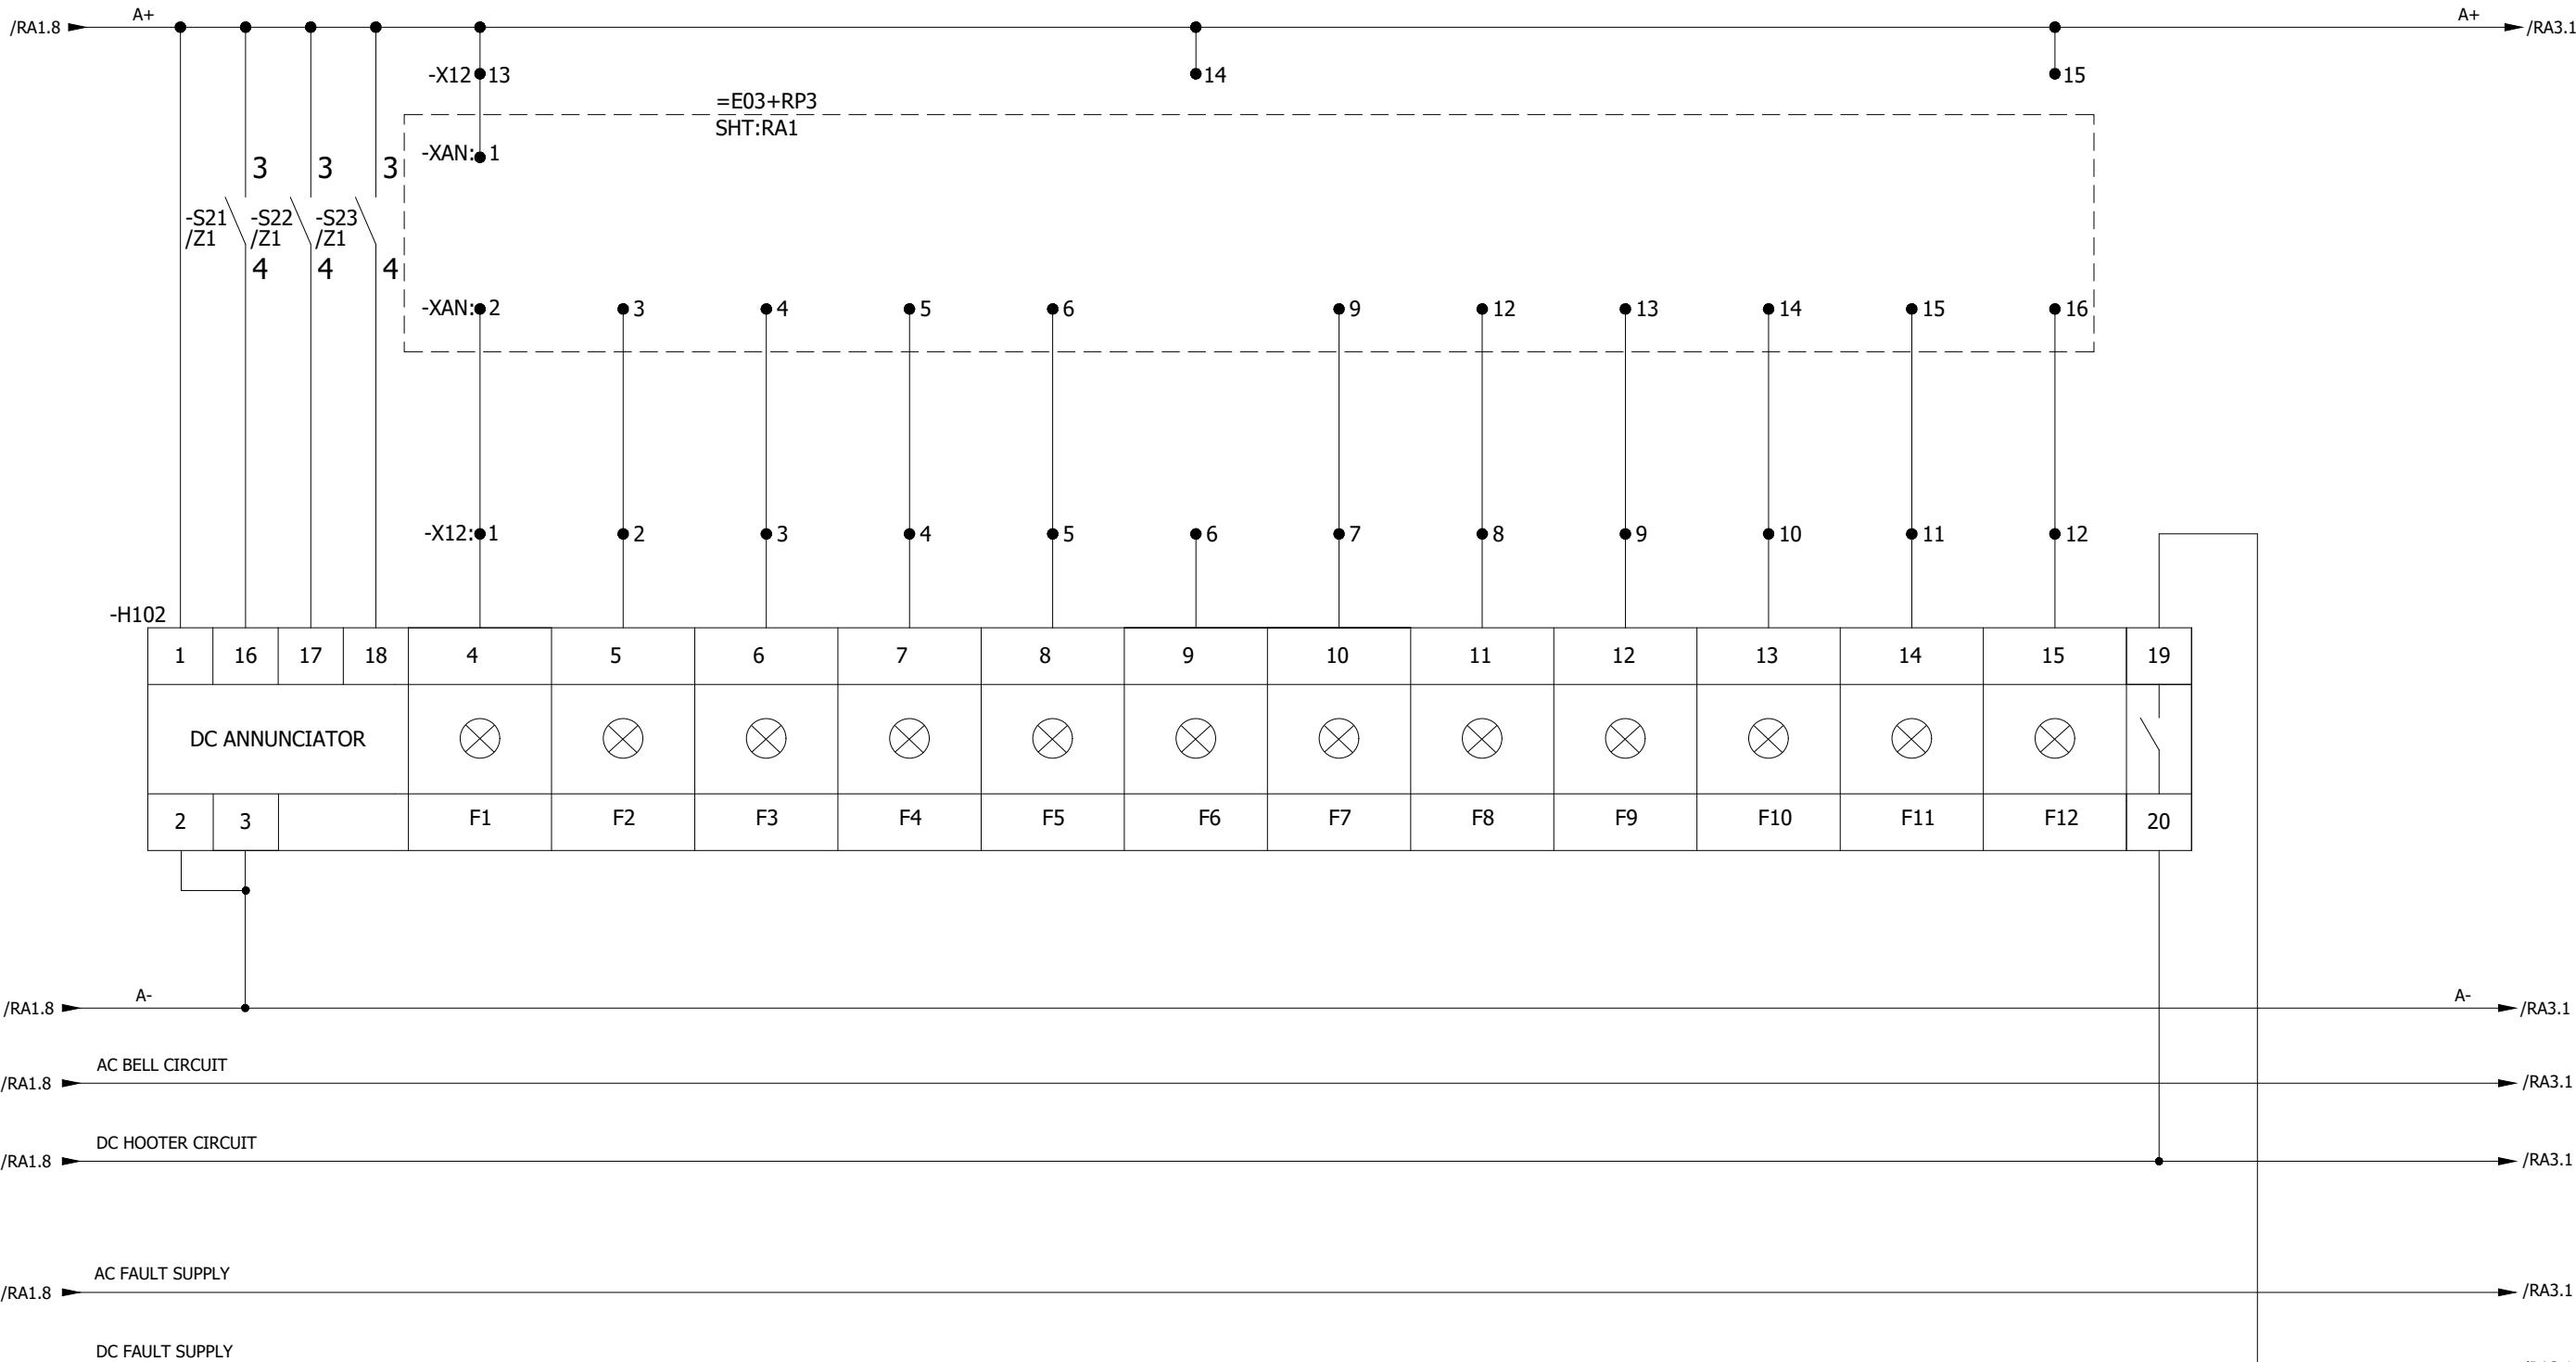

0	AS BUILT	19-10-2018	ASJ	Manufacturer  EPESOL 71-B Garden Block, New Garden Town, Lahore, Pakistan	Contractor  GE Grid Solutions A GE and Alstom joint venture	Client  NATIONAL TRANSMISSION & DISPATCH COMPANY LIMITED (NTDC-WAPDA)	Project 220kV/132kV GIS SUBSTATION GHAZI ROAD, LAHORE	Title 132kV LINE CONTROL PANEL (=E03+CP31) ANNUNCIATOR-2 CIRCUIT	Drawing no. P60194-E-ELC-SC-002		
REV.	DESCRIPTION	DATE	DRAWER						Project no. P-60194	Sheet type RA2	Sheet no. 23
1	2	3	4	5	6	7	8	9	10	11	12

BUS VT
SECONDARY CIRCUIT
MCB UNHEALTHY O/C & E/F PROT.
RELAY FAULTY SPARE LINE RELAY PANEL 230VAC
CIRCUIT/SUPPLY FAULTY TRIP CIRCUIT-1
FAULTY TRIP CIRCUIT-2
FAULTY O/C & E/F PROT.
OPERATED DTT
SEND CBF STG-1
OPERATED SPARE SPARE SPARE HOOTER


All information contained in this document is the exclusive property of GE GRID SOLUTIONS and shall not be used, copied or communicated to third parties without its prior authorization.

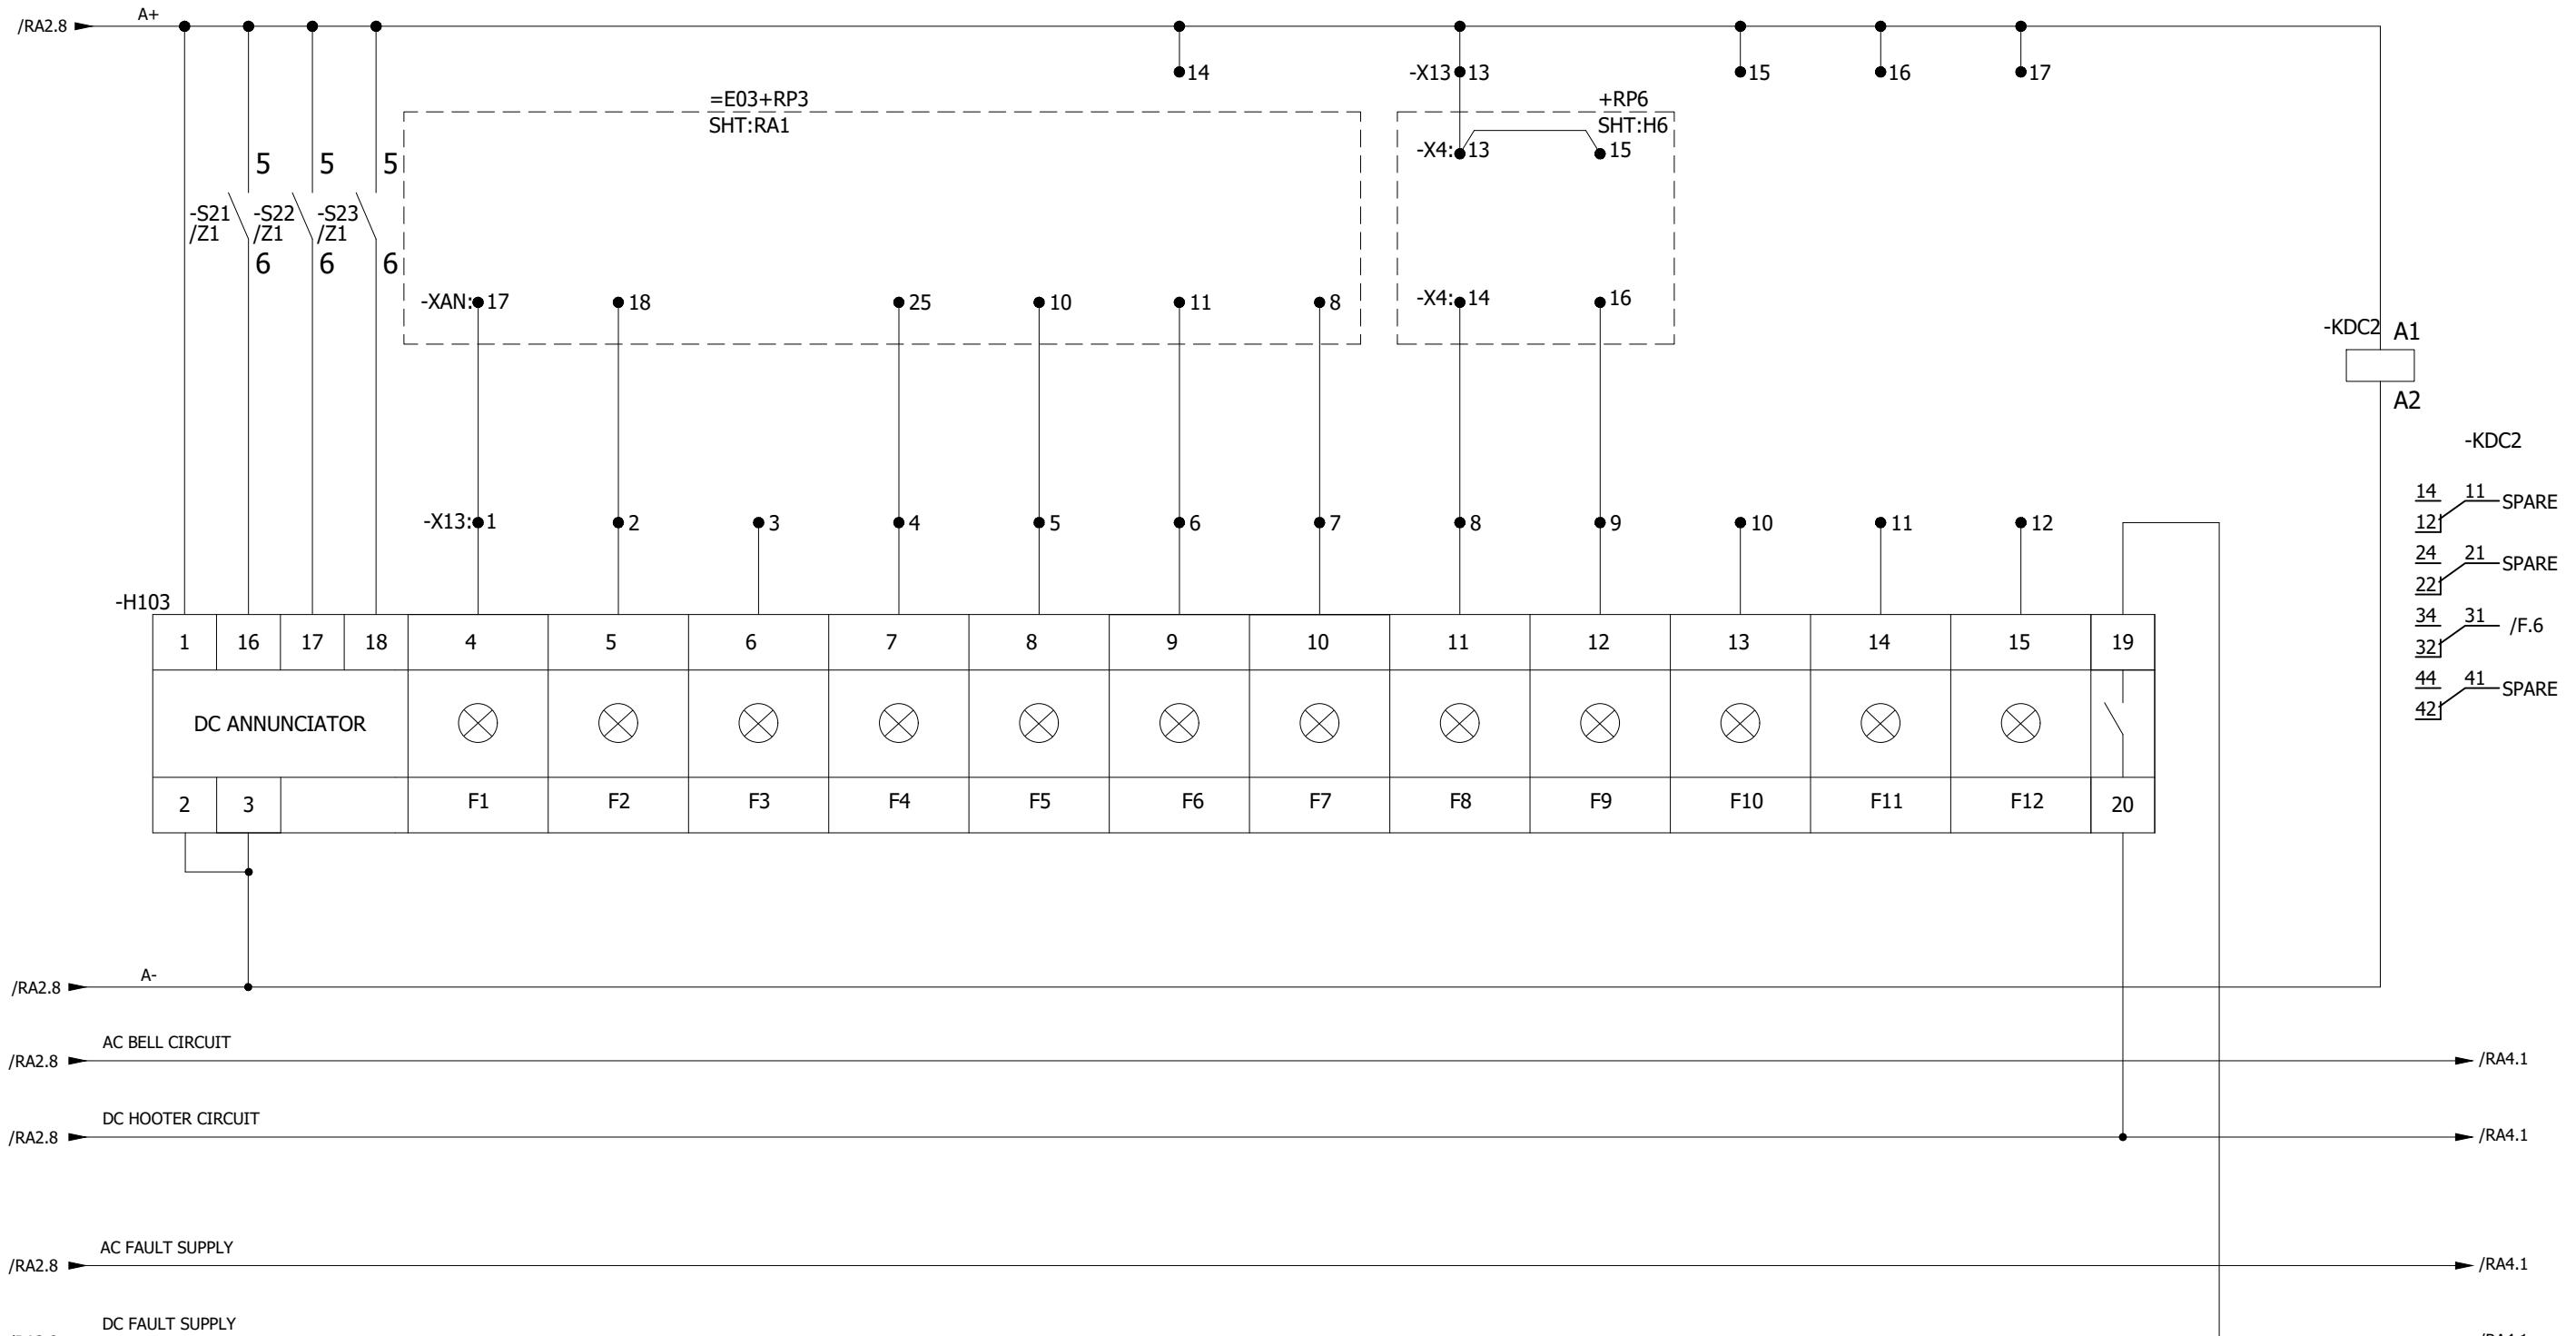

0	AS BUILT	19-10-2018	ASJ	Manufacturer  EPE SOL 7-B Garden Block, New Garden Town, Lahore, Pakistan	Contractor  Grid Solutions A GE and Alstom joint venture	Client  NATIONAL TRANSMISSION & DISPATCH COMPANY LIMITED (NTDC-WAPDA)	Project 220kV/132kV GIS SUBSTATION GHAZI ROAD, LAHORE	Title 132kV LINE CONTROL PANEL (=E03+CP31) ANNUNCIATOR-3 CIRCUIT	Drawing no. P60194-E-ELC-SC-002
REV.	DESCRIPTION	DATE	DRAWER						Project no. P-60194
									Sheet type RA3
									Sheet no. 24



All information contained in this document is the exclusive property of GE GRID SOLUTIONS and shall not be used, copied or communicated to third parties without its prior authorization.

LINE RELAY PANEL
110VDC
CIRCUIT/SUPPLY FAULTY SPARE SPARE SPARE SPARE SPARE SPARE CONTROL PANEL
DC FAIL SPARE SPARE SPARE SPARE AC BELL

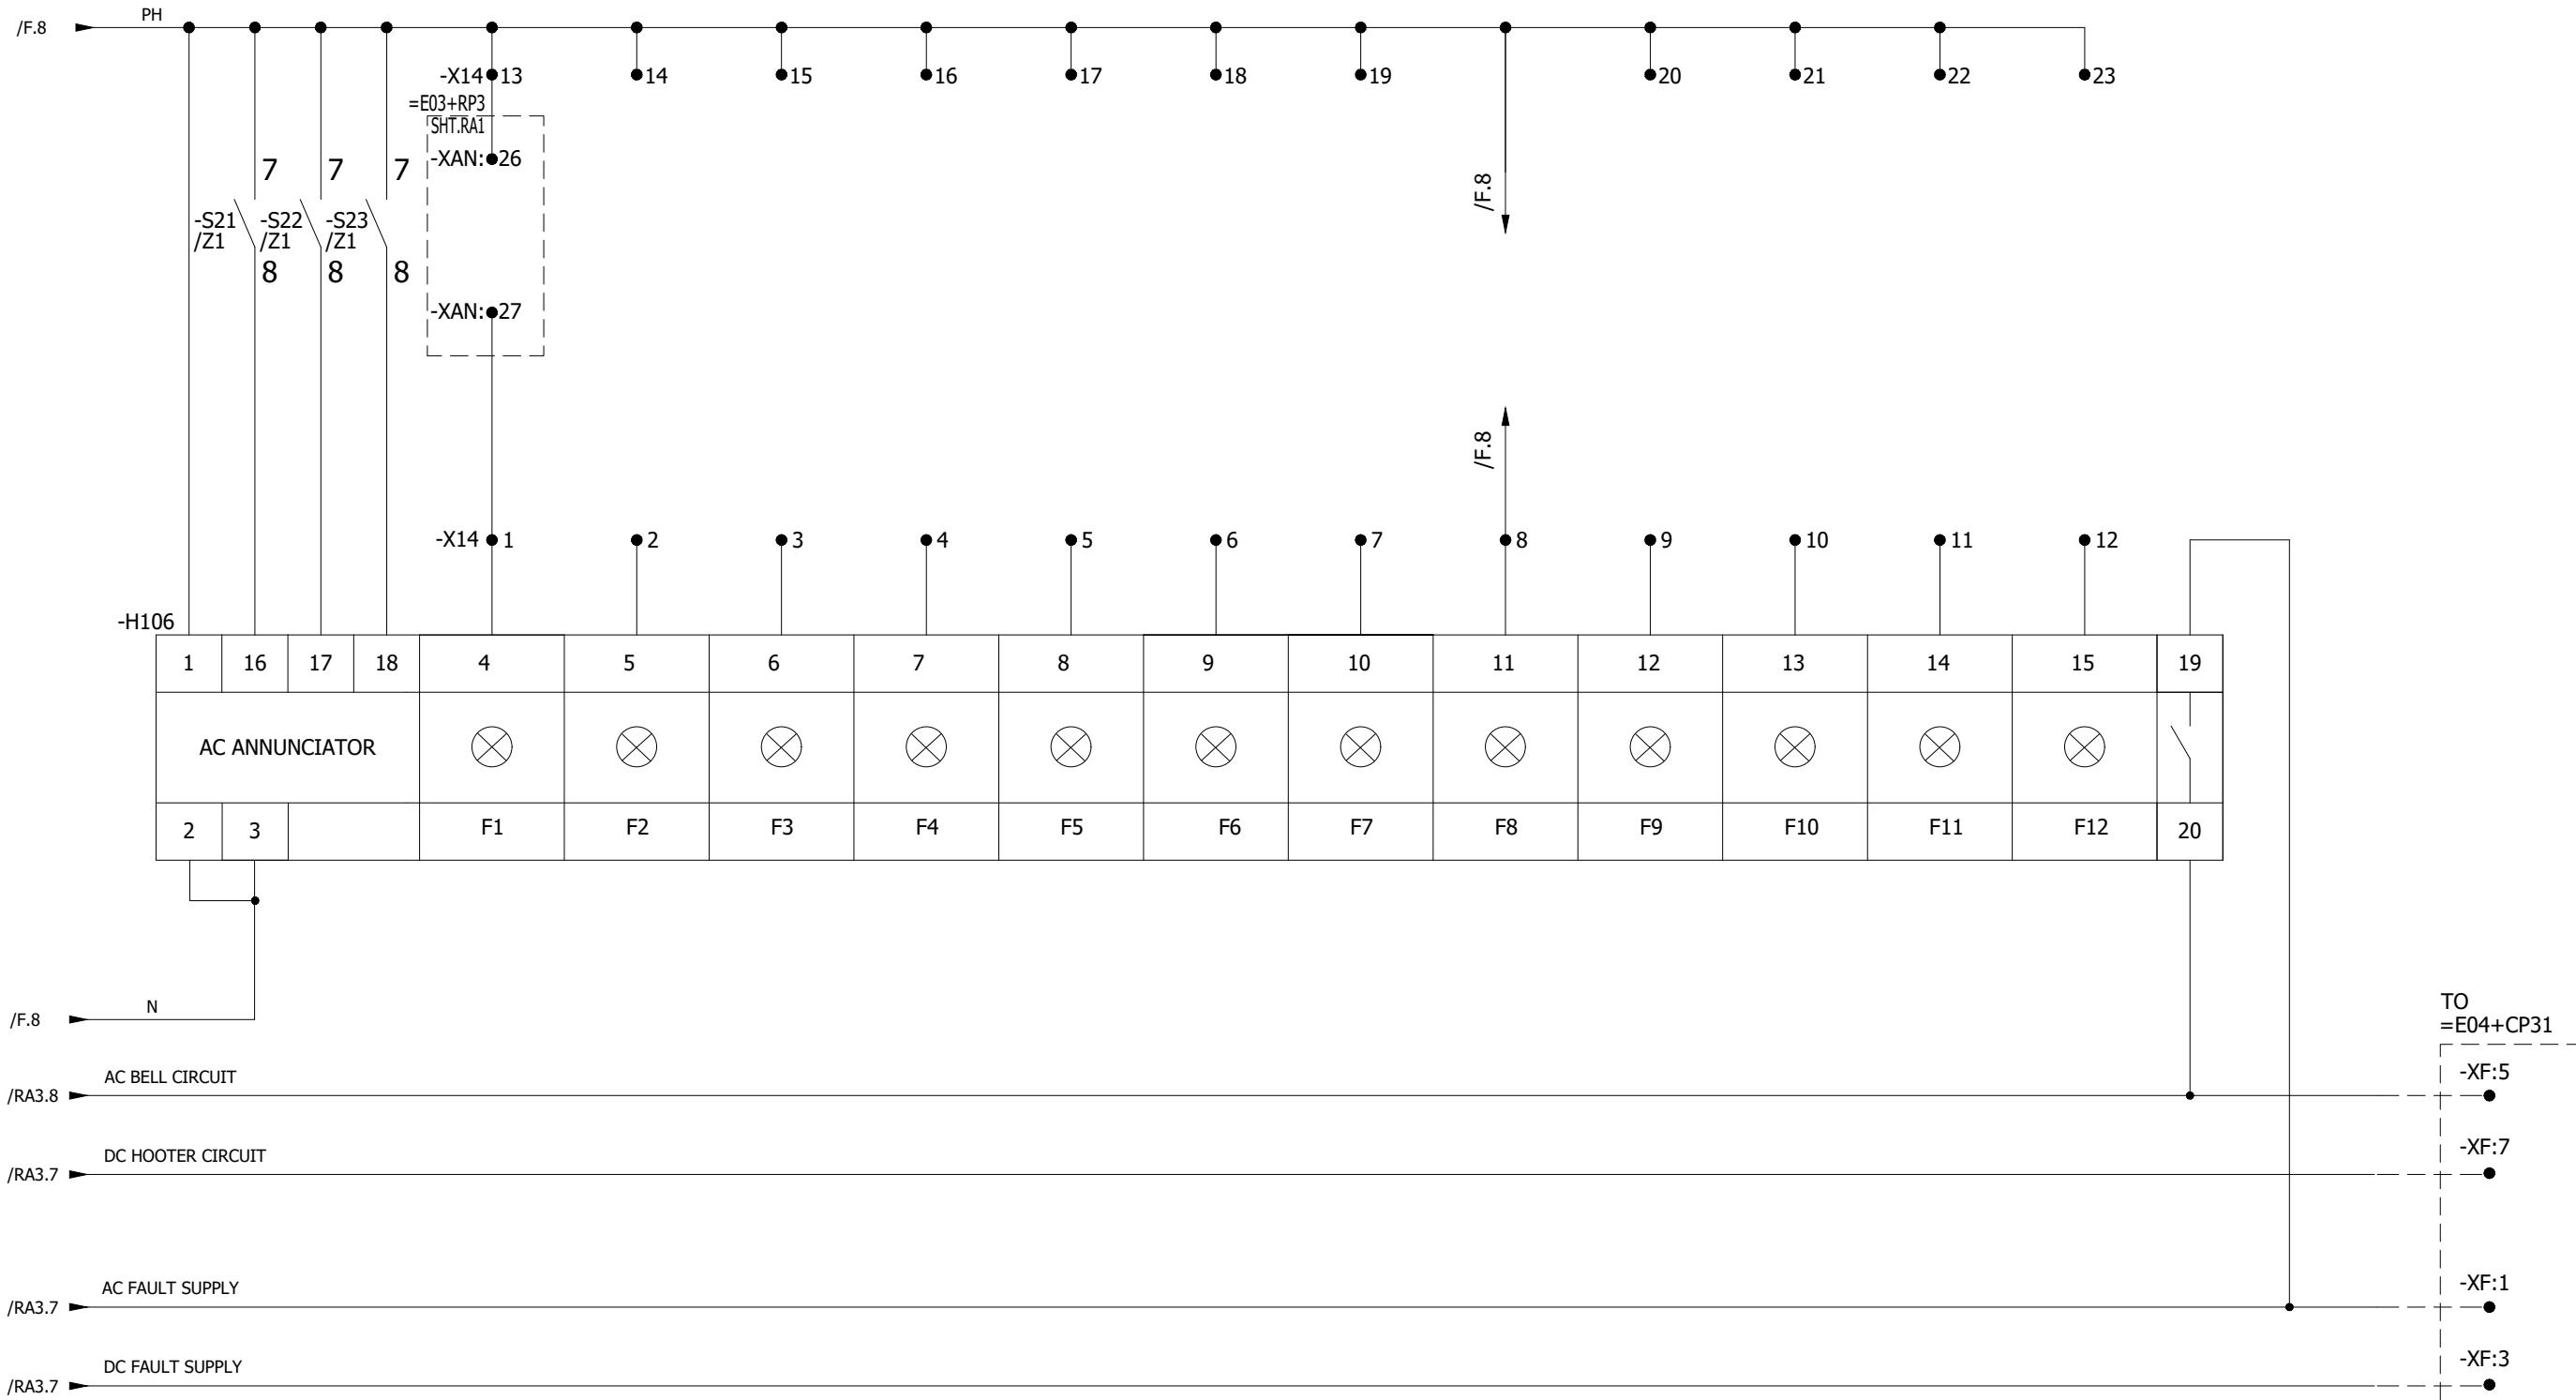

0	AS BUILT	19-10-2018	ASJ	Manufacturer  EPESOL 71-B Garden Block, New Garden Town, Lahore, Pakistan	Contractor  Grid Solutions A GE and Alstom joint venture	Client  NATIONAL TRANSMISSION & DISPATCH COMPANY LIMITED (NTDC-WAPDA)	Project 220kV/132kV GIS SUBSTATION GHAZI ROAD, LAHORE	Title 132kV LINE CONTROL PANEL (=E03+CP31) ANNUNCIATOR-4 CIRCUIT	Drawing no. P60194-E-ELC-SC-002
REV.	DESCRIPTION	DATE	DRAWER						Project no. P-60194 Sheet type RA4 Sheet no. 25

All information contained in this document is the exclusive property of GE GRID SOLUTIONS and shall not be used, copied or communicated to third parties without its prior authorization.

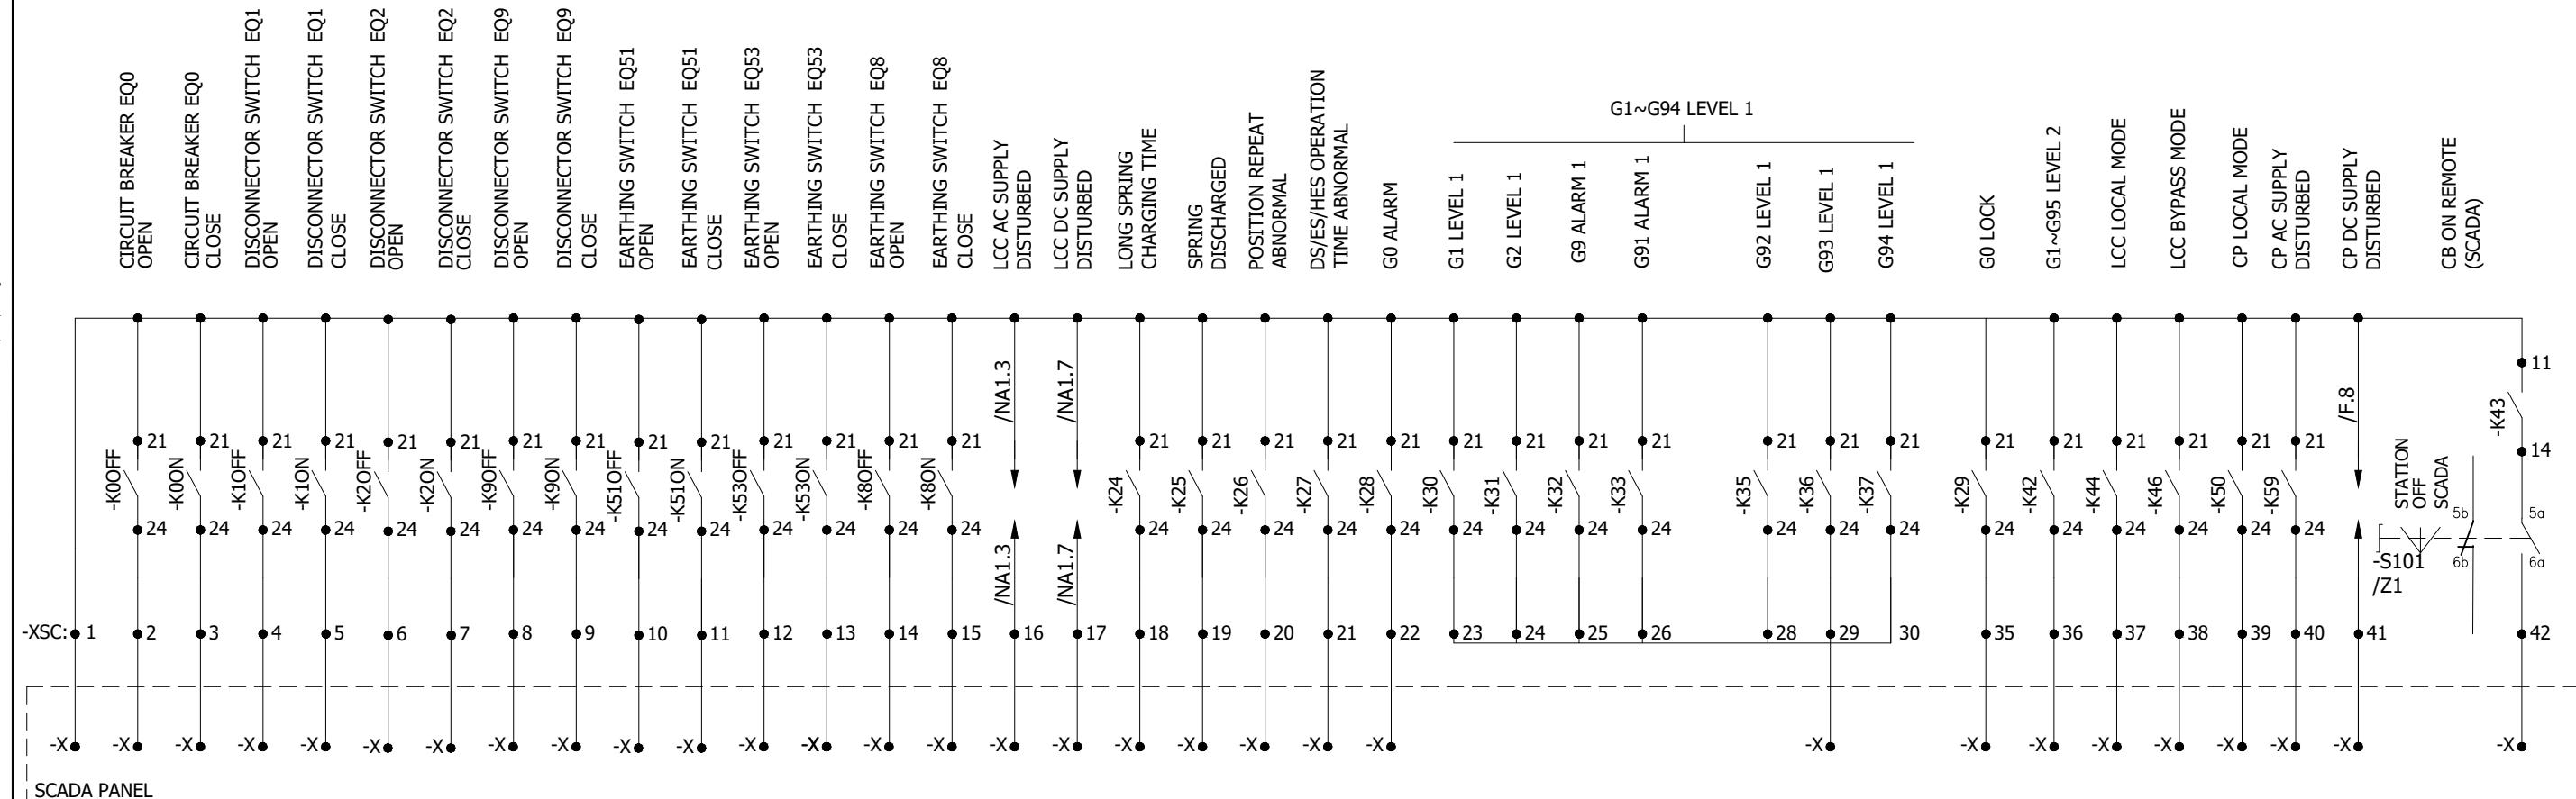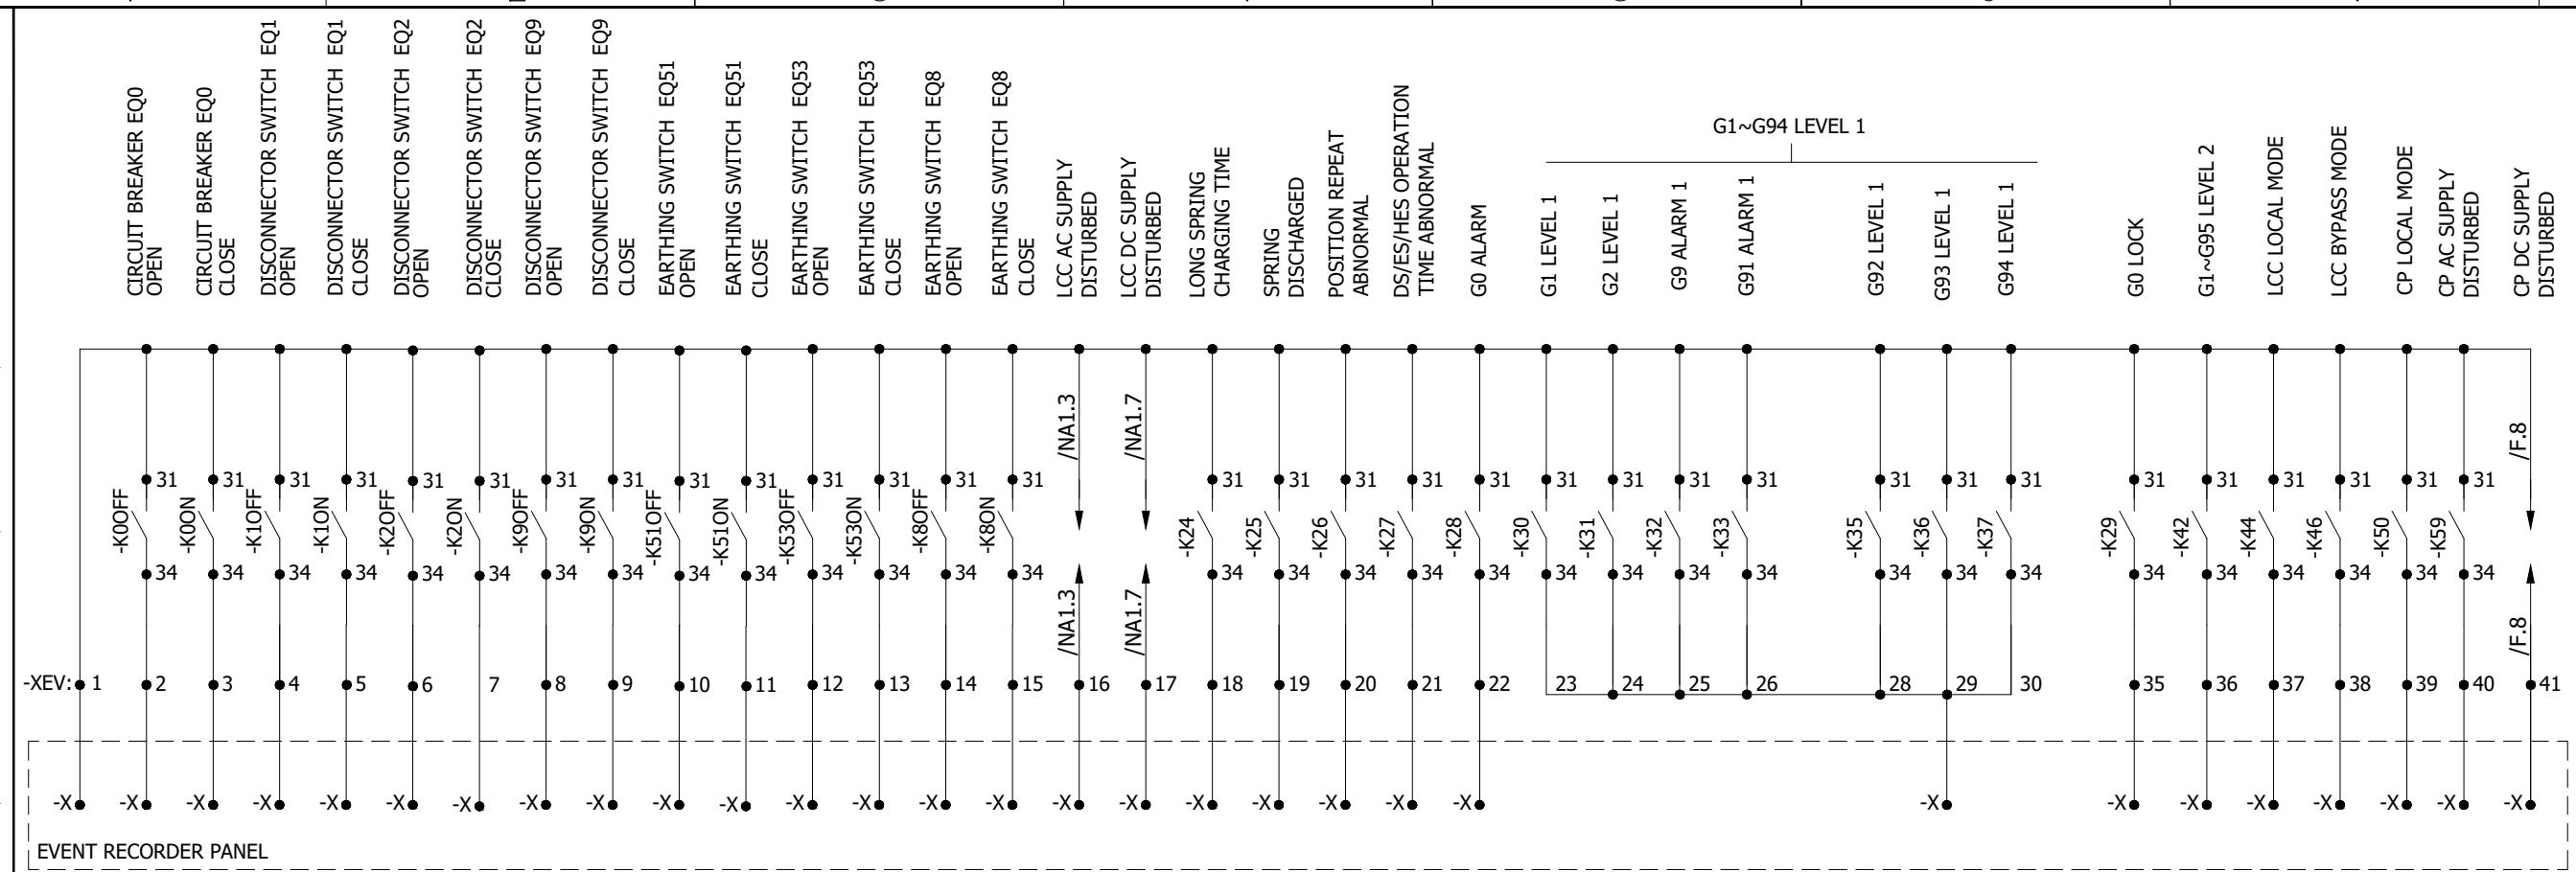

0	AS BUILT	19-10-2018	ASJ	Manufacturer  EPESOL 7-B Garden Block, New Garden Town, Lahore, Pakistan	Contractor  Grid Solutions <small>A GE and Alstom joint venture</small>	Client  NATIONAL TRANSMISSION & DISPATCH COMPANY LIMITED <small>(NTDC-WAPDA)</small>	Project 220kV/132kV GIS SUBSTATION GHAZI ROAD, LAHORE	Title 132kV LINE CONTROL PANEL <small>(=E03+CP31)</small> SCADA & ER SIGNALS	Drawing no.		
									P60194-E-ELC-SC-002		
									Project no.		
									P-60194	Sheet type	Sheet no.
REV.	DESCRIPTION	DATE	DRAWER						RA5	26	

