



Grid Solutions

A GE and Alstom joint venture

220kV/132kV GIS SUBSTATION GHAZI ROAD , LAHORE

132kV LINE CONTROL PANEL SCHEMATIC DRAWINGS

DOC / DWG REVIEW CODE	
<input type="checkbox"/>	A Approved, Issue IFC.
<input type="checkbox"/>	B Approved with comments as noted, Issue IFC after incorporation of these comments.
<input type="checkbox"/>	C Revise and re-submit for approval.
<input type="checkbox"/>	D Rejected.
Signed	
Date	
Permission to proceed does not constitute acceptance or approval of design details, analysers, test methods or materials/ selected by the CONTRACTOR and does not relieve the CONTRACTOR from full compliance with AGREEMENT obligations.	

	1	2	3	4	5	6	7	8							
	PAGE NO.	SHEET NAME	SHEET DESCRIPTION			ISSUE / REVISION									
						A	B	C	D	E	F	01	02	03	04
A	01	A	COVER SHEET			X	X	X	X	X	X				
	02	AA	LIST OF CONTENTS			X	X	X	X	X	X				
	03	AB	SYMBOL AND LEGENDS			X	X	X	X	X	X				
	04	AC1	COMPONENT LIST			X	X	X	X	X	X				
	05	AC2	COMPONENT LIST			X	X	X	X	X	X				
	06	AD	PANEL VIEW			X	X	X	X	X	X				
	07	AE	SINGLE LINE DIAGRAM			X	X	X	X	X	X				
	08	D	AC SUPPLY DISTRIBUTION CIRCUIT			X	X	X	X	X	X				
	09	E	DC SUPPLY DISTRIBUTION CIRCUIT			X	X	X	X	X	X				
	10	F	DC SUPPLY FAILURE ALARM CIRCUIT			X	X	X	X	X	X				
	11	G	METERING			X	X	X	X	X	X				
	12	H1	CB CONTROL CIRCUIT			X	X	X	X	X	X				
	13	H2	CB CONTROL CIRCUIT			X	X	X	X	X	X				
	14	I1	DISCONNECTOR & EARTH SWITCH CONTROL			X	X	X	X	X	X				
	15	I2	DISCONNECTOR & EARTH SWITCH CONTROL			X	X	X	X	X	X				
	16	K1	DISCONNECTOR CONTACT MULTIPLICATION			X	X	X	X	X	X				
	17	NA1	ALARM MULTIPLICATION			X	X	X	X	X	X				
	18	NA2	DISCREPANCY INITIATION			X	X	X	X	X	X				
	19	NA3	DISCREPANCY INITIATION			X	X	X	X	X	X				
	20	NA4	DISCREPANCY INITIATION			X	X	X	X	X	X				
	21	NA5	DISCREPANCY INDICATIONS			X	X	X	X	X	X				
	22	RA1	ANNUNCIATOR-1 CIRCUIT			X	X	X	X	X	X				
	23	RA2	ANNUNCIATOR-2 CIRCUIT			X	X	X	X	X	X				
	24	RA3	ANNUNCIATOR-3 CIRCUIT			X	X	X	X	X	X				
	25	RA4	ANNUNCIATOR-4 CIRCUIT			X	X	X	X	X	X				
	26	RA5	SCADA & ER SIGNALS			X	X	X	X	X	X				
	27	Z1	COMPONENT DIAGRAM			X	X	X	X	X	X				
F	0	AS BUILT	30.10.2018	ASJ	Manufacturer  EPESOL 71-B Garden Block, New Garden Town,	Contractor  Grid Solutions A GE and Alstom joint venture	Client  NATIONAL TRANSMISSION & DISPATCH COMPANY LIMITED	Project 220kV/132kV GIS SUBSTATION GHAZI ROAD, LAHORE	Title 132kV LINE CONTROL PANEL (=E10+CP31) LIST OF CONTANTS	Drawing no. P60194-E-ELC-SC-007					
	REV.	DESCRIPTION	DATE	DRAWER						Project no. P-60194	Sheet type AA	Sheet no. 02			

	SYMBOL	DESCRIPTION	SYMBOL	DESCRIPTION	SYMBOL	DESCRIPTION	SYMBOL	DESCRIPTION
A		CIRCUIT BREAKER		MINIATURE CIRCUIT BREAKER		AUXILIARY CONTACTOR NO+NC	21	DISTANCE
B		SWITCH/ISOLATOR		SELECTOR SWITCH		AMMETER	24	OVEREXCITATION
C		EARTHING		LIMITED SWITCH		VOLTMETER	25	SYCHROCHECK
D		GIS TERMINATION		HUMIDITY & TEMPERATURE CONTROLLER		POWER FACTOR METER	49	THERMAL OVERLOAD
E		SF6 TO AIR BUSHING		PANEL HEATER		DIGITAL PANEL METER	50/51	PHASE OVERCURRENT
F		LINE TRAP		THREE PIN SOCKET		ACTIVE POWER METER	50N/51N	EARTH FAULT
G		SURGE ARRESTOR		INDICATION LIGHT		REACTIVE POWER METER	50BF	CIRCUIT BREAKER FAILURE
H		CURRENT TRANSFORMER		PUSH BUTTON		ENERGY METER	64	RESTRICTED EARTH FAULT
I		COUPLING CAPACITOR VOLTAGE TRANSFORMER		AUXILIARY CONTACTOR COIL			67N	DIRECTIONAL EARTH FAULT
J		POWER TRANSFORMER		POWER SUPPLY AC/DC			68	POWER SWING BLOCKING
K		AUTO TRANSFORMER		TERMINAL			78	OUT OF STEP
L				OPTO CONTACTS			79	AUTO-RECLOSING
M				RELAY CONTACTS			85	COMMUNICATION FAILURE
N				HOOTER			87T	TRAFO DIFFERENTIAL
O				AC BELL			87C	LOW IMPEDANCE DIFFERENTIAL CONNECTION
P							87BB	LOW IMPEDANCE DIFFERENTIAL BUSBAR

All information contained in this document is the exclusive property of GE GRID SOLUTIONS and shall not be used, copied or communicated to third parties without its prior authorization.

0	AS BUILT	30.10.2018	ASJ	Manufacturer EPESOL 71-B Garden Block, New Garden Town,	Contractor Grid Solutions A GE and Alstom joint venture	Client NATIONAL TRANSMISSION & DISPATCH COMPANY LIMITED	Project 220kV/132kV GIS SUBSTATION GHAZI ROAD, LAHORE	Title 132kV LINE CONTROL PANEL (=E10+CP31) SYMBOL AND LEGENDS	Drawing no. P60194-E-ELC-SC-007
REV.	DESCRIPTION	DATE	DRAWER						Project no. P-60194
									Sheet type AB
									Sheet no. 03

	1	2	3	4	5	6	7	8	
	QTY.	DEVICE DESCRIPTION	DEVICE SPECIFICATIONS DEVICE TYPE ; TECHNICAL DATA / SPECIFICATIONS			DEVICE DESIGNITION	MANUFACTURER		
A	01	MWH+MVARH METER	MODEL: MT860S-A22R36S33-E1-L21-M3K03-Z7 3 PHASE, 4 WIRE PT: 132/ $\sqrt{3}$ /0.10/ $\sqrt{3}$ CT: -1A ACCURACY CLASS: 0.2S			-P11	ISKRAEMCO		
	02	ANALOG AMMETER (TRANSDUCER OPERATED)	DUAL SCALE ,In=0-20mA , Deflection:240 degree, Overload: 1.5In, Class: 1.5, Size: 96X96mm , SUITABLE FOR CT: 1600:800:400/1A. LOOSE SCALE PLATE FOR 800 & 400Amp.			-Q1 , -Q3	FRER		
	01	DIGITAL AMMETER	DIGITAL AMMETER, CLASS 1.5, 0-20mA OPERATED, SIZE: 96X96mm SUITABLE FOR CT: 1600:800:400/1A			-Q2	FRER		
B	02	CURRENT TRANSDUCER	1 Input (1A)/ 1 Output (0-20mA), Scale:0-150% of Rated Current, Frequency: 50Hz, Supply: 110VDC			-U1, -U3	FRER		
	01	CURRENT TRANSDUCER	1 Input (1A)/ 2 Outputs (0-20mA), Scale:0-150% of Rated Current, Frequency: 50Hz, Supply: 110VDC			-U2	FRER		
	01	ANALOG REAL POWER (MW) METER	In: -10,0,10mA DC, Deflection: 240° with Center zero, Size: 96x96 Sq.mm. Application: 3PH+4W Balanced System			-Q5	FRER		
C	01	ANALOG REACTIVE POWER (MVAR) METER	In: -10,0,10mA DC, Deflection: 240° with Center zero, Size: 96x96 Sq.mm. Application: 3PH+4W Balanced System			-Q6	FRER		
	01	PROGRAMMABLE UNIVERSAL TRANSDUCER	3-Phase 4-Wire Balanced Load With 4 Outputs, Input: 110/1.732V, 1A Supply: 110VDC			-U5	FRER		
	01	DIGITAL POWER METER	PM5310, Accuracy Class:0.5, Auxiliary Supply: 110VDC			-Q7	SCHNEIDER ELECTRIC		
D	01	ANNUNCIATOR	12-WINDOWS, 240VAC			-H106	ELABS		
	03	ANNUNCIATOR	12-WINDOWS, 110VDC			-H101,-H102,-H103	ELABS		
	01	PUSH BUTTON - LAMP TEST	5NO			-S21	SCHNEIDER ELECTRIC		
E	01	PUSH BUTTON - ALARM ACKNOWLEDGMENT	5NO			-S22	SCHNEIDER ELECTRIC		
	01	PUSH BUTTON - ALARM RESET	5NO			-S23	SCHNEIDER ELECTRIC		
	01	SELECTOR SWITCH - OPERATION (LOCAL-OFF-SCADA)	2 Position with OFF, 4-Pole, Ratings: 12A, 220VDC, Keylockable on both positions			-S101	SCHNEIDER ELECTRIC		
F	02	AUX. CONTACTOR	5NO, 110VDC			-K1,2	SCHNEIDER ELECTRIC		
	15	AUX. CONTACTOR	3NO+2NC, 110VDC			-K0,-K0E,-KOA,-K9,-K59,-KOD,-K1D, -K2D,-K9D,-K51D,-K53D,-K8D,-KDC,-KDC1,-KDC2	SCHNEIDER ELECTRIC		
	02	AUX. CONTACTOR	3NO+2NC, 240VAC			-KAMC,-K7	SCHNEIDER ELECTRIC		
G	01	AUX. CONTACTOR	3NO+2NC, 240VAC WITH ADDON BLOCK 2NO+2NC			-K8	SCHNEIDER ELECTRIC		
	44	AUX. RELAY	55.14, 4CO (4PDT), 110VDC			-K11-21,24-33,42-50,-K0OFF-ON,-K1OFF-ON,-K2OFF-ON, -K9OFF-ON,-K51OFF-ON,-K53OFF-ON,-K8OFF-ON	FINDER/EQUIVALENT		
	01	CONTROL DISCREPANCY SWITCH - CIRCUIT BREAKER	BHL-3B4-111-110VDC L1-W-Y-B, SQUARE FRONT PLATE			-S0	COMELETIC		
H	06	CONTROL DISCREPANCY SWITCH - ISOLATORS & EARTHING SW.	BHL-3B4-111-110VDC L1-W-Z-B, ROUND FRONT PLATE			-S1-2,-S9,-S51,-S8,-S53	COMELETIC		
	01	FLASHER RELAY	Coil Voltage: 110VDC			-K51	ELABS		
	0	AS BUILT	30.10.2018	ASJ	Manufacturer  EPESOL 71-B Garden Block, New Garden Town,	Contractor  GE Grid Solutions A GE and Alstom joint venture	Client  NATIONAL TRANSMISSION & DISPATCH COMPANY LIMITED	Project 220kV/132kV GIS SUBSTATION GHAZI ROAD, LAHORE	Title 132kV LINE CONTROL PANEL (=E10+CP31) COMPONENT LIST
REV.		DESCRIPTION	DATE	DRAWER					
1		2	3	4					

	1	2	3	4	5	6	7	8		
	QTY.	DEVICE DESCRIPTION	DEVICE SPECIFICATIONS DEVICE TYPE ; TECHNICAL DATA / SPECIFICATIONS			DEVICE DESIGNITION	MANUFACTURER			
A	01	PUSH BUTTON - ALARM RESET	TYPE: SWITCH(A TYPE:), COLOR : GREEN , SUPPLY : 120VDC, Ord: YS-AP1-2-31-G-D-W			-S23	YONGSUNG			
	01	SELECTOR SWITCH - OPERATION (LOCAL-OFF-SCADA)	3-POSITION (STATION-OFF-SCADA), 110VDC, KEYLOCKABLE TYPE, ORD: YS-AK-2-3-44-D			-S101	YONGSUNG			
B	60	AUXILIARY CONTACTOR	COIL VOLTAGE: 110VDC, 4 C/O CONTACTS, ORD: PRC4M40DCJL			-K0E, -K50, -K0A, -KDC-1, -K1, -K2, -K9, -K0, -K11 TO -K21, -K24 TO -K33, -K42 TO -K46, -K59 -K0OFF, -K0ON, -K0D, -K1OFF, -K1ON, -K1D, -K2OFF, -K2ON, -K2D, -K9OFF, -K9ON, -K9D, -K51OFF, -K51ON, -K51D, -K53OFF, -K53ON, -K53D, -K8OFF, -K8ON, -K8D, -KDC-2, -KS21, -K111, -K222	GE			
	01	AUXILIARY CONTACTOR - SUPPLY CHANGEOVER	COIL VOLTAGE: 110VDC, 3 NO + 3 NC CONTACTS, ORD: MCRC022ATWJ-B+MARN211AT			-KDC	GE			
C	03	AUXILIARY CONTACTOR	COIL VOLTAGE:: 240VAC, 4 C/O CONTACTS, ORD: PRC4M40ANL			-KAMC, -K7, -K8	GE			
	01	CONTROL DISCREPANCY SWITCH - CIRCUIT BREAKER	CONTROL AND DISCREPANCY SWITCH FOR ISOLATOR CONTROL AND INDICATION, SQUARE TYPE FOUR CONTACTS FOR COMMAND AND FOUR CONTACTS FOR INDICATION			-S0	YONGSUNG			
D	06	CONTROL DISCREPANCY SWITCH - ISOLATORS & EARTHING SW.	CONTROL AND DISCREPANCY SWITCH FOR ISOLATOR CONTROL AND INDICATION, ROUND TYPE FOUR CONTACTS FOR COMMAND AND FOUR CONTACTS FOR INDICATION ORD:YS-IC-4456-R4(49)-PM-K-G-D11-G			-S1, -S2, -S9, -S51, -S53, -S8	YONGSUNG			
	01	FLASHER RELAY	FLASHER RELAY, COIL VOLTAGE 110 VDC, ORD: FR-101-110			-K51	ELABS			
E	02	TEST BLOCK	YS-CTT-04-S, YS-PTT-04-S			-XTB1, -XTB2	YONGSUNG			
	02	INDICATION LIGHT - AC AND DC SUPPLY	TYPE: LED , COLOR : RED , SUPPLY : 240VAC ORD: YS-PL-2-AL-22-R-W			-H7, -H8	YONGSUNG			
F	01	OPERATION COUNTER	OPERATION COUNTER FOR CIRCUIT BREAKER, RATED VOLTAGE 110VDC			-Q10	ELABS			
	02	CONTROL MCB - PANEL LIGHT & HEATER	2-Pole, Ratings: 2A, 240VAC, 6kA @ 240VAC, 2 C/O Contacts, Ord: G62C02+CAH(2)			-F101, -F102	GE			
G	01	CONTROL ELCB - PANEL SOCKET	2-Pole, Ratings: 16A, 30mA, 240VAC, 1P+N, 2 C/O Contacts, Ord: DM100C16/030+CAH(2)			-F103	GE			
	02	CONTROL MCB - DC DISTRIBUTION	2-Pole, Ratings: 4A, 250VDC, 10kA @ 250VDC, 2 C/O Contacts, Ord: EP102UCC04+CAH(2)			-F201,-F202	GE			
H	01	PANEL LIGHT	230VAC @ 50Hz, 05W, Ord: YS-T8-30-5W			-H100	YONGSUNG			
	01	DOOR SWITCH	230VAC @ 50Hz, 1 NO Contact, Ord: YS P3315GW-B + YS MS-C			-S100	YONGSUNG			
I	01	THREE PIN SOCKET	1N+PE, 16A, 230VAC @ 50Hz			-X100	LOCAL			
	REV.	DESCRIPTION	DATE	DRAWER	Manufacturer  EPESOL 71-B Garden Block, New Garden Town,	Contractor  Grid Solutions A GE and Alstom joint venture	Client  NATIONAL TRANSMISSION & DISPATCH COMPANY LIMITED	Project 220kV/132kV GIS SUBSTATION GHAZI ROAD, LAHORE	Title 132kV LINE CONTROL PANEL (=E10+CP31) COMPONENT LIST	Drawing no. P60194-E-ELC-SC-007
								Project no. P-60194	Sheet type AC2	Sheet no. 05

	1	2	3	4	5	6	7	8		
	QTY.	DEVICE DESCRIPTION	DEVICE SPECIFICATIONS DEVICE TYPE ; TECHNICAL DATA / SPECIFICATIONS			DEVICE DESIGNITION	MANUFACTURER			
A	01	PANEL HEATER	240VAC @ 50Hz, 50W			-R100	E-LABS			
	01	HUMIDITY & TEMPERATURE CONTROLLER	40-90%RH, 25-50 deg.C, 240VAC @ 50Hz			-B100	E-LABS			
	04	TERMINAL BLOCKS FOR AC SUPPLY	TYPE: CBD-4			-XAC	CABUR			
	02	TERMINAL BLOCKS FOR DC SUPPLY1	TYPE: CBD-4			-XDC-1	CABUR			
	02	TERMINAL BLOCKS FOR DC SUPPLY2	TYPE: CBD-4			-XDC-2	CABUR			
	16	TERMINAL BLOCKS FOR METERING	TYPE: CBD-4			-X3	CABUR			
B	08	TERMINAL BLOCKS FOR CB CONTROL CIRCUIT	TYPE: CBD-4			-X4	CABUR			
	12	TERMINAL BLOCKS FOR CB CONTROL CIRCUIT	TYPE: CBD-4			-X5	CABUR			
	35	TERMINAL BLOCKS FOR DS+ES CONTACTOR MULTIPLICATION	TYPE: CBD-4			-X6	CABUR			
	08	TERMINAL BLOCKS FOR CB/DS CONTACTOR MULTIPLICATION	TYPE: CBD-4			-X7	CABUR			
	40	TERMINAL BLOCKS FOR AUXIALARY MULTIPLICATION	TYPE: CBD-4			-X8	CABUR			
	15	TERMINAL BLOCKS FOR DISCRIPANCY INITIATION	TYPE: CBD-4			-X9	CABUR			
C	13	TERMINAL BLOCKS FOR ANNUNCIATOR-1	TYPE: CBD-4			-X11	CABUR			
	16	TERMINAL BLOCKS FOR ANNUNCIATOR-2	TYPE: CBD-4			-X12	CABUR			
	18	TERMINAL BLOCKS FOR ANNUNCIATOR-3	TYPE: CBD-4			-X13	CABUR			
	24	TERMINAL BLOCKS FOR ANNUNCIATOR-4	TYPE: CBD-4			-X14	CABUR			
	45	TERMINAL BLOCKS FOR EVENT RECORDER	TYPE: CBD-4			-XEV	CABUR			
	45	TERMINAL BLOCKS FOR SCADA	TYPE: CBD-4			-XSC	CABUR			
D	30	TERMINAL BLOCKS FOR TRANSDUCER TO SCADA	TYPE: CBD-4			-XSA	CABUR			
	30	TERMINAL BLOCKS FOR SCADA	TYPE: CBD-4			-XSP	CABUR			
	08	TERMINAL BLOCKS FOR BELL AND HOOTER	TYPE: CBD-4			-XF	CABUR			
	0	AS BUILT	30.10.2018	ASJ	Manufacturer  EPESOL 71-B Garden Block, New Garden Town,	Contractor  Grid Solutions A GE and Alstom joint venture	Client  NATIONAL TRANSMISSION & DISPATCH COMPANY LIMITED	Project 220kV/132kV GIS SUBSTATION GHAZI ROAD, LAHORE	Title 132kV LINE CONTROL PANEL (=E10+CP31) COMPONENT LIST	Drawing no. P60194-E-ELC-SC-007
	REV.	DESCRIPTION	DATE	DRAWER					Project no. P-60194	Sheet type AC2




	1	2	3	4	5	6	7	8	
	QTY.	DEVICE DESCRIPTION	DEVICE SPECIFICATIONS DEVICE TYPE ; TECHNICAL DATA / SPECIFICATIONS			DEVICE DESIGNITION	MANUFACTURER		
A	08	TERMINAL BLOCKS FOR METERING CT	TYPE: SCB-6			-X2	CABUR	A	
B	07	TERMINAL BLOCKS WITH DIODE TYPE IN-D4007, RATED MAXIMUM VOLTAGE 350VDC, RATED BREAK DOWN VOLTAGE 430VDC	TYPE: DAS.4/6			-XD	CABUR	B	
C								C	
D								D	
E								E	
F								F	
<i>All information contained in this document is the exclusive property of GE GRID SOLUTIONS and shall not be used, copied or communicated to third parties without its prior authorization.</i>									
0	AS BUILT	30.10.2018	ASJ	Manufacturer  EPESOL 71-B Garden Block, New Garden Town,	Contractor  Grid Solutions A GE and Alstom joint venture	Client  NATIONAL TRANSMISSION & DISPATCH COMPANY LIMITED	Project 220KV/132KV GIS SUBSTATION GHAZI ROAD, LAHORE	Title 132KV LINE CONTROL PANEL (=E10+CP31) COMPONENT LIST	Drawing no. P60194-E-ELC-SC-007
REV.	DESCRIPTION	DATE	DRAWER					Project no. P-60194 Sheet type AC2 Sheet no. 05	

BACK VIEW WITHOUT DOOR

BACK VIEW WITH DOOR


TOP VIEW


All information contained in this document is the exclusive property of GPD SOLUTIONS and shall not be used copied or communicated to third parties without its prior authorization

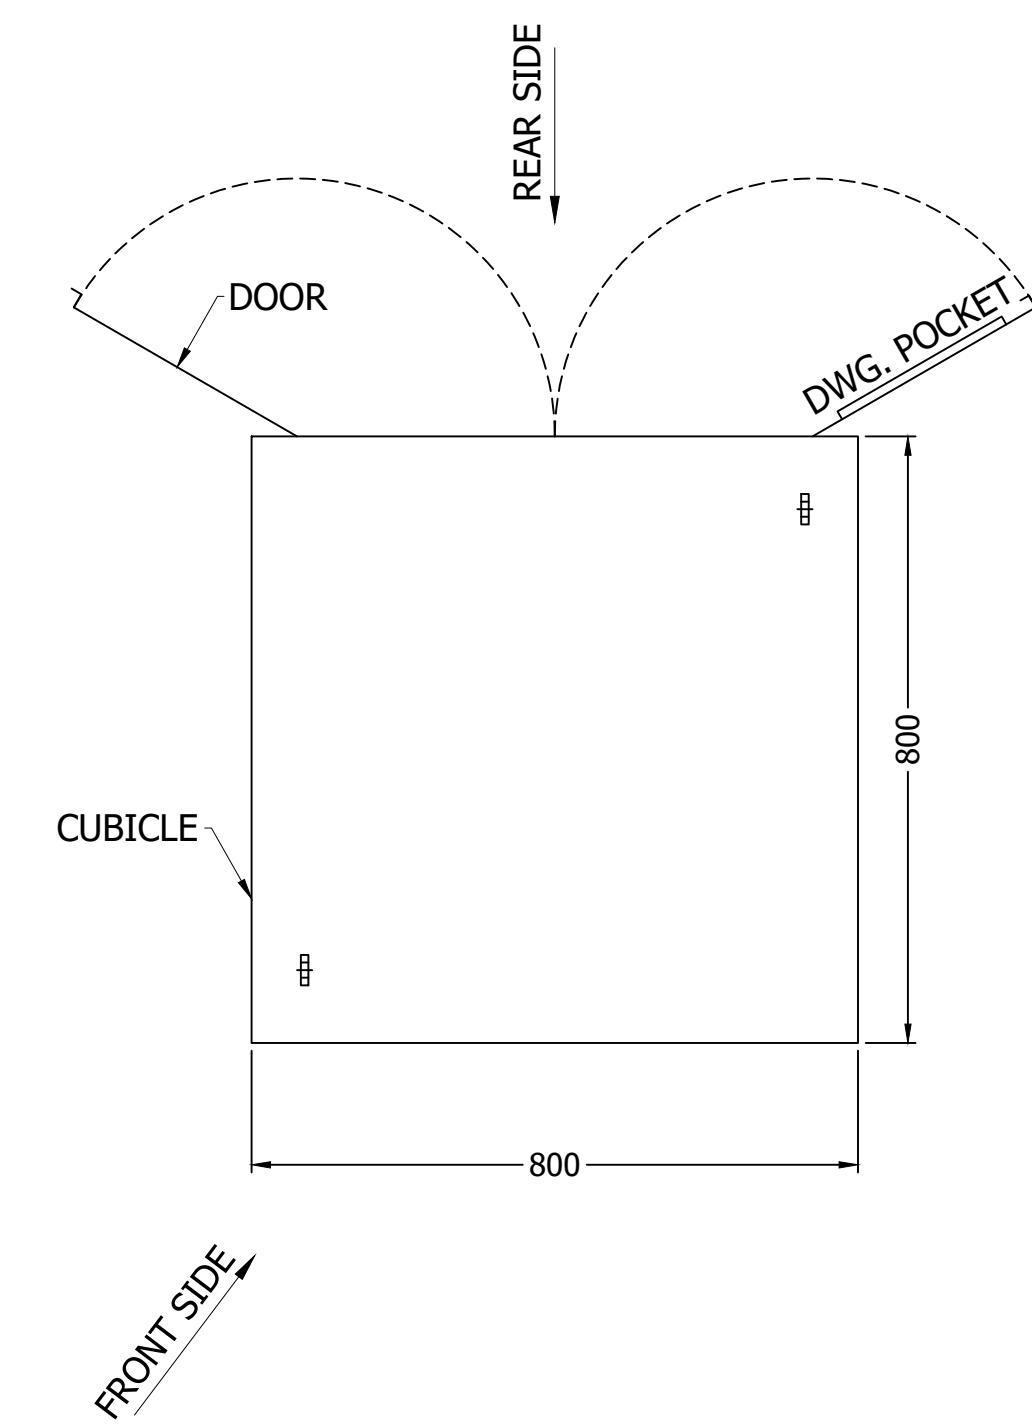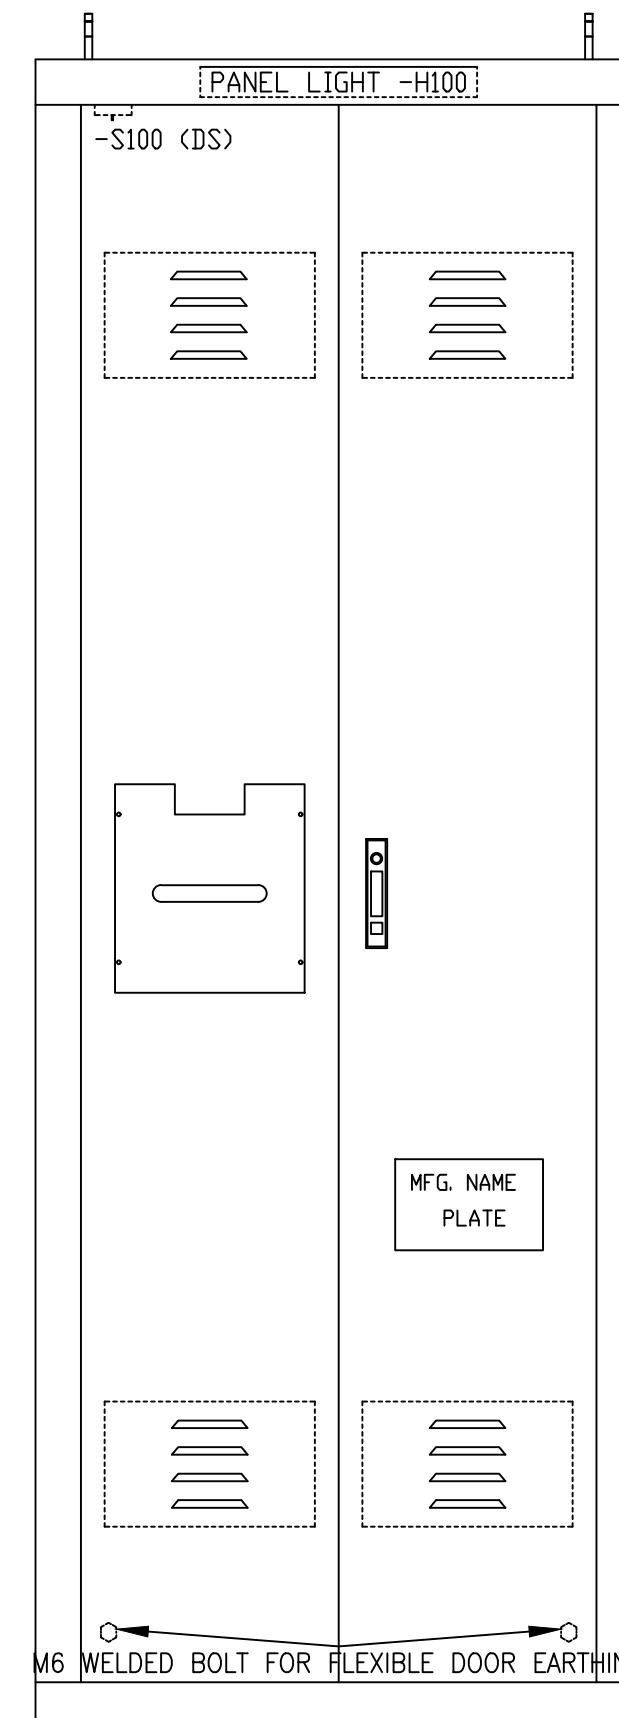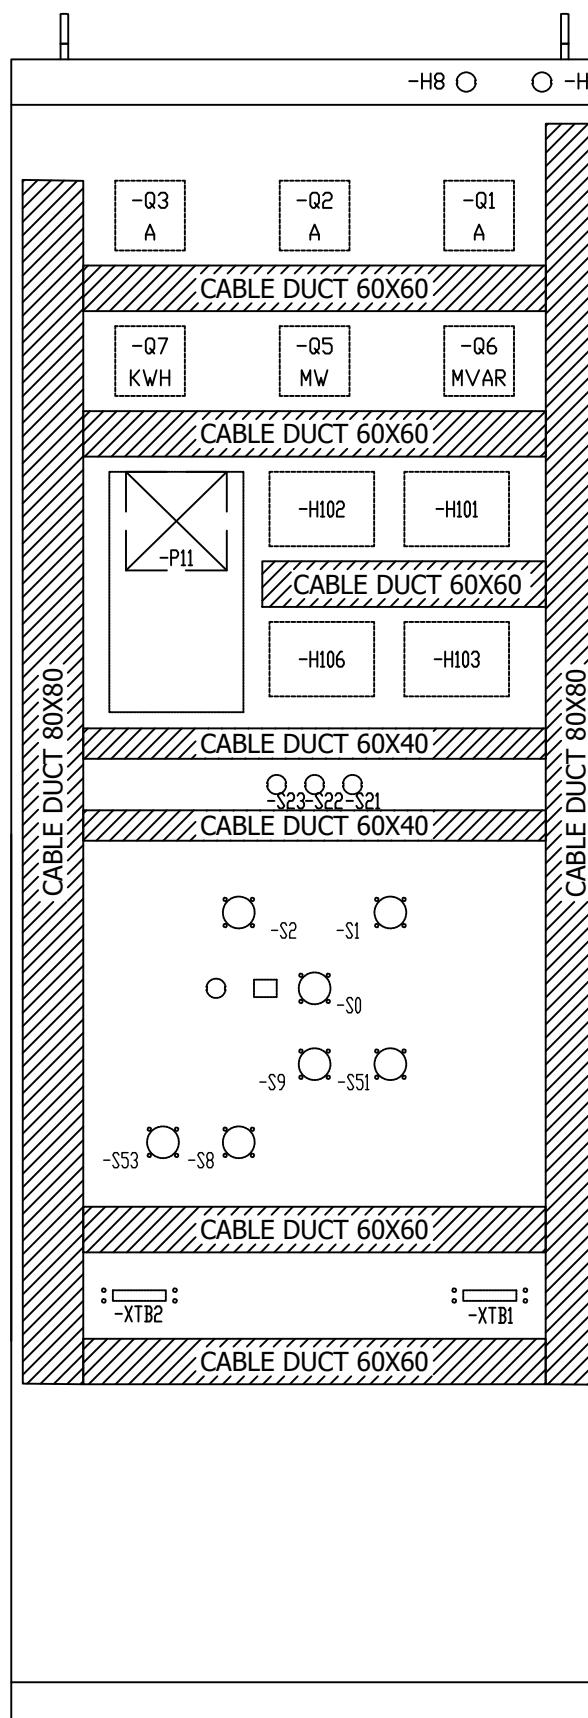


NOTE:-

 - 1 - PANEL DIMENSION: 800 x 800 x 2200mm (WxDxH)
 - 2 - COLOR : RAL 7032
 - 3 - SHEET THICKNESS : 2-2.5 mm
 - 4- PROTECTION CLASS : IP-51 (INDOOR TYPE)
 - 5 - ALL DOOR FITTED WITH 16mm EARTH STRAP & INSULATED WITH GREEN-YELLOW COLOUR.

0	AS BUILT	30.10.2018	ASJ	Manufacturer  EPESOL <i>7-B Garden Block, New Garden Town, Lahore, Pakistan</i>	Contractor  Grid Solutions <small>A GE and Alstom joint venture</small>	Client  NATIONAL TRANSMISSION & DISPATCH COMPANY LIMITED <small>(NTDC-WAPDA)</small>	Project 220kV/132kV GIS SUBSTATION GAZI ROAD, LAHORE	Title 132kV LINE CONTROL PANEL <small>(=E10+CP31)</small> PANEL VIEWS	Drawing no.		
									P60194-E-ELC-SC-007		
									Project no.		
									P-60194	Sheet type	Sheet no.
REV.	DESCRIPTION	DATE	DRAWER						AD	06	

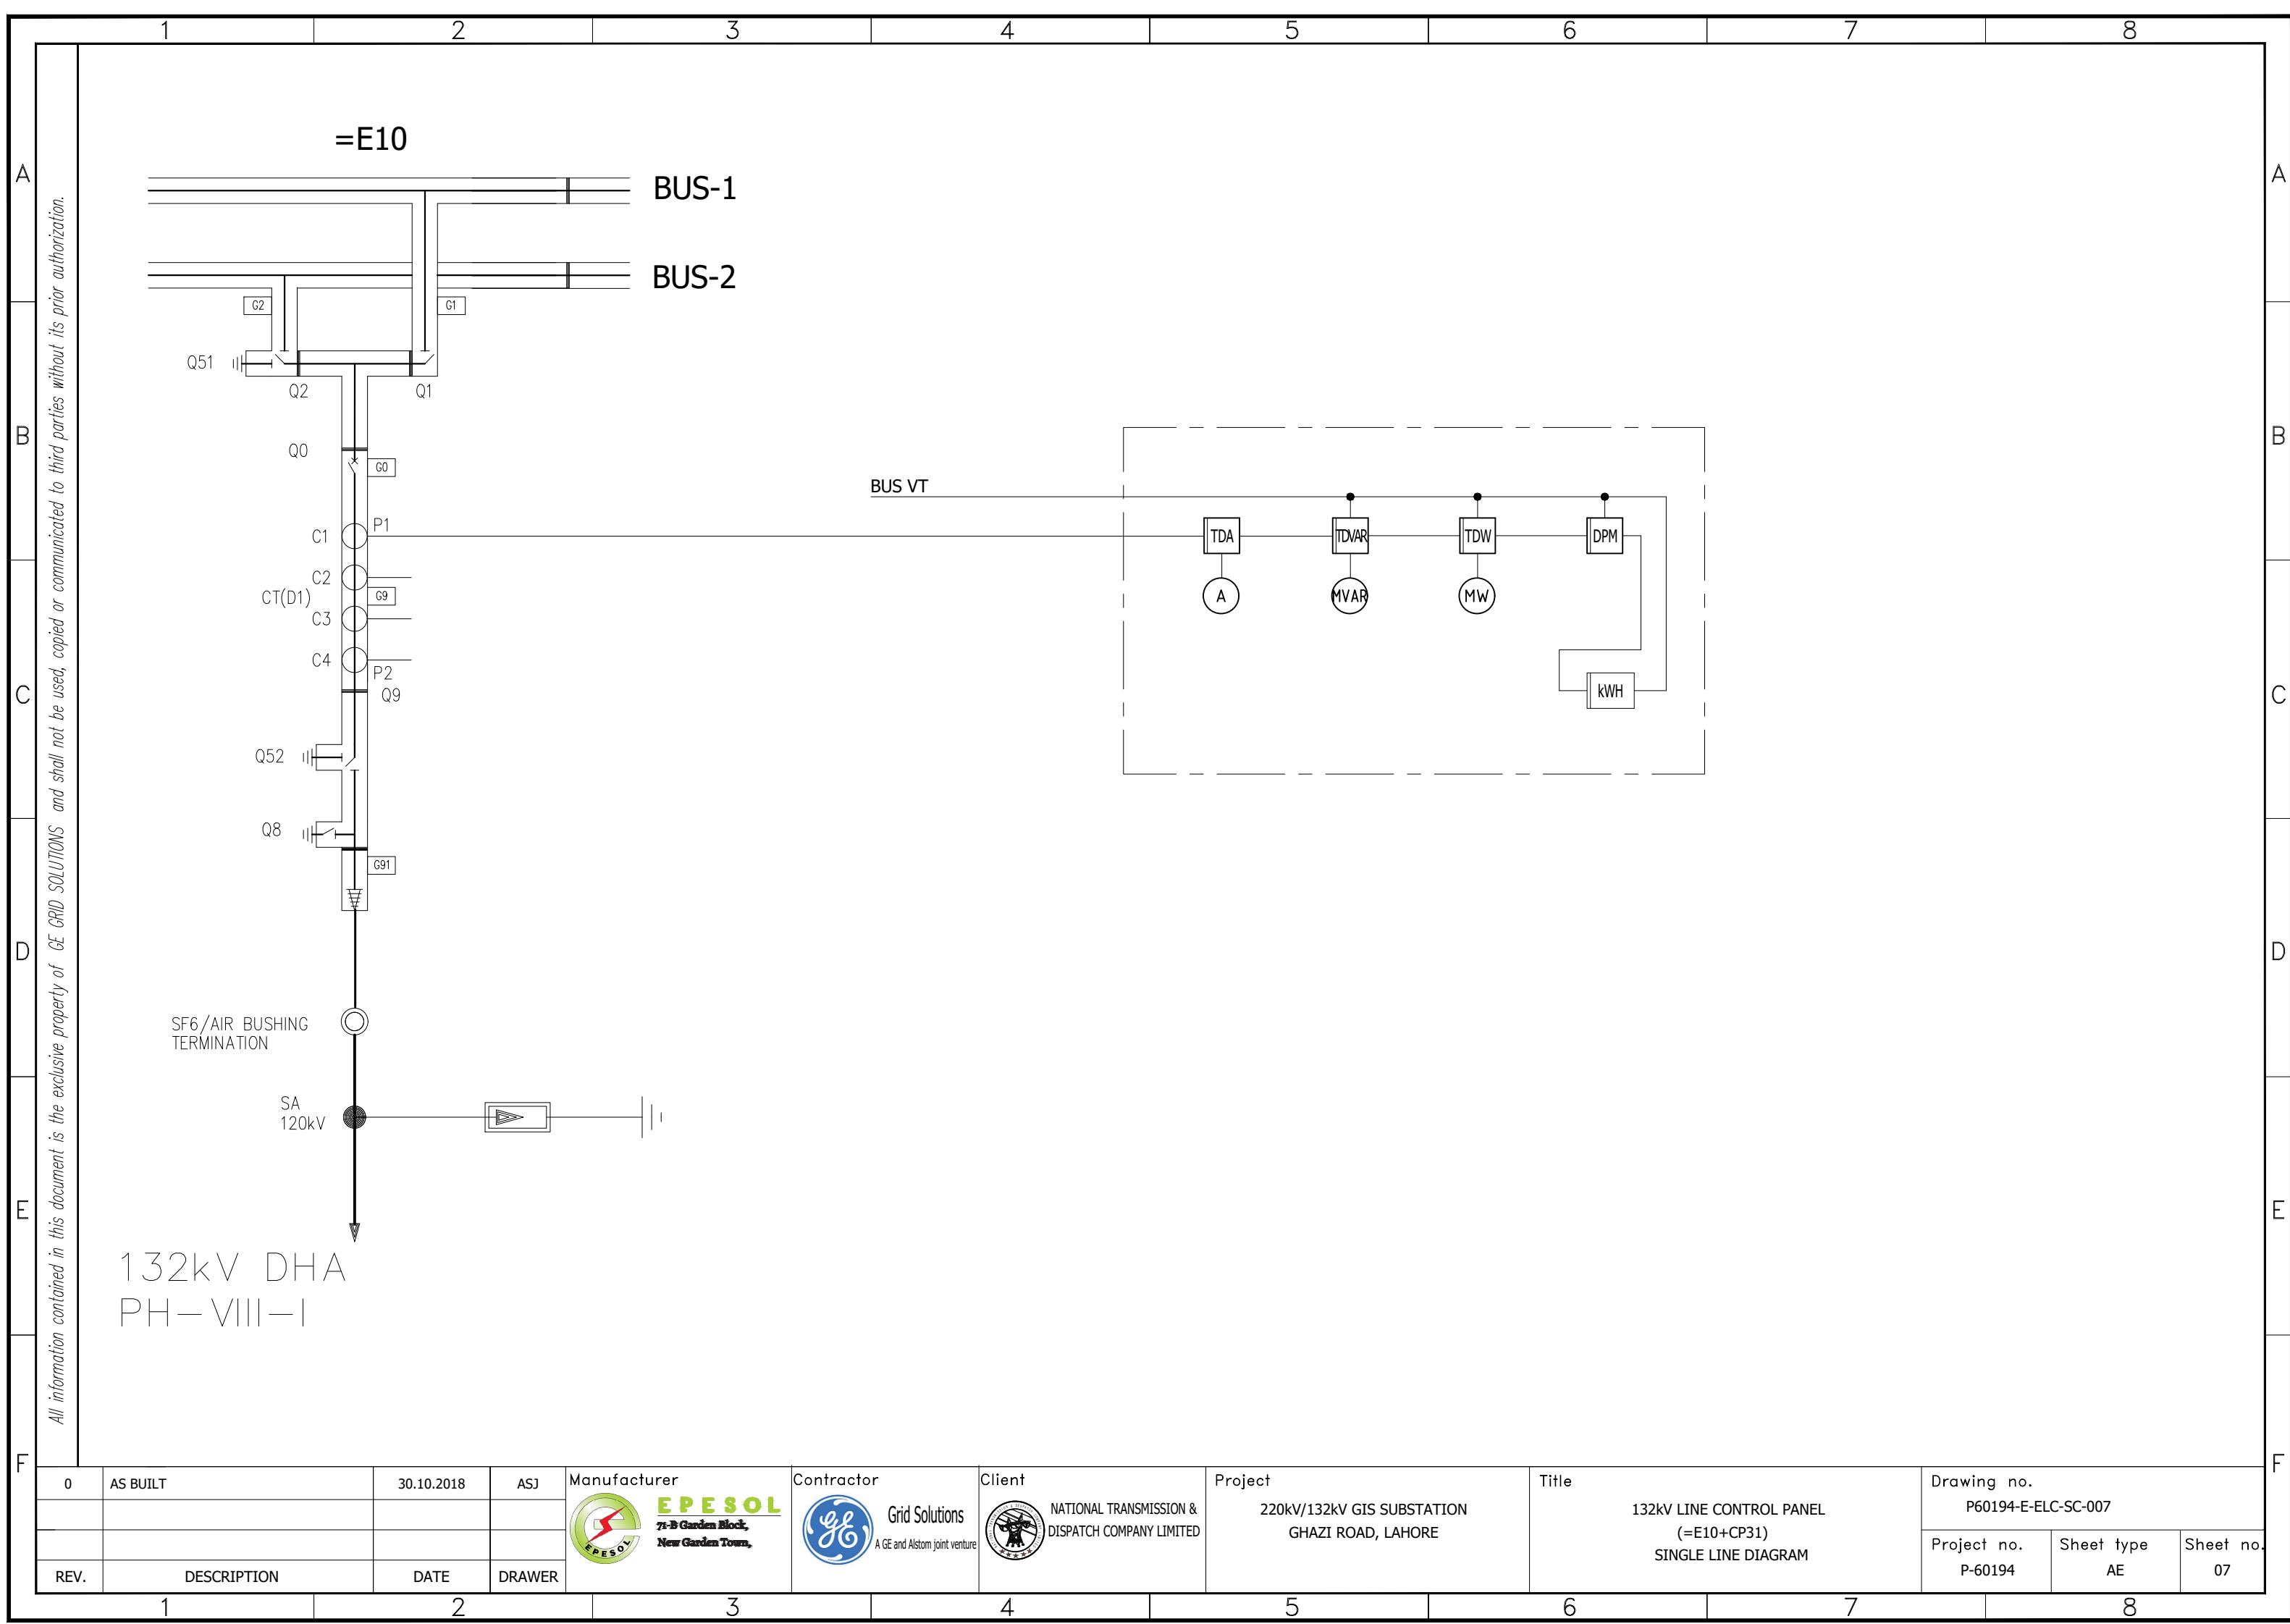

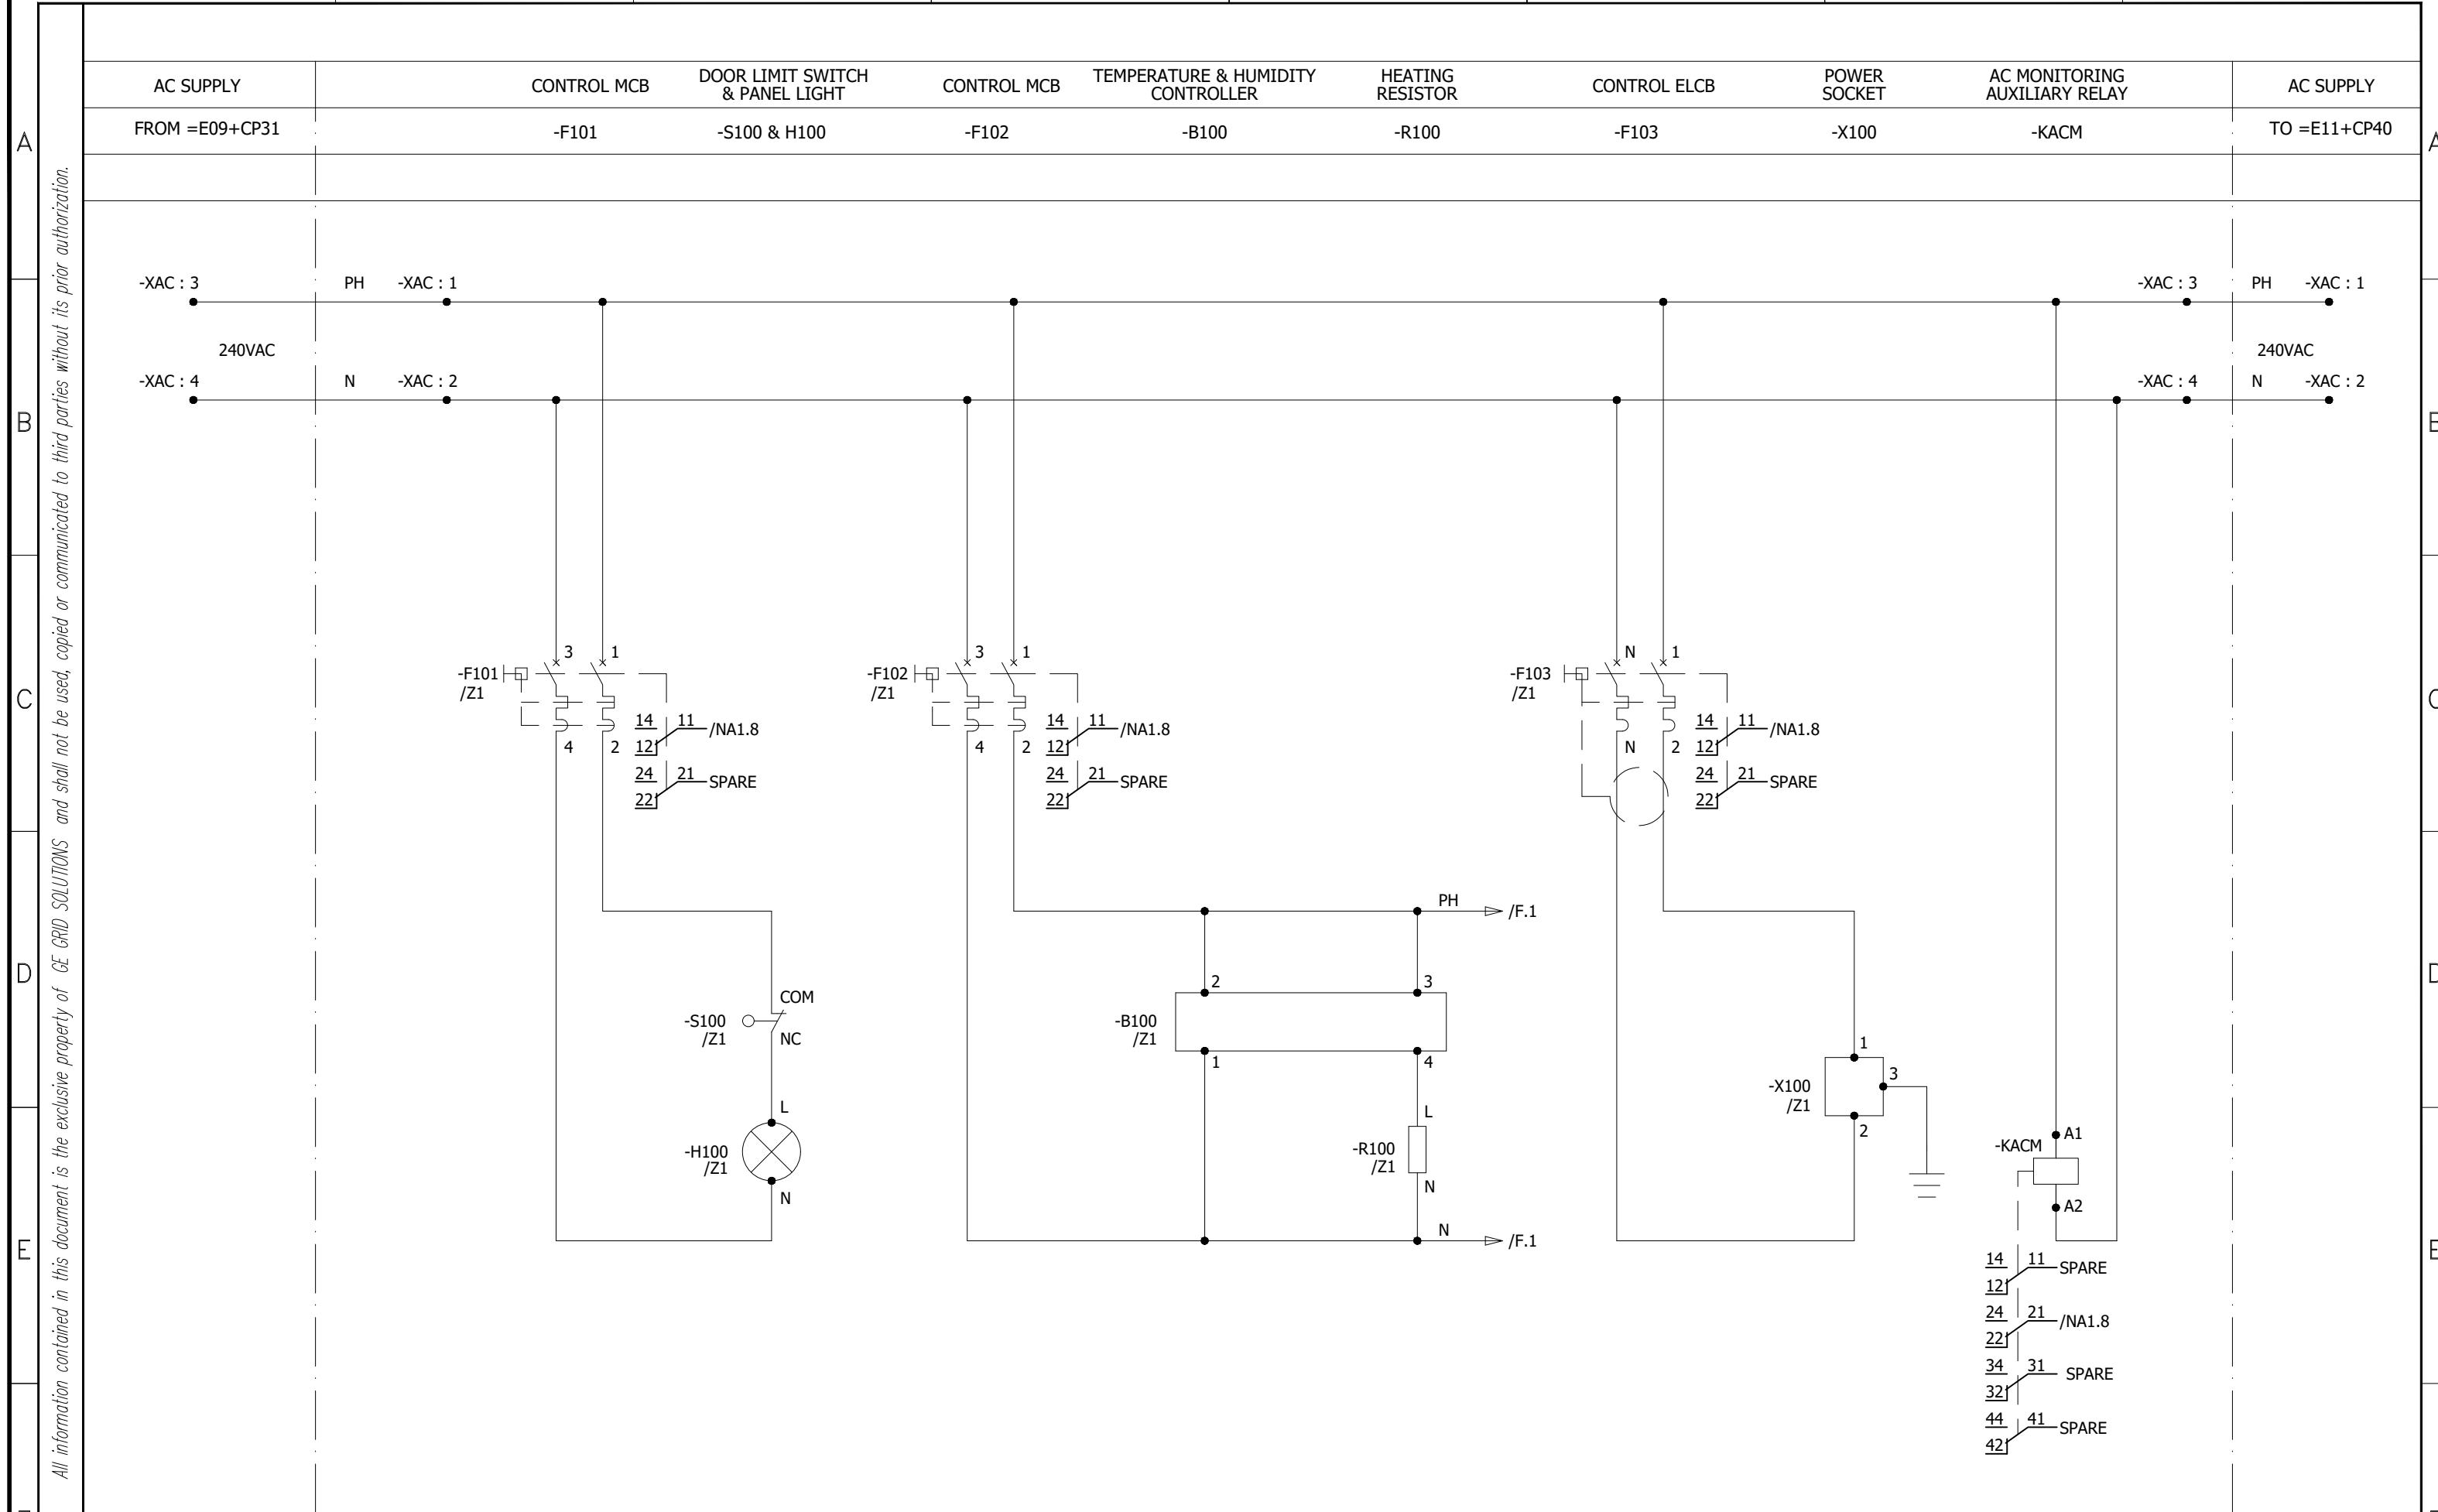

0	AS BUILT	30.10.2018	ASJ	Manufacturer EPE SOL 71-B Garden Block, New Garden Town,	Contractor Grid Solutions A GE and Alstom joint venture	Client NATIONAL TRANSMISSION & DISPATCH COMPANY LIMITED	Project 220kV/132kV GIS SUBSTATION GHAZI ROAD, LAHORE	Title 132kV LINE CONTROL PANEL (=E10+CP31) AC SUPPLY DISTRIBUTION CIRCUIT	Drawing no. P60194-E-ELC-SC-007
									Project no. P-60194
REV.	DESCRIPTION	DATE	DRAWER						Sheet type D
									Sheet no. 08


All information contained in this document is the exclusive property of GE GRID SOLUTIONS and shall not be used, copied or communicated to third parties without its prior authorization.

DC MCB FOR 132kV CB
CONTROL

DC MCB FOR
INDICATION

-F201

-F202

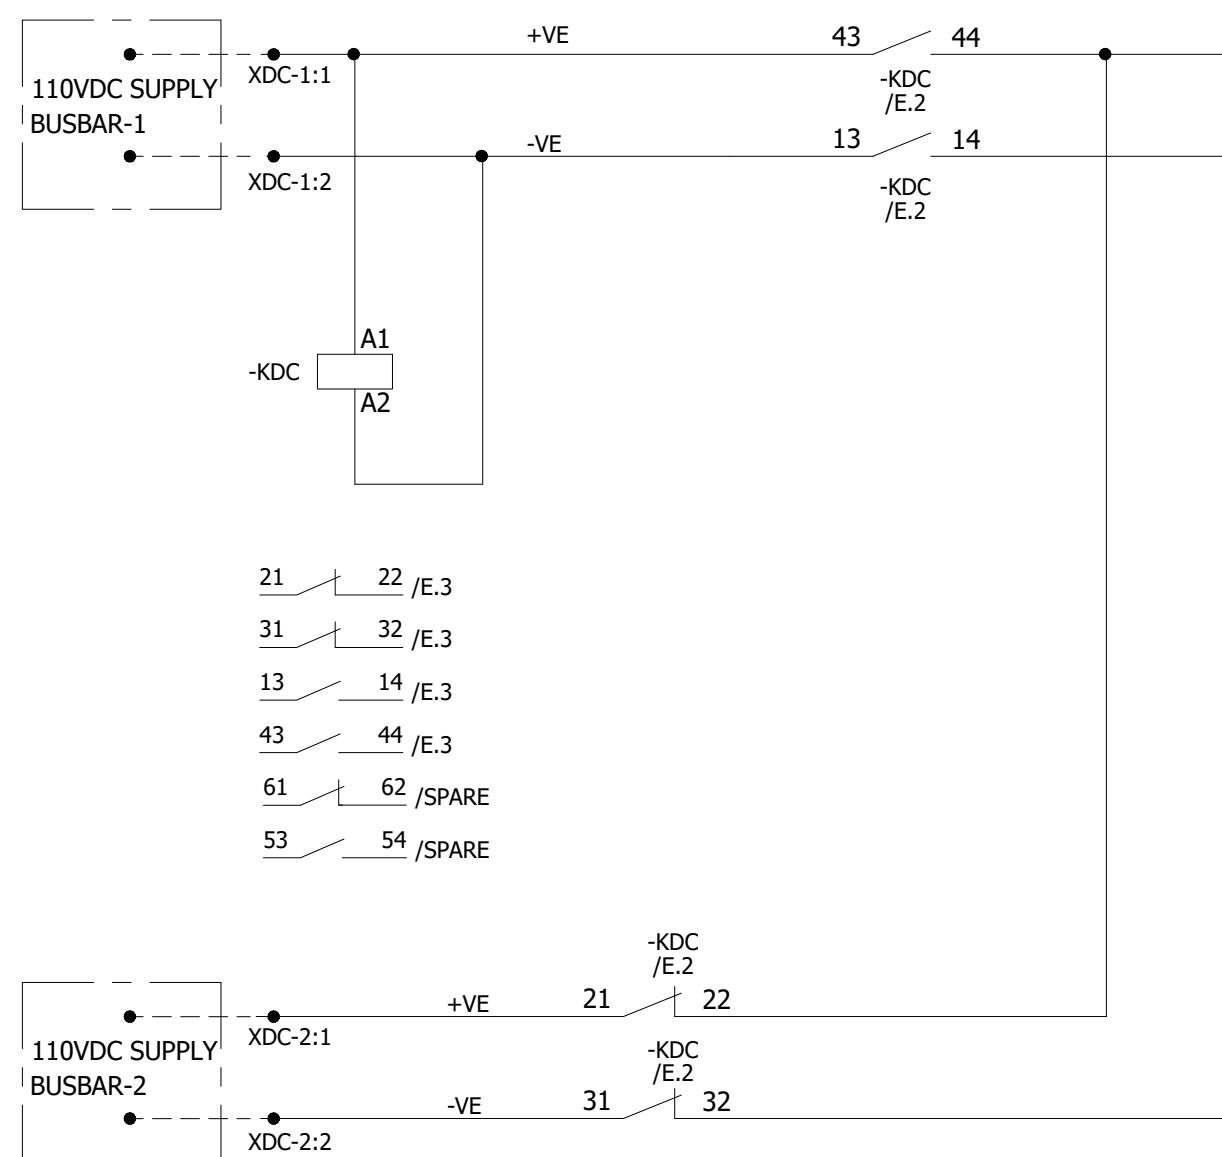

-F201


/Z1

DC SUPPLY FOR
=E10+Q0/H1.1


-F202




/Z1

DC SUPPLY FOR
INDICATION/G.2

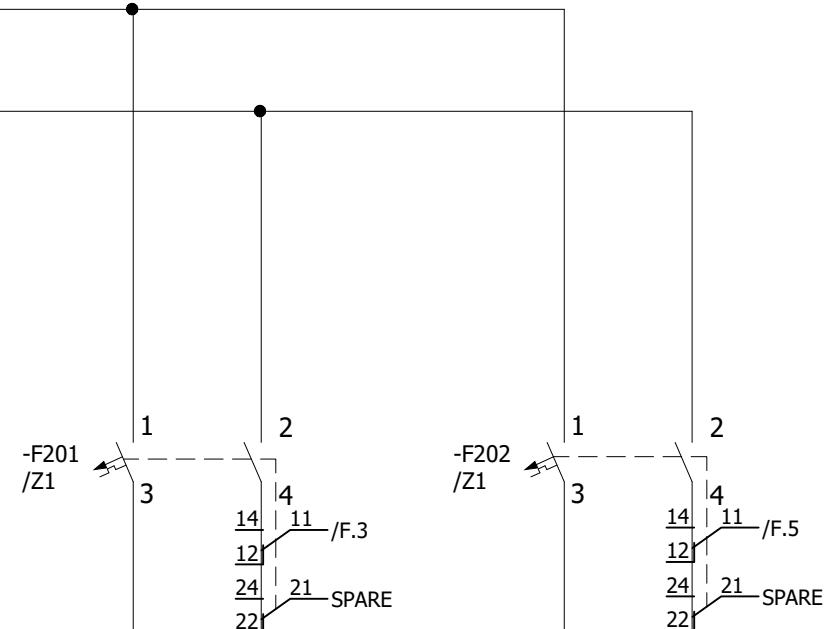

0	AS BUILT	30.10.2018	ASJ	Manufacturer  EPESOL 71-B Garden Block, New Garden Town,	Contractor  Grid Solutions A GE and Alstom joint venture	Client  NATIONAL TRANSMISSION & DISPATCH COMPANY LIMITED	Project 220kV/132kV GIS SUBSTATION GHAZI ROAD, LAHORE	Title 132kV LINE CONTROL PANEL (=E10+CP31) DC SUPPLY DISTRIBUTION CIRCUIT	Drawing no. P60194-E-ELC-SC-007
REV.	DESCRIPTION	DATE	DRAWER						Project no. P-60194
									Sheet type E
									Sheet no. 09

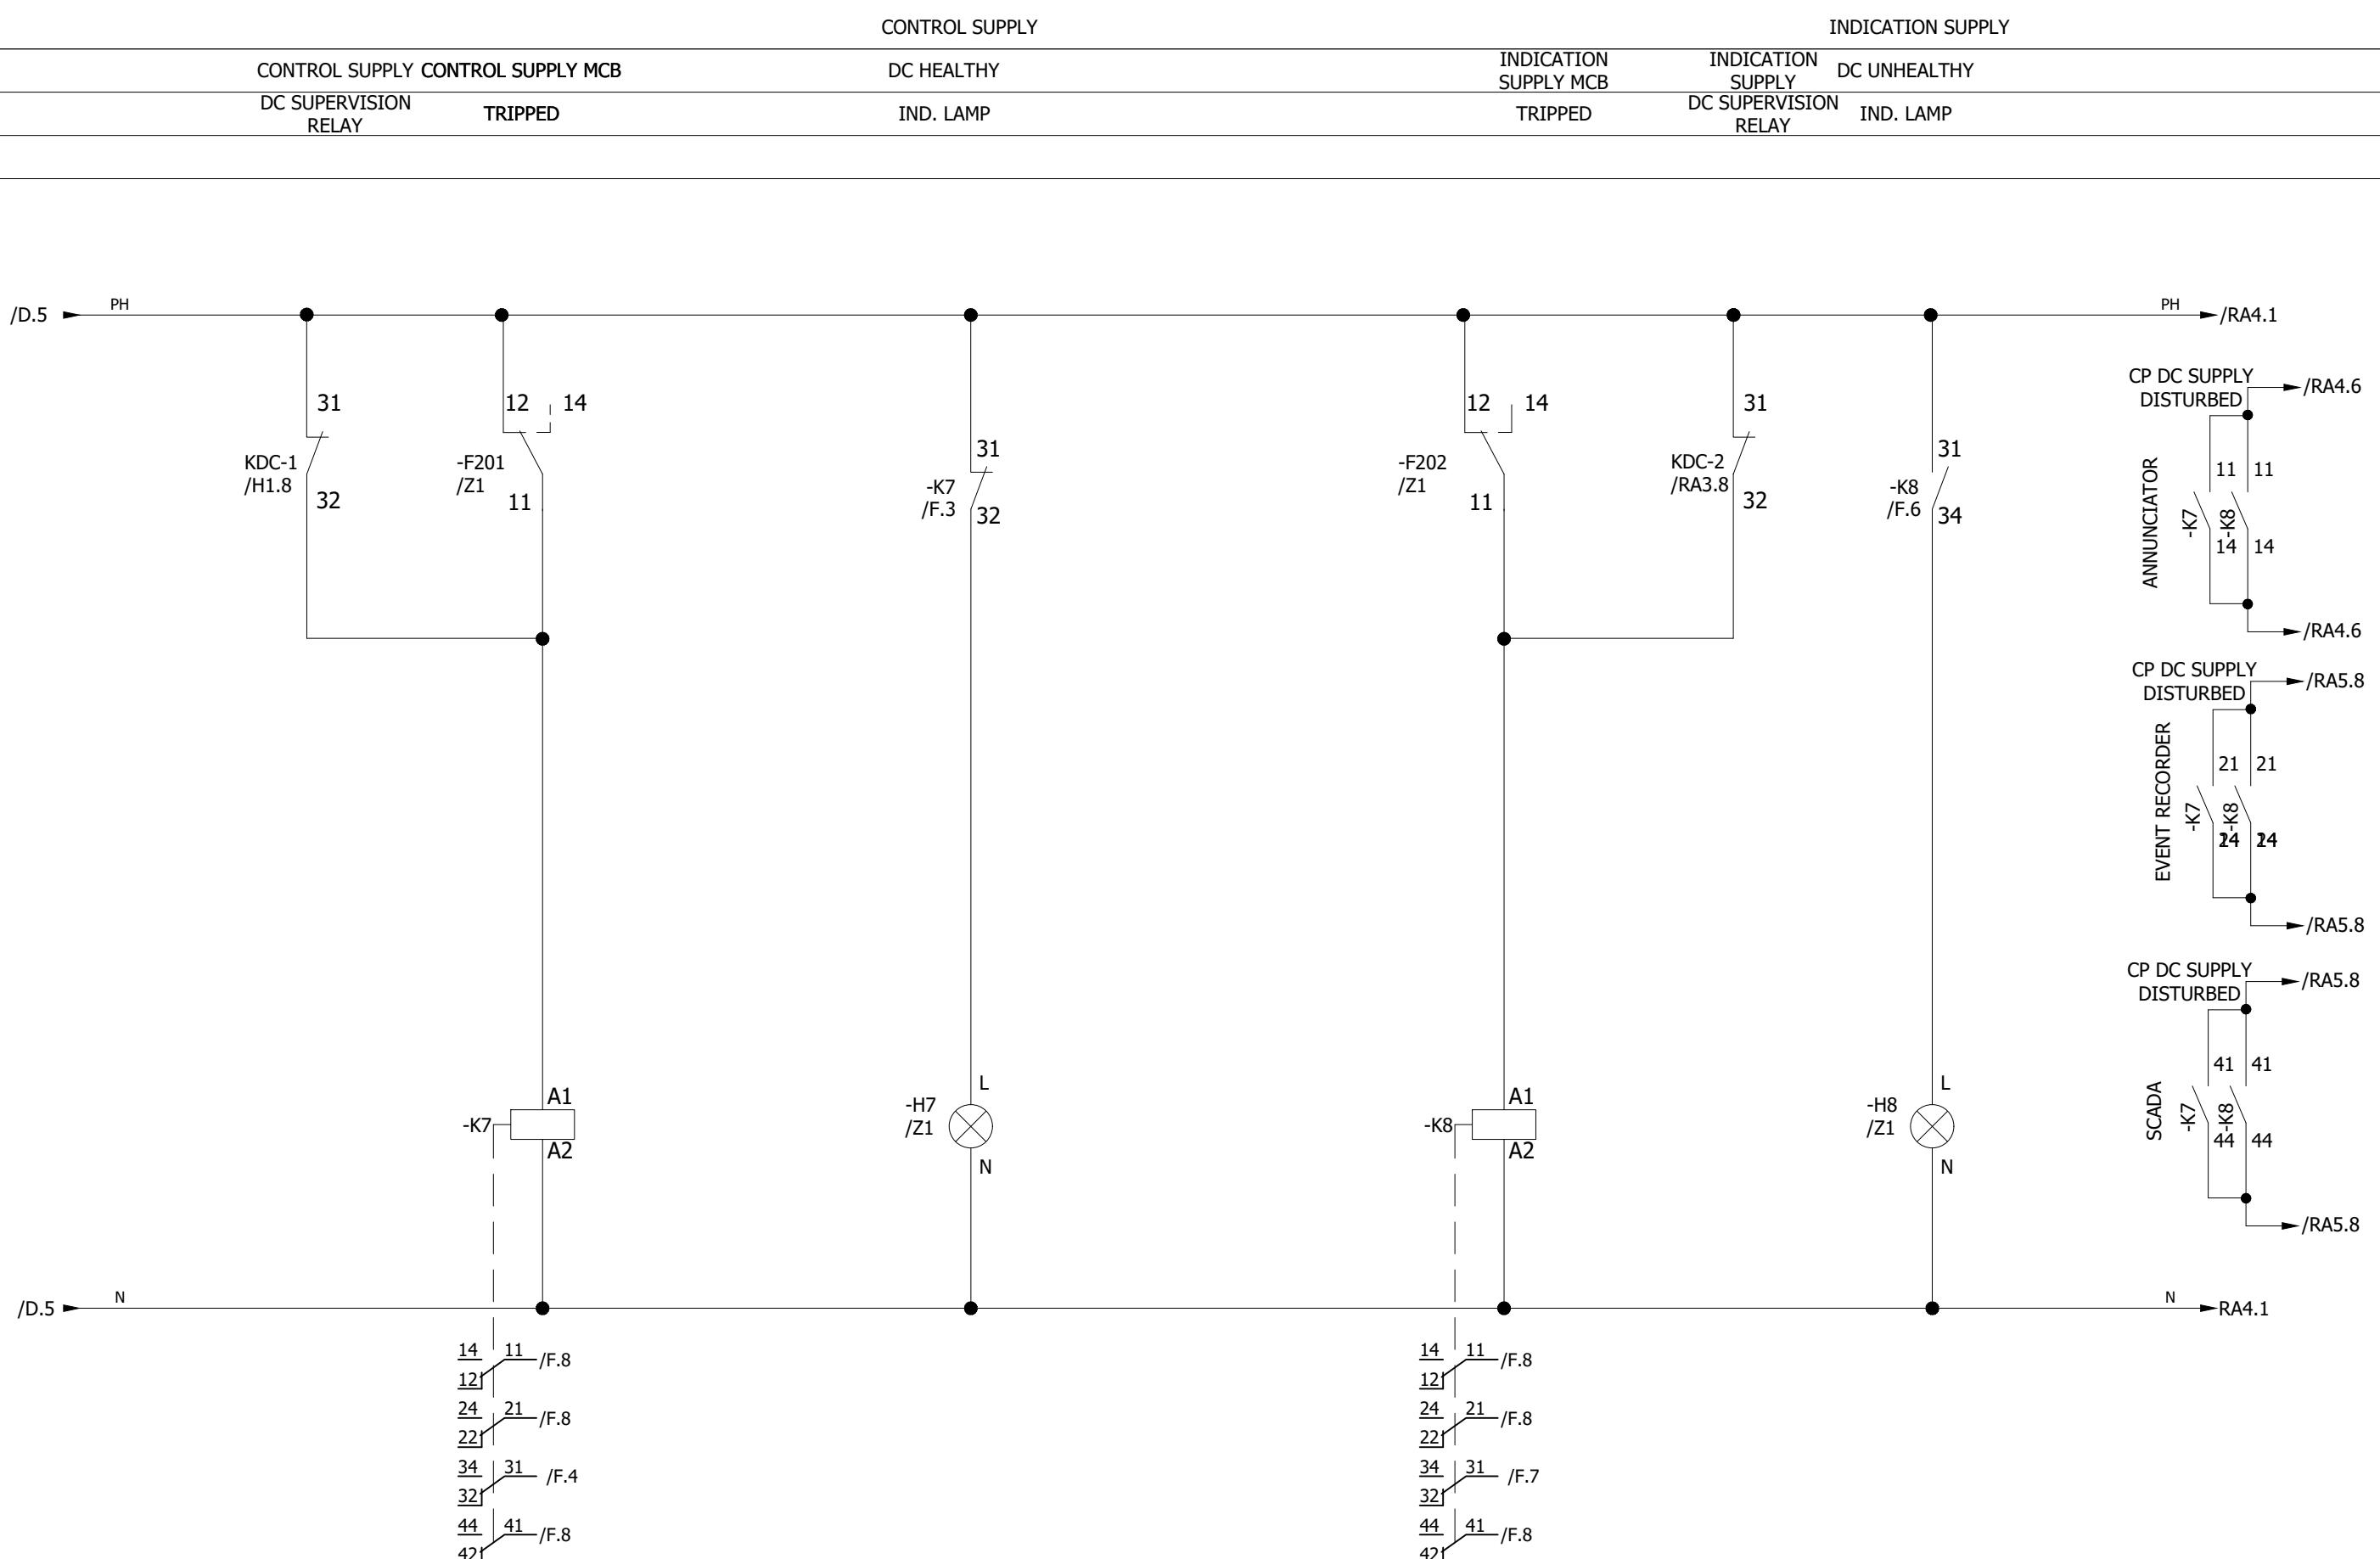

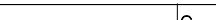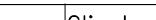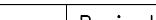0	AS BUILT	30.10.2018	ASJ	Manufacturer  EPESOL 7-B Garden Block, New Garden Town,	Contractor  Grid Solutions A GE and Alstom joint venture	Client  NATIONAL TRANSMISSION & DISPATCH COMPANY LIMITED	Project 220kV/132kV GIS SUBSTATION GHAZI ROAD, LAHORE	Title 132kV LINE CONTROL PANEL (=E10+CP31) DC SUPPLY FAILURE ALARM CIRCUIT	Drawing no. P60194-E-ELC-SC-007		
									Project no. P-60194		
									Sheet type F		
REV.	DESCRIPTION	DATE	DRAWER	1	2	3	4	5	6	7	8

1 2 3 4 5 6 7 8

TEST BLOCK

AM METERS

MW METER (-Q5)

MVAR METER (-Q6)

DIGITAL POWER METER

REVENUE METER

TS


(-Q1, -Q2, -Q3) WITH
TRANSDUCERS
(-U1, , -U2, -U3)

WITH TRANSDUCER (-U5)

(-Q7)

(-P11)

All information contained in this document is the exclusive property of GE GRID SOLUTIONS and shall not be used, copied or communicated to third parties without its prior authorization.

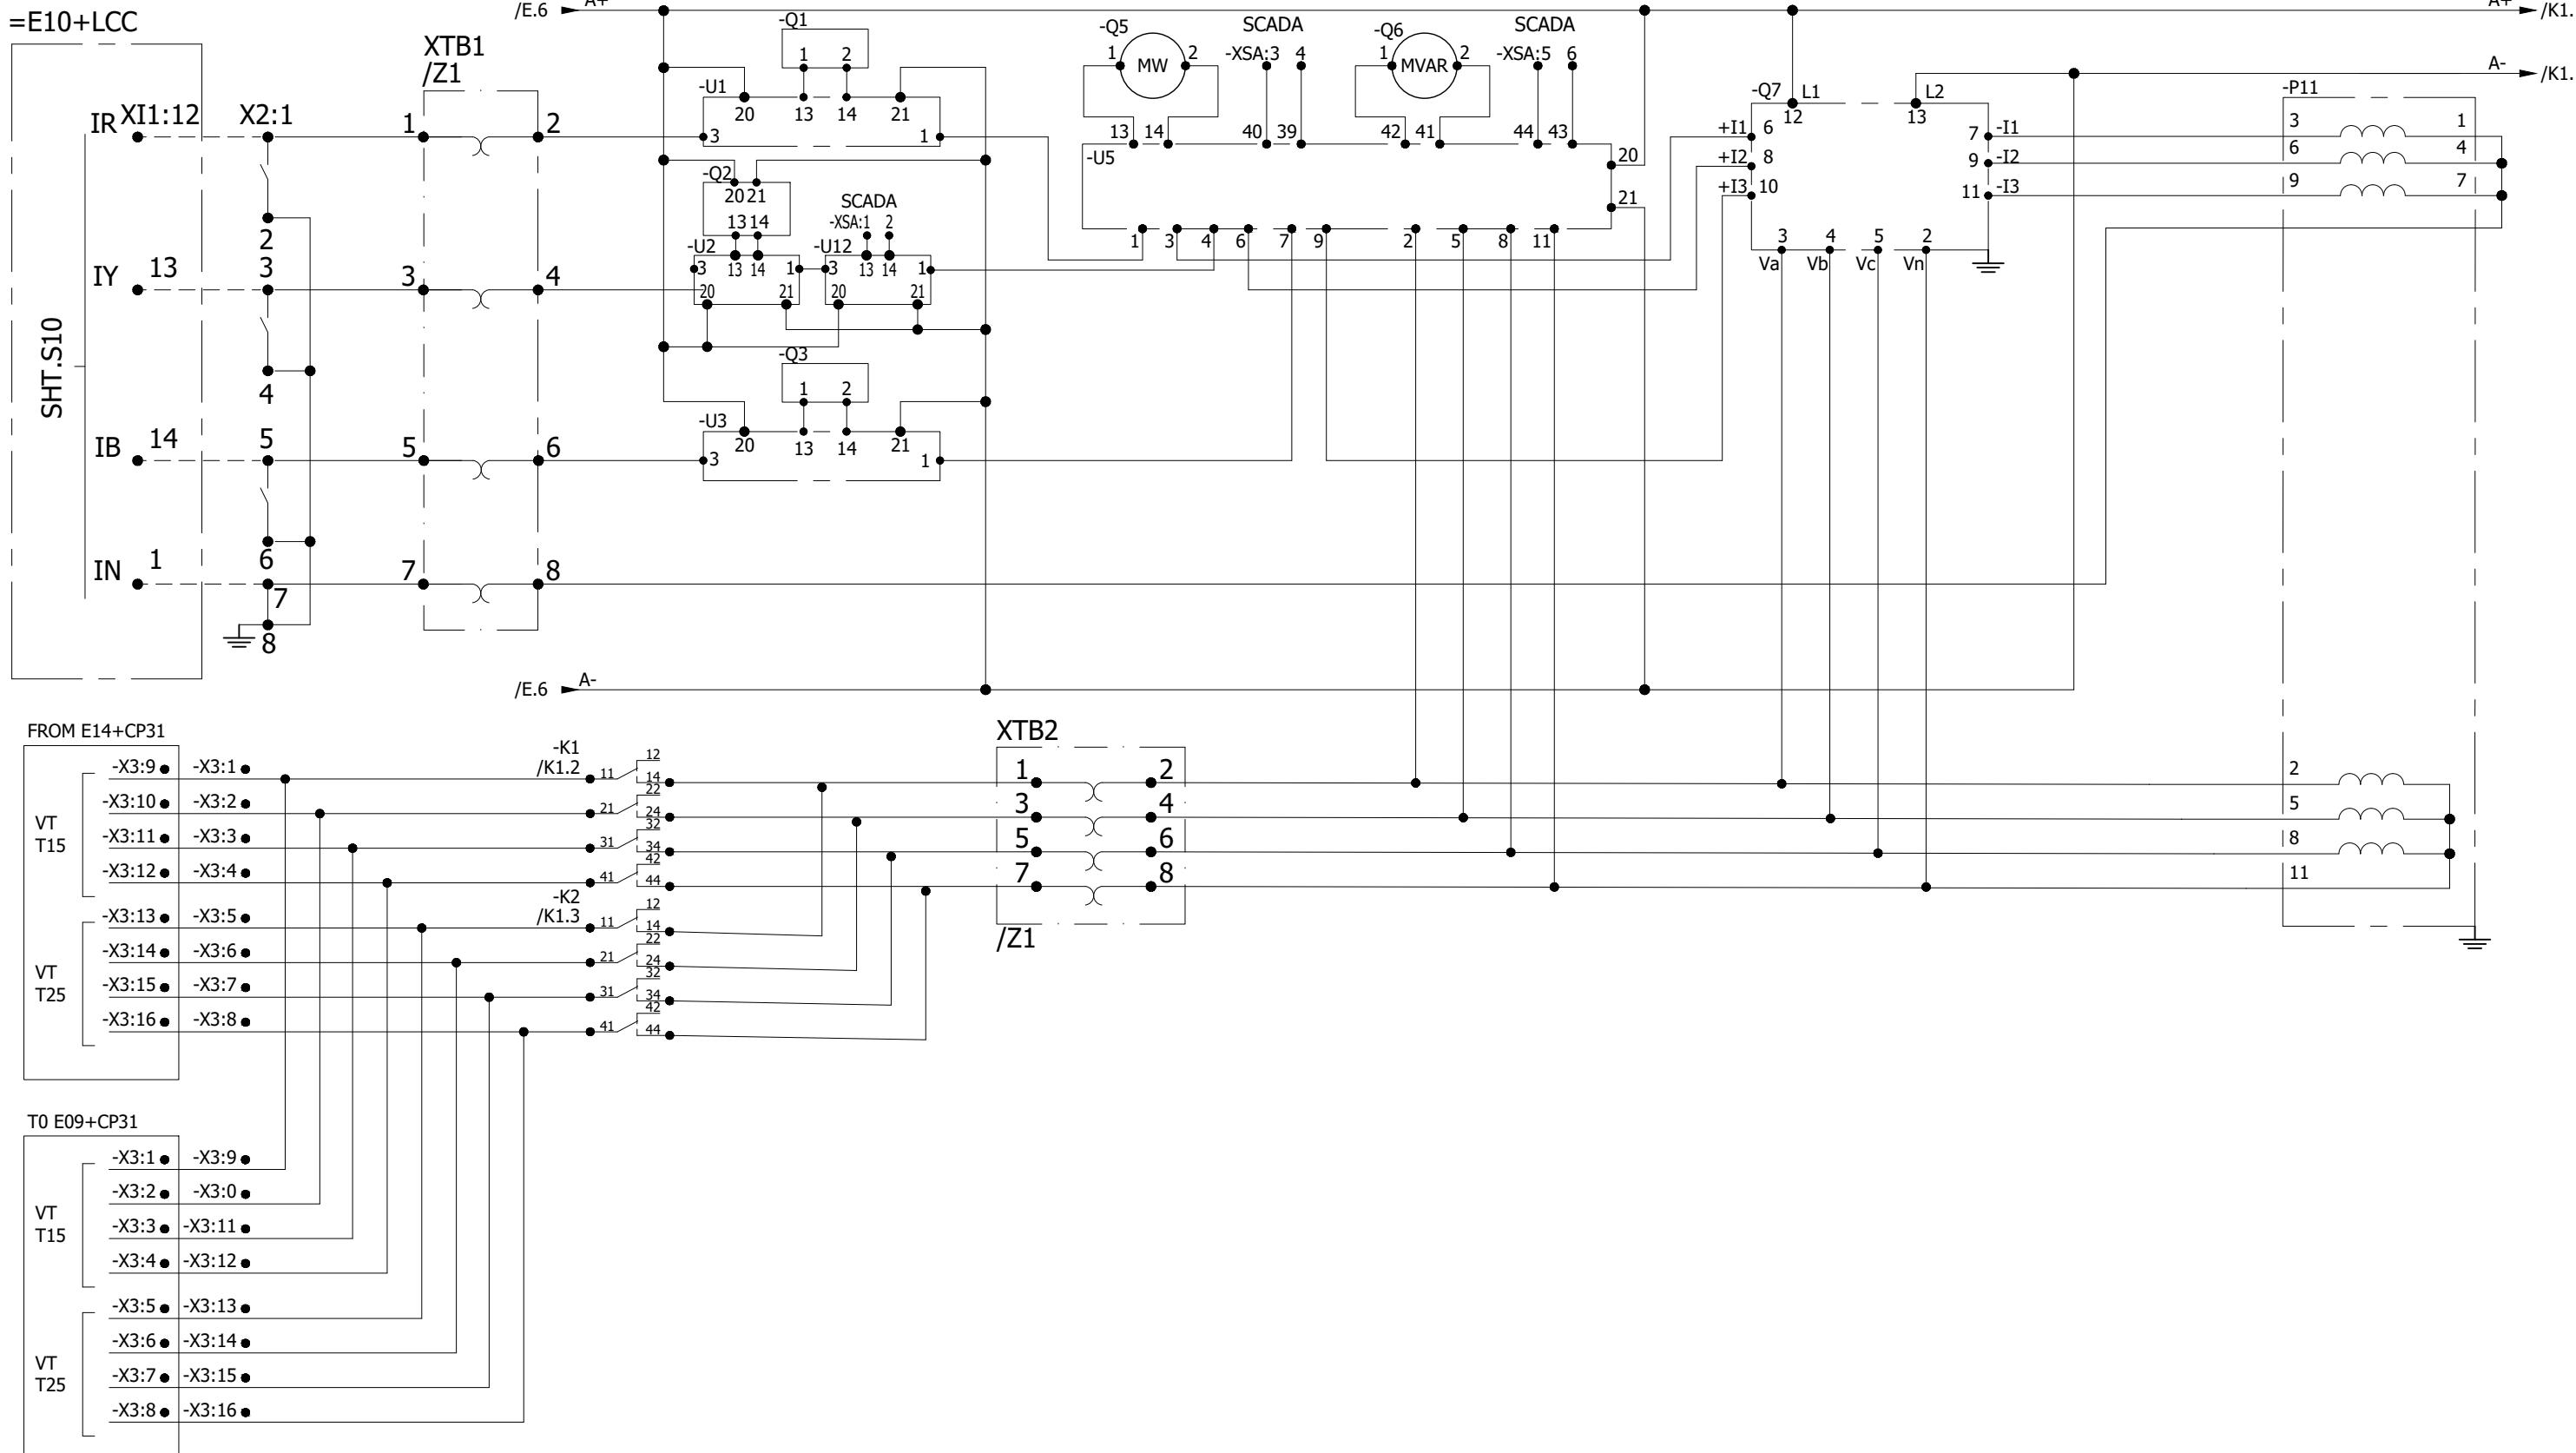

0	AS BUILT		30.10.2018	ASJ	Manufacturer	Contractor	Client	Project	Title	Drawing no.		
REV.	DESCRIPTION		DATE	DRAWER	EPEPSOL 71-B Garden Block, New Garden Town,	Grid Solutions A GE and Alstom joint venture	NATIONAL TRANSMISSION & DISPATCH COMPANY LIMITED	220KV/132KV GIS SUBSTATION GHAZI ROAD, LAHORE	132KV LINE CONTROL PANEL (=E10+CP31) METERING	P-60194-E-ELC-SC-007		
										Project no. P-60194	Sheet type G	Sheet no. 11
1			2	3	4	5	6	7	8			

1 2 3 4 5 6 7 8


C O N T R O L R O O M

DC SUPERVISION
RELAY SCADA
CONTROL

CLOSE

OPEN KDC-1 CLOSE OPEN

All information contained in this document is the exclusive property of GE GRID SOLUTIONS and shall not be used, copied or communicated to third parties without its prior authorization.

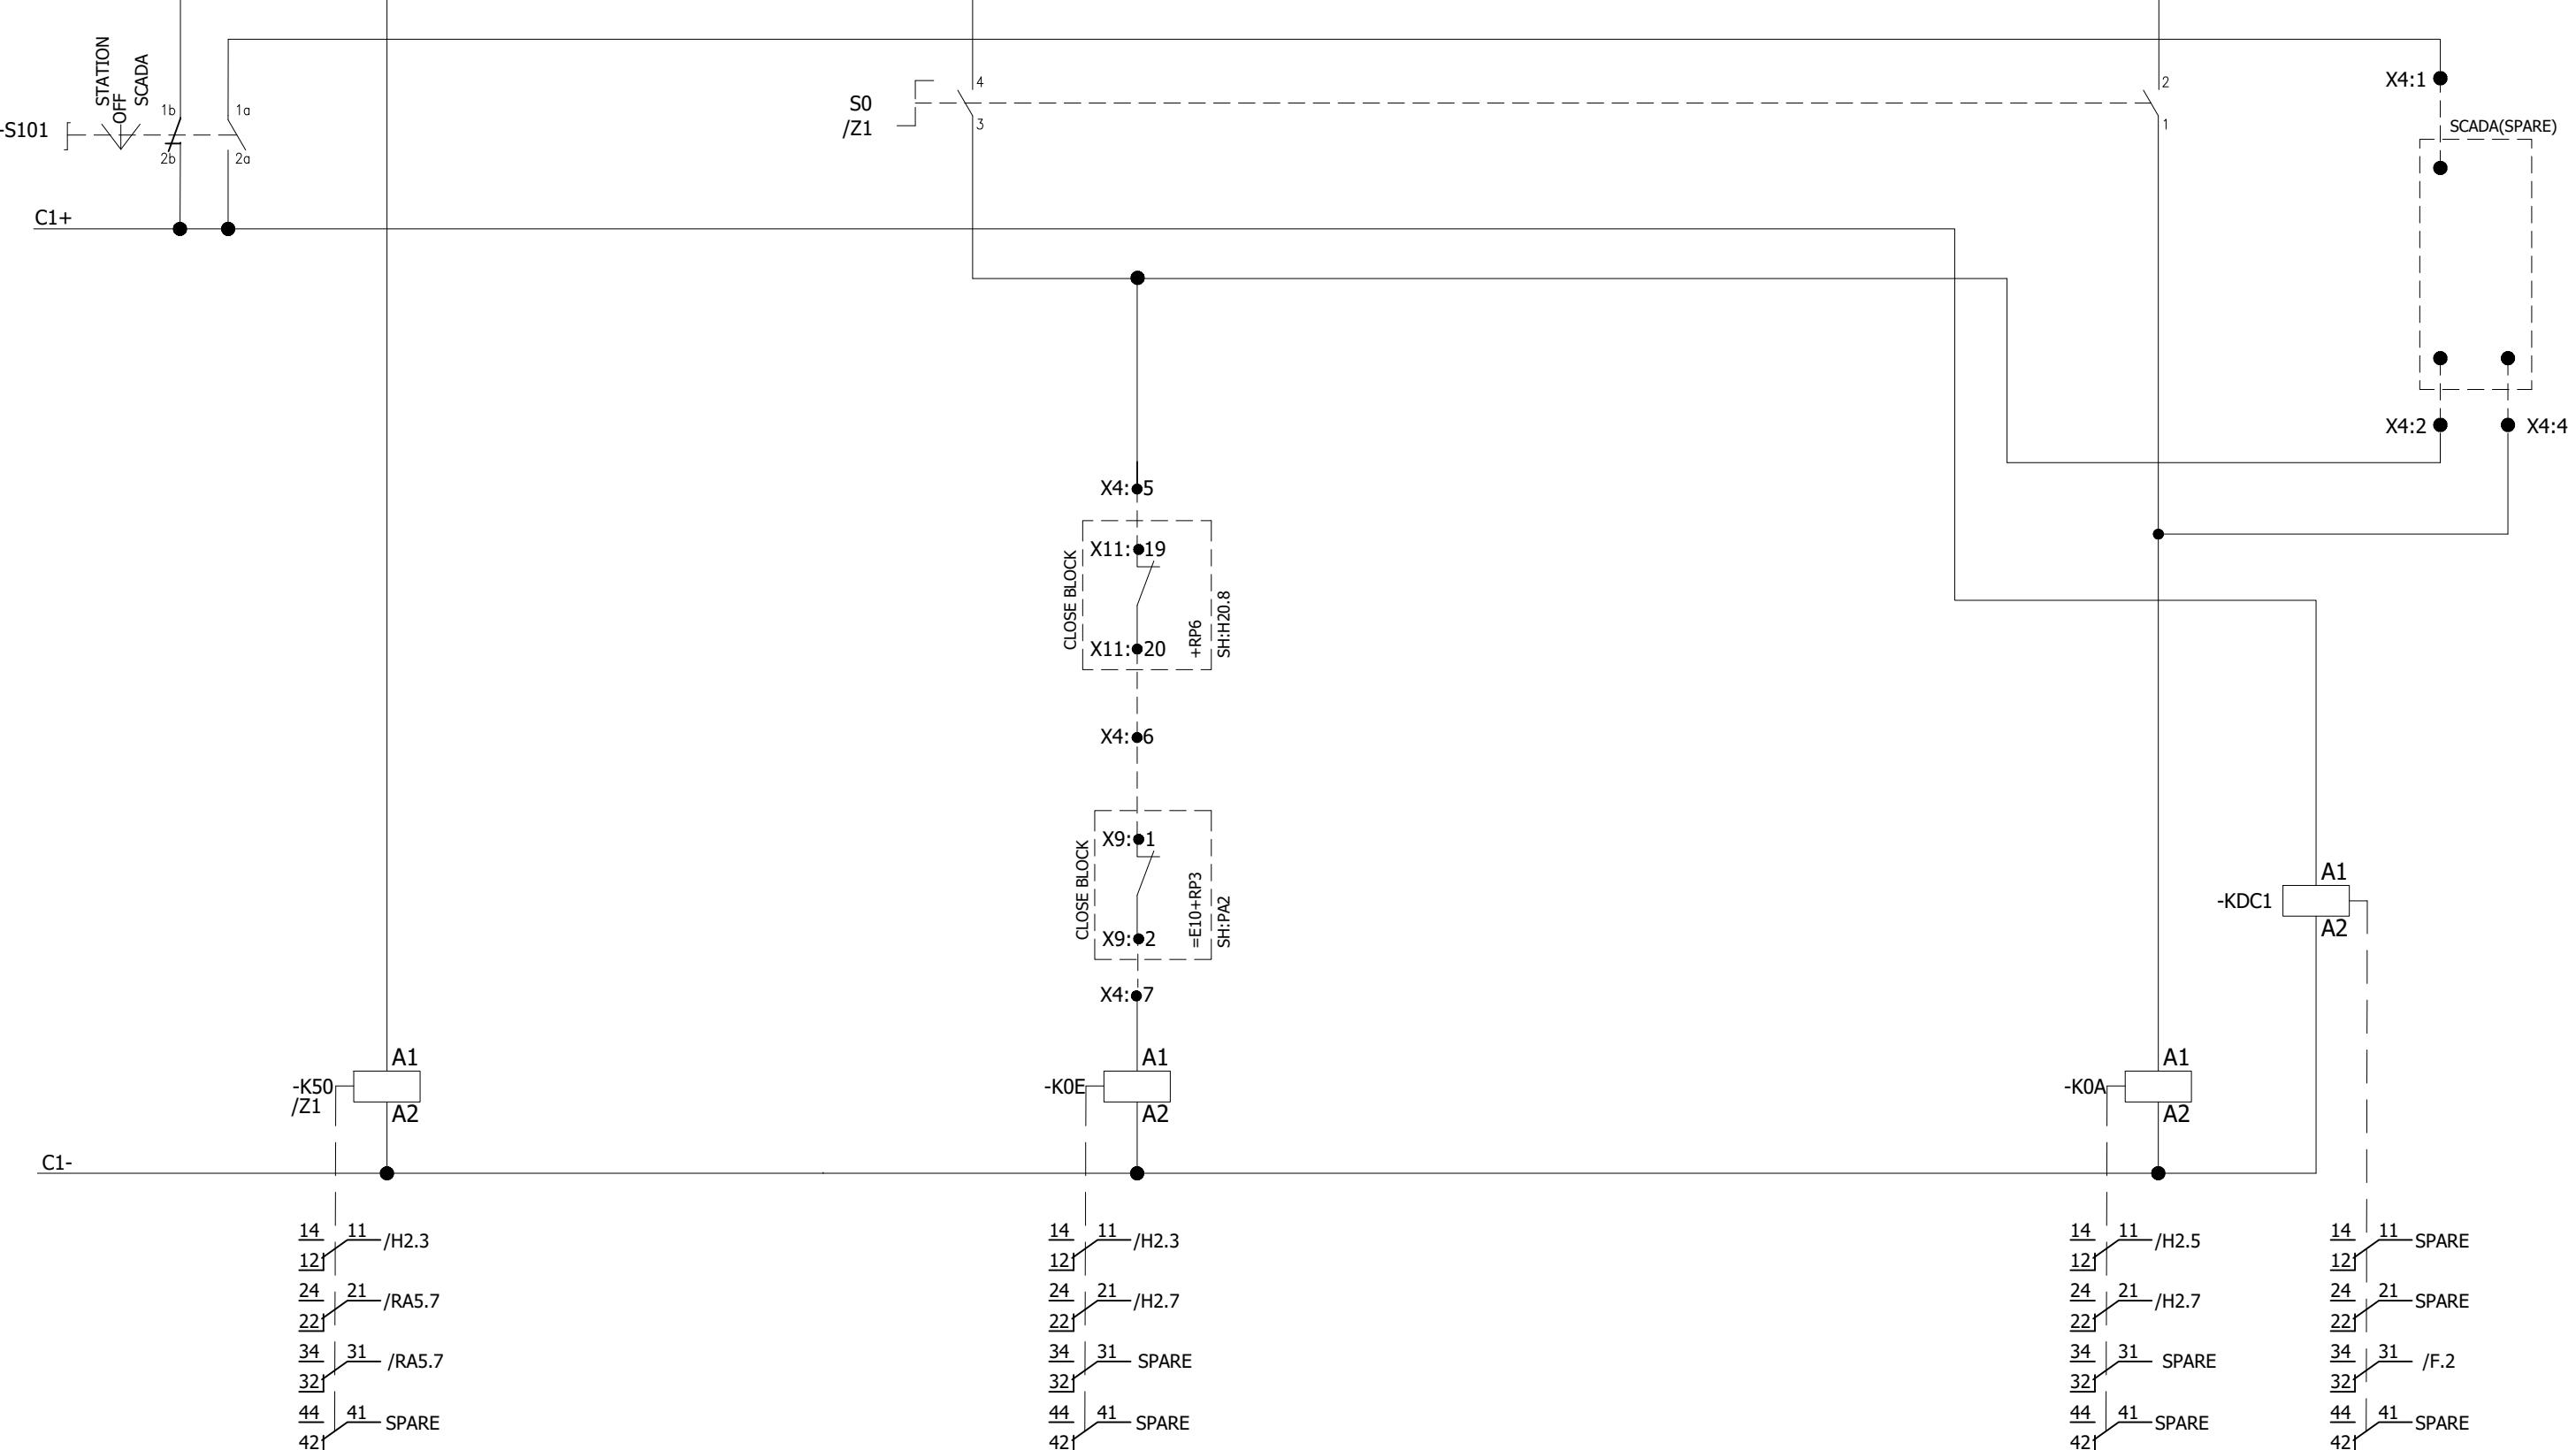

0	AS BUILT	30.10.2018	ASJ	Manufacturer  EPESOL 71-B Garden Block, New Garden Town,	Contractor  Grid Solutions A GE and Alstom joint venture	Client  NATIONAL TRANSMISSION & DISPATCH COMPANY LIMITED	Project 220kV/132kV GIS SUBSTATION GHAZI ROAD, LAHORE	Title 132kV LINE CONTROL PANEL (=E10+CP31) CB CONTROL CIRCUIT	Drawing no. P60194-E-ELC-SC-007
REV.	DESCRIPTION	DATE	DRAWER						Project no. P-60194
									Sheet type H1
									Sheet no. 12



All information contained in this document is the exclusive property of GE GRID SOLUTIONS and shall not be used, copied or communicated to third parties without its prior authorization.

C O N T R O L R O O M C O N T R O L

AUTORECLOSE(SPARE)

CLOSE

OPEN

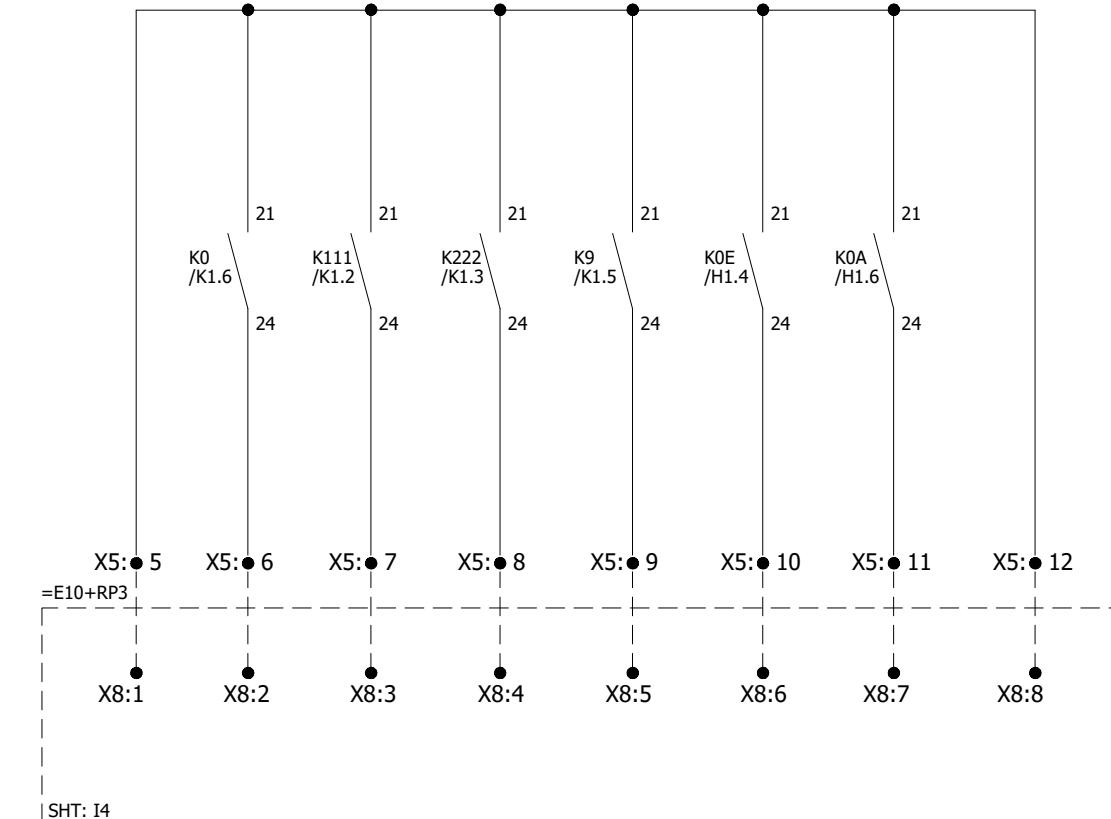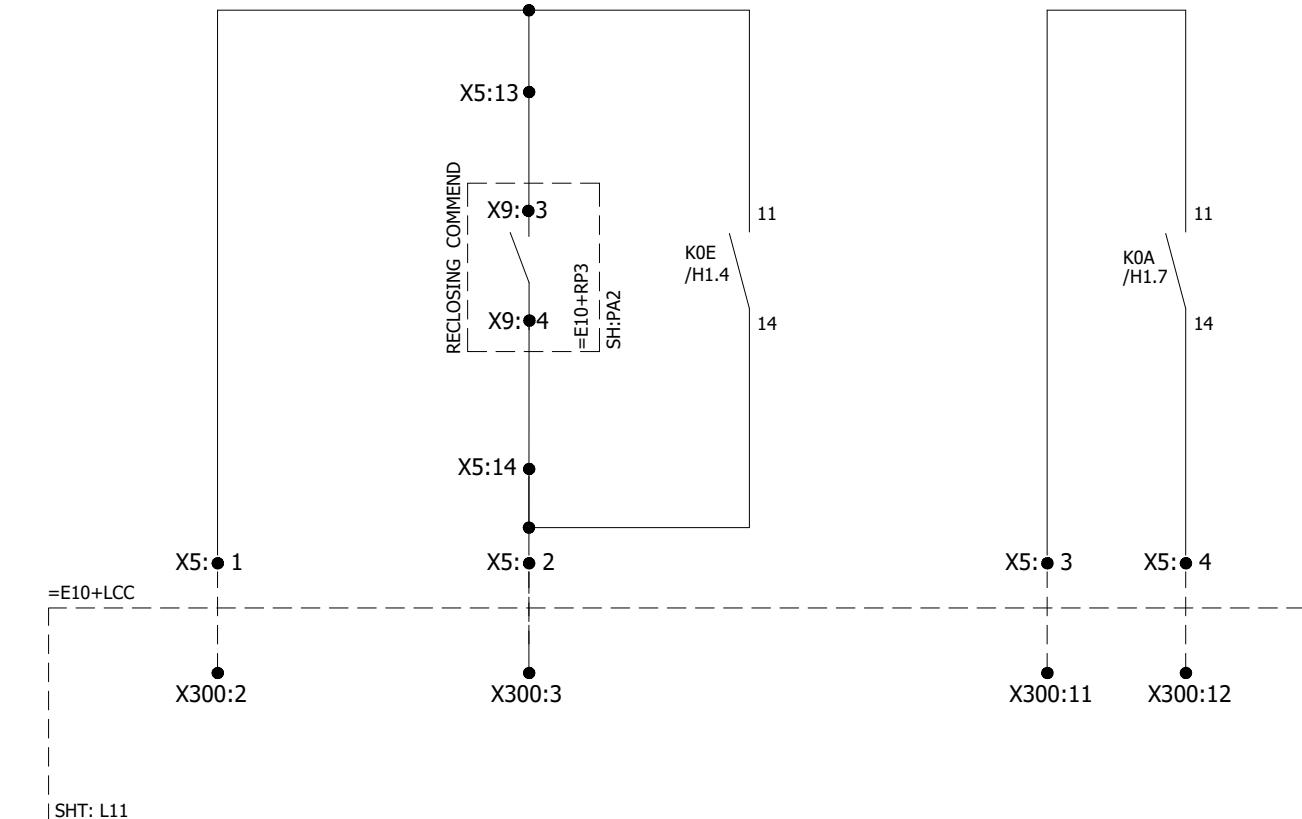

CB CLOSE STATUS

Q1 CLOSE STATUS

Q2 CLOSE STATUS

Q9 CLOSE STATUS

MANUAL CLOSE INPUT FOR DISTANCE RELAY

MANUAL OPEN INPUT FOR DISTANCE RELAY

A
B
C
D
E
F

A
B
C
D
E
F

0	AS BUILT	30.10.2018	ASJ	Manufacturer  EPESOL 7-B Garden Block, New Garden Town,	Contractor  Grid Solutions A GE and Alstom joint venture	Client  NATIONAL TRANSMISSION & DISPATCH COMPANY LIMITED	Project 220kV/132kV GIS SUBSTATION GHAZI ROAD, LAHORE	Title 132kV LINE CONTROL PANEL (=E10+CP31) CB CONTROL CIRCUIT	Drawing no. P60194-E-ELC-SC-007
REV.	DESCRIPTION	DATE	DRAWER						Project no. P-60194
									Sheet type H2
									Sheet no. 13

=E10+Q51

CLOSE

OPEN

=E10+Q53

CLOSE




OPEN

=E10+Q8


CLOSE

OPEN

All information contained in this document is the exclusive property of GE GRID SOLUTIONS and shall not be used, copied or communicated to third parties without its prior authorization.

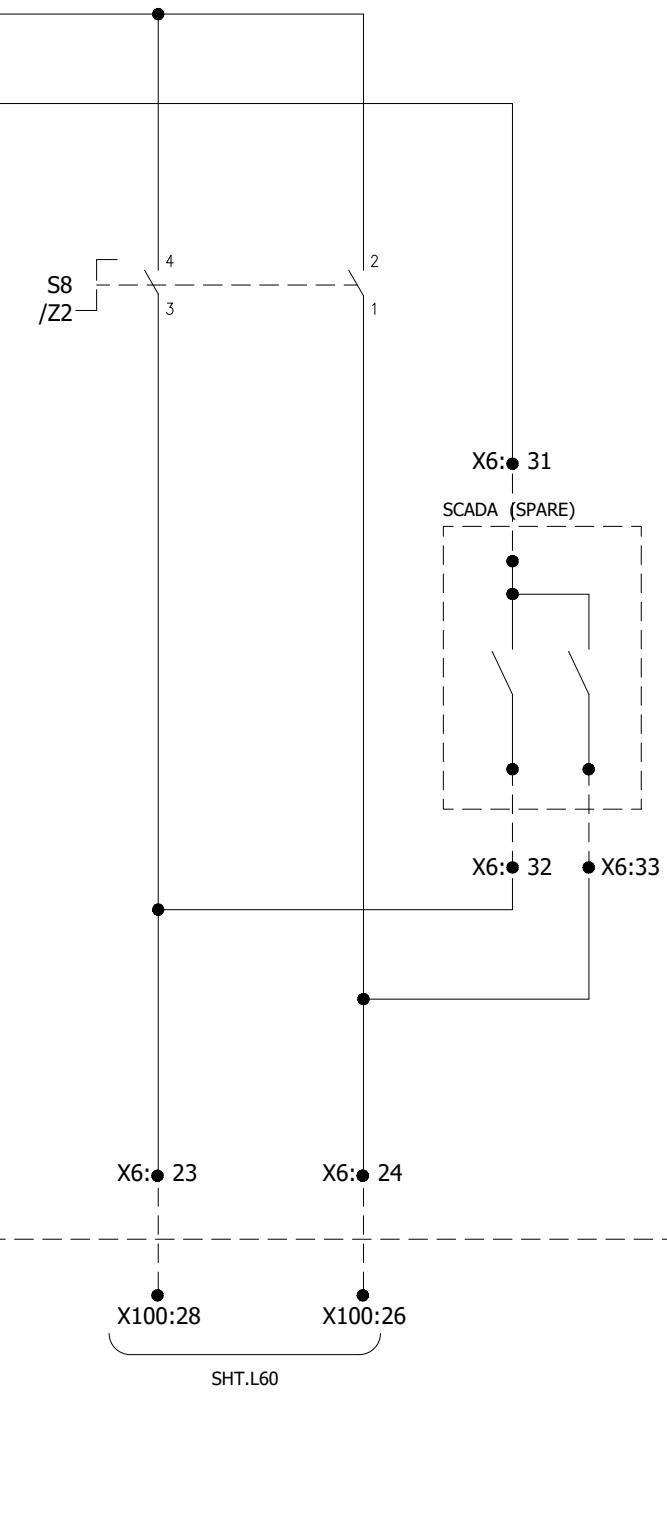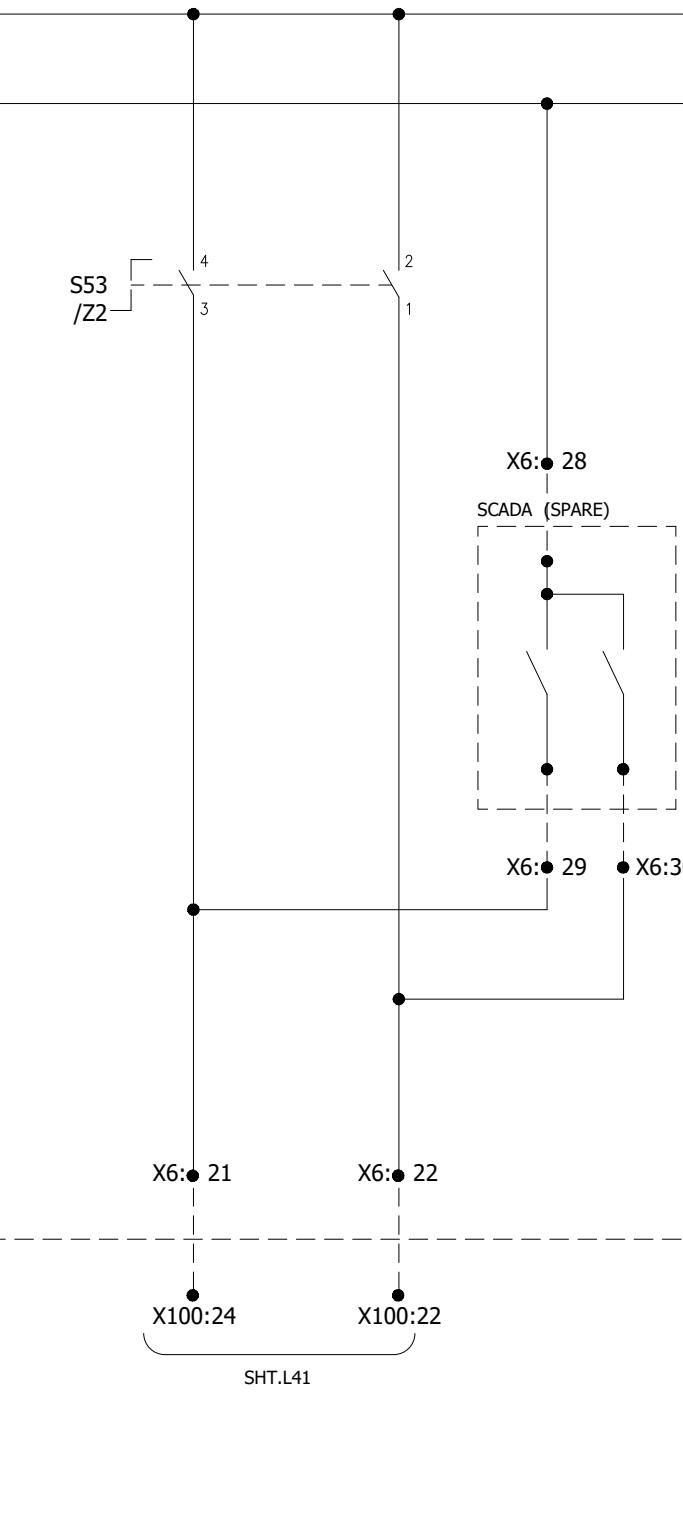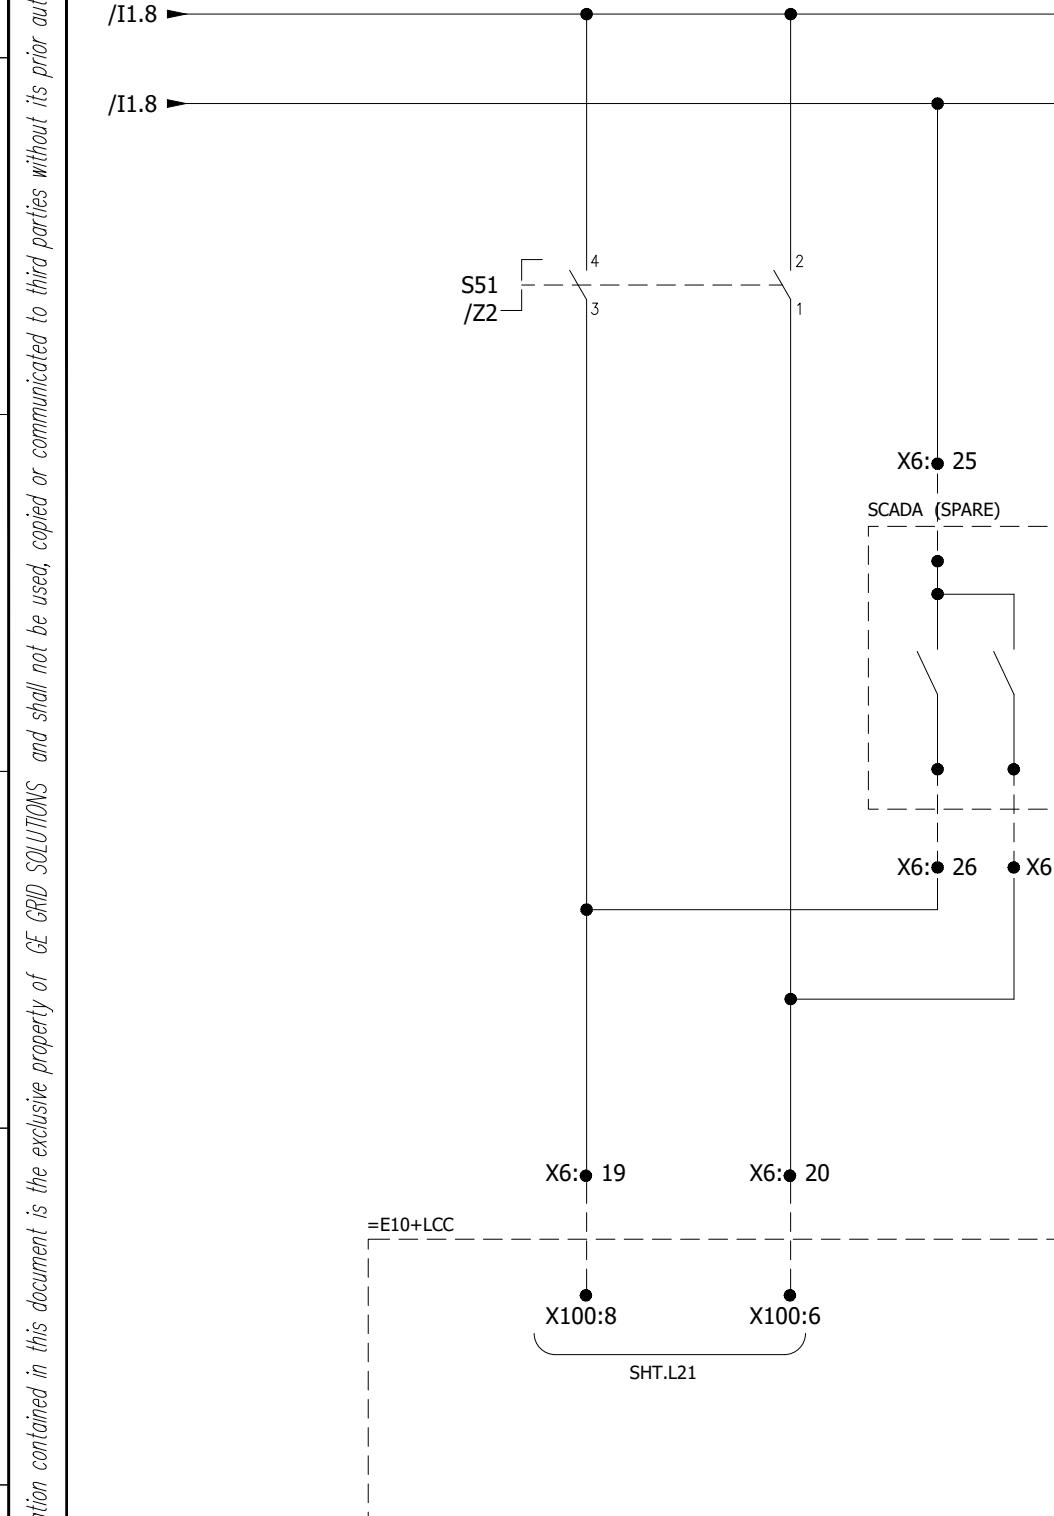


0	AS BUILT		30.10.2018	ASJ	Manufacturer  EPESOL 71-B Garden Block, New Garden Town,	Contractor  GE Grid Solutions A GE and Alstom joint venture	Client 	Project 220kV/132kV GIS SUBSTATION GHAZI ROAD, LAHORE	Title 132kV LINE CONTROL PANEL (=E10+CP31) DISCONNECTOR & EARTH SWITCH CONTROL	Drawing no. P60194-E-ELC-SC-007		
REV.	DESCRIPTION		DATE	DRAWER						Project no. P-60194	Sheet type I2	Sheet no. 15
1	2	3	4	5	6	7	8					

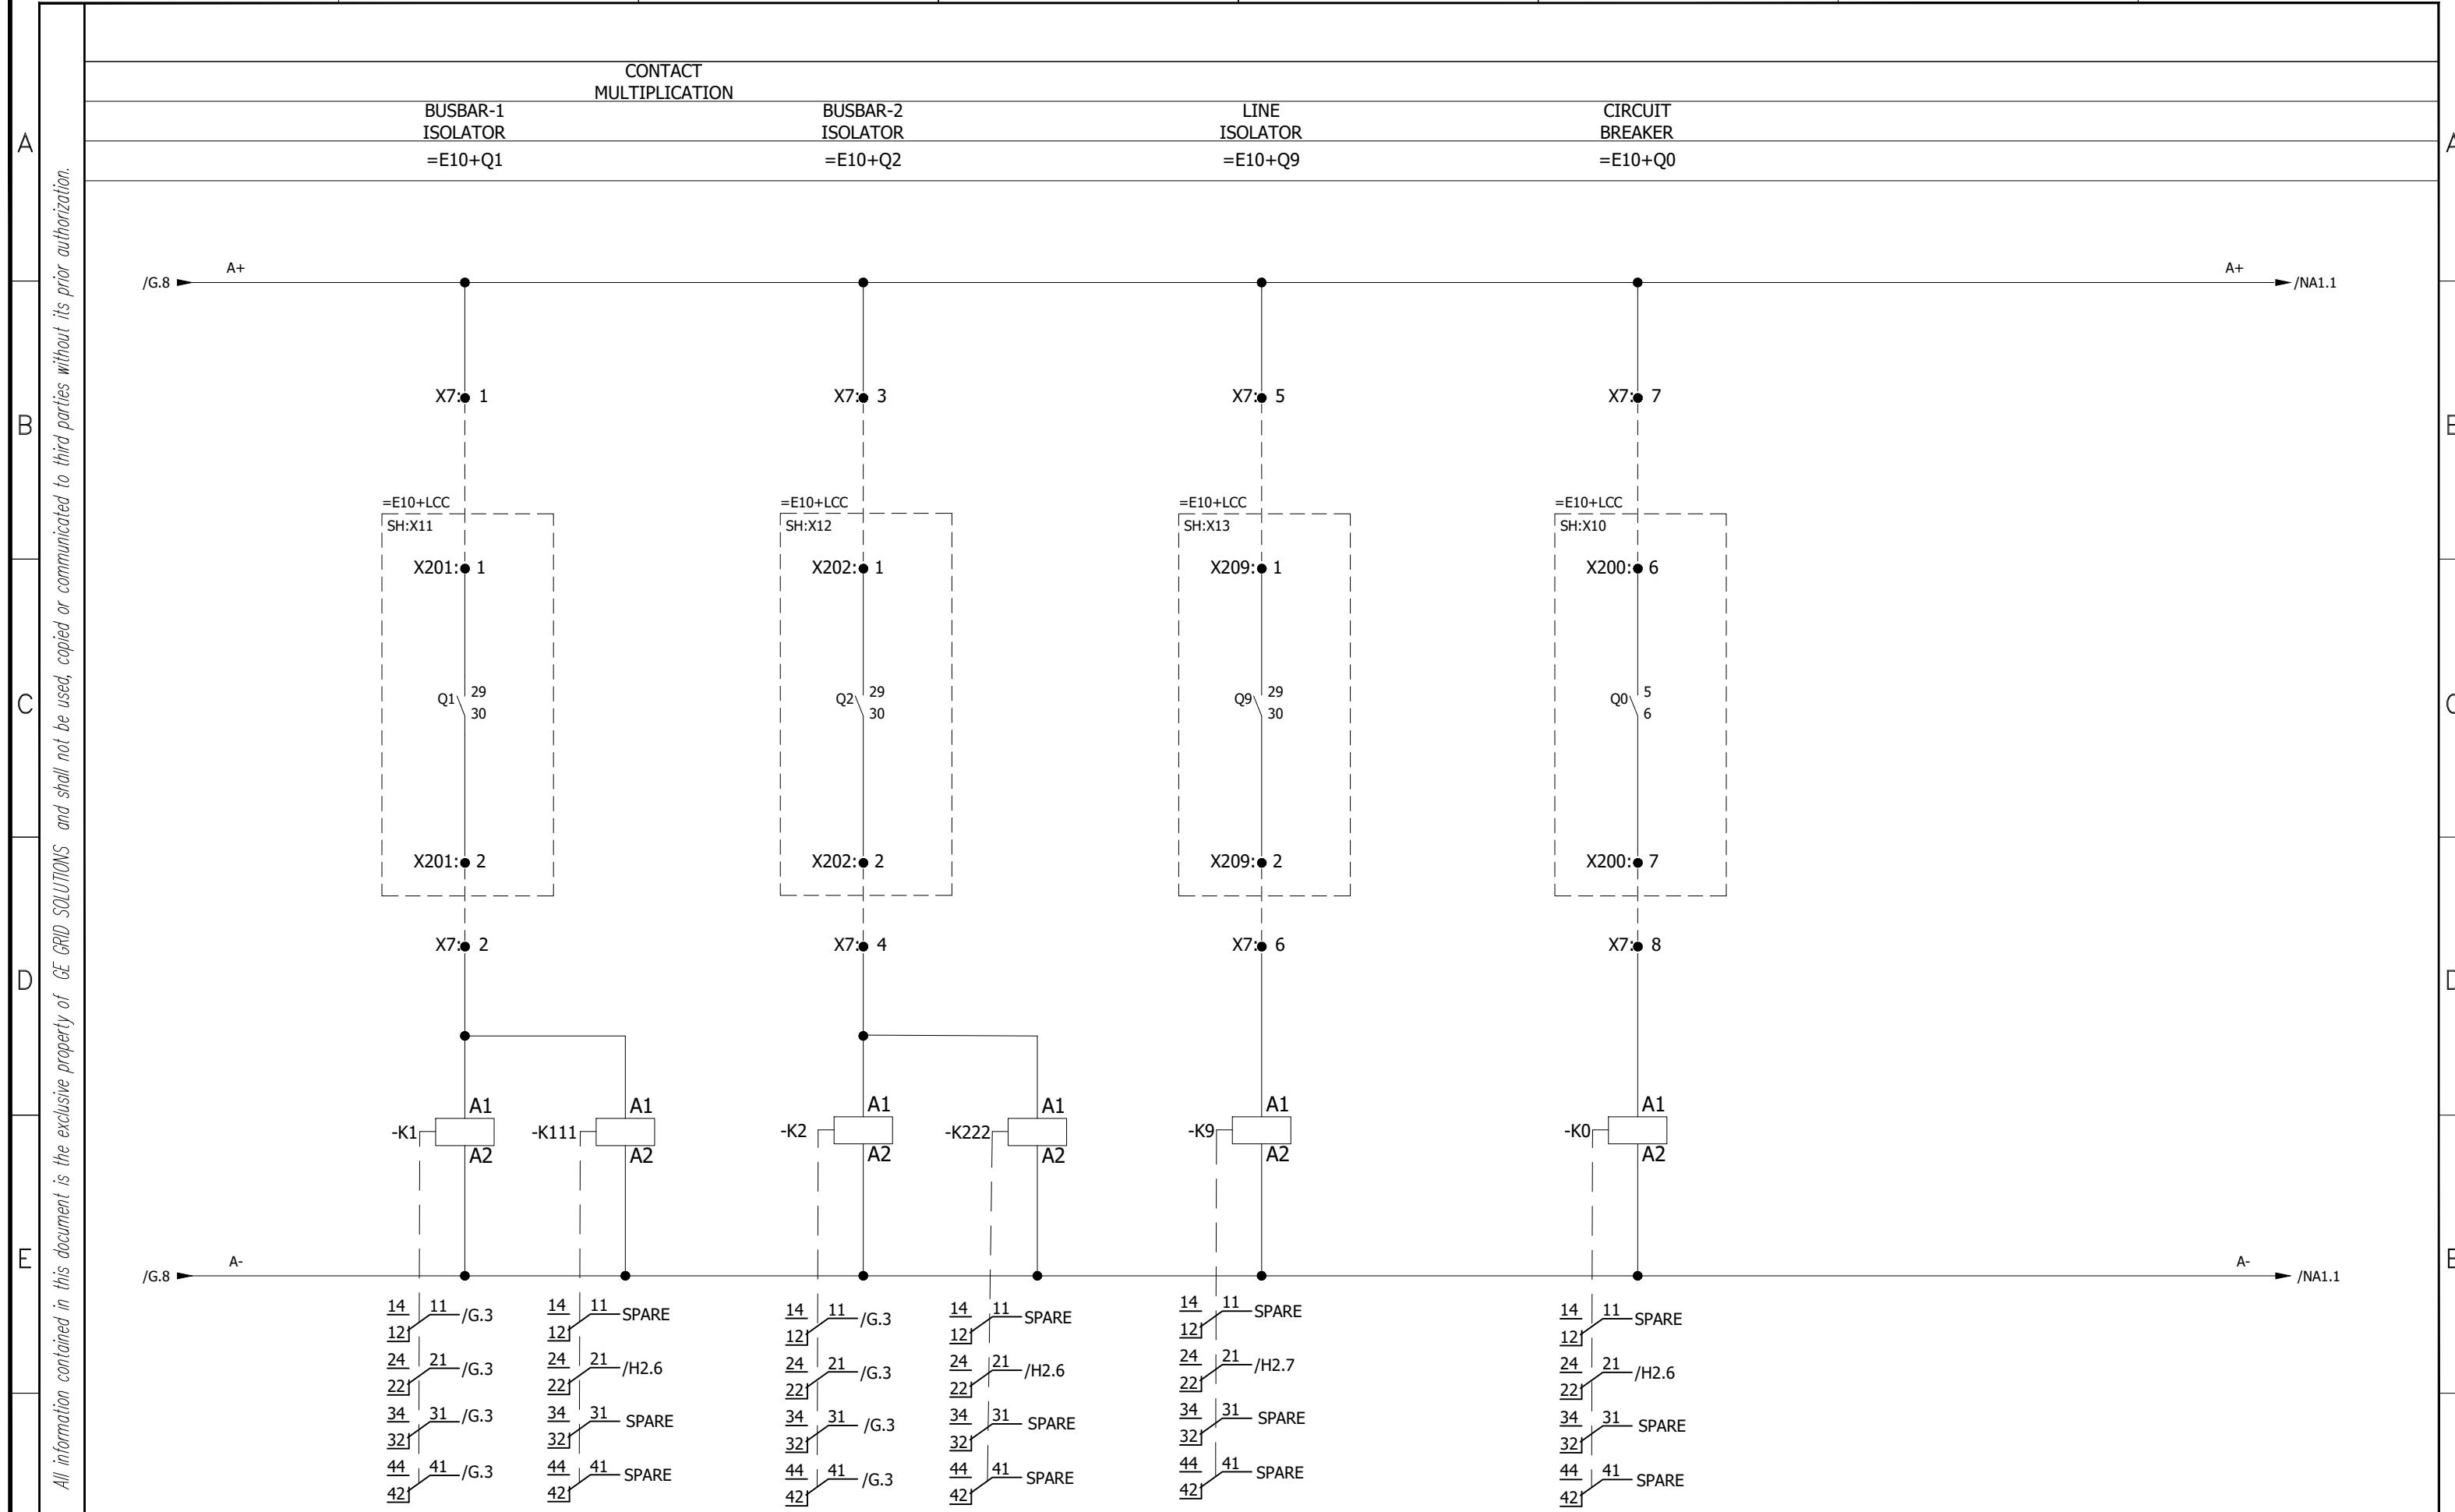

0	AS BUILT		30.10.2018	ASJ	Manufacturer  EPESOL 7-B Garden Block, New Garden Town,	Contractor  Grid Solutions A GE and Alstom joint venture	Client  NATIONAL TRANSMISSION & DISPATCH COMPANY LIMITED	Project 220kV/132kV GIS SUBSTATION GHAZI ROAD, LAHORE	Title 132kV LINE CONTROL PANEL (=E10+CP31) CB/DISCONNECTOR CONTACT MULTIPLICATION	Drawing no. P60194-E-ELC-SC-007		
REV.	DESCRIPTION		DATE	DRAWER						Project no. P-60194	Sheet type K1	Sheet no. 16
1	2	3	4	5	6	7	8					

1	2	3	4	5	6	7	8
A	CONTACT MULTIPLICATION	POSITION	LONG SPRING CHARGING TIME	CONTROL SUPPLY MCB TRIPPED	GAS MONITOR MCB TRIPPED	CB TRIPPING 1 MCB TRIPPED	LIGHTING AC SUPPLY MCB TRIPPED
G9 ALARM 1	G1 LEVEL 1	G0 ALARM	REPEAT ABNORMAL	DS/ES/HES OPERATION TIME ABNORMAL	SPRING DISCHARGED	DS/ES/HES MOTOR SUPPLY MCB TRIPPED	CB MOTOR THERMAL OVERLOAD
G91 ALARM 1	G2 LEVEL 1	G0 LOCK			ALARM SUPPLY MCB TRIPPED	CB CLOSING MCB TRIPPED	CB TRIPPING 2 MCB TRIPPED
						CB MOTOR SUPPLY MCB TRIPPED	HEATING AC SUPPLY MCB TRIPPED
							PANEL'S AC SUPPLY FAIL

All information contained in this document is the exclusive property of GE GRID SOLUTIONS and shall not be used, copied or communicated to third parties without its prior authorization.

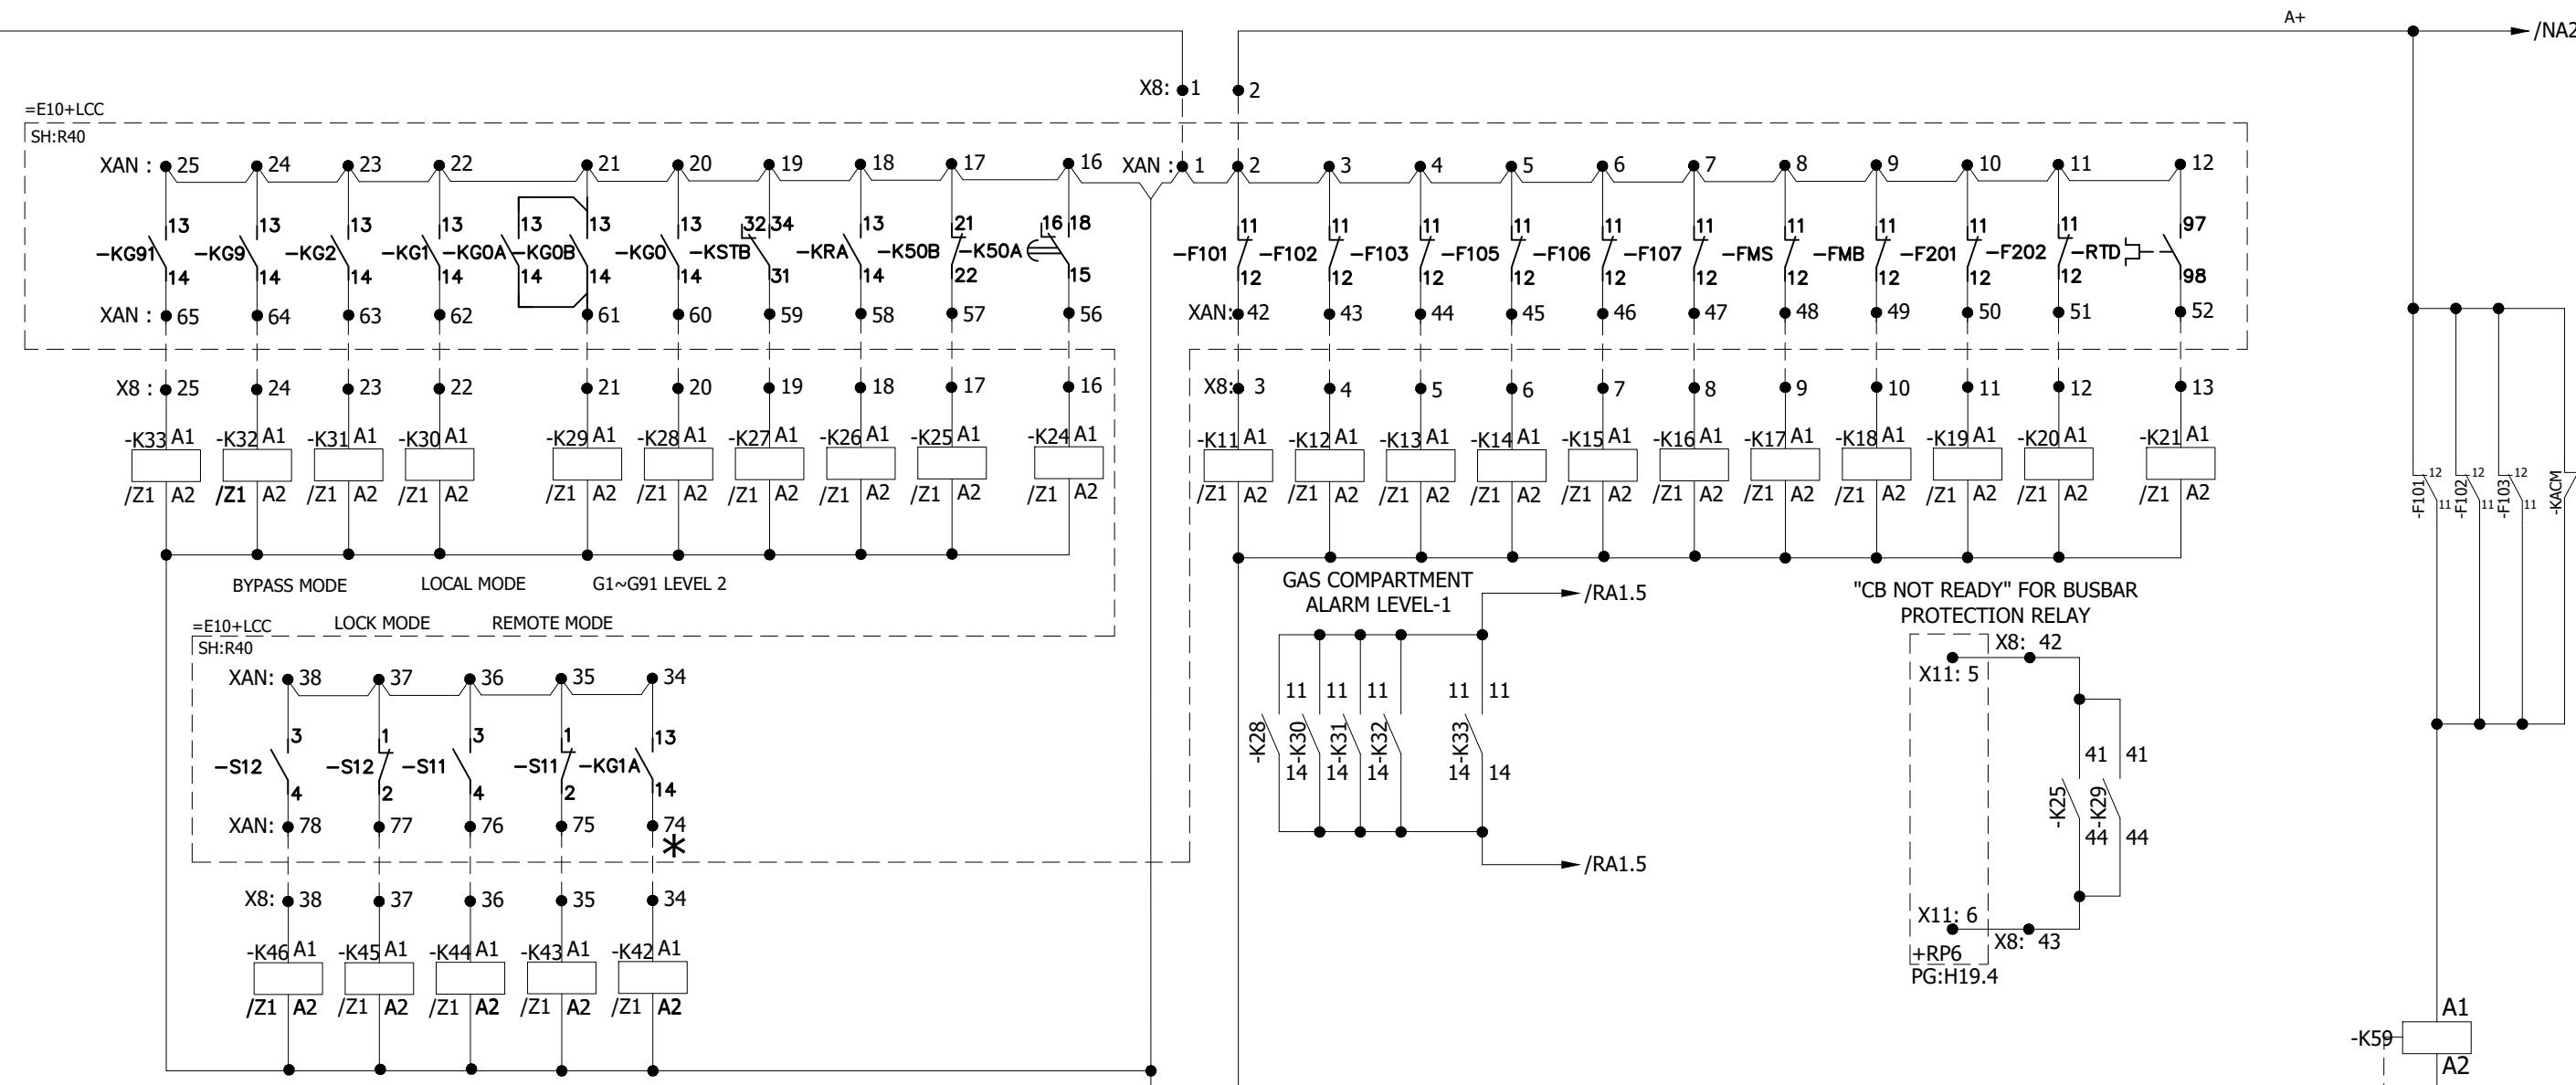

0	AS BUILT	30.10.2018	ASJ	Manufacturer	Contractor	Client	Project	Title	Drawing no.
				EPESOL	Grid Solutions	NATIONAL TRANSMISSION & DISPATCH COMPANY LIMITED	220KV/132KV GIS SUBSTATION GHAZI ROAD, LAHORE	132KV LINE CONTROL PANEL (=E10+CP31) ALARM MULTIPLICATION	P-60194-E-ELC-SC-007
REV.	DESCRIPTION	DATE	DRAWER						Project no. P-60194 Sheet type NA1 Sheet no. 17

All information contained in this document is the exclusive property of GE GRID SOLUTIONS and shall not be used, copied or communicated to third parties without its prior authorization.


A

(=E10+Q0)
OPEN CLOSE(=E10+Q1)
OPEN CLOSE(=E10+Q2)
OPEN CLOSE(=E10+Q9)
OPEN CLOSE(=E10+Q51)
OPEN CLOSE

A+

/NA3.1


/NA1.8

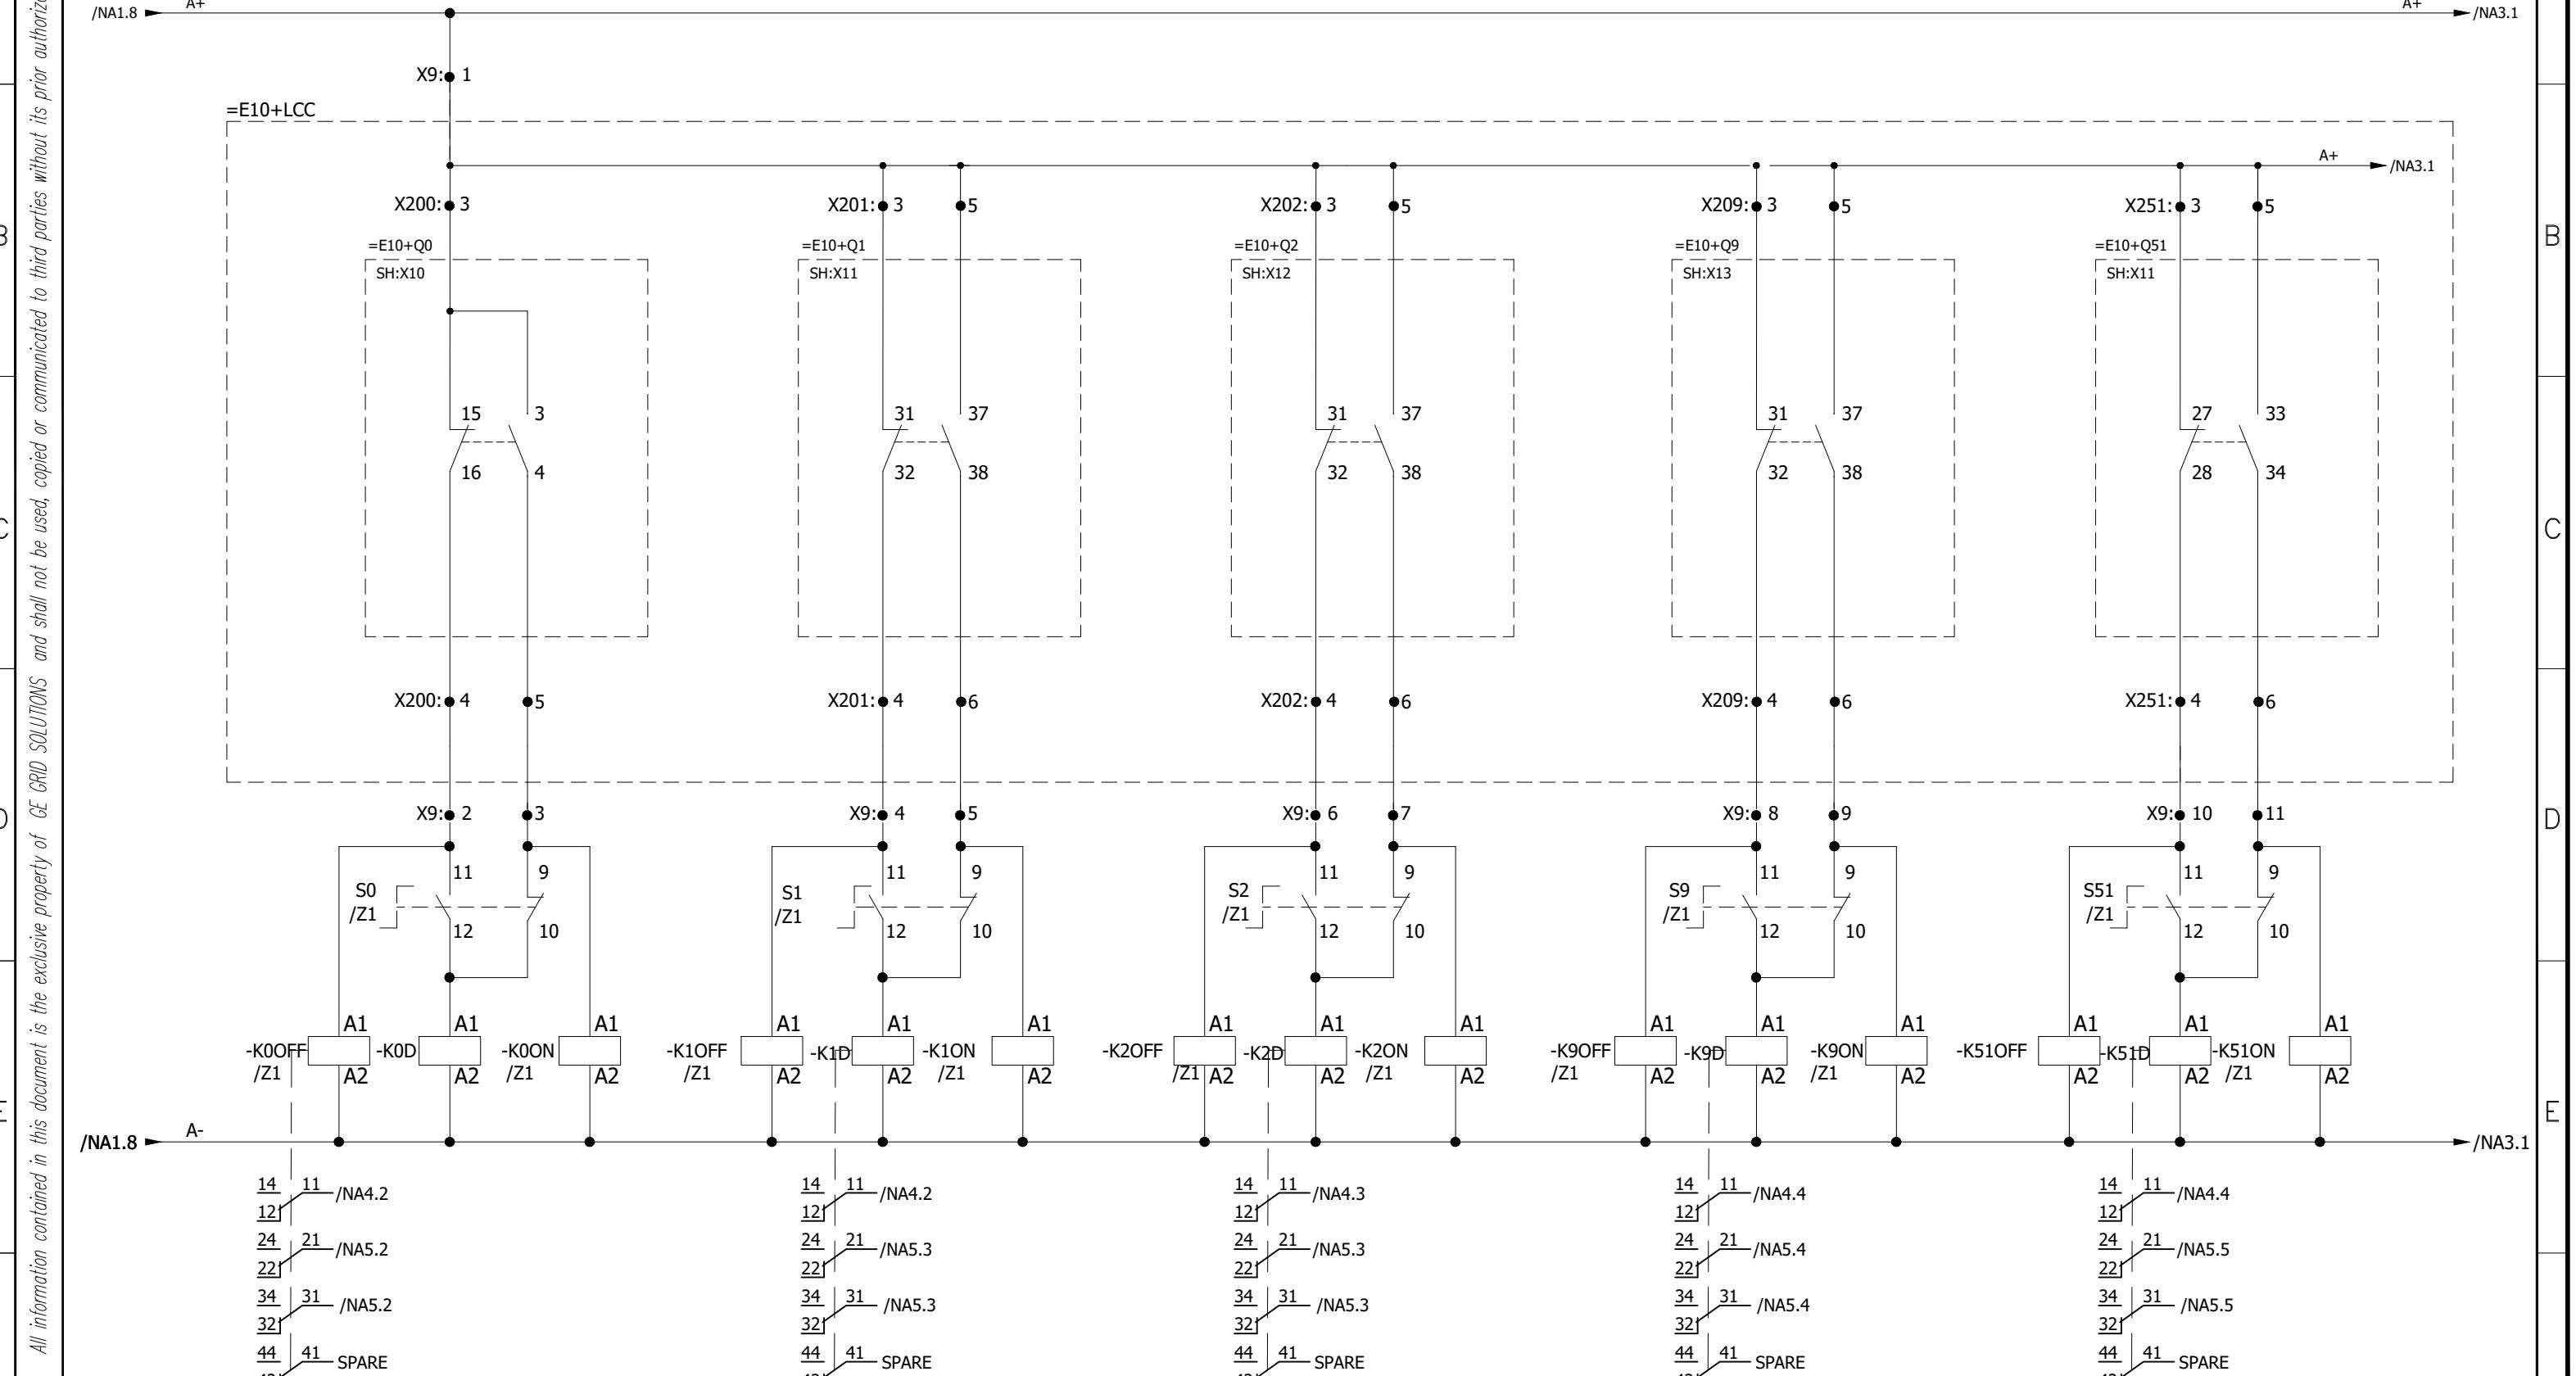

0	AS BUILT	30.10.2018	ASJ	Manufacturer EPE SOL 75-B Garden Block, New Garden Town,	Contractor Grid Solutions A GE and Alstom joint venture	Client NATIONAL TRANSMISSION & DISPATCH COMPANY LIMITED	Project 220kV/132kV GIS SUBSTATION GHAZI ROAD, LAHORE	Title 132kV LINE CONTROL PANEL (=E10+CP31) DISCREPANCY INITIATION	Drawing no. P60194-E-ELC-SC-007
									Project no. P-60194
	DESCRIPTION	DATE	DRAWER						Sheet type NA2
REV.									Sheet no. 18

1 2 3 4 5 6 7 8


All information contained in this document is the exclusive property of GE GRID SOLUTIONS and shall not be used, copied or communicated to third parties without its prior authorization.

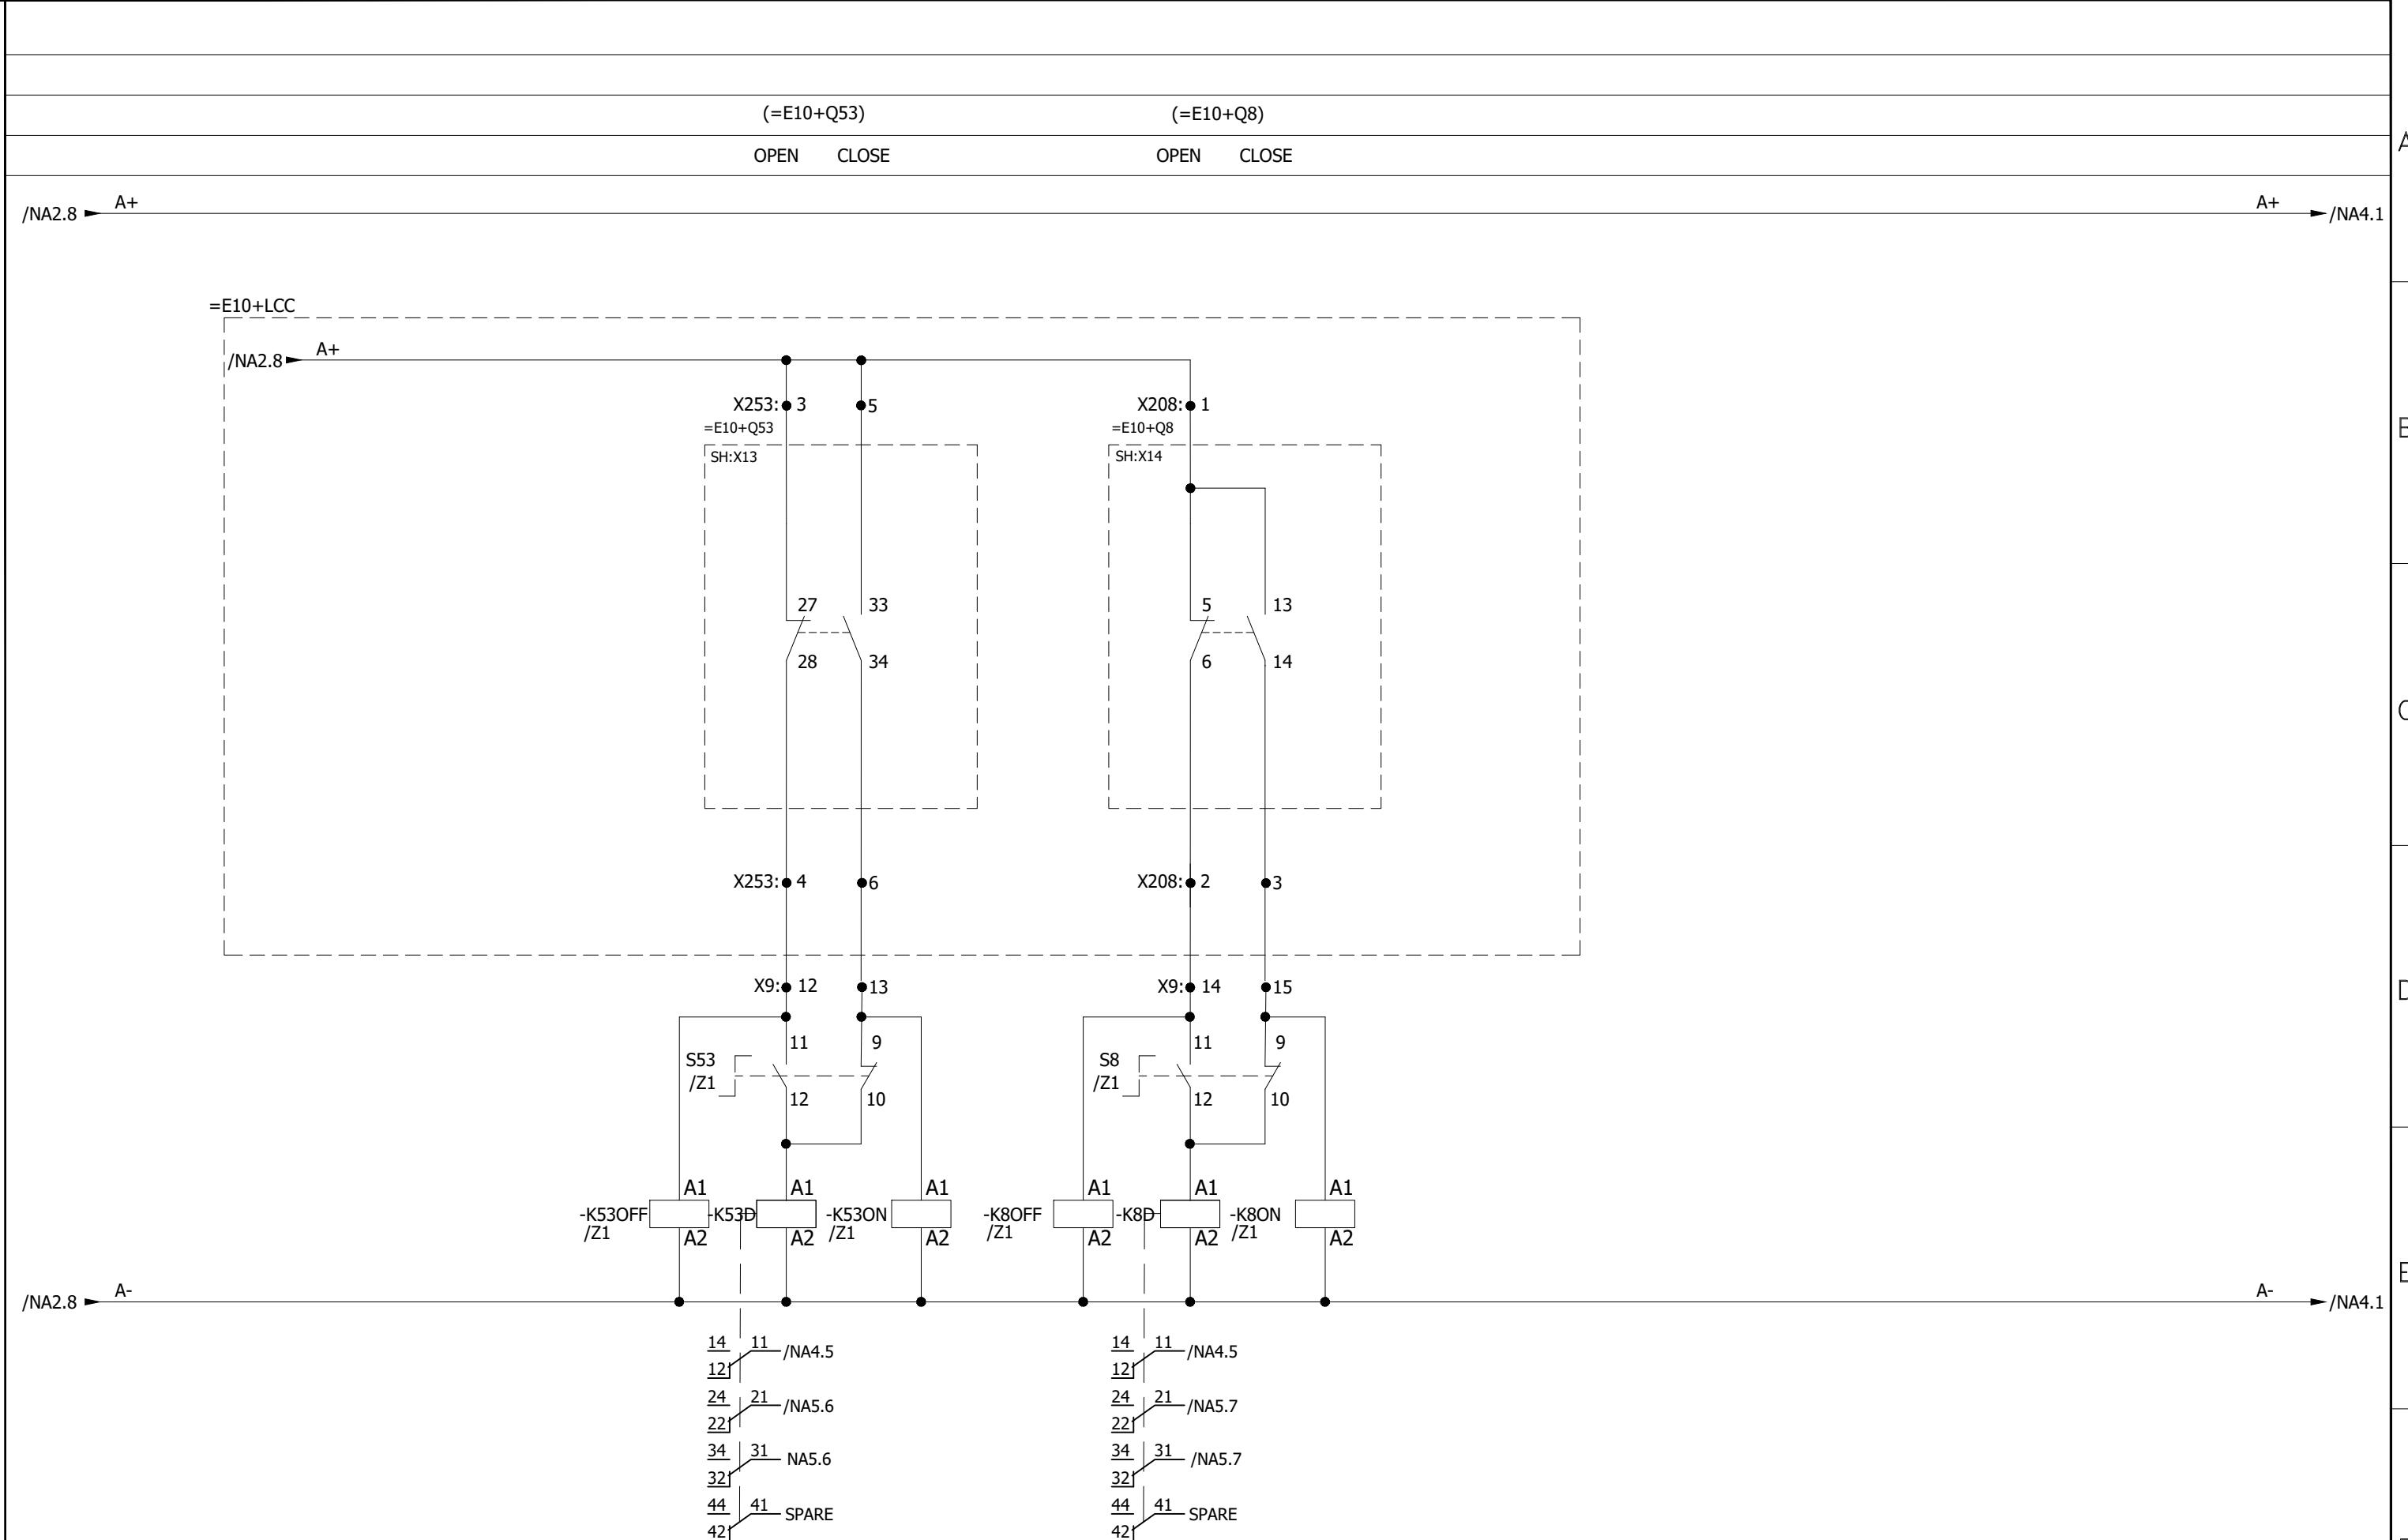

0	AS BUILT		30.10.2018	ASJ	Manufacturer  EPESOL 71-B Garden Block, New Garden Town,	Contractor  Grid Solutions A GE and Alstom joint venture	Client  NATIONAL TRANSMISSION & DISPATCH COMPANY LIMITED	Project 220KV/132KV GIS SUBSTATION GHAZI ROAD, LAHORE	Title 132KV LINE CONTROL PANEL (=E10+CP31) DISCREPANCY INITIATION	Drawing no. P60194-E-ELC-SC-007		
REV.	DESCRIPTION		DATE	DRAWER						Project no. P-60194	Sheet type NA3	Sheet no. 19
1	2	3	4	5	6	7	8					

1 2 3 4 5 6 7 8

OFF/ON (=E10+Q0)	OFF/ON (=E10+Q1)	OFF/ON (=E10+Q2)	OFF/ON (=E10+Q9)	OFF/ON (=E10+Q51)	OFF/ON (=E10+Q53)	OFF/ON (=E10+Q8)	CIRCUIT BREAKER OPERATION COUNTER (-Q10)
---------------------	---------------------	---------------------	---------------------	----------------------	----------------------	---------------------	--

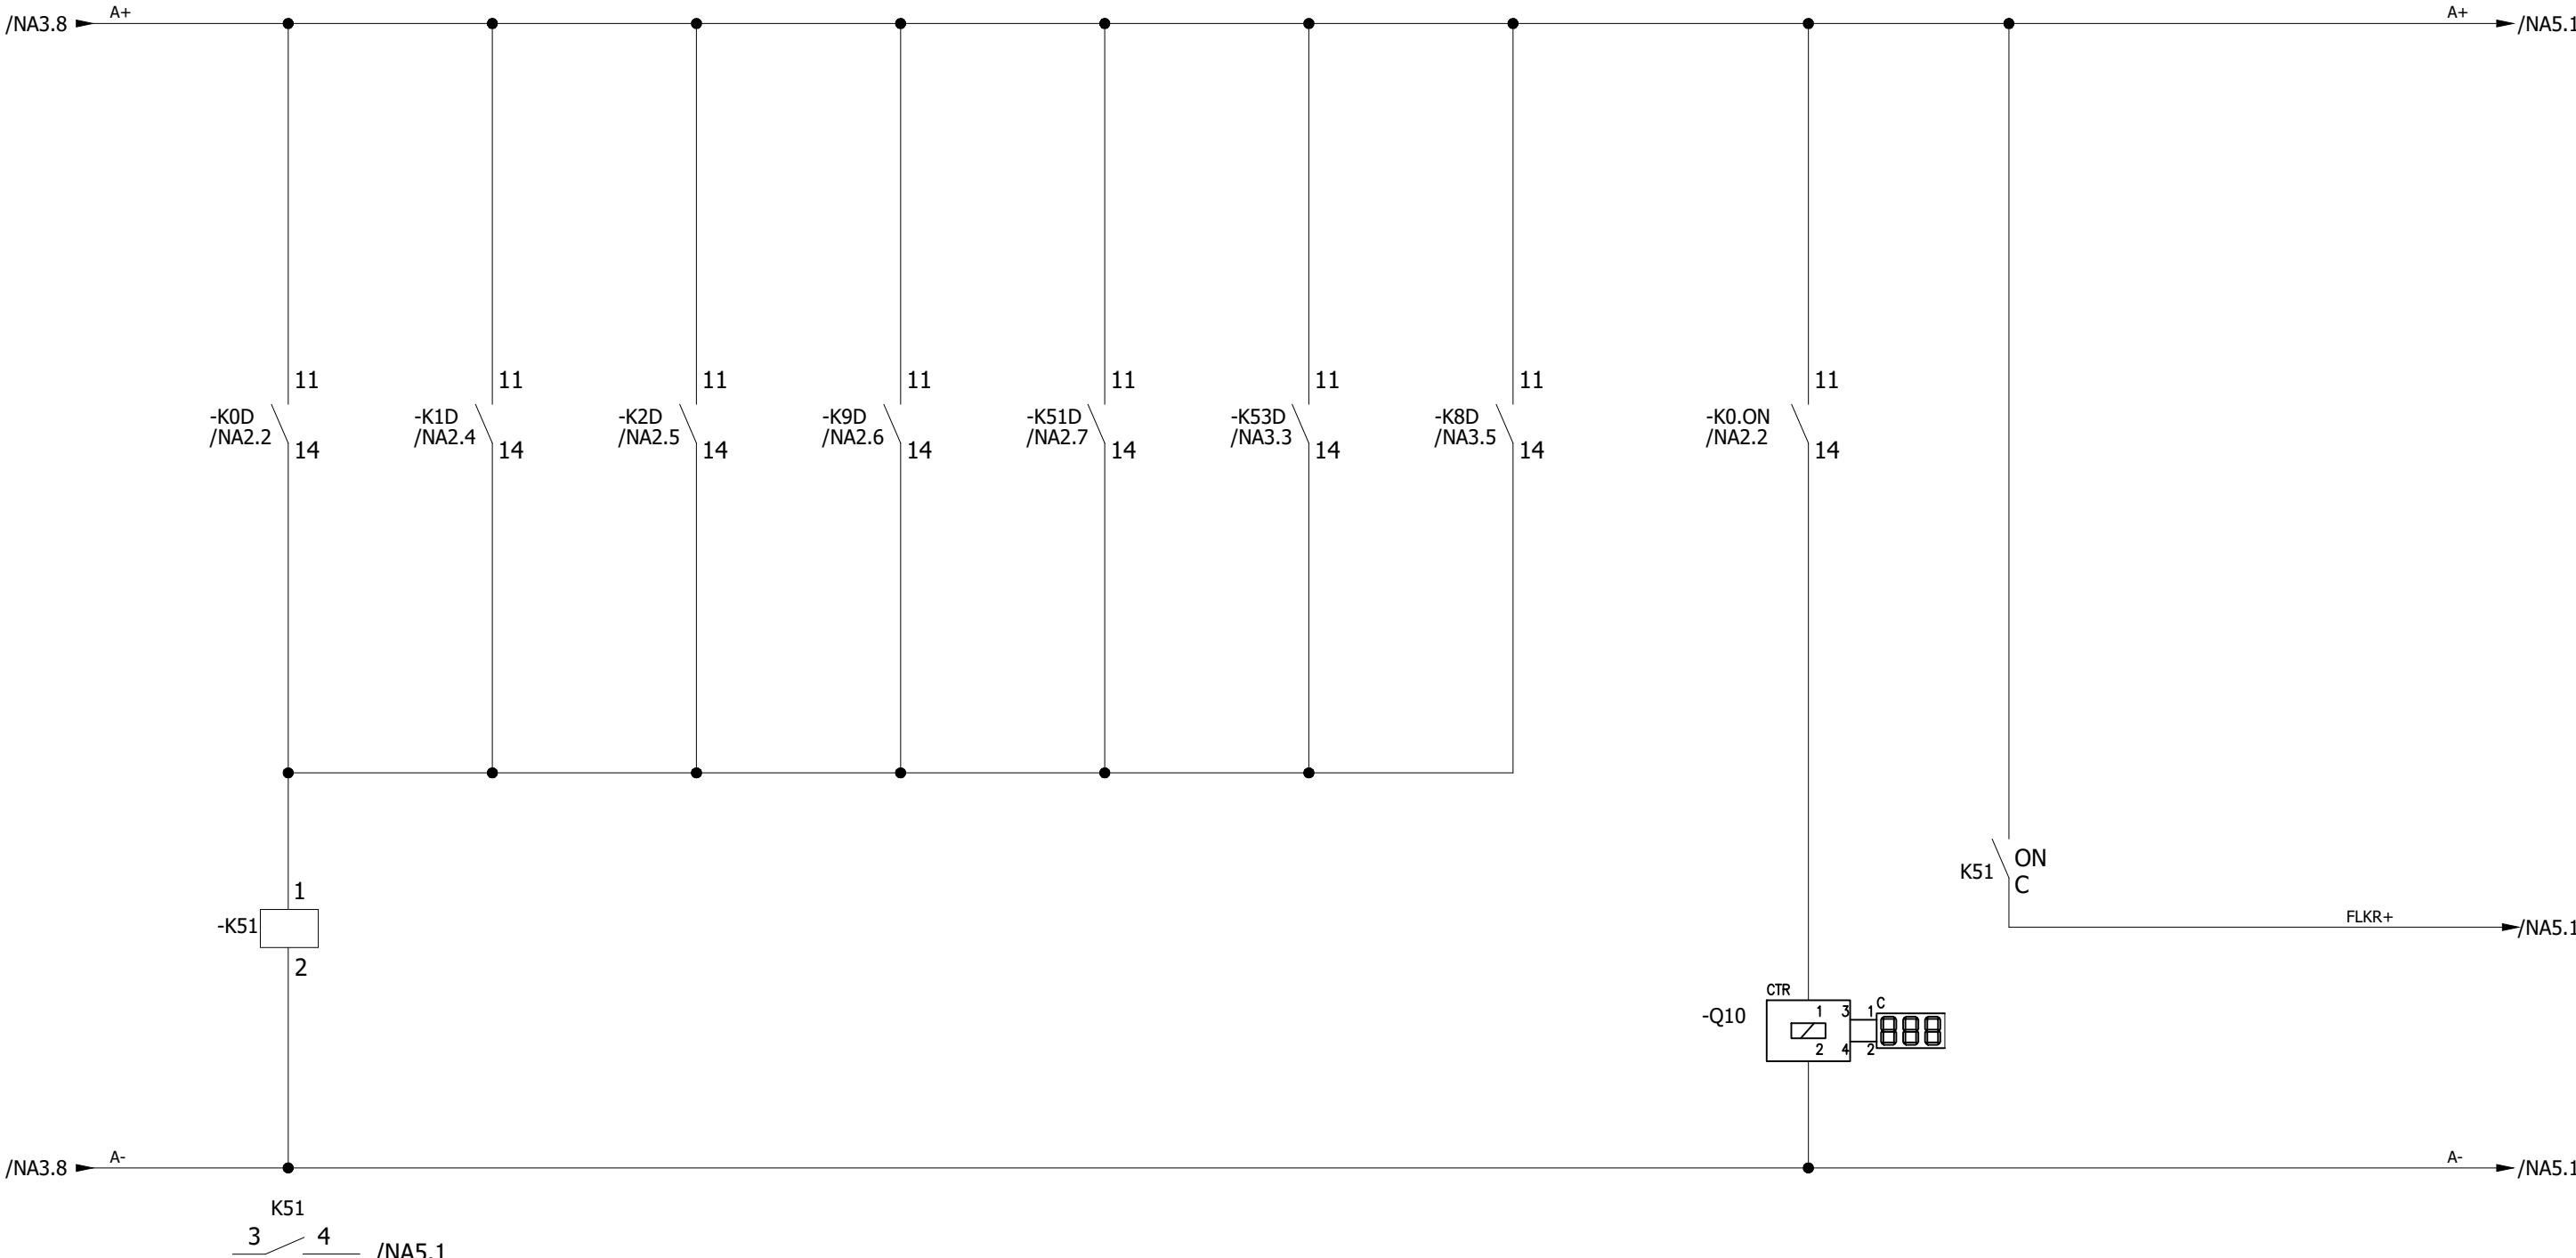

0	AS BUILT	30.10.2018	ASJ	Manufacturer  71-B Garden Block, New Garden Town,	Contractor  A GE and Alstom joint venture	Client 	Project 220kV/132kV GIS SUBSTATION GHAZI ROAD, LAHORE	Title 132kV LINE CONTROL PANEL (-E10+CP31) DISCREPANCY INITIATION	Drawing no. P60194-E-ELC-SC-007
									Project no. P-60194
REV.	DESCRIPTION	DATE	DRAWER						Sheet type NA4
									Sheet no. 20


1 2 3 4 5 6 7 8

1 2 3 4 5 6 7 8

All information contained in this document is the exclusive property of GE GRID SOLUTIONS and shall not be used, copied or communicated to third parties without its prior authorization.

(=E10+Q0) (=E10+Q1) (=E10+Q2) (=E10+Q9) (=E10+Q51) (=E10+Q53) (=E10+Q8)

A

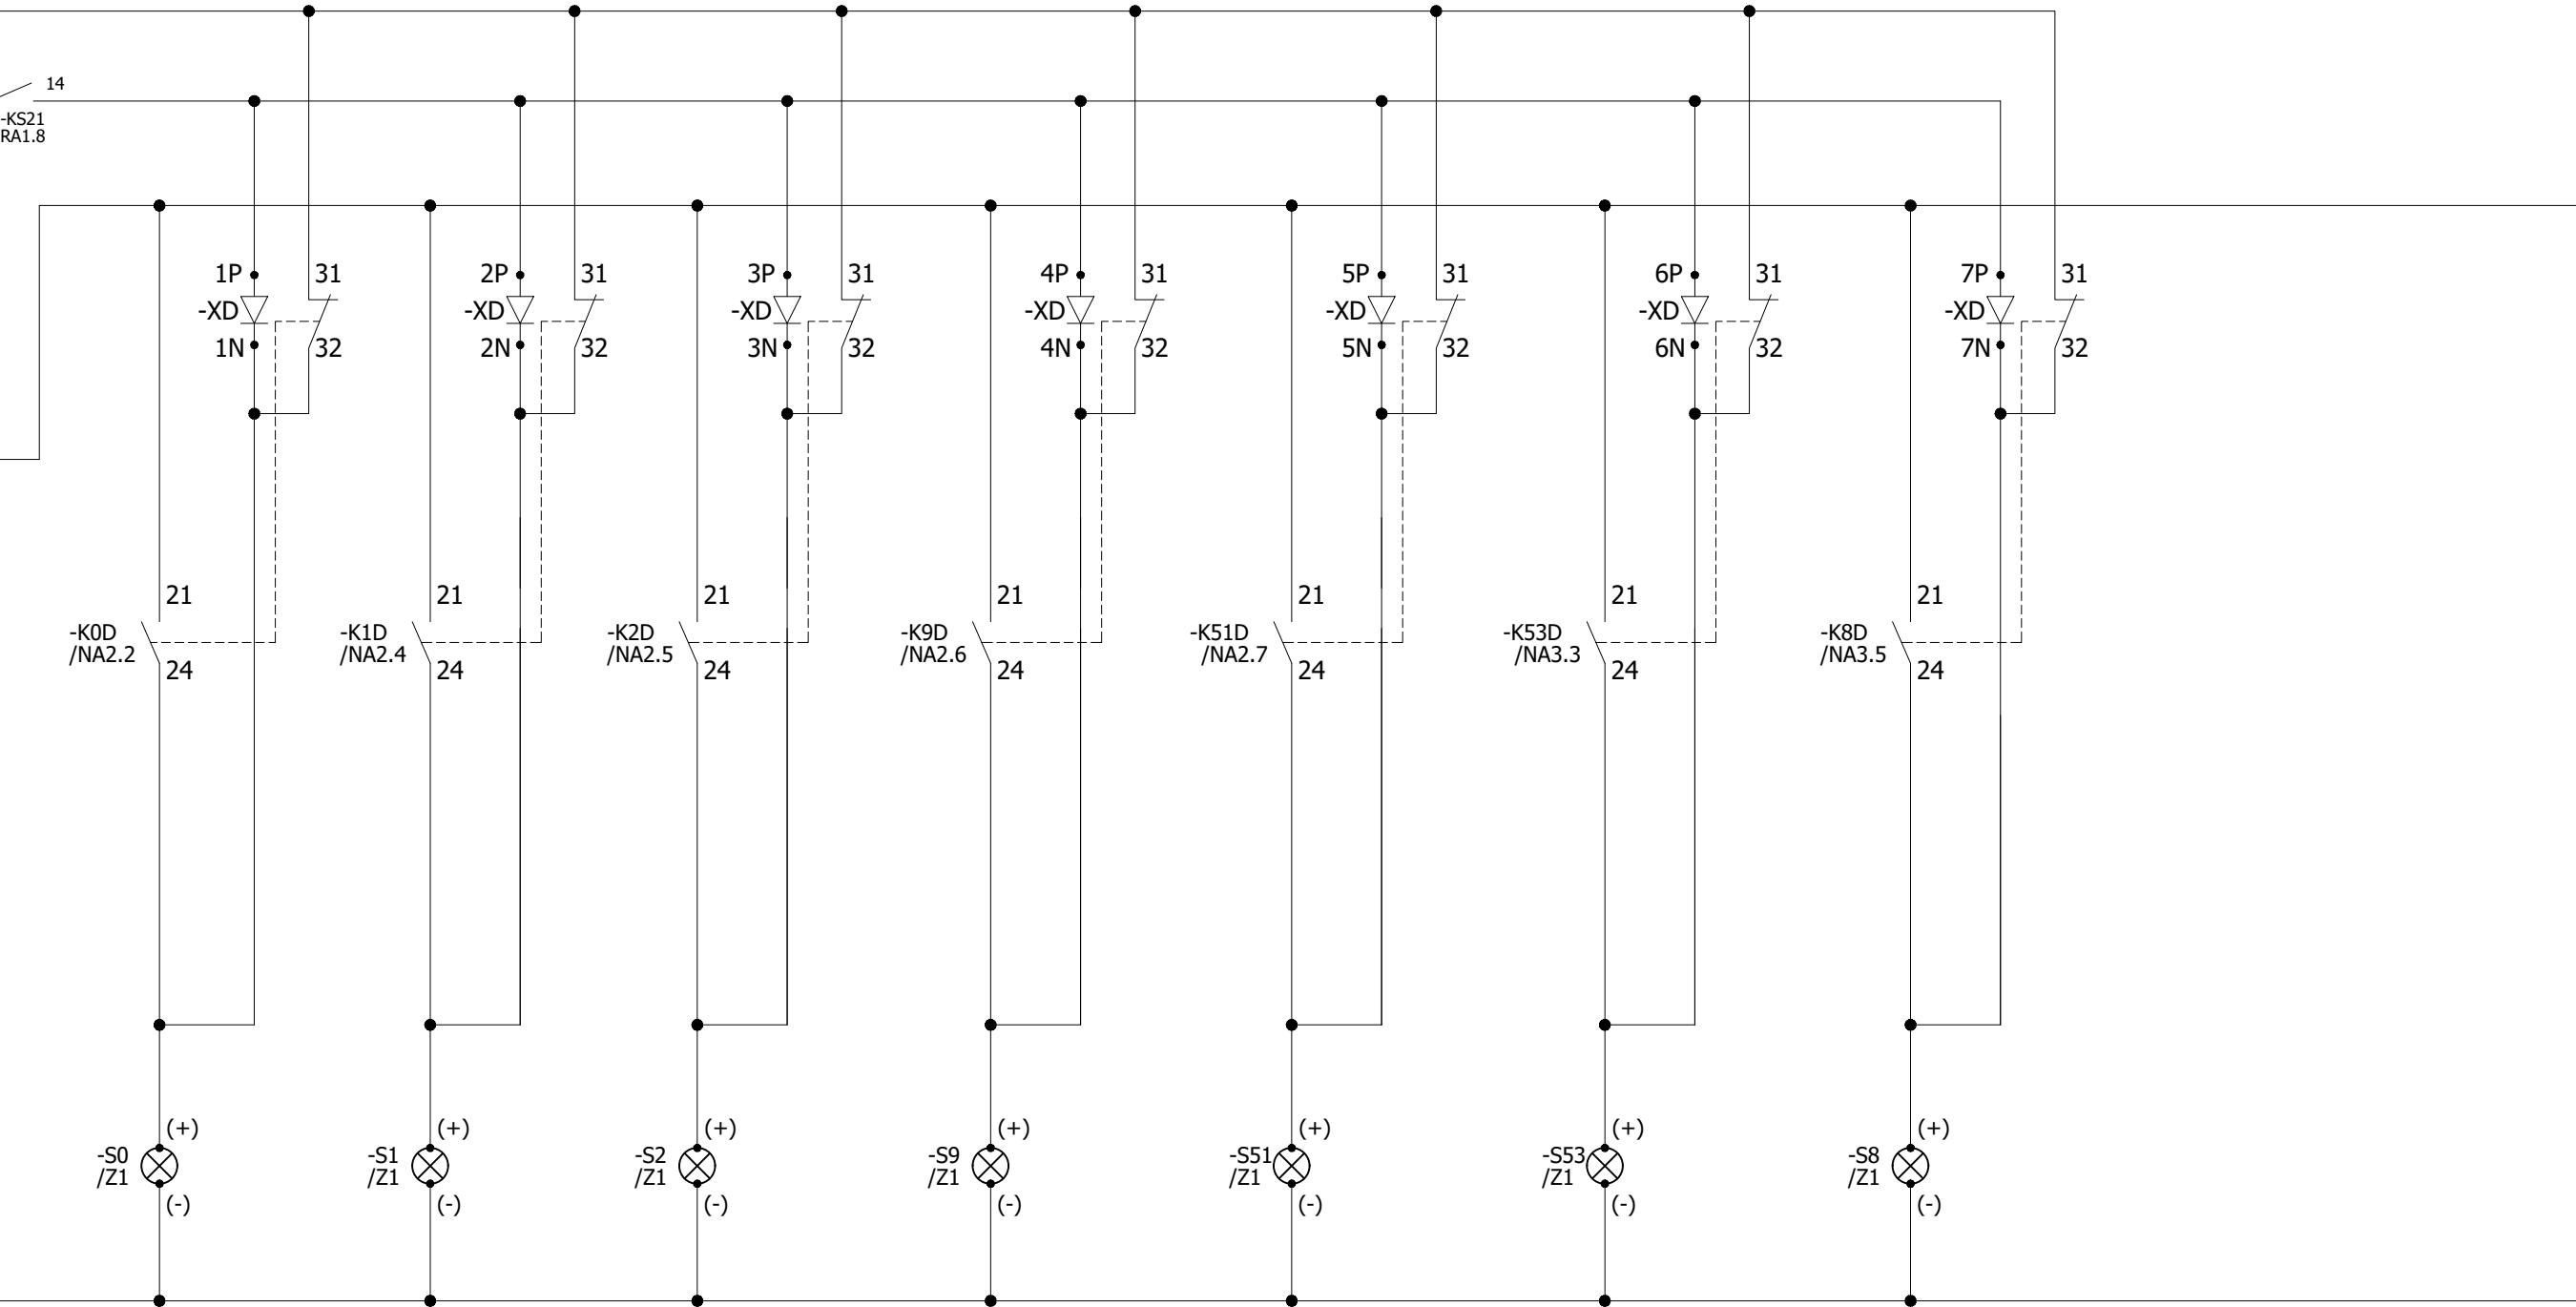

B

(=E10+Q0) (=E10+Q1) (=E10+Q2) (=E10+Q9) (=E10+Q51) (=E10+Q53) (=E10+Q8)

(=E10+Q0) (=E10+Q1) (=E10+Q2) (=E10+Q9) (=E10+Q51) (=E10+Q53) (=E10+Q8)

C

(=E10+Q0) (=E10+Q1) (=E10+Q2) (=E10+Q9) (=E10+Q51) (=E10+Q53) (=E10+Q8)

D

(=E10+Q0) (=E10+Q1) (=E10+Q2) (=E10+Q9) (=E10+Q51) (=E10+Q53) (=E10+Q8)


E

(=E10+Q0) (=E10+Q1) (=E10+Q2) (=E10+Q9) (=E10+Q51) (=E10+Q53) (=E10+Q8)

F

(=E10+Q0) (=E10+Q1) (=E10+Q2) (=E10+Q9) (=E10+Q51) (=E10+Q53) (=E10+Q8)


0	AS BUILT	30.10.2018	ASJ	Manufacturer  71-B Garden Block, New Garden Town,	Contractor  Grid Solutions A GE and Alstom joint venture	Client  NATIONAL TRANSMISSION & DISPATCH COMPANY LIMITED	Project 220KV/132KV GIS SUBSTATION GHAZI ROAD, LAHORE	Title 132KV LINE CONTROL PANEL (=E10+CP31) DISCREPANCY INDICATIONS	Drawing no. P60194-E-ELC-SC-007
REV.	DESCRIPTION	DATE	DRAWER						Project no. P-60194 Sheet type NA5 Sheet no. 21
1	2	3	4	5	6	7	8		

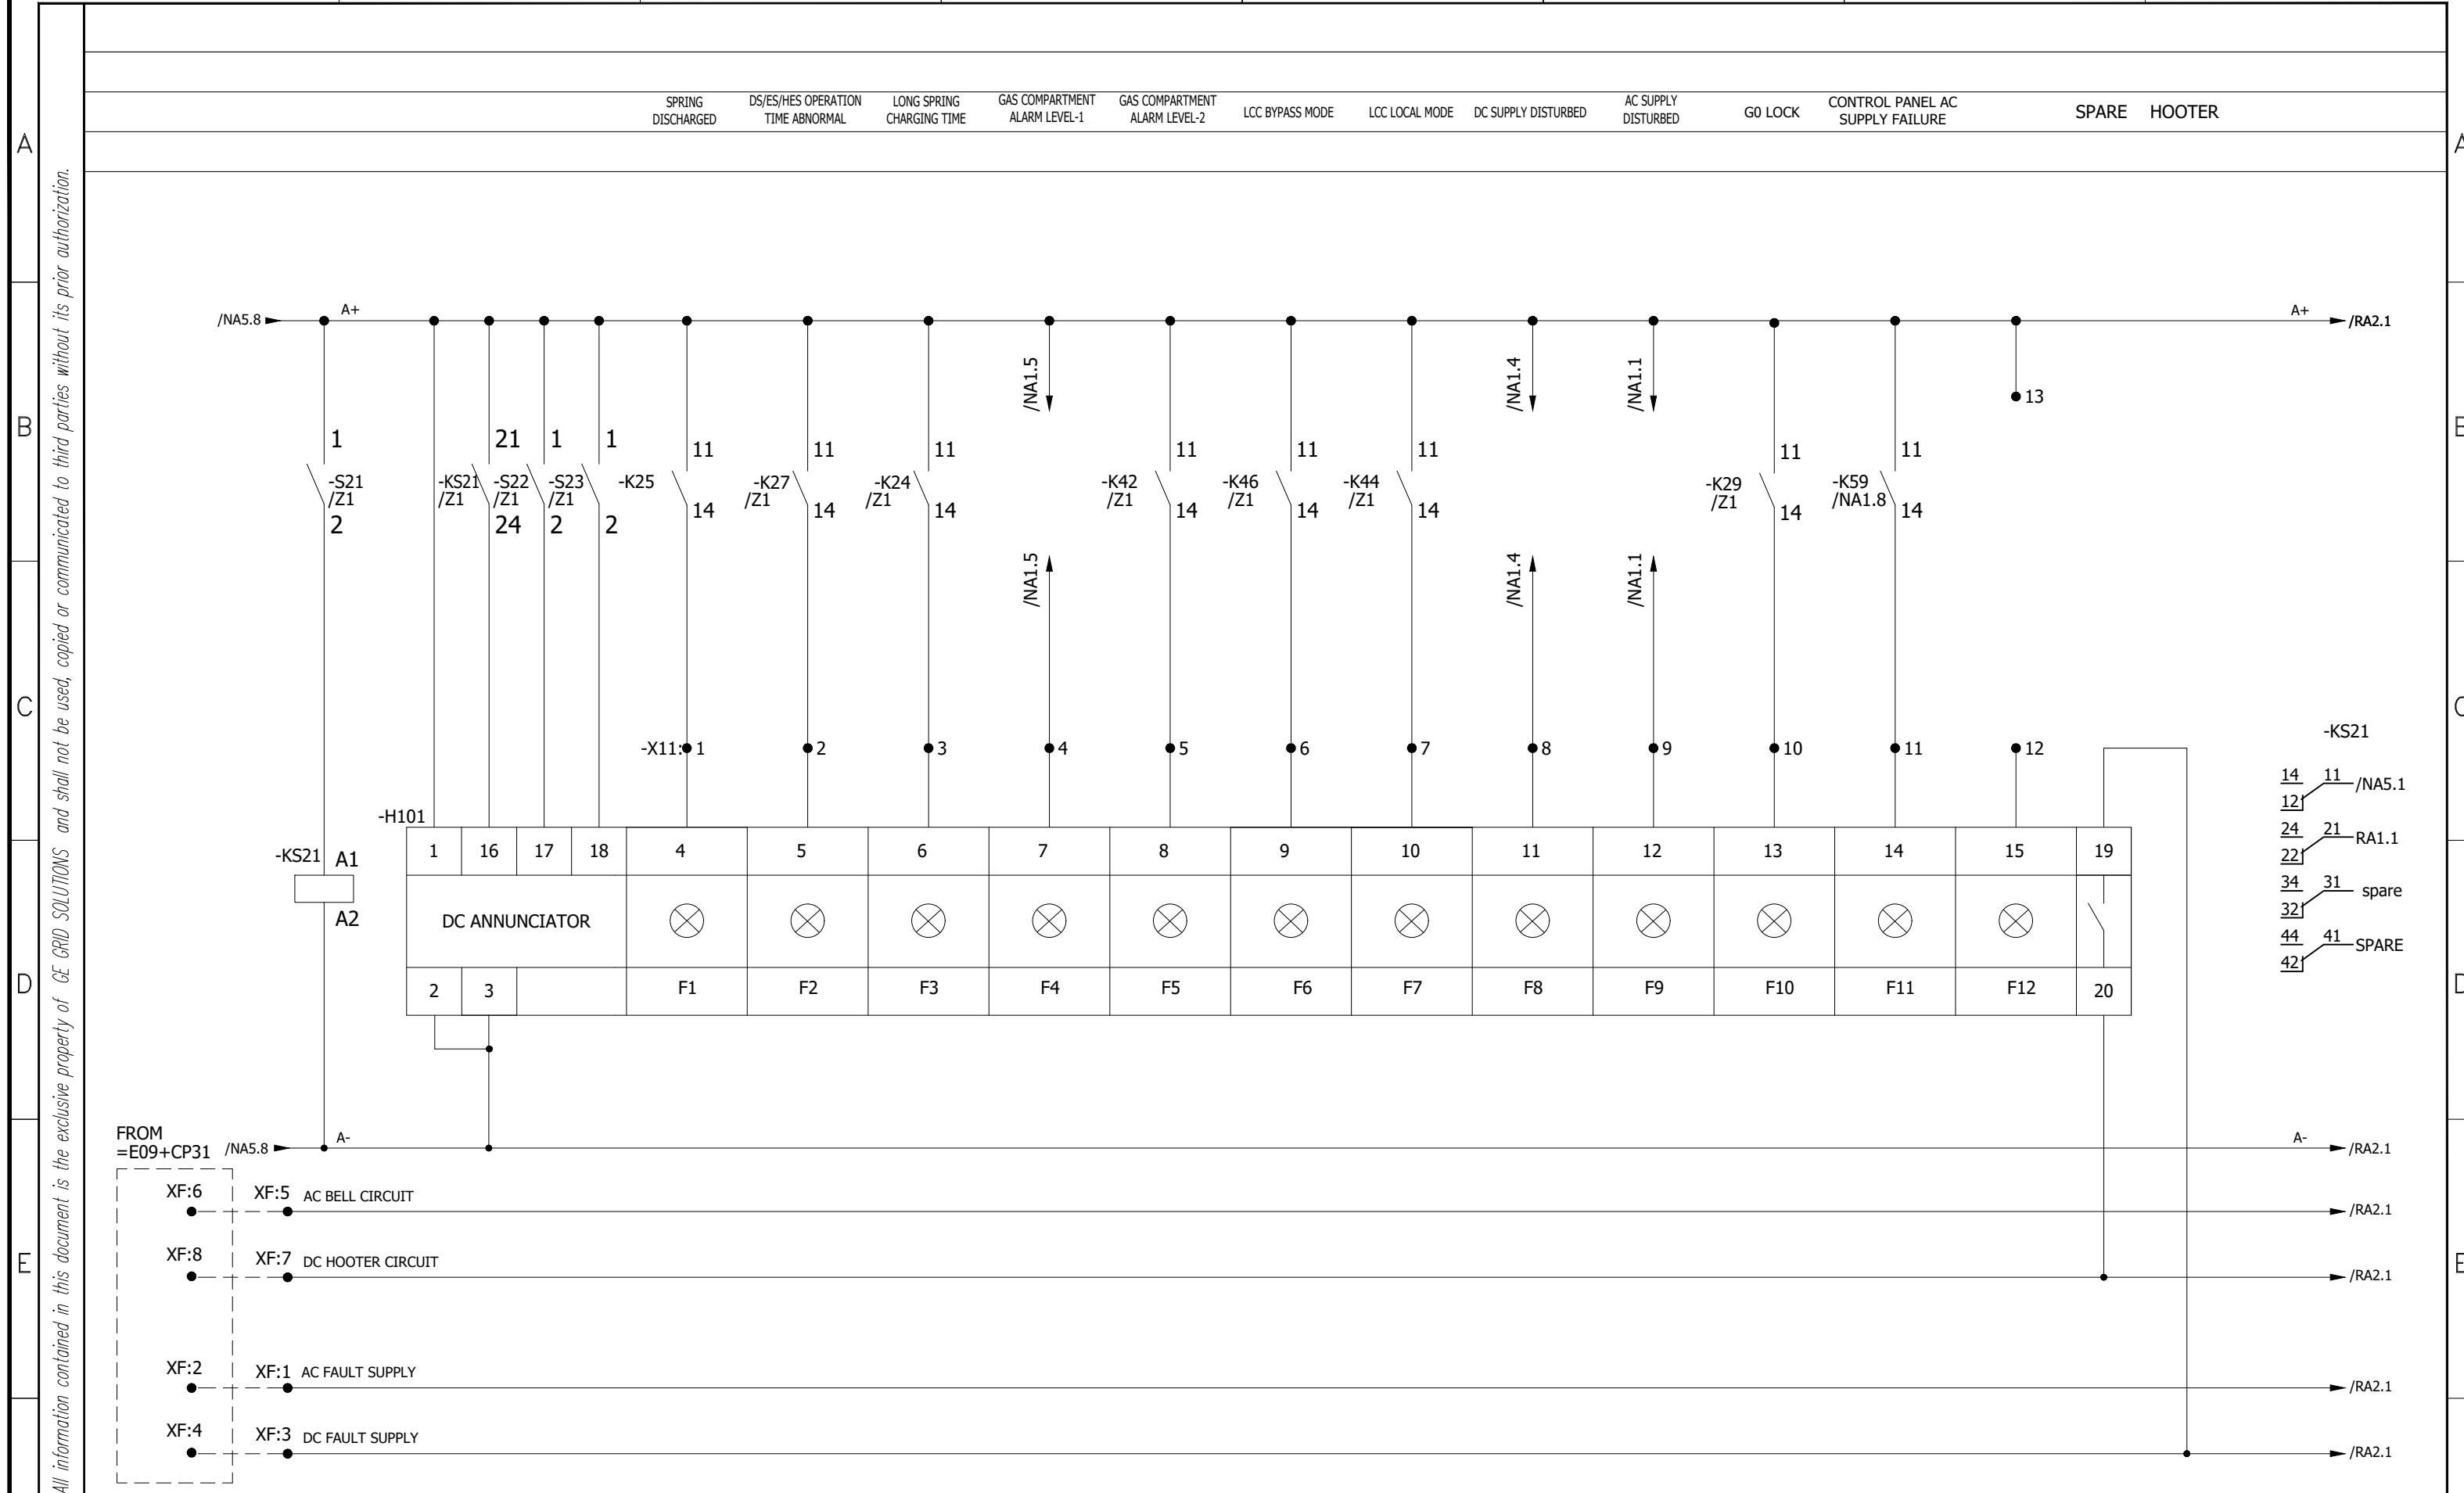

0	AS BUILT	30.10.2018	ASJ	Manufacturer  EPESOL 71-B Garden Block, New Garden Town,	Contractor  Grid Solutions A GE and Alstom joint venture	Client  NATIONAL TRANSMISSION & DISPATCH COMPANY LIMITED	Project 220kV/132kV GIS SUBSTATION GHAZI ROAD, LAHORE	Title 132kV LINE CONTROL PANEL (=E10+CP31) ANNUNCIATOR-1 CIRCUIT	Drawing no. P60194-E-ELC-SC-007
REV.	DESCRIPTION	DATE	DRAWER						Project no. P-60194
									Sheet type RA1
									Sheet no. 22

RED PHASE TRIP YELLOW PHASE TRIP BLUE PHASE TRIP ZONE-1 TRIP ZONE-2/3 TRIP SPARE POWER SWING DETECTED SOTF OPERATED AUTORECLOSE OPERATED AUTORECLOSE BLOCKED LINE DIFFERENTIAL PROTECTION SPARE HOOTER
RELAY FAULTY

All information contained in this document is the exclusive property of GE GRID SOLUTIONS and shall not be used, copied or communicated to third parties without its prior authorization.

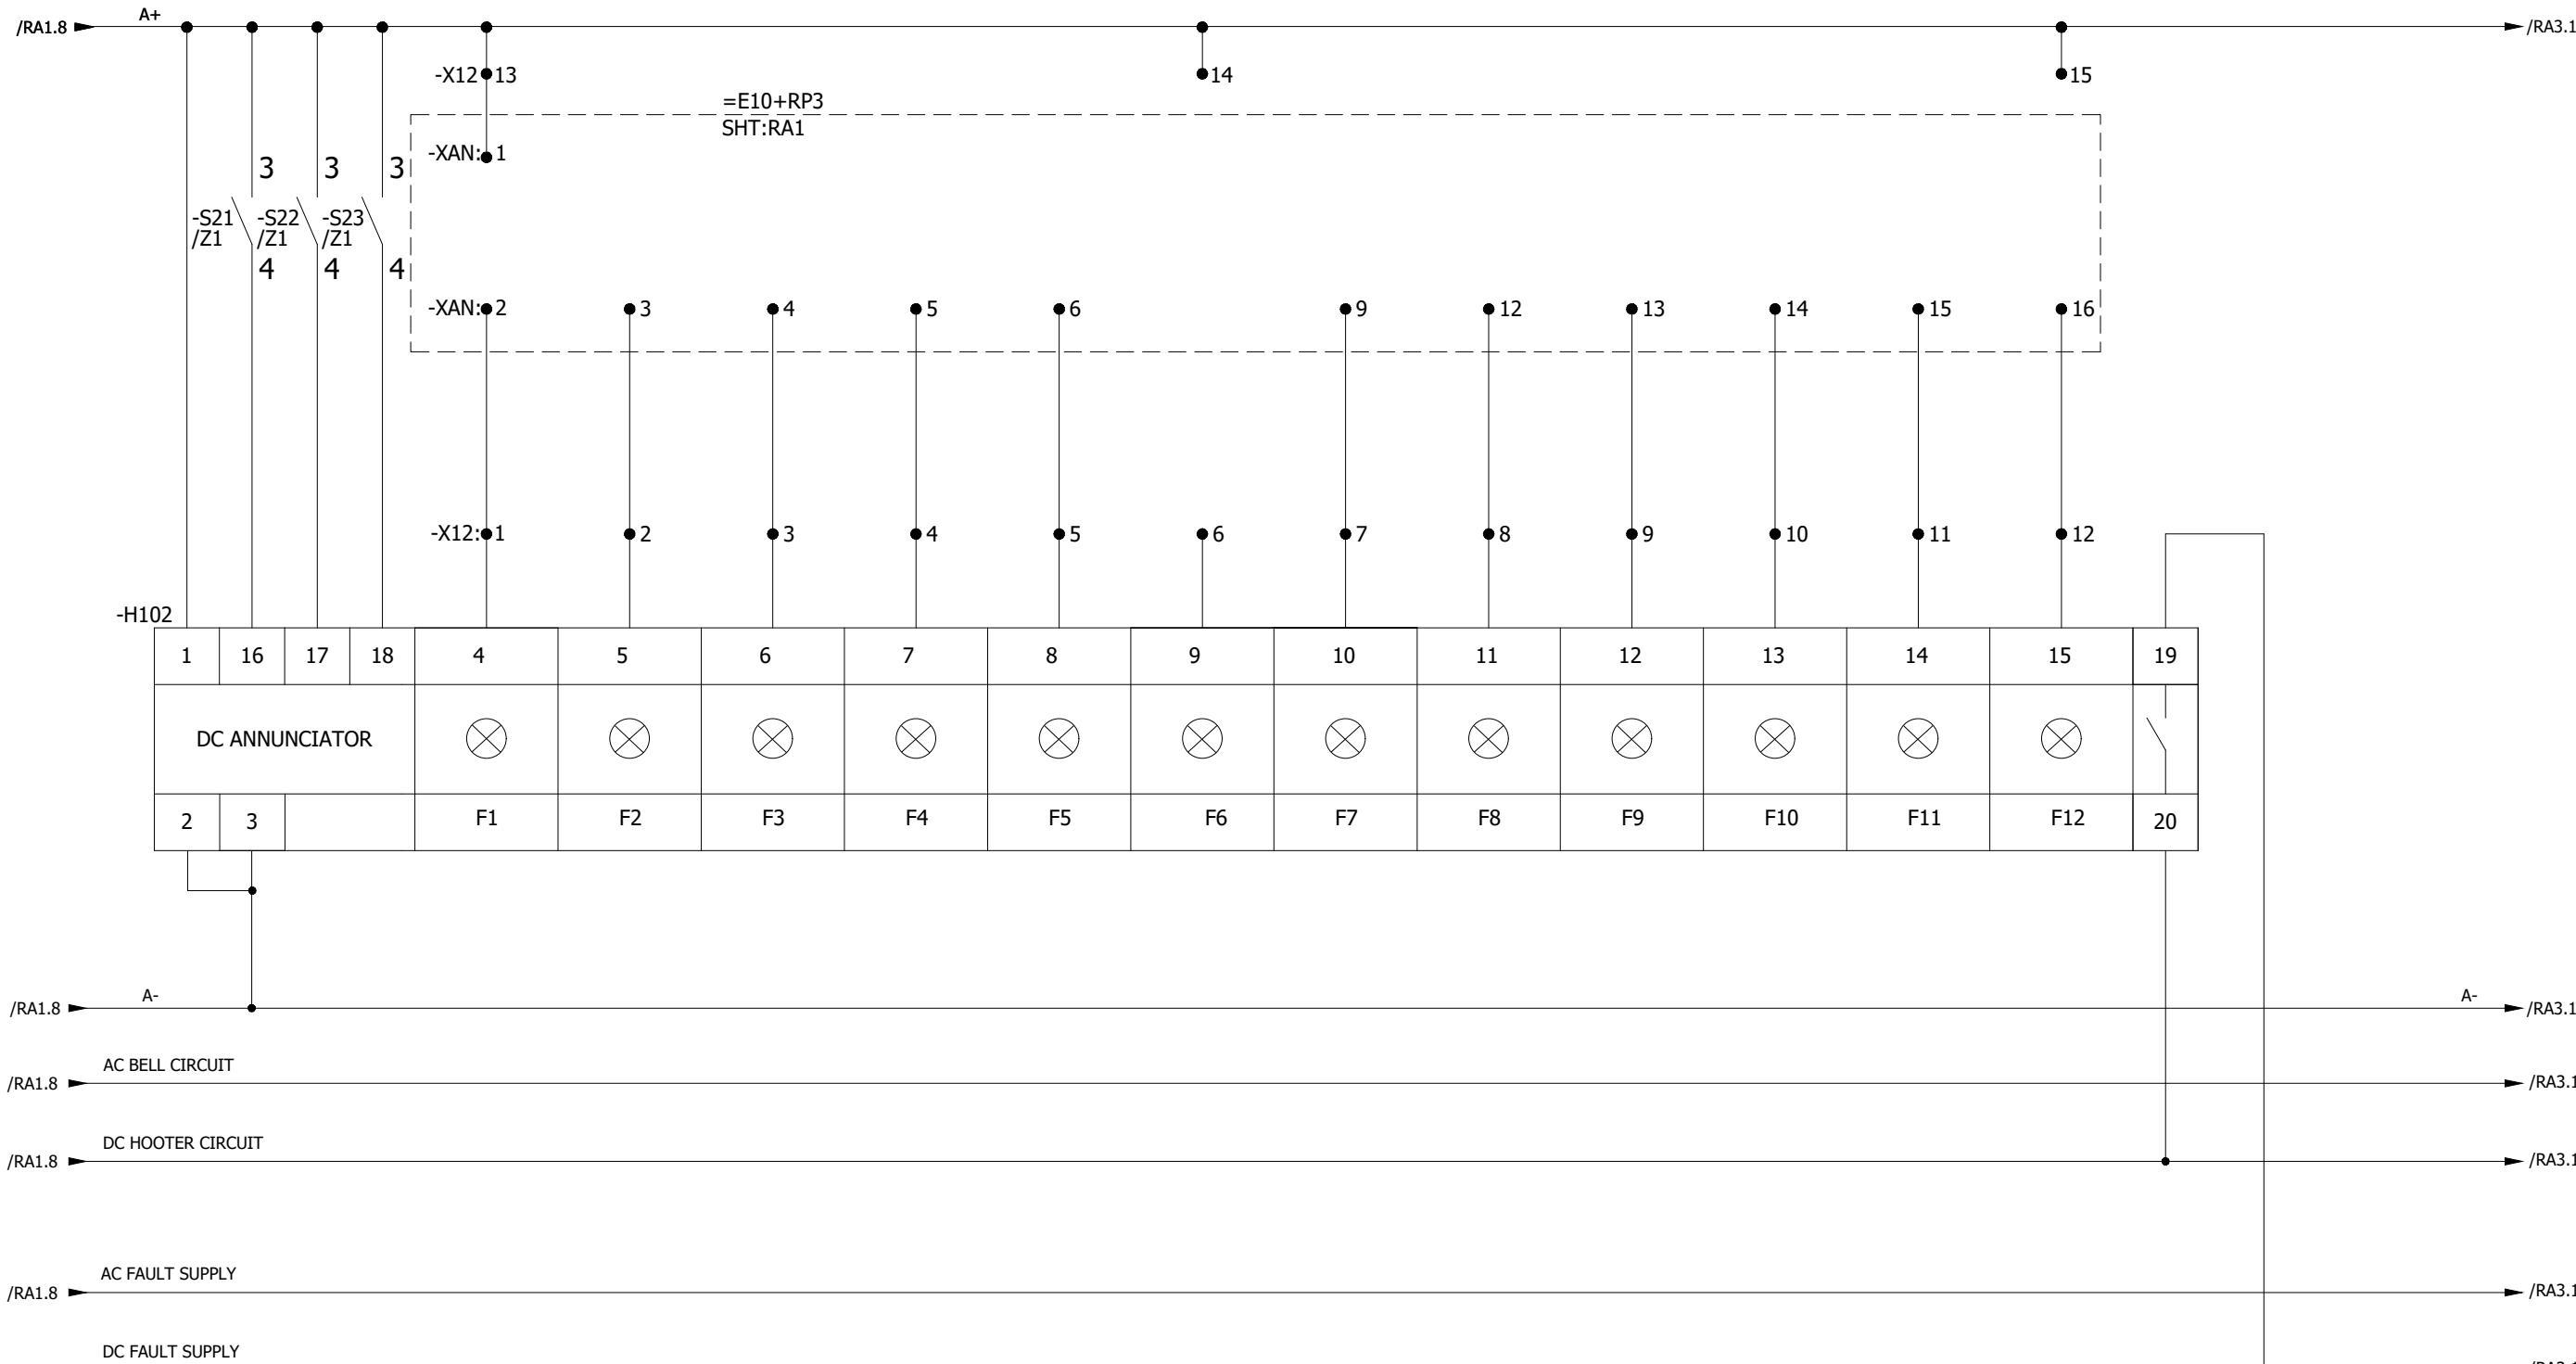


0	AS BUILT	30.10.2018	ASJ	Manufacturer  EPESOL 71-B Garden Block, New Garden Town,	Contractor  Grid Solutions A GE and Alstom joint venture	Client  NATIONAL TRANSMISSION & DISPATCH COMPANY LIMITED	Project 220kV/132kV GIS SUBSTATION GHAZI ROAD, LAHORE	Title 132kV LINE CONTROL PANEL (=E10+CP31) ANNUNCIATOR-2 CIRCUIT	Drawing no. P60194-E-ELC-SC-007
REV.	DESCRIPTION	DATE	DRAWER						Project no. P-60194 Sheet type RA2 Sheet no. 23

A

BUS VT
SECONDARY CIRCUIT
MCB UNHEALTHY O/C & E/F PROT.
RELAY FAULTY SPARE LINE RELAY PANEL 230VAC
CIRCUIT/SUPPLY FAULTY TRIP CIRCUIT-1
FAULTY TRIP CIRCUIT-2
FAULTY O/C & E/F PROT.
OPERATED DTT
SEND CBF STG-1
OPERATED SPARE SPARE SPARE HOOTER

All information contained in this document is the exclusive property of GE GRID SOLUTIONS and shall not be used, copied or communicated to third parties without its prior authorization.

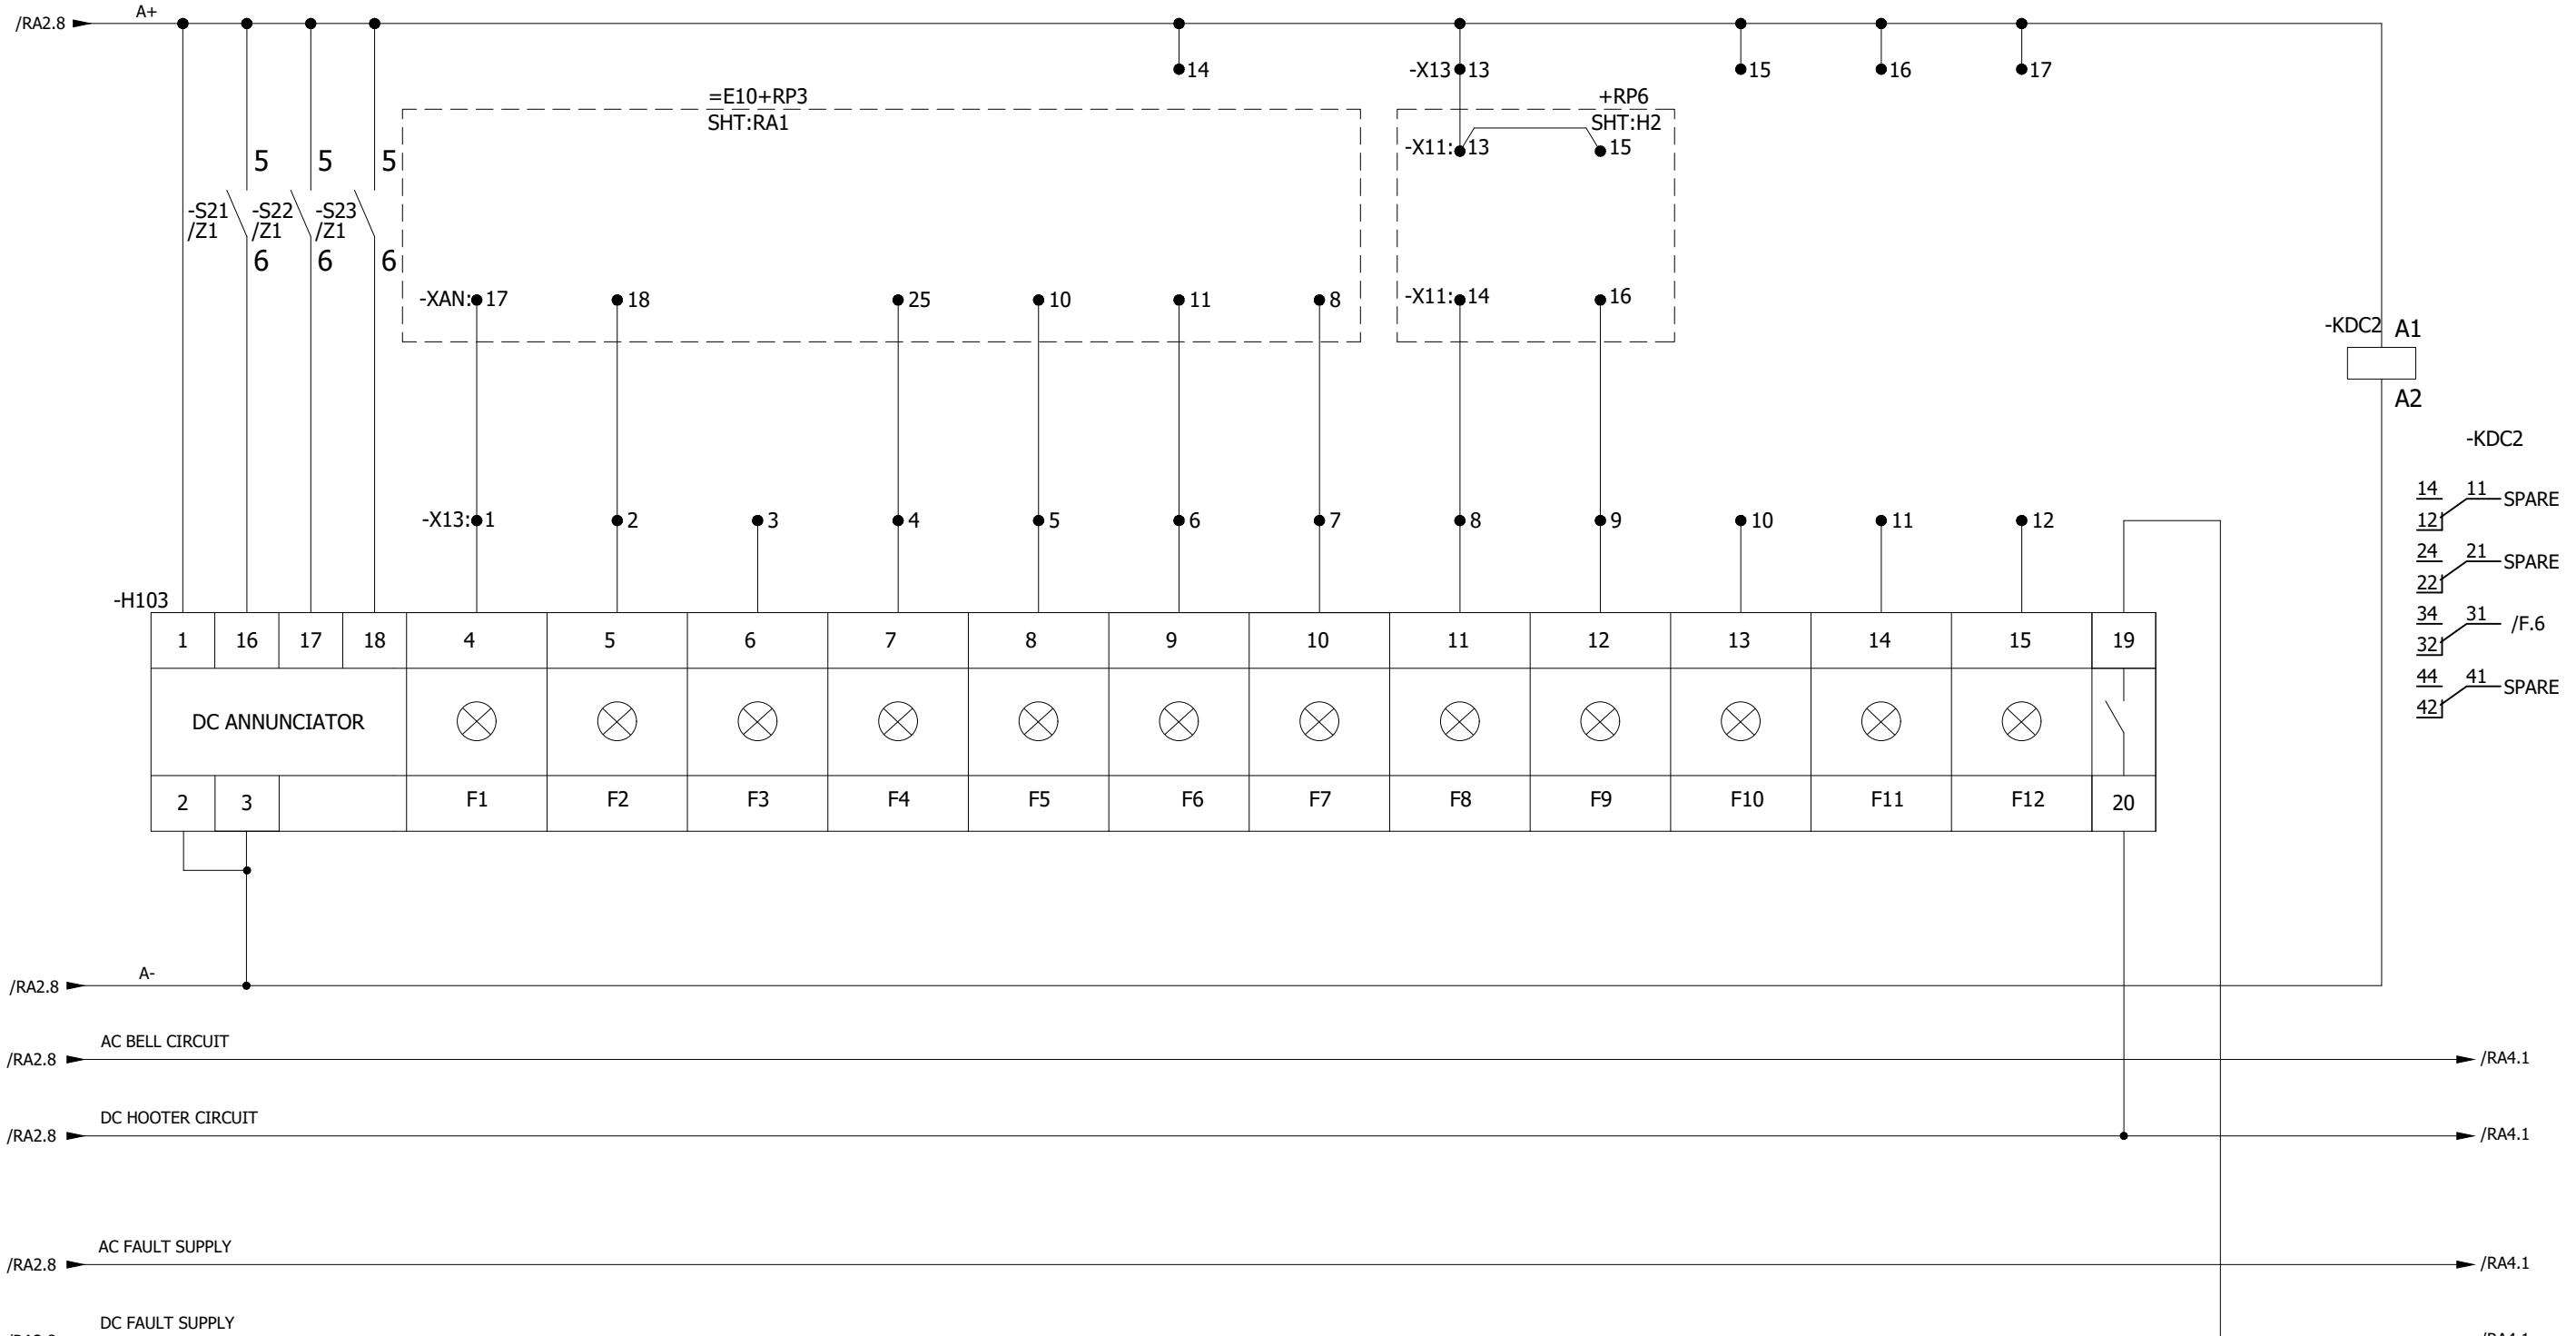

F

0	AS BUILT	30.10.2018	ASJ	Manufacturer EPESOL 21-B Garden Block, New Garden Town,	Contractor Grid Solutions A GE and Alstom joint venture	Client NATIONAL TRANSMISSION & DISPATCH COMPANY LIMITED	Project 220kV/132kV GIS SUBSTATION GHAZI ROAD, LAHORE	Title 132kV LINE CONTROL PANEL (=E10+CP31) ANNUNCIATOR-3 CIRCUIT	Drawing no. P60194-E-ELC-SC-007
REV.	DESCRIPTION	DATE	DRAWER						Project no. P-60194
									Sheet type RA3

A

B

C


D

E

F

All information contained in this document is the exclusive property of GE GRID SOLUTIONS and shall not be used, copied or communicated to third parties without its prior authorization.

LINE RELAY PANEL 110VDC CIRCUIT/SUPPLY FAULTY	SPARE	SPARE	SPARE	SPARE	SPARE	SPARE	CONTROL PANEL DC FAIL	SPARE	SPARE	SPARE	SPARE	AC BELL
---	-------	-------	-------	-------	-------	-------	--------------------------	-------	-------	-------	-------	---------

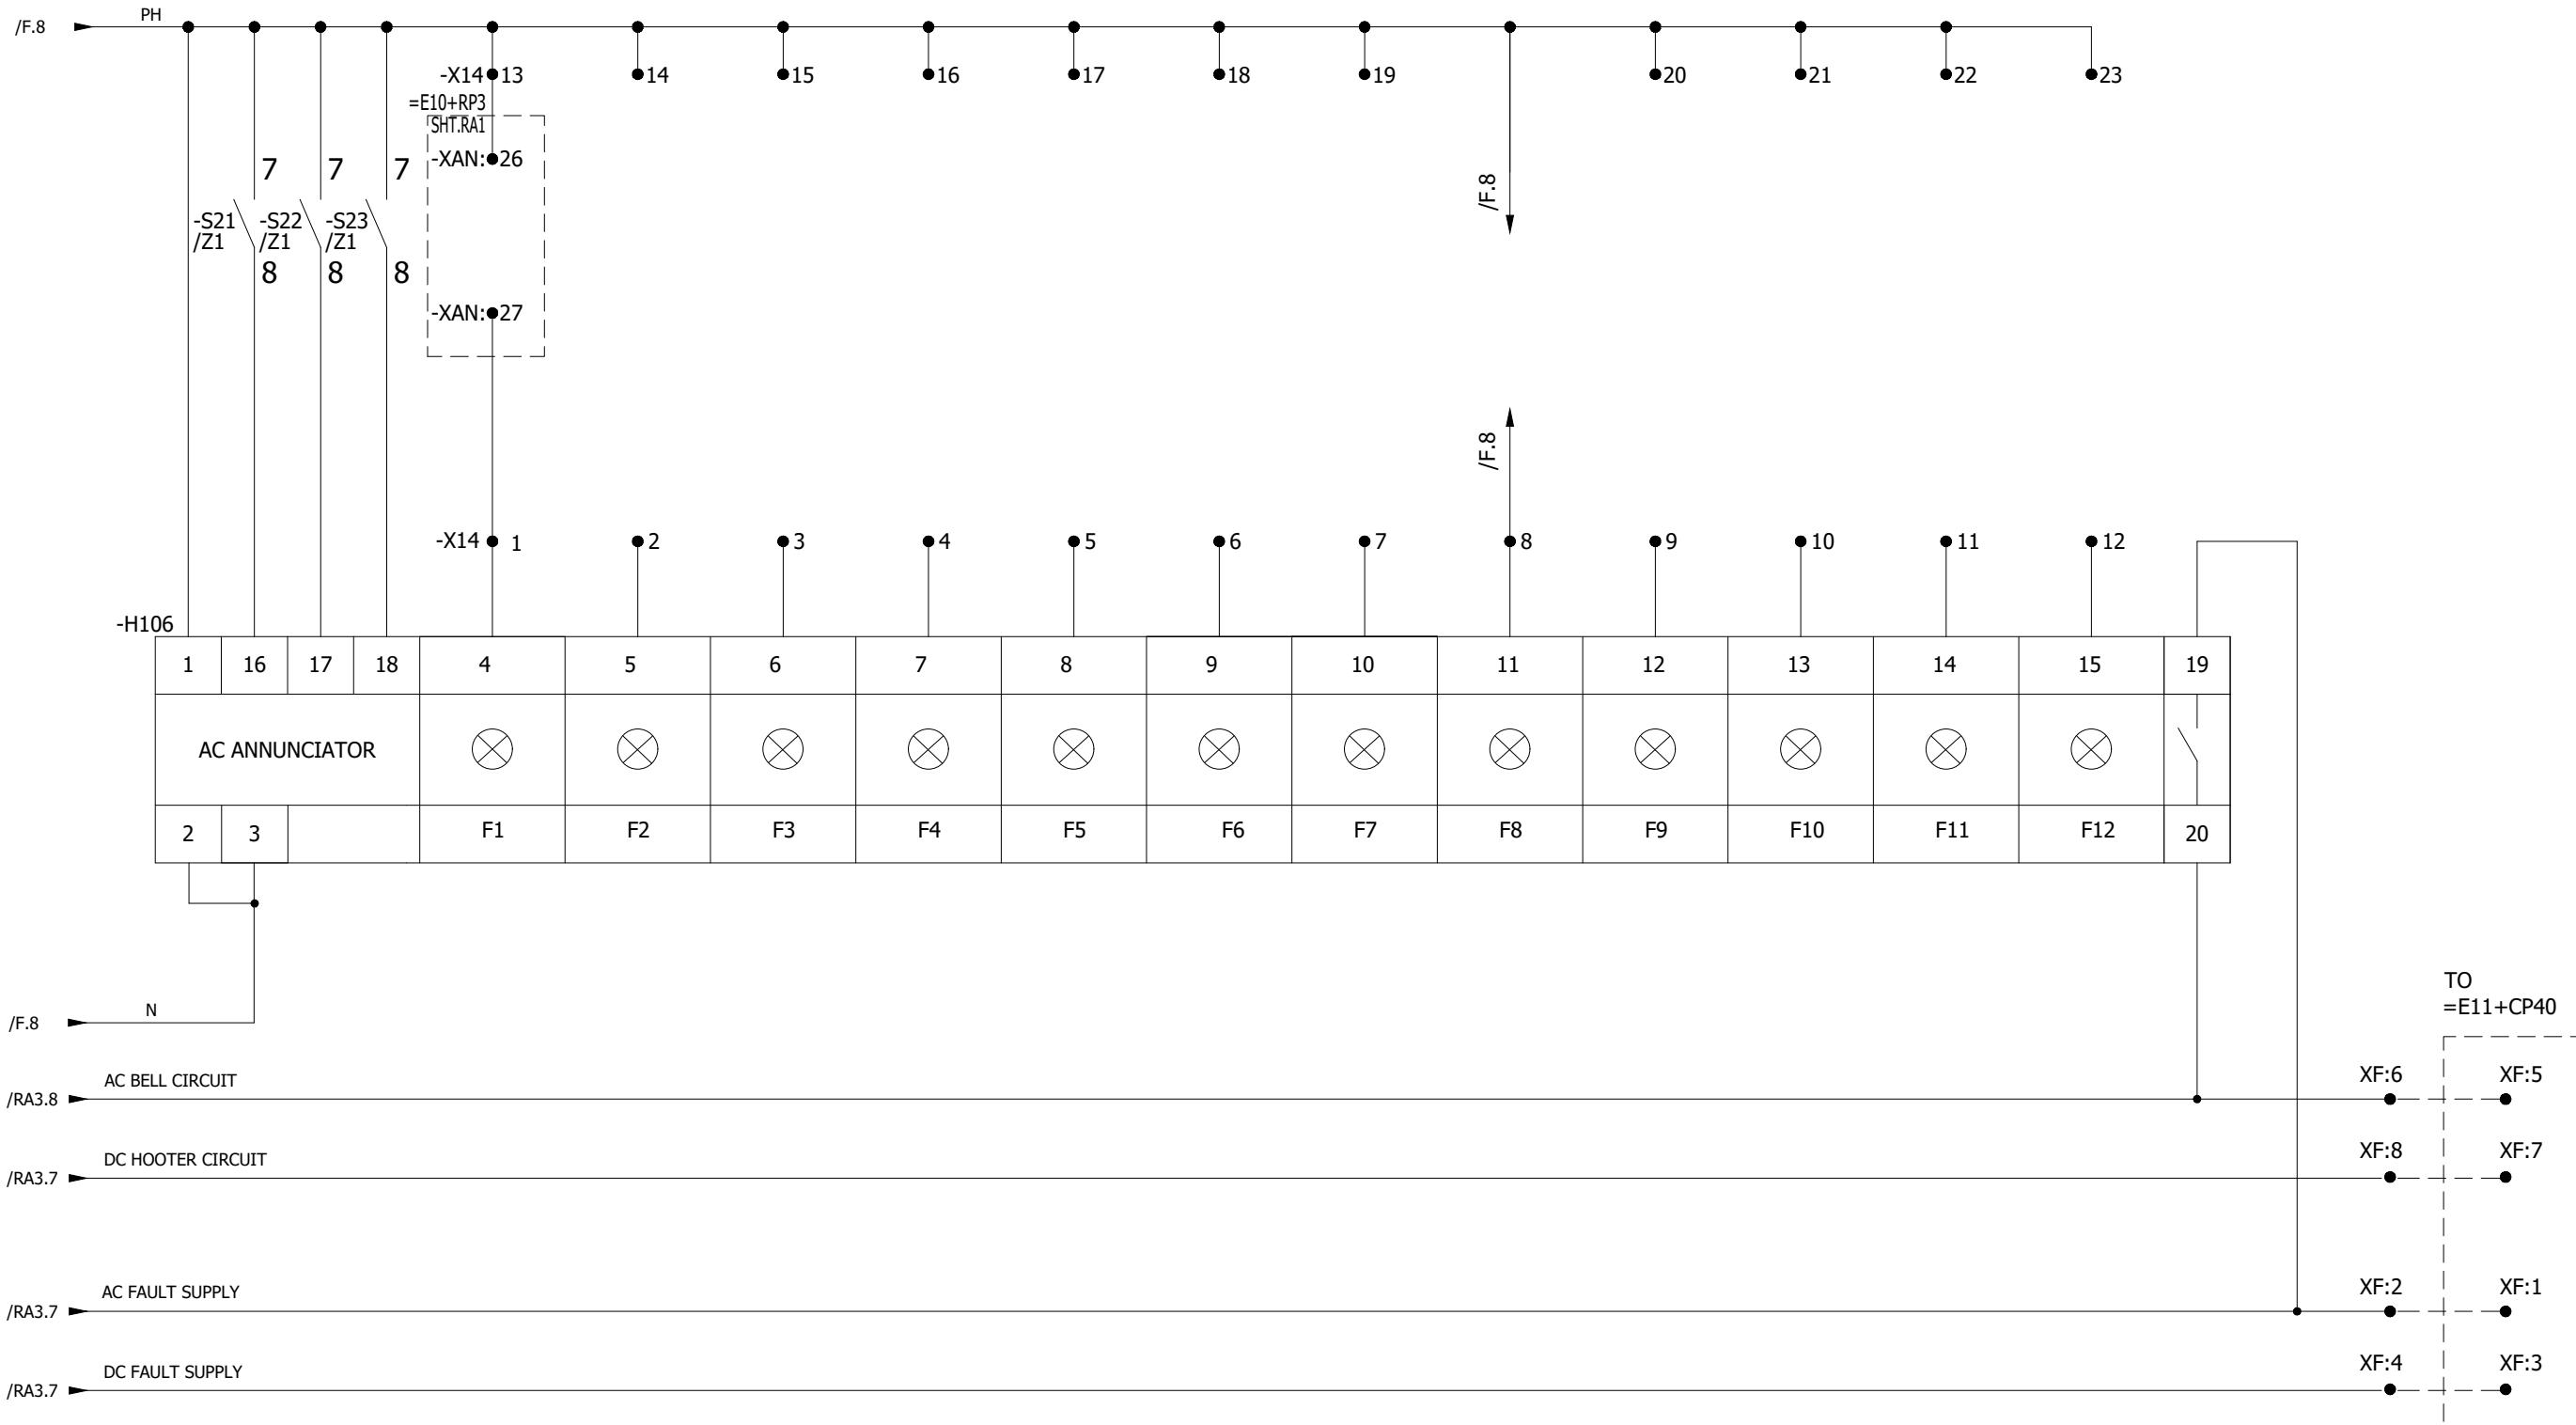

A
A

B
B

C
C



D
D

E
E


F
F

0	AS BUILT	30.10.2018	ASJ	Manufacturer	Contractor	Client	Project	Title	Drawing no.
REV.	DESCRIPTION	DATE	DRAWER	EPESOL 71-B Garden Block, New Garden Town,	Grid Solutions A GE and Alstom joint venture	NATIONAL TRANSMISSION & DISPATCH COMPANY LIMITED	220kV/132kV GIS SUBSTATION GHAZI ROAD, LAHORE	132kV LINE CONTROL PANEL (=E10+CP31) ANNUNCIATOR-4 CIRCUIT	P60194-E-ELC-SC-007
									Project no. P-60194 Sheet type RA4 Sheet no. 25

All information contained in this document is the exclusive property of GE GRID SOLUTIONS and shall not be used, copied or communicated to third parties without its prior authorization.

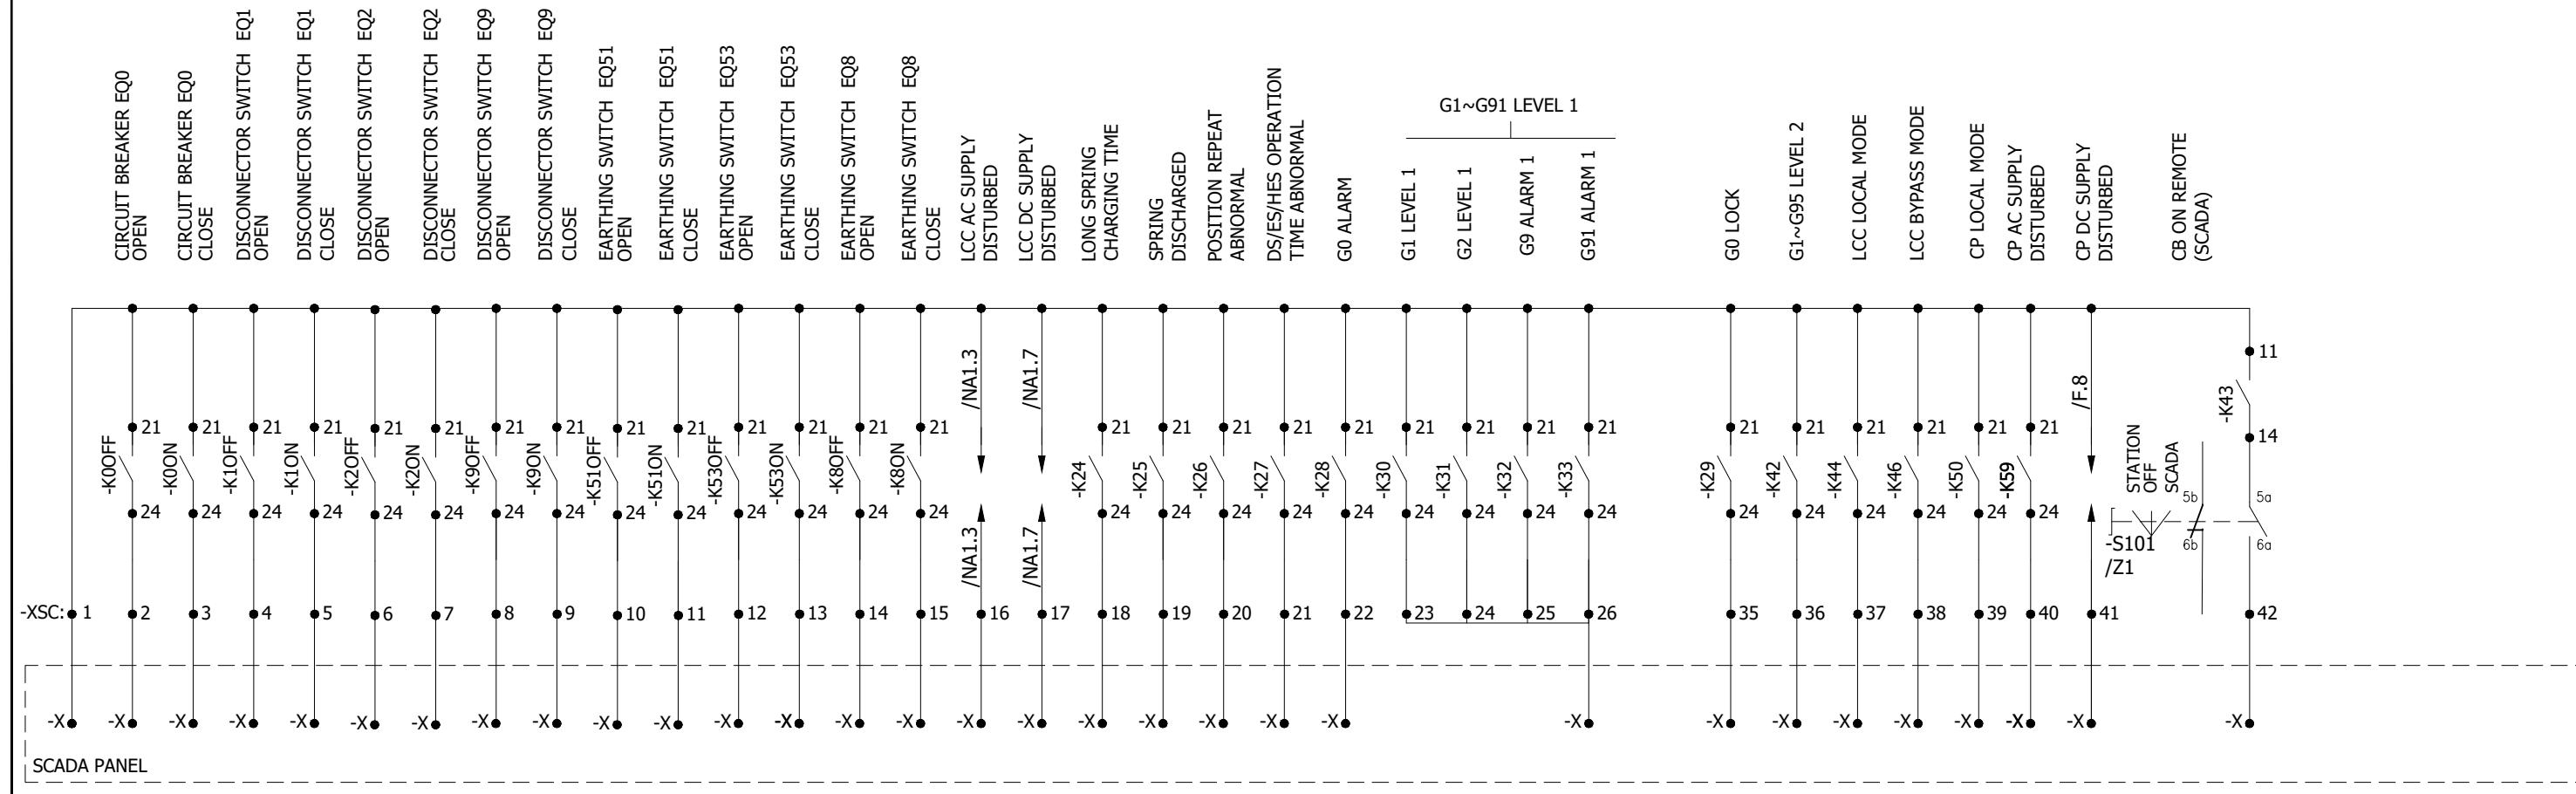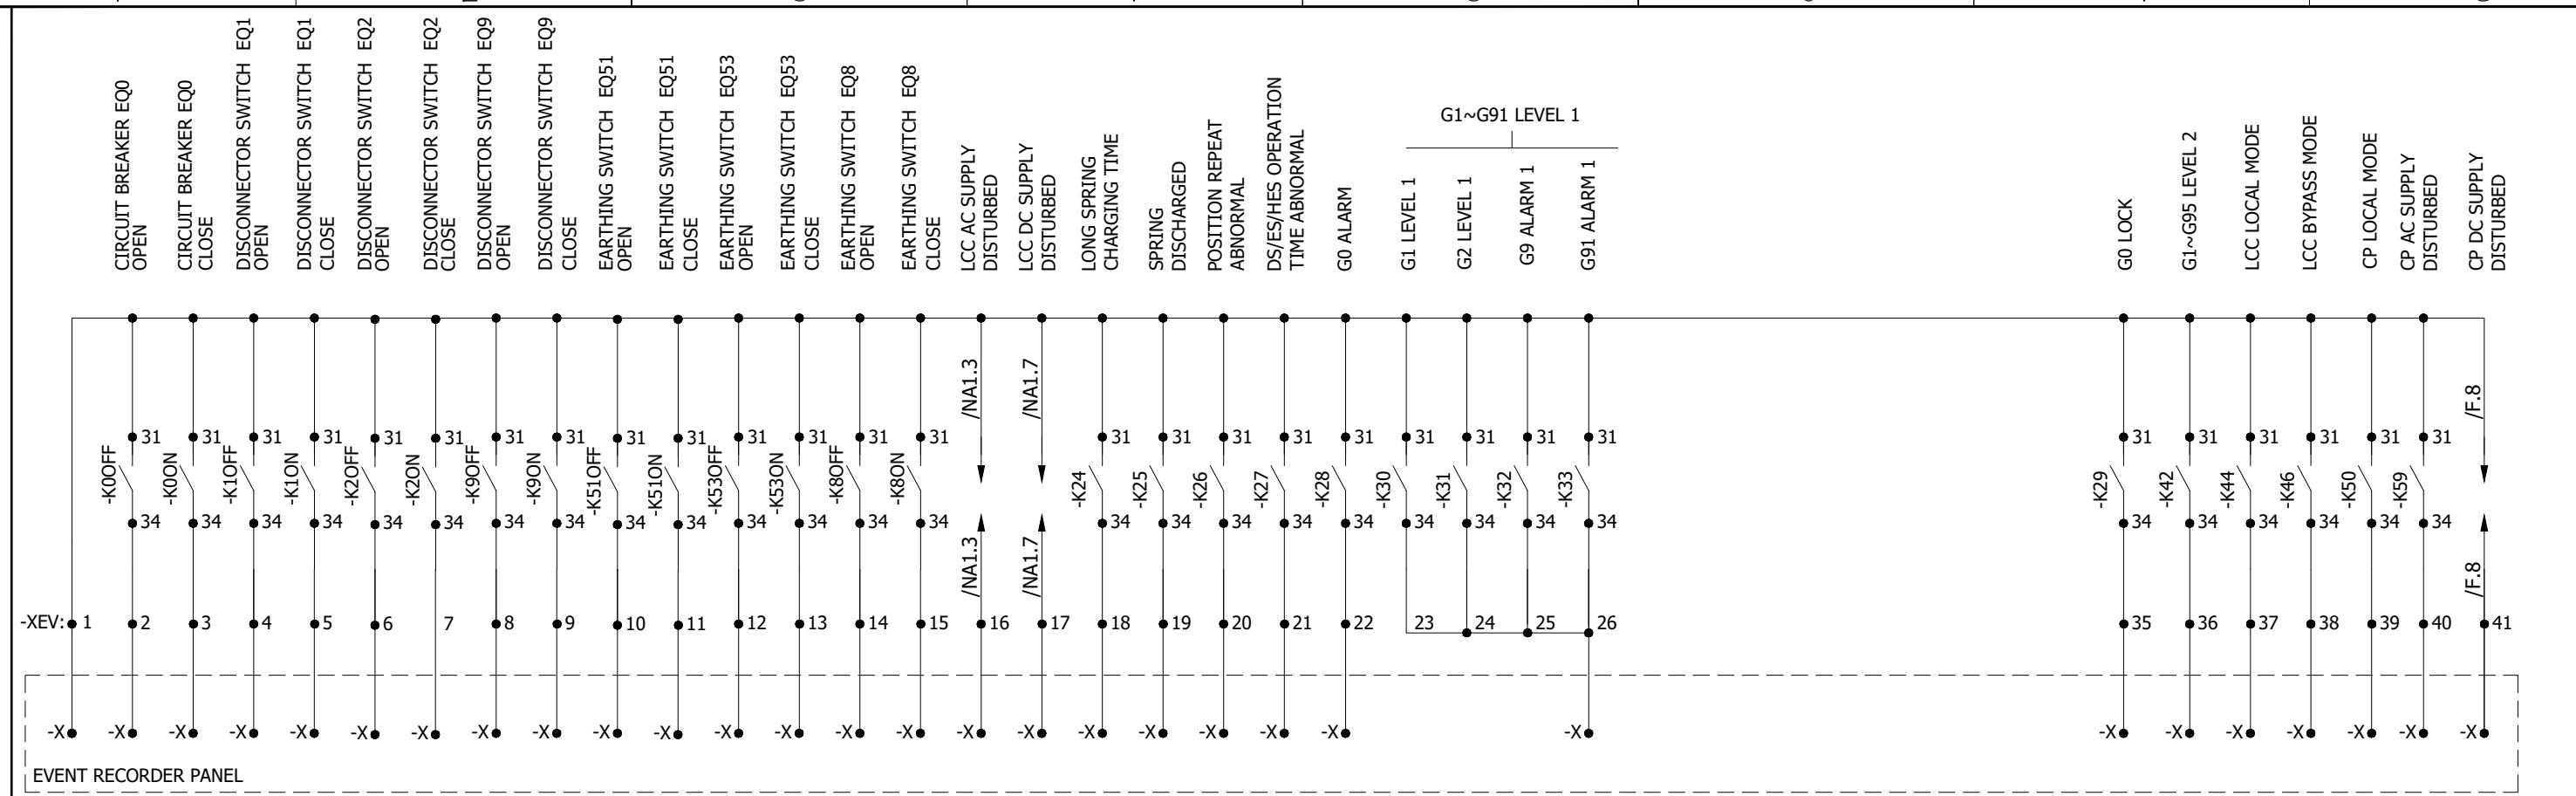

1 2 3 4 5 6 7 8

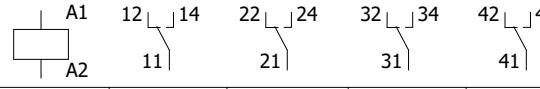A	
-K11	NA1.5 NA1.3 NA1.5 NA1.6
-K12	NA1.5 NA1.3 NA1.5 NA1.6
-K13	NA1.5 NA1.3 NA1.5 NA1.7
-K14	NA1.5 NA1.4 NA1.5 NA1.7
-K15	NA1.6 NA1.4 NA1.5 NA1.7
-K16	NA1.6 NA1.4 NA1.5 NA1.7
-K17	NA1.6 NA1.4 NA1.5 NA1.7
-K18	NA1.6 NA1.4 NA1.6 NA1.7
-K19	NA1.7 NA1.1 NA1.2 NA1.3
-K20	NA1.7 NA1.1 NA1.2 NA1.3
-K21	NA1.7 NA1.1 NA1.2 NA1.3
-K24	NA1.4 RA1.4 RA5.4 RA5.4
-K25	NA1.4 RA1.3 RA5.4 RA5.4 NA1.7
-K26	NA1.4 RA5.4 RA5.4
-K27	NA1.3 RA1.4 RA5.5 RA5.5
-K28	NA1.3 NA1.5 RA5.5 RA5.5
-K29	NA1.3 RA1.7 RA5.7 RA5.7 NA1.7
-K30	NA1.2 NA1.5 RA5.5 RA5.5
-K31	NA1.2 NA1.5 RA5.5 RA5.5
-K32	NA1.2 NA1.5 RA5.5 RA5.5
-K42	NA1.3 RA1.5 RA5.7 RA5.7
-K43	NA1.3 RA5.8
-K44	NA1.2 RA1.6 RA5.7 RA5.7
-K45	NA1.2
-K46	NA1.2 RA1.5 RA5.8 RA5.7
-K47	NA1.2 NA1.4 NA1.6 NA1.7
-K48	NA1.1 NA1.4 NA1.6 NA1.7
-K49	NA1.1 NA1.4 NA1.6 NA1.7
-K50	H1.2 RA5.8 RA5.8
-K0OFF	NA2.2 RA5.1 RA5.1
-K0ON	NA2.3 NA4.6 RA5.1 RA5.1
-K1OFF	NA2.3 RA5.2 RA5.2
-K1ON	NA2.4 RA5.2 RA5.2
-K2OFF	NA2.5 RA5.2 RA5.2
-K2ON	NA2.6 RA5.2 RA5.2
-K9OFF	NA2.6 RA5.3 RA5.2
-K9ON	NA2.7 RA5.3 RA5.3
-K51OFF	NA2.7 RA5.3 RA5.3
-K51ON	NA2.8 RA5.3 RA5.3
-K53OFF	NA3.3 RA5.3 RA5.3
-K53ON	NA3.4 RA5.4 RA5.3
-K8OFF	NA3.4 RA5.4 RA5.3
-K8ON	NA3.5 RA5.4 RA5.4

