



Grid Solutions

A GE and Alstom joint venture

220kV/132kV GIS SUBSTATION GHAZI ROAD , LAHORE


132kV LINE CONTROL PANEL SCHEMATIC DRAWINGS

	1	2	3	4	5	6	7	8				
	PAGE NO.	SHEET NAME	SHEET DESCRIPTION	ISSUE / REVISION								
				A	B	C	D	E	F	01	02	03
A B C D E F	01	A	COVER SHEET	X								
	02	AA	LIST OF CONTENTS	X								
	03	AB	SYMBOL AND LEGENDS	X								
	04	AC1	COMPONENT LIST	X								
	05	AC2	COMPONENT LIST	X								
	06	AD	PANEL VIEW	X								
	07	AE	SINGLE LINE DIAGRAM	X								
	08	D	AC SUPPLY DISTRIBUTION CIRCUIT	X								
	09	E	DC SUPPLY DISTRIBUTION CIRCUIT	X								
	10	F	DC SUPPLY FAILURE ALARM CIRCUIT	X								
	11	G	METERING	X								
	12	H1	CB CONTROL CIRCUIT	X								
	13	H2	CB CONTROL CIRCUIT	X								
	14	I1	DISCONNECTOR & EARTH SWITCH CONTROL	X								
	15	I2	DISCONNECTOR & EARTH SWITCH CONTROL	X								
	16	K1	DISCONNECTOR CONTACT MULTIPLICATION	X								
	17	NA1	ALARM MULTIPLICATION	X								
	18	NA2	DISCREPANCY INITIATION	X								
	19	NA3	DISCREPANCY INITIATION	X								
	20	NA4	DISCREPANCY INITIATION	X								
	21	NA5	DISCREPANCY INDICATIONS	X								
	22	RA1	ANNUNCIATOR-1 CIRCUIT	X								
	23	RA2	ANNUNCIATOR-2 CIRCUIT	X								
	24	RA3	ANNUNCIATOR-3 CIRCUIT	X								
	25	RA4	ANNUNCIATOR-4 CIRCUIT	X								
	26	RA5	SCADA & ER SIGNALS	X								
	27	Z1	COMPONENT DIAGRAM	X								
All information contained in this document is the exclusive property of GE GRID SOLUTIONS and shall not be used, copied or communicated to third parties without its prior authorization.												
0	AS BUILT	19-10-2018	ASJ	Manufacturer  EPESOL 71-B Garden Block, New Garden Town, Lahore, Pakistan	Contractor  Grid Solutions A GE and Alstom joint venture	Client  NATIONAL TRANSMISSION & DISPATCH COMPANY LIMITED (NTDC-WAPDA)	Project 220kV/132kV GIS SUBSTATION GHAZI ROAD, LAHORE	Title 132kV LINE CONTROL PANEL (=E01+CP31) LIST OF CONTANTS	Drawing no. P60194-E-ELC-SC-002			
REV.	DESCRIPTION	DATE	DRAWER						Project no. P-60194	Sheet type AA	Sheet no. 02	

	SYMBOL	DESCRIPTION	SYMBOL	DESCRIPTION	SYMBOL	DESCRIPTION	SYMBOL	DESCRIPTION
A		CIRCUIT BREAKER		MINIATURE CIRCUIT BREAKER		AUXILIARY CONTACTOR NO+NC	21	DISTANCE
B		SWITCH/ISOLATOR		SELECTOR SWITCH		AMMETER	24	OVEREXCITATION
C		EARTHING		LIMITED SWITCH		VOLTmeter	25	SYCHROCHECK
D		GIS TERMINATION		HUMIDITY & TEMPERATURE CONTROLLER		POWER FACTOR METER	49	THERMAL OVERLOAD
E		SF6 TO AIR BUSHING		PANEL HEATER		DIGITAL PANEL METER	50/51	PHASE OVERCURRENT
F		LINE TRAP		THREE PIN SOCKET		ACTIVE POWER METER	50N/51N	EARTH FAULT
G		SURGE ARRESTOR		INDICATION LIGHT		REACTIVE POWER METER	50BF	CIRCUIT BREAKER FAILURE
H		CURRENT TRANSFORMER		PUSH BUTTON		ENERGY METER	64	RESTRICTED EARTH FAULT
I		COUPLING CAPACITOR VOLTAGE TRANSFORMER		AUXILIARY CONTACTOR COIL			67N	DIRECTIONAL EARTH FAULT
J		POWER TRANSFORMER		POWER SUPPLY AC/DC			68	POWER SWING BLOCKING
K		AUTO TRANSFORMER		TERMINAL			78	OUT OF STEP
L				OPTO CONTACTS			79	AUTO-RECLOSING
M				RELAY CONTACTS			85	COMMUNICATION FAILURE
N				HOOTER			87T	TRAFO DIFFERENTIAL
O				AC BELL			87C	LOW IMPEDANCE DIFFERENTIAL CONNECTION
P							87BB	LOW IMPEDANCE DIFFERENTIAL BUSBAR

All information contained in this document is the exclusive property of GE GRID SOLUTIONS and shall not be used, copied or communicated to third parties without its prior authorization.

0	AS BUILT	19-10-2018	MUR	Manufacturer EPESOL 71-B Garden Block, New Garden Town, Lahore, Pakistan	Contractor Grid Solutions A GE and Alstom joint venture	Client NATIONAL TRANSMISSION & DISPATCH COMPANY LIMITED (NTDC-WAPDA)	Project 220kV/132kV GIS SUBSTATION GHAZI ROAD, LAHORE	Title 132kV LINE CONTROL PANEL (=E01+CP31) SYMBOL AND LEGENDS	Drawing no. P60194-E-ELC-SC-002
REV.	DESCRIPTION	DATE	DRAWER						Project no. P-60194
									Sheet type AB
									Sheet no. 03

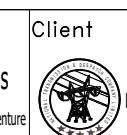	1	2	3	4	5	6	7	8			
	QTY.	DEVICE DESCRIPTION	DEVICE SPECIFICATIONS DEVICE TYPE ; TECHNICAL DATA / SPECIFICATIONS			DEVICE DESIGNITION	MANUFACTURER				
A	01	MWH+MVARTH METER	THREE PHASE FOUR WIRE STATIC ENERGY METER, CLASS 0.2, PT RATIO: 132/0.11 KV (L-L), CT RATIO 400:800:1600/1A , MODEL: MT860S-A22R36S33-E1-L21-M3K03-Z7			-P11	ISKRAEMECO				
	02	ANALOG AMMETER	METER: TRANSDUCER OPERATED DIGITAL AMPERE METER, INPUT 0...20/30 mA, ACCURACY CLASS 1, SCALE_1: 0...400/600A, SCALE_2: 0...800/1200A, SCALE_3: 0...1600/2400A. , AUX. VOLTAGE 110 VDC.			-Q1 , -Q3	FRER				
B	02	CURRENT TRANSDUCER	CURRENT TRANSDUCER: 1-INPUT, 2-OUTPUT, NOMINAL INPUT CURRENT 1/1.5A, OUTPUT1: 0...20/30mA, OUTPUT2: 0...20/30mA, AUXILIARY VOLTAGE 110 VDC, ACCURACY CLASS 1, CT RATIO 400:800:1600/1A ORD: A96MMA + MCOEAQ			-U1, -U3	FRER				
	01	DIGITAL AMMETER	METER: TRANSDUCER OPERATED DIGITAL AMPERE METER, INPUT 0...20/30 mA, ACCURACY CLASS 1, SCALE_1: 0...400/600A, SCALE_2: 0...800/1200A, SCALE_3: 0...1600/2400A. , AUX. VOLTAGE 110 VDC.			-Q2	FRER				
C	02	CURRENT TRANSDUCER	CURRENT TRANSDUCER: 1-INPUT, 2-OUTPUT, NOMINAL INPUT CURRENT 1/1.5A, OUTPUT1: 0...20/30mA, OUTPUT2: 0...20/30mA, AUXILIARY VOLTAGE 110 VDC, ACCURACY CLASS 1, CT RATIO 400:800:1600/1A ORD: D96MMA + MCOEAQ			-U2, -U12	FRER				
	01	ANALOG REAL POWER (MW) METER	METER: 240 DEGREE TRANSDUCER OPERATED ANALOGUE MW METER, INPUT -12.5/10...0...+10/12.5 mA, ACCURACY CLASS 1, SCALE_1: 125/100-0-100/125 MW (91.5 MW at 20mA), SCALE_2: 250/200-0-200/250 MW (183 MW at 20mA), SCALE_3: 500/400-0-400/500 MW (366 MW at 20mA).			-Q5	FRER				
D	01	ANALOG REACTIVE POWER (MVAR) METER	METER: 240 DEGREE TRANSDUCER OPERATED ANALOGUE MVAR METER, INPUT -12.5/10...0...+10/12.5 mA, ACCURACY CLASS 1, SCALE_1: 125/100-0-100/125 MVAR (91.5 MVAR at 20mA), SCALE_2: 250/200-0-200/250 MVAR (183 MVAR at 20mA), SCALE_3: 500/400-0-400/500 MVAR (366 MVAR at 20mA).			-Q6	FRER				
	01	PROGRAMMABLE UNIVERSAL TRANSDUCER (for MW and MVAR meters)	TRANSDUCER: 3-PHASE, 4-WIRE BALANCED LOAD, 4 PROGRAMMABLE DC mA OUTPUTS. NOMINAL INPUT VOLTAGE 110/137.5 VAC(L-L), NOMINAL INPUT CURRENT 1/1.25A, AUXILIARY VOLTAGE 110 VDC, ACCURACY CLASS 1, OUTPUT1 to OUTPUT4: -12.5/10...0...+10/12.5 mA, PT RATIO: 132/0.11 KV (L-L), CT RATIO 400:800:1600/1A. ORD: MCOP4			-U5	FRER				
E	01	DIGITAL POWER METER	THREE PHASE DIGITAL POWER METER, ACCURACY CLASS 0.5s, INPUT NOMINAL CURRENT, 1/5A, INPUT NOMINAL VOLTAGE 110 VAC (L-L), AUXILIARY VOLTAGE 110-375 VDC.			-Q7	ENERDIS				
	03	ANNUNCIATOR	TWELVE WINDOW ANNUNCIATOR, RATED VOLTAGE 110 VDC, ORD: AM-101			-H101, -H102, -H103	ELABS				
F	01	ANNUNCIATOR	TWELVE WINDOW ANNUNCIATOR, RATED VOLTAGE 240 VAC, ORD: AM-101			-H106	ELABS				
	01	PUSH BUTTON - LAMP TEST	TYPE: SWITCH (A TYPE:), COLOR : BLACK , SUPPLY : 120VDC, Ord: YS-AP1-2-31-B-D-W			-S21	YONGSUNG				
F	01	PUSH BUTTON - ALARM ACKNOWLEDGMENT	TYPE: SWITCH (A TYPE:), COLOR : RED , SUPPLY : 120VDC, Ord: YS-AP1-2-31-R-D-W			-S22	YONGSUNG				
	0	AS BUILT	19-10-2018	ASJ	Manufacturer  EPESOL 71-B Garden Block, New Garden Town, Lahore, Pakistan	Contractor  GE Grid Solutions A GE and Alstom joint venture	Client  NATIONAL TRANSMISSION & DISPATCH COMPANY LIMITED (NTDC-WAPDA)	Project 220KV/132KV GIS SUBSTATION GHAZI ROAD, LAHORE	Title 132KV LINE CONTROL PANEL (=E01+CP31) COMPONENT LIST	Drawing no. P60194-E-ELC-SC-002	
F	REV.	DESCRIPTION	DATE	DRAWER					Project no. P-60194	Sheet type AC1	Sheet no. 04

	1	2	3	4	5	6	7	8			
	QTY.	DEVICE DESCRIPTION	DEVICE SPECIFICATIONS DEVICE TYPE ; TECHNICAL DATA / SPECIFICATIONS			DEVICE DESIGNITION	MANUFACTURER				
A	01	PUSH BUTTON - ALARM RESET	TYPE: SWITCH(A TYPE:), COLOR : GREEN , SUPPLY : 120VDC, Ord: YS-AP1-2-31-G-D-W			-S23	YONGSUNG				
	01	SELECTOR SWITCH - OPERATION (LOCAL-OFF-SCADA)	3-POSITION (STATION-OFF-SCADA), 110VDC, KEYLOCKABLE TYPE, ORD: YS-AK-2-3-44-D			-S101	YONGSUNG				
	73	AUXILIARY CONTACTOR	COIL VOLTAGE: 110VDC, 4 C/O CONTACTS, ORD: PRC4M40DCJL			-K0E, -KS0, -KOA, -KDC1, -K1, -K2, -K9, -K0, -K11 TO -K46, -K59,-K0OFF, -K0ON, -K0D, -K1OFF, -K1ON, -K1D, -K2OFF, -K2ON, -K2D, -K9OFF, -K9ON, -K9D, -K51OFF, -K51ON, -K51D, -K53OFF, -K53ON, -K53D, -K8OFF, -K8ON, -K8D, -KDC2, -KS21, -K111, -K222	GE				
B	01	AUXILIARY CONTACTOR - SUPPLY CHANGEOVER	COIL VOLTAGE: 110VDC, 3 NO + 3 NC CONTACTS, ORD: MCRC022ATWJ-B+MARN211AT			-KDC	GE				
	03	AUXILIARY CONTACTOR	COIL VOLTAGE:: 240VAC, 4 C/O CONTACTS, ORD: PRC4M40ANL			-KAMC, -K7, -K8	GE				
	01	CONTROL DISCREPANCY SWITCH - CIRCUIT BREAKER	CONTROL AND DISCREPANCY SWITCH FOR ISOLATOR CONTROL AND INDICATION, SQUARE TYPE FOUR CONTACTS FOR COMMAND AND FOUR CONTACTS FOR INDICATION			-S0	YONGSUNG				
C	06	CONTROL DISCREPANCY SWITCH - ISOLATORS & EARTHING SW.	CONTROL AND DISCREPANCY SWITCH FOR ISOLATOR CONTROL AND INDICATION, ROUND TYPE FOUR CONTACTS FOR COMMAND AND FOUR CONTACTS FOR INDICATION ORD:YS-IC-4456-R4(49)-PM-K-G-D11-G			-S1, -S2, -S9, -S51, -S53, -S8	YONGSUNG				
	01	FLASHER RELAY	FLASHER RELAY, COIL VOLTAGE 110 VDC, ORD: FR-101-110			-K51	ELABS				
	02	TEST BLOCK	YS-CTT-04-S, YS-PTT-04-S			-XTB1, -XTB2	YONGSUNG				
D	02	INDICATION LIGHT - AC AND DC SUPPLY	TYPE: LED , COLOR : RED , SUPPLY : 240VAC ORD: YS-PL-2-AL-22-R-W			-H7, -H8	YONGSUNG				
	01	OPERATION COUNTER	OPERATION COUNTER FOR CIRCUIT BREAKER, RATED VOLTAGE 110VDC			-Q10	ELABS				
	03	CONTROL MCB - PANEL LIGHT & HEATER	2-Pole, Ratings: 2A, 240VAC, 6kA @ 240VAC, 2 C/O Contacts, Ord: G62C02+CAH(2)			-F101, -F102,-F104	GE				
E	01	CONTROL ELCB - PANEL SOCKET	2-Pole, Ratings: 16A, 30mA, 240VAC, 1P+N, 2 C/O Contacts, Ord: DM100C16/030+CAH(2)			-F103	GE				
	03	CONTROL MCB - DC DISTRIBUTION	2-Pole, Ratings: 4A, 250VDC, 10kA @ 250VDC, 2 C/O Contacts, Ord: EP102UCC04+CAH(2)			-F201,-F202,-F203	GE				
	01	PANEL LIGHT	230VAC @ 50Hz, 05W, Ord: YS-T8-30-5W			-H100	YONGSUNG				
F	01	DOOR SWITCH	230VAC @ 50Hz, 1 NO Contact, Ord: YS P3315GW-B + YS MS-C			-S100	YONGSUNG				
	01	THREE PIN SOCKET	1N+PE, 16A, 230VAC @ 50Hz			-X100	LOCAL				
	0	AS BUILT	19-10-2018	ASJ	Manufacturer  EPESOL 7-B Garden Block, New Garden Town, Lahore, Pakistan	Contractor  A GE and Alstom joint venture	Client  NATIONAL TRANSMISSION & DISPATCH COMPANY LIMITED (NTDC-WAPDA)	Project 220kV/132kV GIS SUBSTATION GHAZI ROAD, LAHORE	Title 132kV LINE CONTROL PANEL (=E01+CP31) COMPONENT LIST	Drawing no. P60194-E-ELC-SC-002	
	REV.	DESCRIPTION	DATE	DRAWER					Project no. P-60194	Sheet type AC2	Sheet no. 05

	1	2	3	4	5	6	7	8		
	QTY.	DEVICE DESCRIPTION	DEVICE SPECIFICATIONS DEVICE TYPE ; TECHNICAL DATA / SPECIFICATIONS			DEVICE DESIGNITION	MANUFACTURER			
A	01	PANEL HEATER	240VAC @ 50Hz, 50W			-R100	E-LABS			
	01	HUMIDITY & TEMPERATURE CONTROLLER	40-90%RH, 25-50 deg.C, 240VAC @ 50Hz			-B100	E-LABS			
	01	HOOTER	RATED VOLTAGE 110VDC ORD: AH-101			-H1	E-LABS			
B	01	BELL	BELL, RATED VOLTAGE 240VAC, ORD: YSMB-722A			-B1	YONGSUNG			
	04	TERMINAL BLOCKS FOR AC SUPPLY	TYPE: CBD-4			-XAC	CABUR			
	02	TERMINAL BLOCKS FOR DC SUPPLY1	TYPE: CBD-4			-XDC-1	CABUR			
C	02	TERMINAL BLOCKS FOR DC SUPPLY2	TYPE: CBD-4			-XDC-2	CABUR			
	16	TERMINAL BLOCKS FOR METERING	TYPE: CBD-4			-X3	CABUR			
	08	TERMINAL BLOCKS FOR CB CONTROL CIRCUIT	TYPE: CBD-4			-X4	CABUR			
D	12	TERMINAL BLOCKS FOR CB CONTROL CIRCUIT	TYPE: CBD-4			-X5	CABUR			
	35	TERMINAL BLOCKS FOR DS+ES CONTACTOR MULTIPLICATION	TYPE: CBD-4			-X6	CABUR			
	08	TERMINAL BLOCKS FOR CB/DS CONTACTOR MULTIPLICATION	TYPE: CBD-4			-X7	CABUR			
E	40	TERMINAL BLOCKS FOR AUXIALARY MULTIPLICATION	TYPE: CBD-4			-X8	CABUR			
	15	TERMINAL BLOCKS FOR DISCRIPANCY INITIATION	TYPE: CBD-4			-X9				
	13	TERMINAL BLOCKS FOR ANNUNCIATOR-1	TYPE: CBD-4			-X11	CABUR			
F	16	TERMINAL BLOCKS FOR ANNUNCIATOR-2	TYPE: CBD-4			-X12	CABUR			
	18	TERMINAL BLOCKS FOR ANNUNCIATOR-3	TYPE: CBD-4			-X13	CABUR			
	24	TERMINAL BLOCKS FOR ANNUNCIATOR-4	TYPE: CBD-4			-X14	CABUR			
G	45	TERMINAL BLOCKS FOR EVENT RECORDER	TYPE: CBD-4			-XEV	CABUR			
	45	TERMINAL BLOCKS FOR SCADA	TYPE: CBD-4			-XSC	CABUR			
	30	TERMINAL BLOCKS FOR TRANSDUCER TO SCADA	TYPE: CBD-4			-XSA	CABUR			
H	30	TERMINAL BLOCKS FOR SCADA	TYPE: CBD-4			-XSP	CABUR			
	0	AS BUILT	19-10-2018	ASJ	Manufacturer  EPESOL 7-B Garden Block, New Garden Town, Lahore, Pakistan	Contractor  Grid Solutions A GE and Alstom joint venture	Client  NATIONAL TRANSMISSION & DISPATCH COMPANY LIMITED (NTDC-WAPDA)	Project 220kV/132kV GIS SUBSTATION GHAZI ROAD, LAHORE	Title 132kV LINE CONTROL PANEL (=E01+CP31) COMPONENT LIST	Drawing no. P60194-E-ELC-SC-002
	REV.	DESCRIPTION	DATE	DRAWER				Project no. P-60194	Sheet type AC3	Sheet no. 05a

	1	2	3	4	5	6	7	8			
A B C D E F	QTY.	DEVICE DESCRIPTION		DEVICE SPECIFICATIONS DEVICE TYPE ; TECHNICAL DATA / SPECIFICATIONS			DEVICE DESIGNITION		MANUFACTURER		
	08	TERMINAL BLOCKS FOR BELL AND HOOTER		TYPE: CBD-4			-XF		CABUR		
	08	TERMINAL BLOCKS FOR MERTERING CV		TYPE: SCB-6			-X2		CABUR		
	07	TERMINAL BLOCKS WITH DIODE TYPE IN-D4007, RATED MAXIMUM VOLTAGE 350VDC, RATED BREAK DOWN VOLTAGE 430VDC		TYPE: DAS.4/6			-XD		CABUR		
<i>All information contained in this document is the exclusive property of GE GRID SOLUTIONS and shall not be used, copied or communicated to third parties without its prior authorization.</i>											
0	AS BUILT	19-10-2018	ASJ	Manufacturer  EPESOL 21-B Garden Block, New Garden Town, Lahore, Pakistan	Contractor  Grid Solutions A GE and Alstom joint venture	Client  NATIONAL TRANSMISSION & DISPATCH COMPANY LIMITED (NTDC-WAPDA)	Project 220KV/132KV GIS SUBSTATION GHAZI ROAD, LAHORE	Title 132KV LINE CONTROL PANEL (=E01+CP31) COMPONENT LIST	Drawing no. P60194-E-ELC-SC-002		
REV.	DESCRIPTION	DATE	DRAWER						Project no. P-60194	Sheet type AC3	Sheet no. 05b

1

1

1

4


5

6


1

1


FRONT VIEW

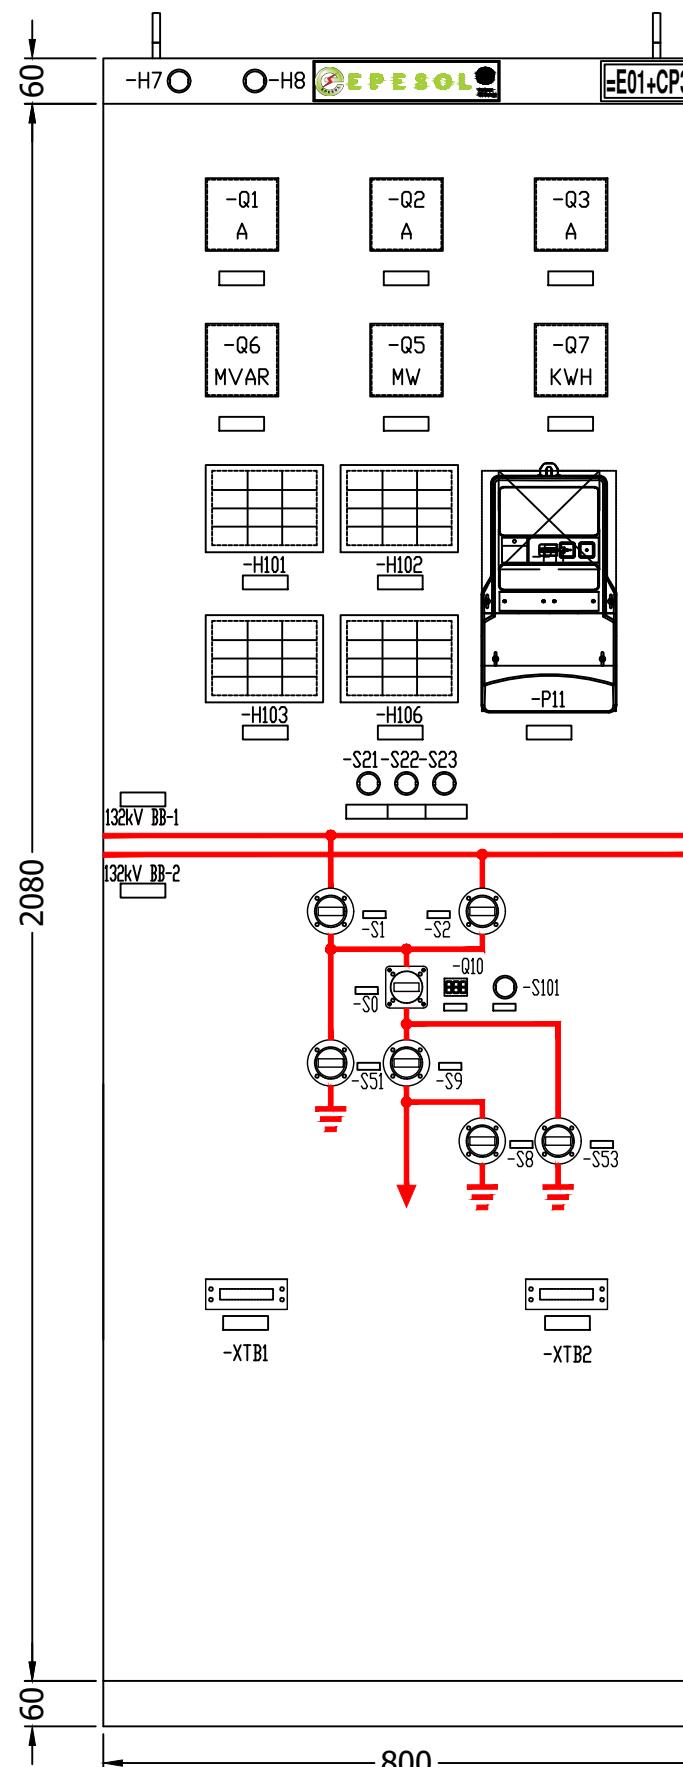


LEFT SIDE VIEW



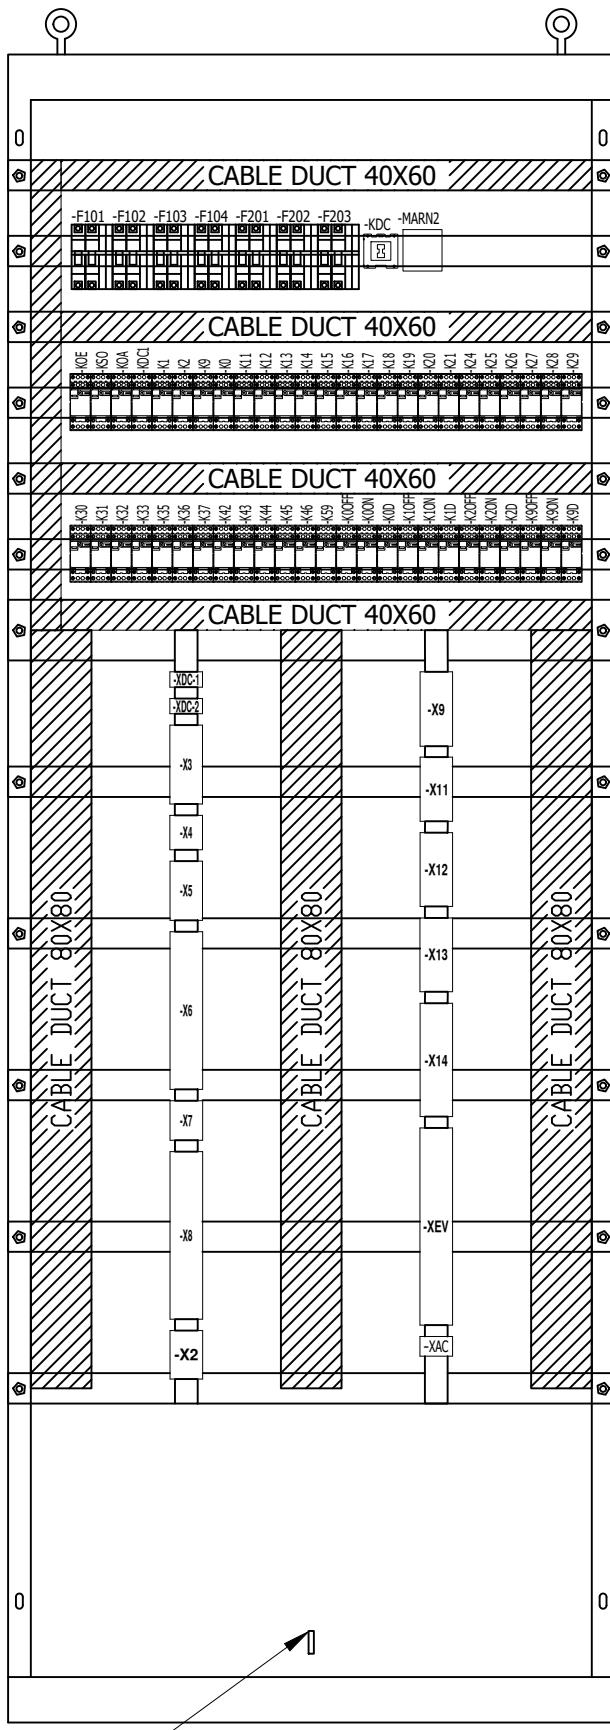


RIGHT SIDE VIEW

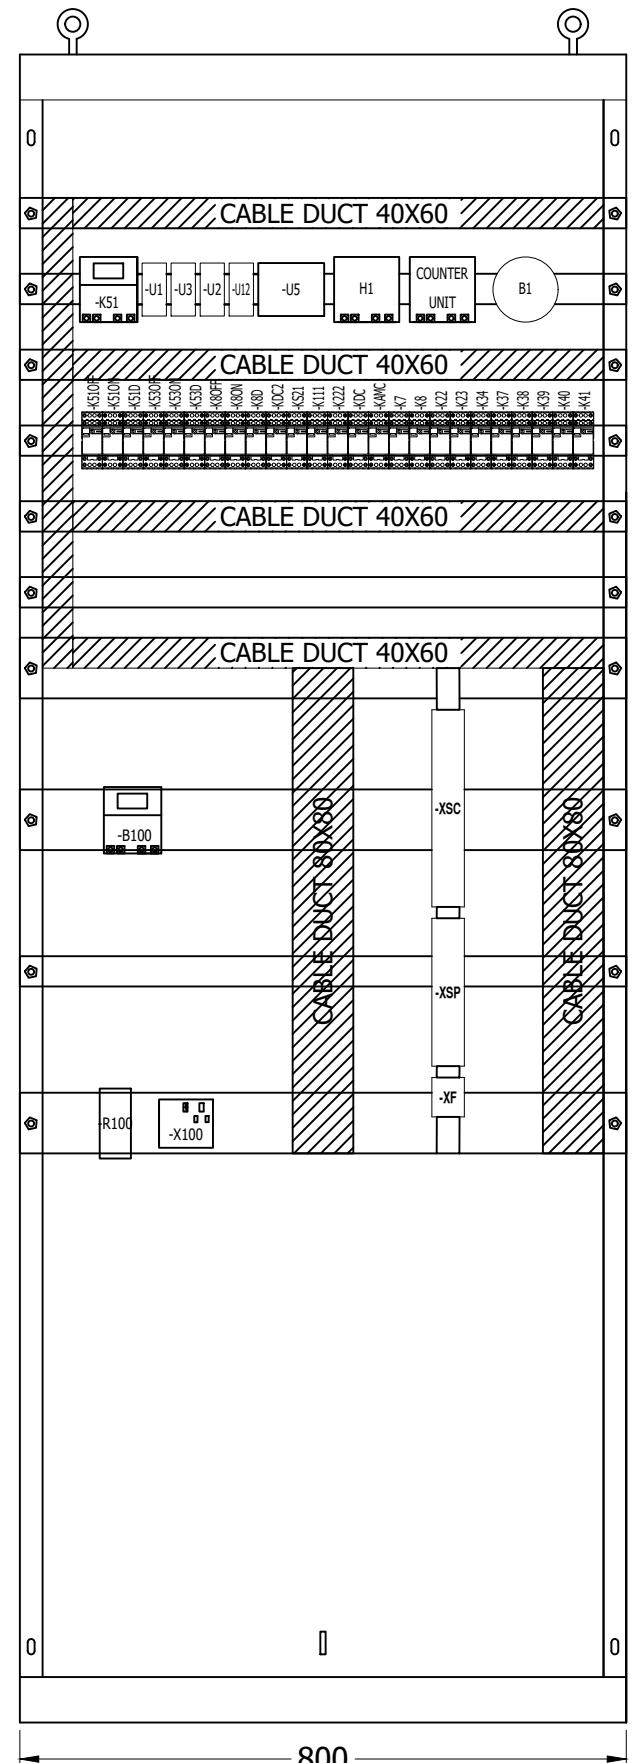

All information contained in this document is the exclusive property of GE GRID SOLUTIONS and shall not be used, copied or communicated to third parties without its prior authorization.

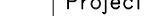0	AS BUILT	19-10-2018	ASJ	Manufacturer  EPESOL 7a-B Garden Block, New Garden Town, Lahore, Pakistan	Contractor  Grid Solutions A GE and Alstom joint venture	Client  NATIONAL TRANSMISSION & DISPATCH COMPANY LIMITED (NTDC-WAPDA)	Project 220kV/132kV GIS SUBSTATION GHAZI ROAD, LAHORE	Title 132kV LINE CONTROL PANEL (=E01+CP31) PANEL VIEWS	Drawing no. P60194-E-ELC-SC-002		
									Project no.	Sheet type	
REV.	DESCRIPTION	DATE	DRAWER						P-60194	AD	06

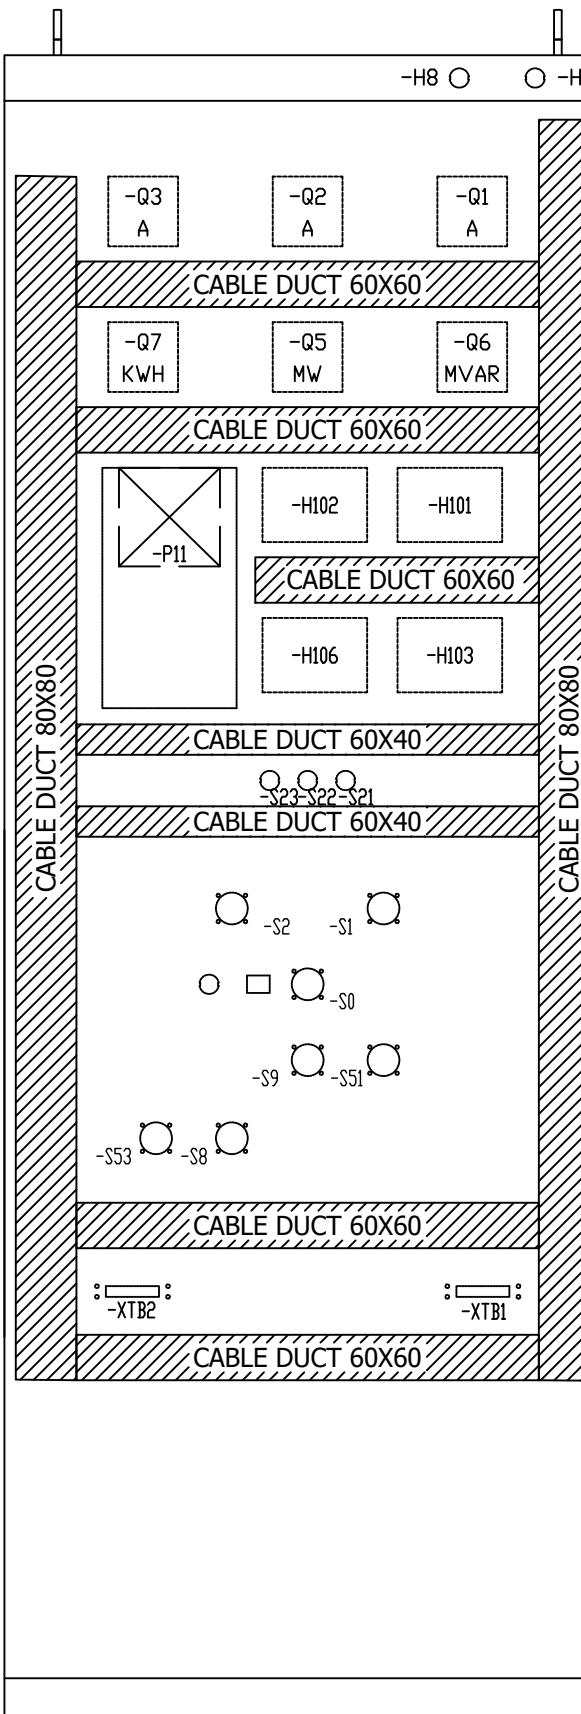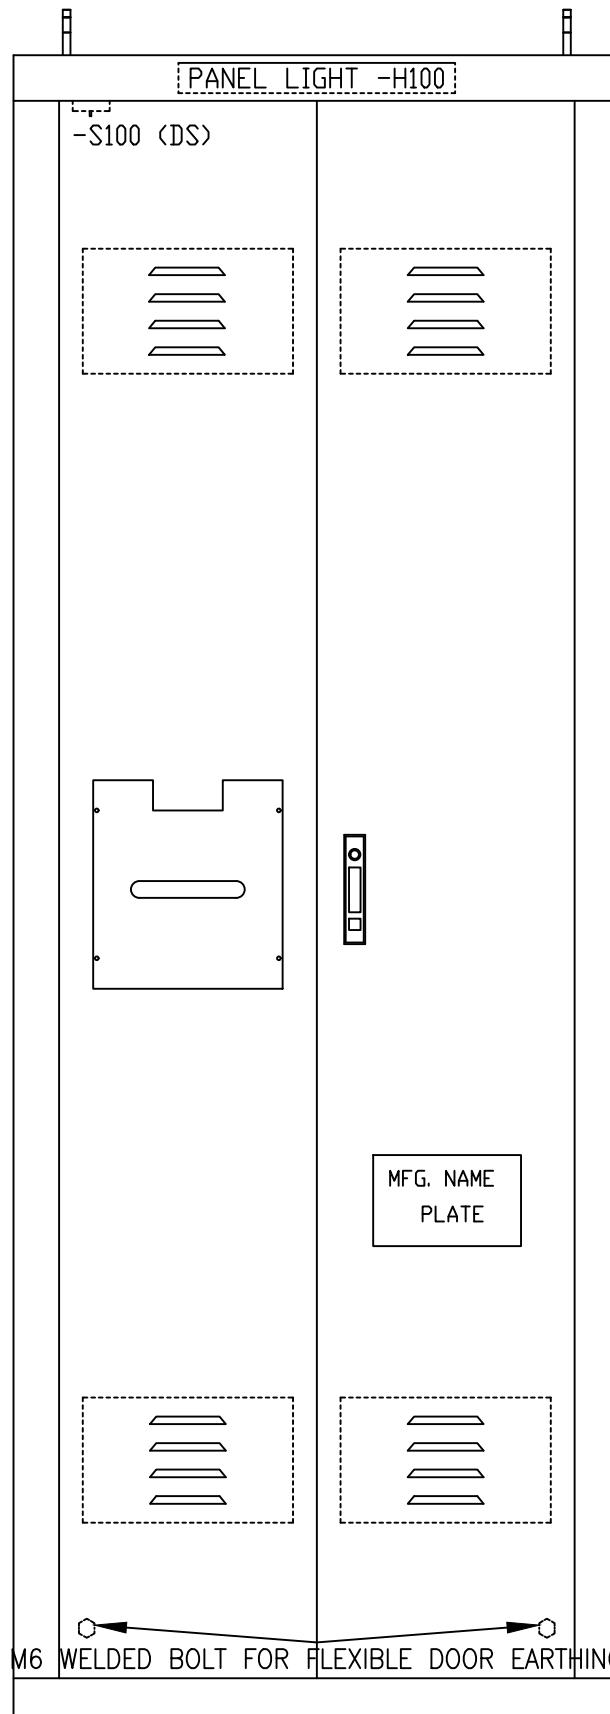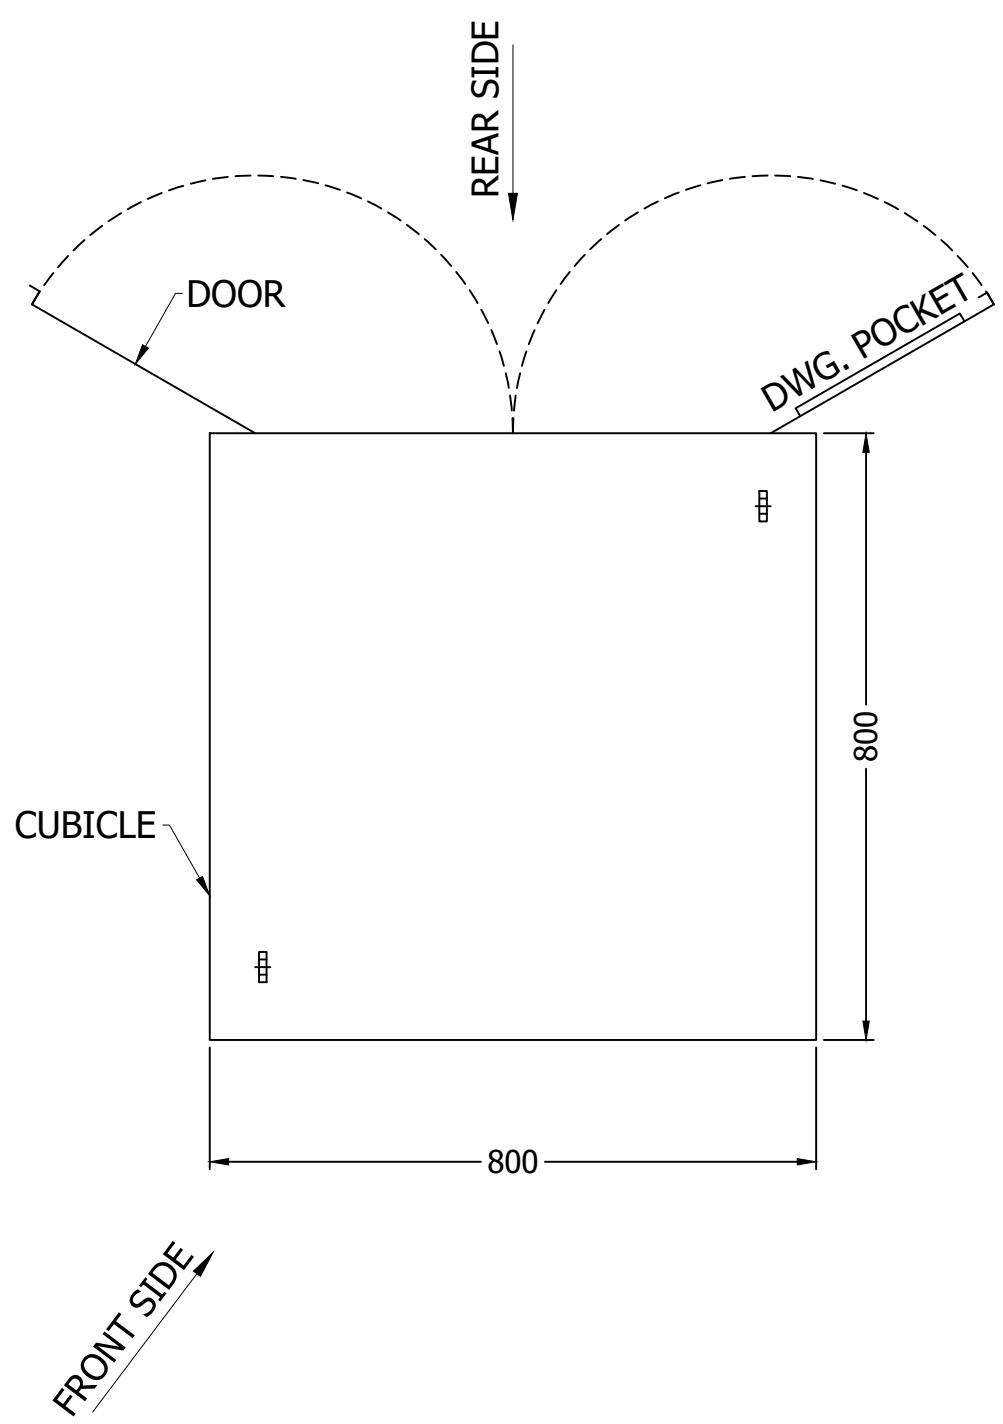
BACK VIEW WITHOUT DOORBACK VIEW WITH DOORTOP VIEWNOTE:-

- PANEL DIMENSION: 800 x 800 x 2200mm (WxDxH)
- COLOR : RAL 7032
- SHEET THICKNESS : 2-2.5 mm
- PROTECTION CLASS : IP-51 (INDOOR TYPE)
- ALL DOOR FITTED WITH 16mm EARTH STRAP & INSULATED WITH GREEN-YELLOW COLOUR.


All information contained in this document is the exclusive property of GE GRID SOLUTIONS and shall not be used, copied or communicated to third parties without its prior authorization.


0	AS BUILT	19-10-2018	ASJ	Manufacturer EPE SOL 71-B Garden Block, New Garden Town, Lahore, Pakistan	Contractor GE Grid Solutions A GE and Alstom joint venture	Client NTDC-WAPDA NATIONAL TRANSMISSION & DISPATCH COMPANY LIMITED (NTDC-WAPDA)	Project 220KV/132KV GIS SUBSTATION GHAZI ROAD, LAHORE	Title 132KV LINE CONTROL PANEL (=E01+CP31) PANEL VIEWS	Drawing no. P60194-E-ELC-SC-002
REV.	DESCRIPTION	DATE	DRAWER						Project no. P-60194

All information contained in this document is the exclusive property of GE GRID SOLUTIONS and shall not be used, copied or communicated to third parties without its prior authorization.

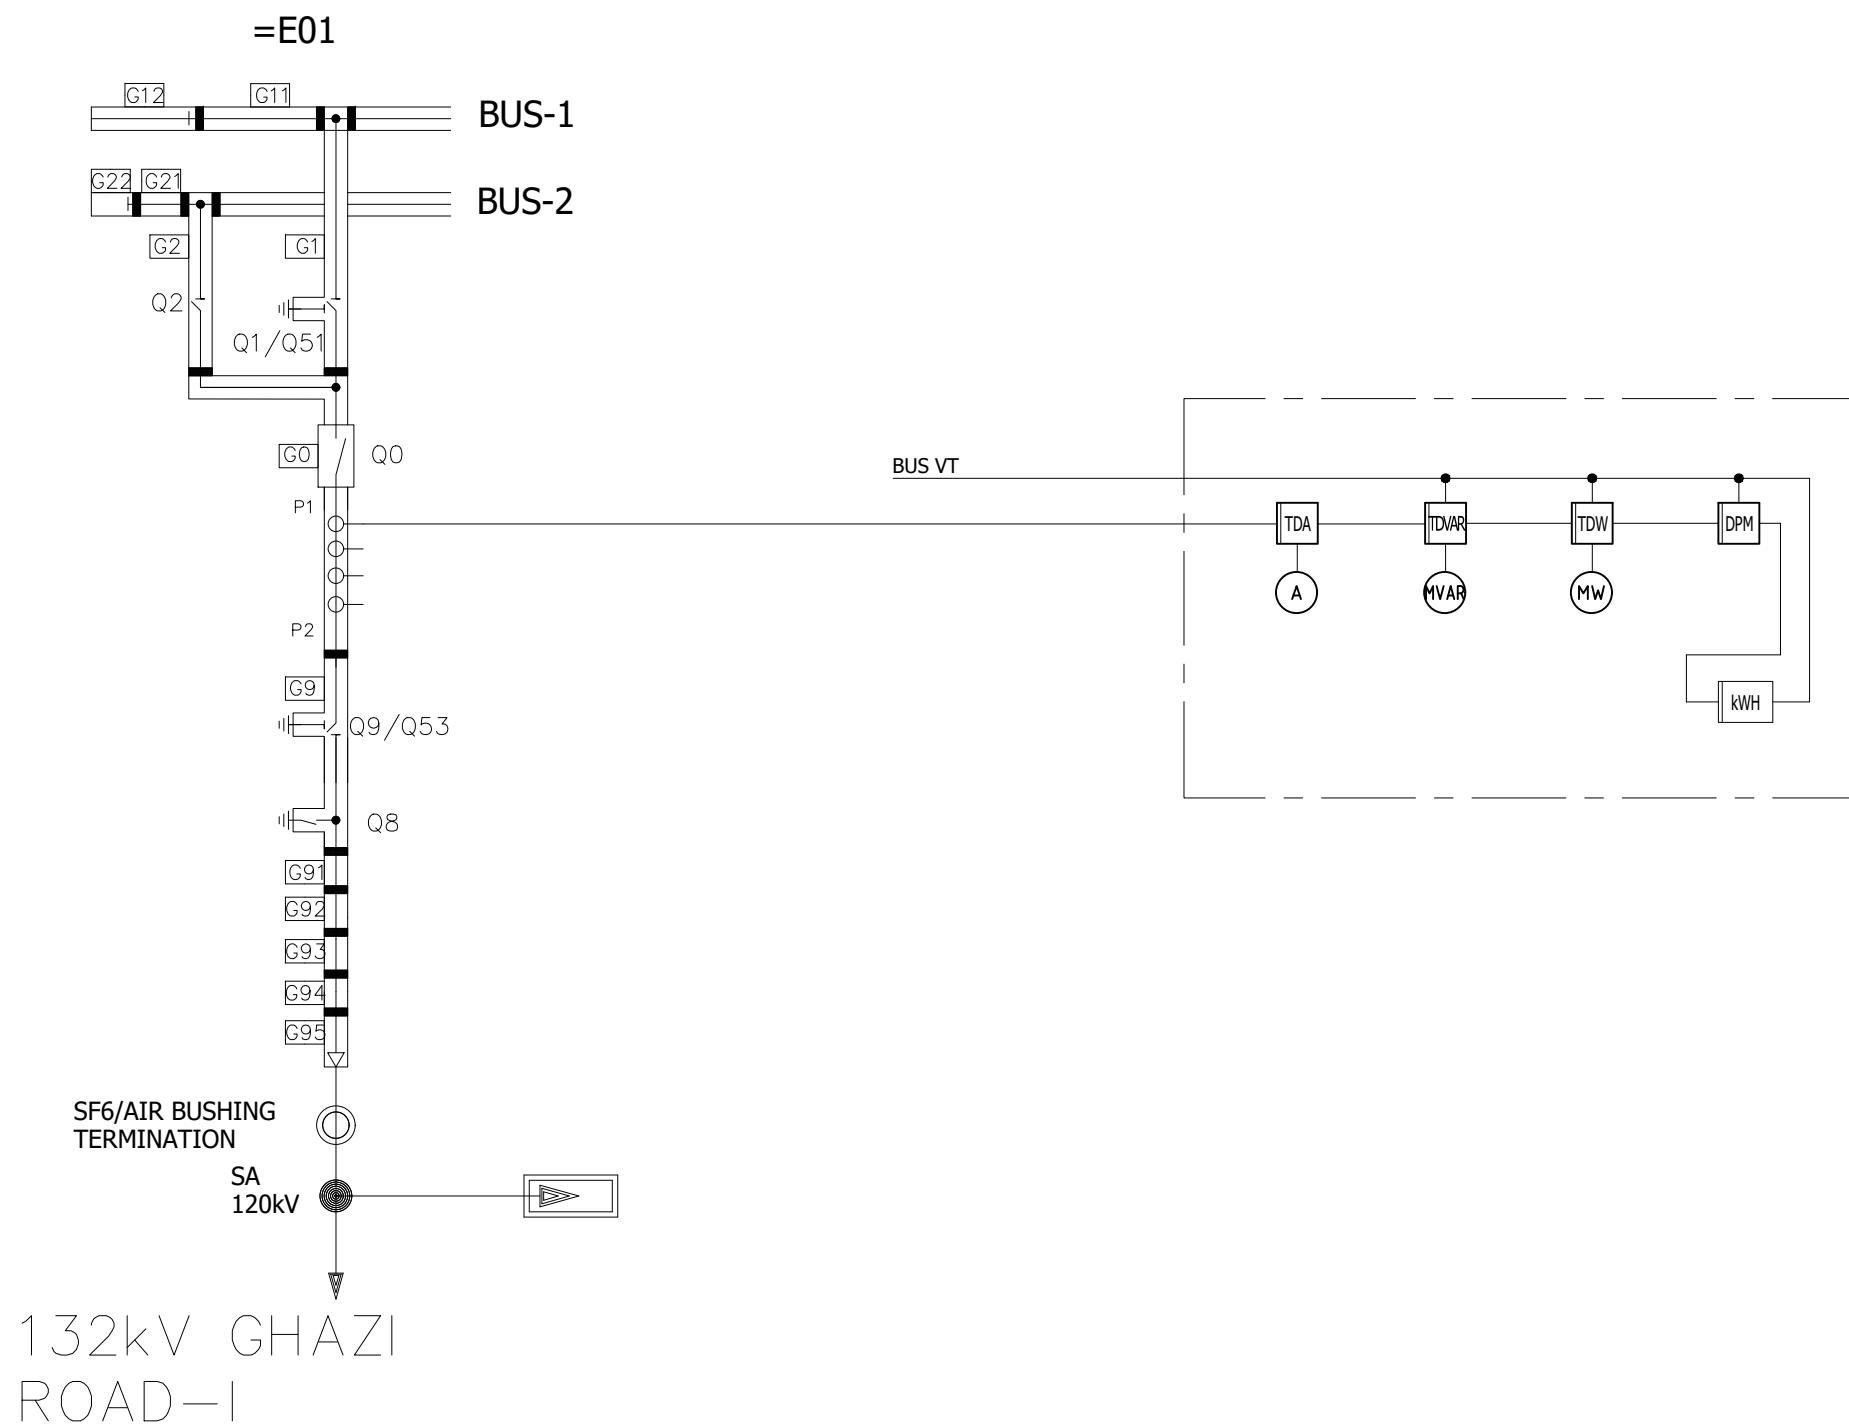

0	AS BUILT	19-10-2018	ASJ	Manufacturer  EPESOL 71-B Garden Block, New Garden Town, Lahore, Pakistan	Contractor  Grid Solutions A GE and Alstom joint venture	Client  NATIONAL TRANSMISSION & DISPATCH COMPANY LIMITED (NTDC-WAPDA)	Project 220kV/132kV GIS SUBSTATION GHAZI ROAD, LAHORE	Title 132kV LINE CONTROL PANEL (=E01+CP31) SINGLE LINE DIAGRAM	Drawing no. P60194-E-ELC-SC-002
REV.	DESCRIPTION	DATE	DRAWER						Project no. P-60194

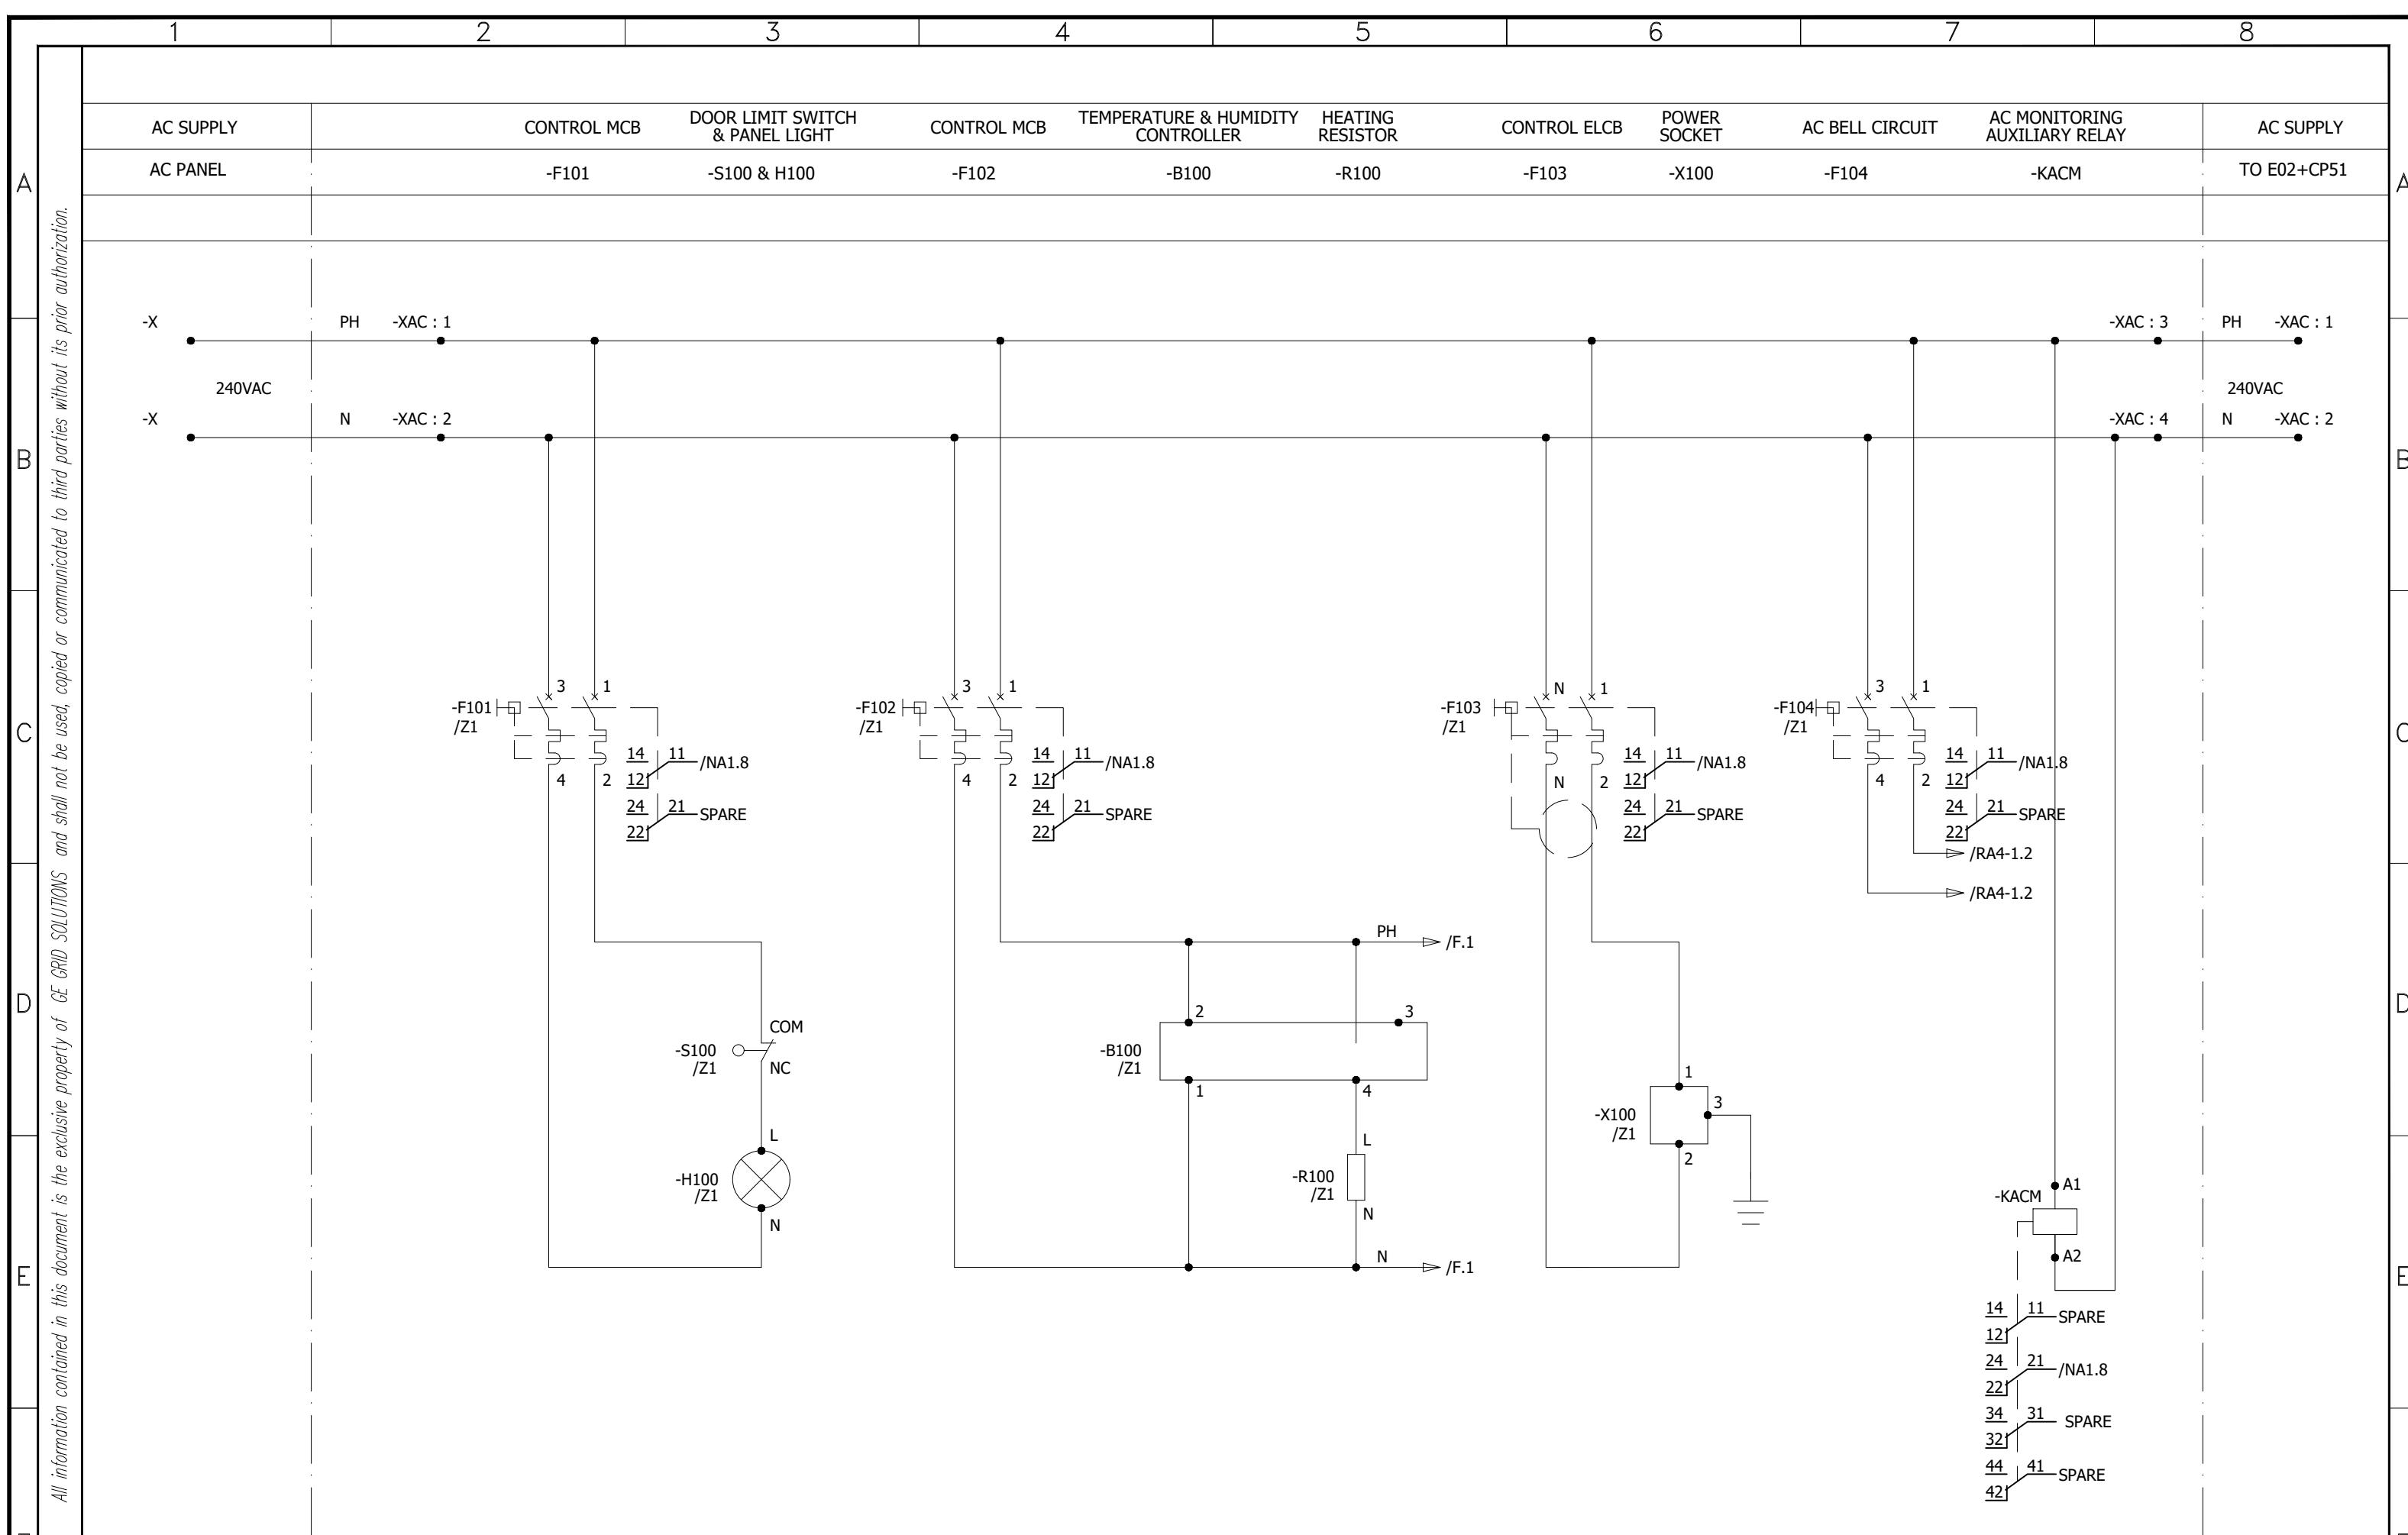

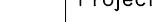0	AS BUILT	19.10.2018	ASJ	Manufacturer  EPESOL 71-B Garden Block, New Garden Town, Lahore, Pakistan	Contractor  Grid Solutions A GE and Alstom joint venture	Client  NATIONAL TRANSMISSION & DISPATCH COMPANY LIMITED (NTDC-WAPDA)	Project 220kV/132kV GIS SUBSTATION GHAZI ROAD, LAHORE	Title 132kV LINE CONTROL PANEL (=E01+CP31) AC SUPPLY DISTRIBUTION CIRCUIT	Drawing no. P60194-E-ELC-SC-001	
REV.	DESCRIPTION	DATE	DRAWER					Project no. P-60194	Sheet type D	Sheet no. 08
1	2	3	4	5	6	7	8			

DC MCB FOR 132KV CB
CONTROL

-F201



DC MCB FOR
INDICATION

-F202


DC HOOTER
CIRCUIT

-F203

All information contained in this document is the exclusive property of GE GRID SOLUTIONS and shall not be used, copied or communicated to third parties without its prior authorization.

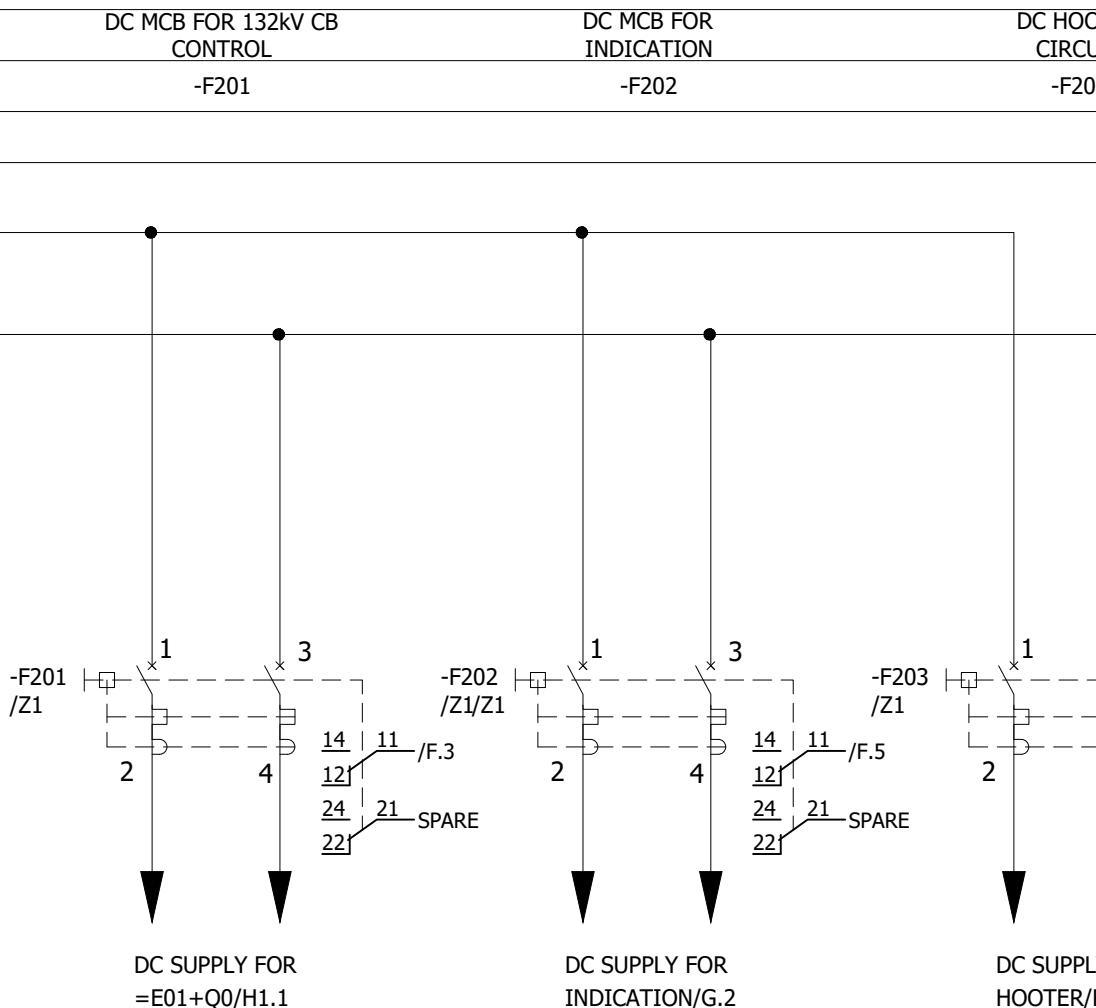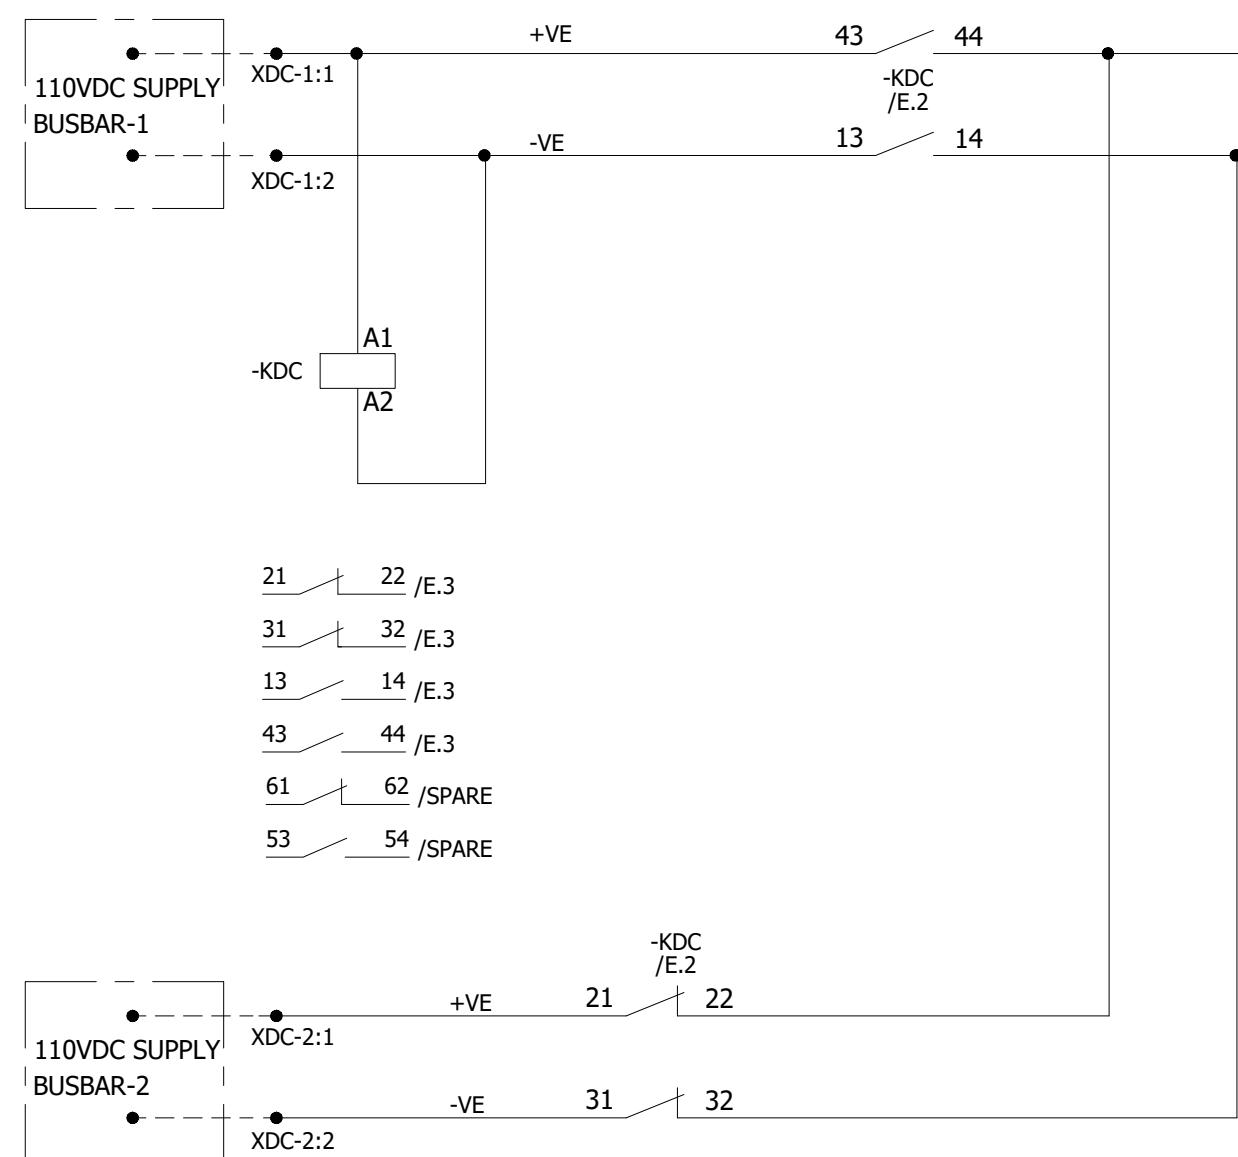

0	AS BUILT	19.10.2018	ASJ	Manufacturer  EPESOL 7-B Garden Block, New Garden Town, Lahore, Pakistan	Contractor  Grid Solutions A GE and Alstom joint venture	Client  NATIONAL TRANSMISSION & DISPATCH COMPANY LIMITED (NTDC-WAPDA)	Project 220KV/132KV GIS SUBSTATION GHAZI ROAD, LAHORE	Title 132KV LINE CONTROL PANEL (=E01+CP31) DC SUPPLY DISTRIBUTION CIRCUIT	Drawing no. P60194-E-ELC-SC-001
REV.	DESCRIPTION	DATE	DRAWER						Project no. P-60194
									Sheet type E
									Sheet no. 09

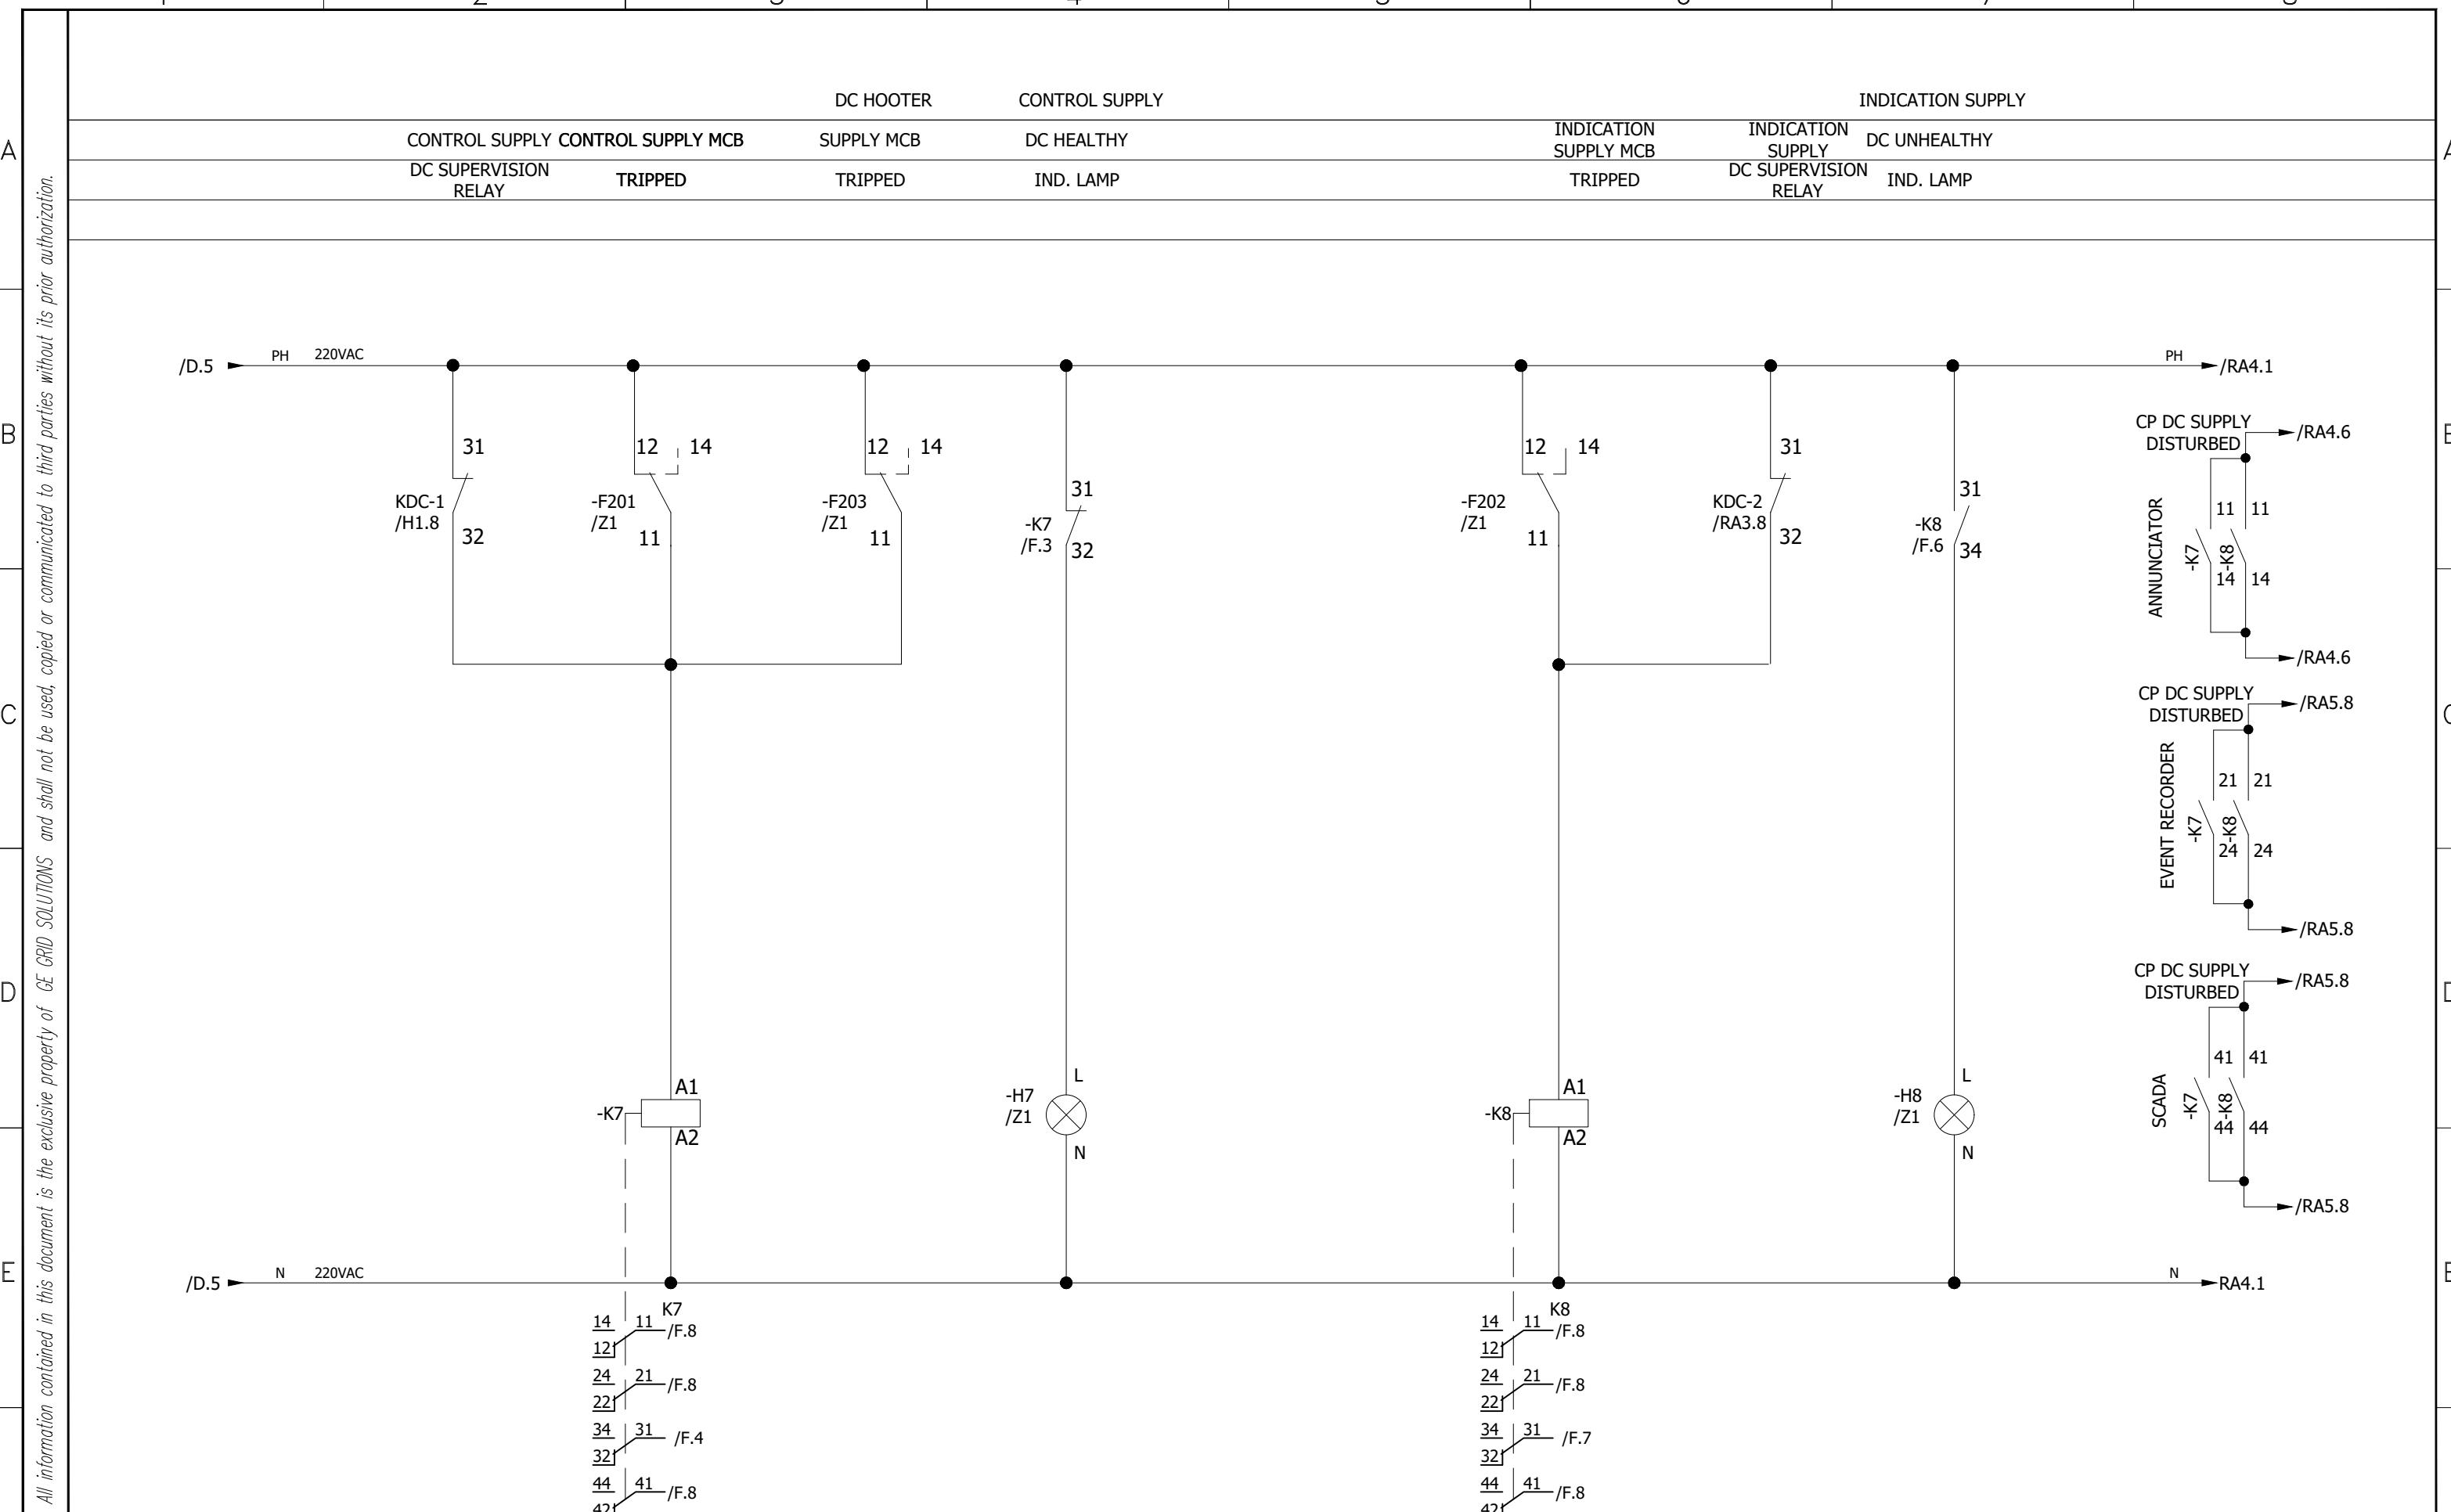

All information contained in this document is the exclusive property of GE GRID SOLUTIONS and shall not be used, copied or communicated to third parties without its prior authorization.

0	AS BUILT	19.10.2018	ASJ	Manufacturer  EPESOL 71-B Garden Block, New Garden Town, Lahore, Pakistan	Contractor  Grid Solutions A GE and Alstom joint venture	Client  NATIONAL TRANSMISSION & DISPATCH COMPANY LIMITED (NTDC-WAPDA)	Project 220kV/132kV GIS SUBSTATION GHAZI ROAD, LAHORE	Title 132kV LINE CONTROL PANEL (=E01+CP31) DC SUPPLY FAILURE ALARM CIRCUIT	Drawing no. P60194-E-ELC-SC-001
REV.	DESCRIPTION	DATE	DRAWER						Project no. P-60194
									Sheet type F
									Sheet no. 10

1 2 3 4 5 6 7 8

TEST BLOCK

AM METERS

MW METER (-Q5)

MVAR METER (-Q6)

DIGITAL POWER METER

REVENUE METER


TS

(-Q1, -Q2, -Q3) WITH
TRANSDUCERS
(-U1, , -U2, -U3)

WITH TRANSDUCER (-U5)

(-Q7)

(-P11)

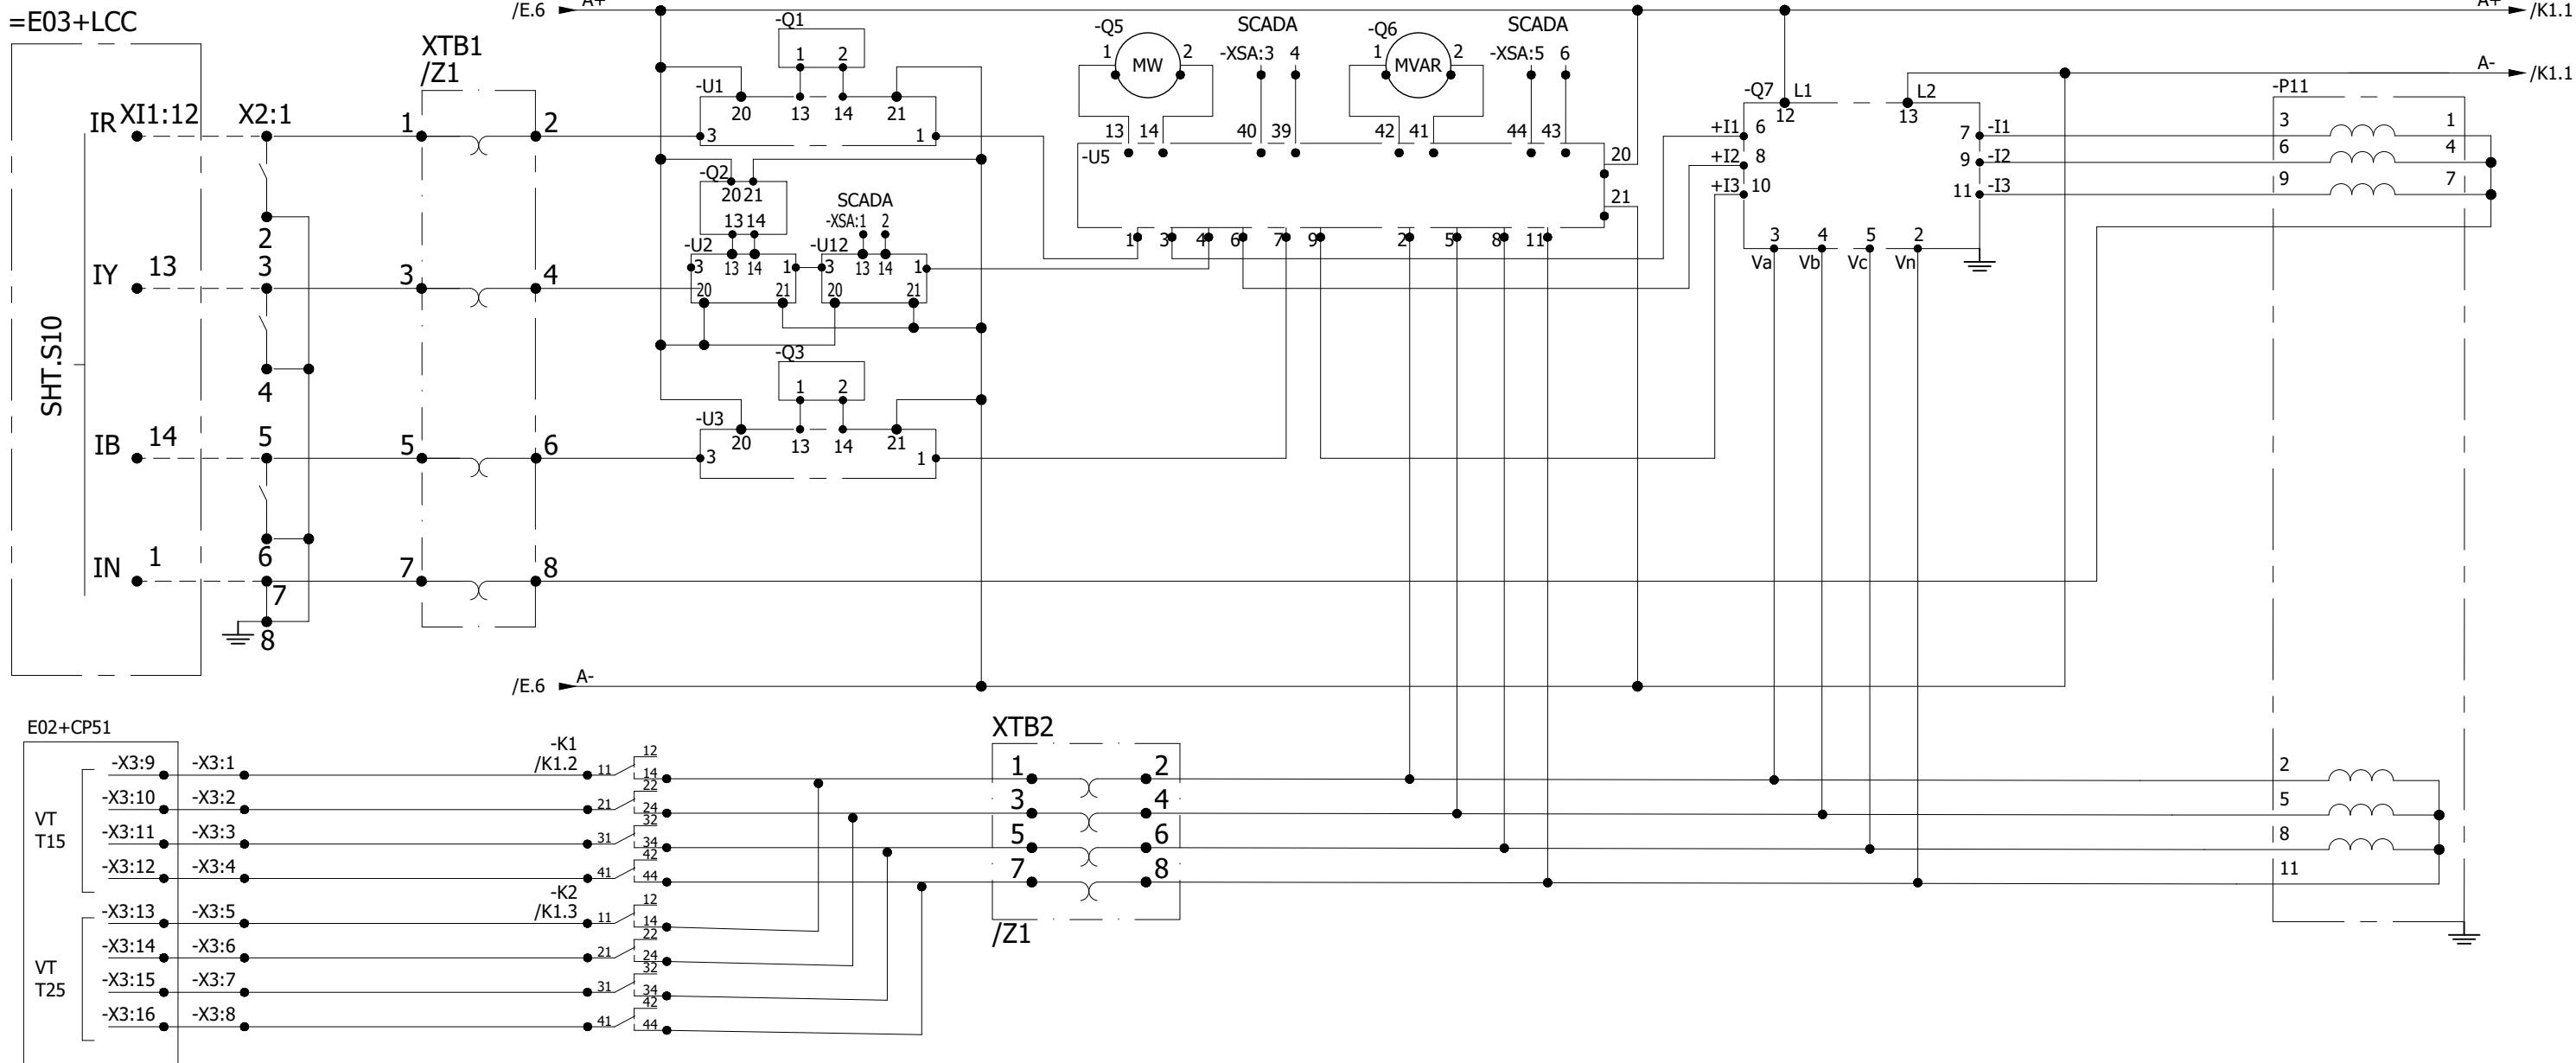

All information contained in this document is the exclusive property of GE GRID SOLUTIONS and shall not be used, copied or communicated to third parties without its prior authorization.

0	AS BUILT	19-10-2018	ASJ	Manufacturer	Contractor	Client	Project	Title	Drawing no.		
				EPE SOL 71-B Garden Block, New Garden Town, Lahore, Pakistan	Grid Solutions A GE and Alstom joint venture	NATIONAL TRANSMISSION & DISPATCH COMPANY LIMITED (NTDC-WAPDA)	220KV/132KV GIS SUBSTATION GHAZI ROAD, LAHORE	132KV LINE CONTROL PANEL (-E01+CP31) METERING	P60194-E-ELC-SC-002		
REV.	DESCRIPTION	DATE	DRAWER						Project no. P-60194	Sheet type G	Sheet no. 11

1 2 3 4 5 6 7 8

1 2 3 4 5 6 7 8

C O N T R O L R O O M


DC SUPERVISION
RELAYSCADA
CONTROL

OPEN KDC-1 CLOSE OPEN

CLOSE

All information contained in this document is the exclusive property of GE GRID SOLUTIONS and shall not be used, copied or communicated to third parties without its prior authorization.

A

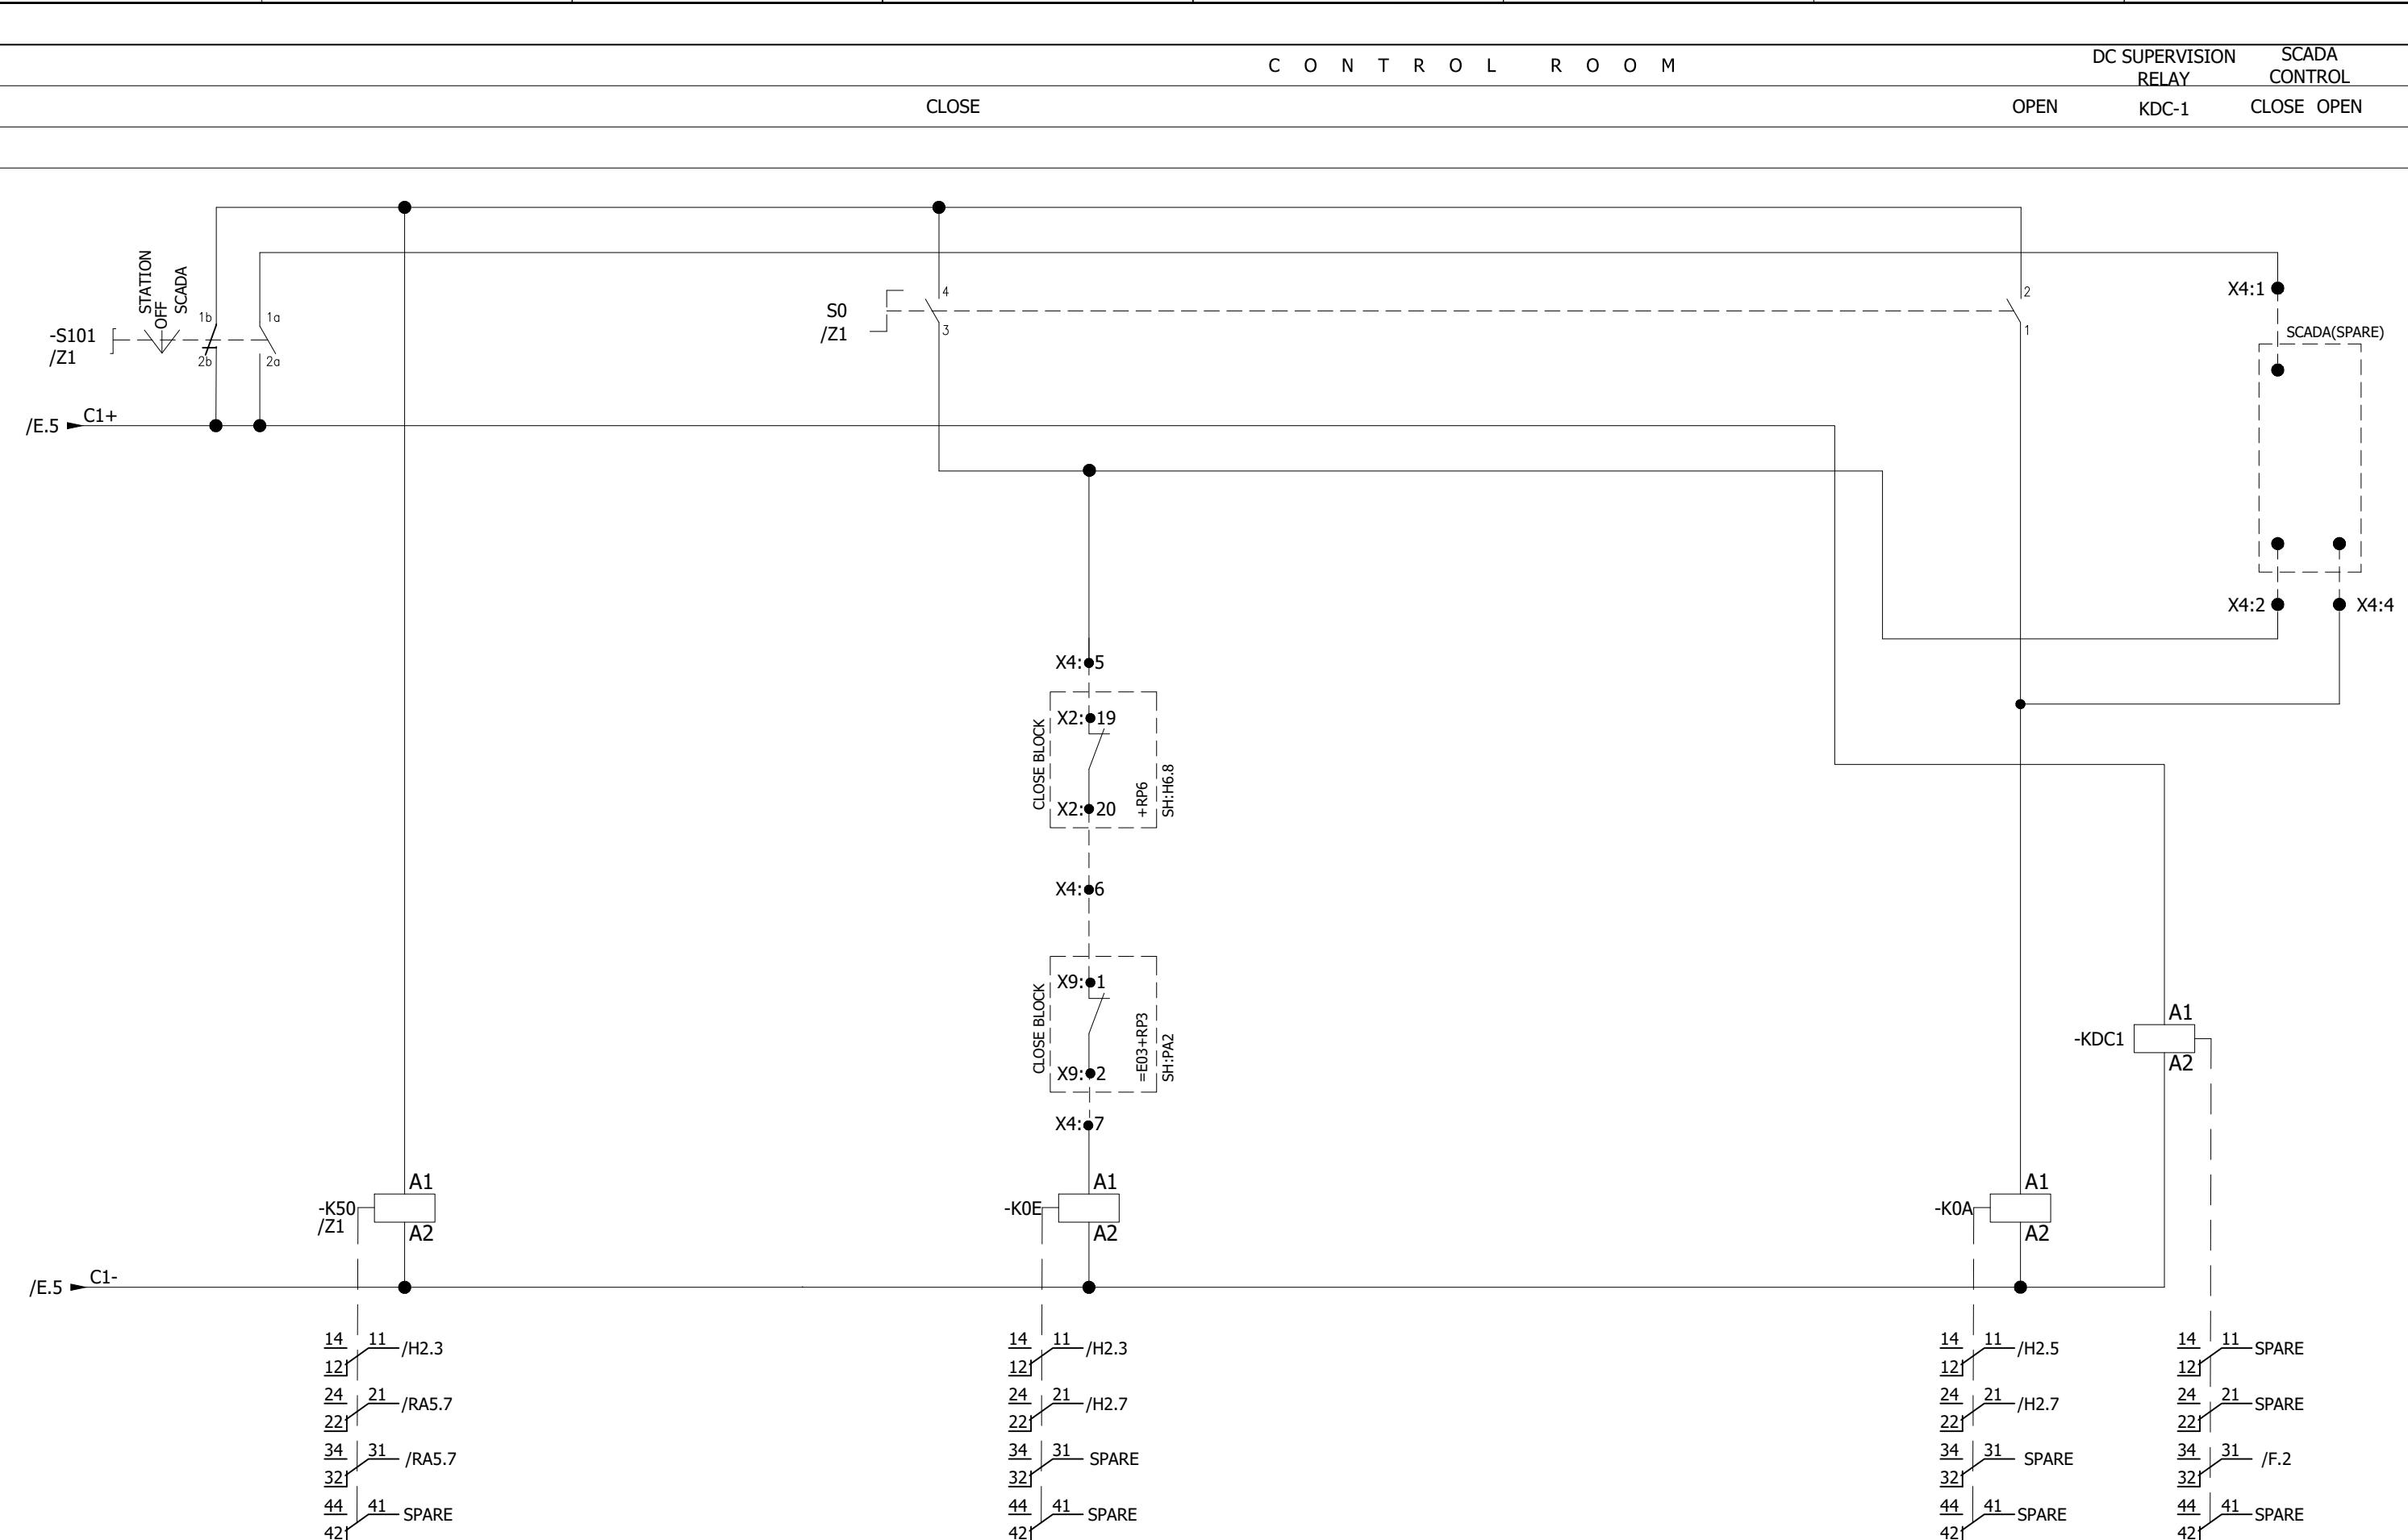

0	AS BUILT	19-10-2018	ASJ	Manufacturer  EPESOL 7-B Garden Block, New Garden Town, Lahore, Pakistan	Contractor  Grid Solutions A GE and Alstom joint venture	Client  NATIONAL TRANSMISSION & DISPATCH COMPANY LIMITED (NTDC-WAPDA)	Project 220kV/132kV GIS SUBSTATION GHAZI ROAD, LAHORE	Title 132kV LINE CONTROL PANEL (=E01+CP31) CB CONTROL CIRCUIT	Drawing no. P60194-E-ELC-SC-002
REV.	DESCRIPTION	DATE	DRAWER						Project no. P-60194
									Sheet type H1
									Sheet no. 12



C O N T R O L R O O M C O N T R O L

AUTORECLOSE(SPARE)

CLOSE

OPEN

All information contained in this document is the exclusive property of GE GRID SOLUTIONS and shall not be used, copied or communicated to third parties without its prior authorization.

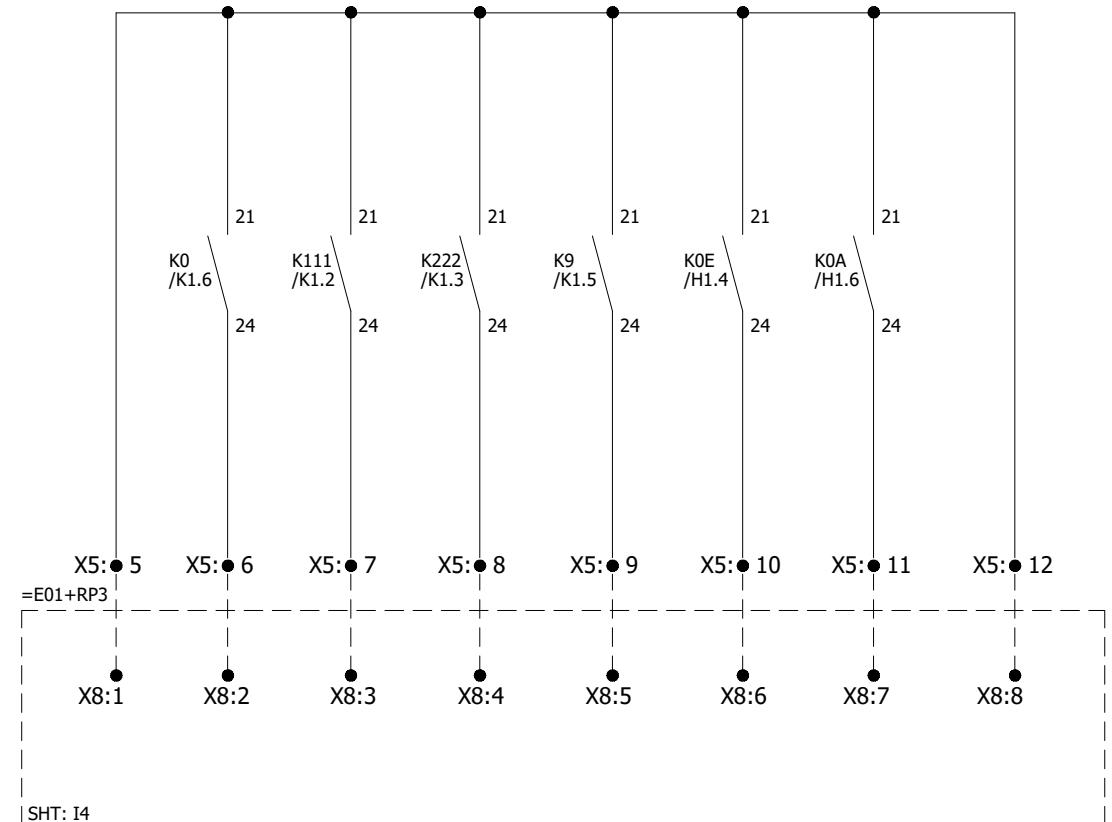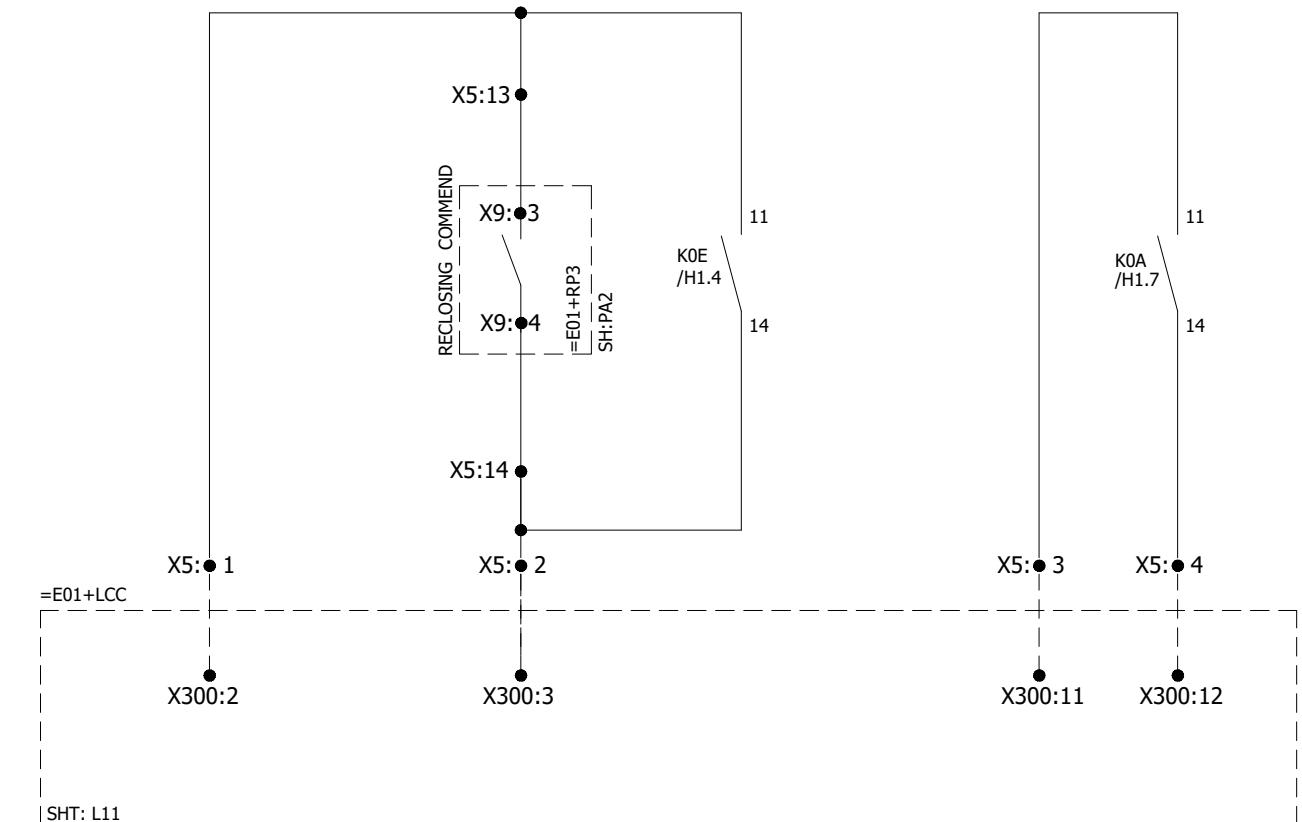

CB CLOSE STATUS

Q1 CLOSE STATUS


Q2 CLOSE STATUS

Q9 CLOSE STATUS

MANUAL CLOSE INPUT FOR
DISTANCE RELAY


MANUAL OPEN INPUT FOR
DISTANCE RELAY

0	AS BUILT	19-10-2018	ASJ	Manufacturer  EPESOL 7-B Garden Block, New Garden Town, Lahore, Pakistan	Contractor  Grid Solutions A GE and Alstom joint venture	Client  NATIONAL TRANSMISSION & DISPATCH COMPANY LIMITED (NTDC-WAPDA)	Project 220kV/132kV GIS SUBSTATION GHAZI ROAD, LAHORE	Title 132kV LINE CONTROL PANEL (=E01+CP31) CB CONTROL CIRCUIT	Drawing no. P60194-E-ELC-SC-002
REV.	DESCRIPTION	DATE	DRAWER						Project no. P-60194
									Sheet type H2
									Sheet no. 13

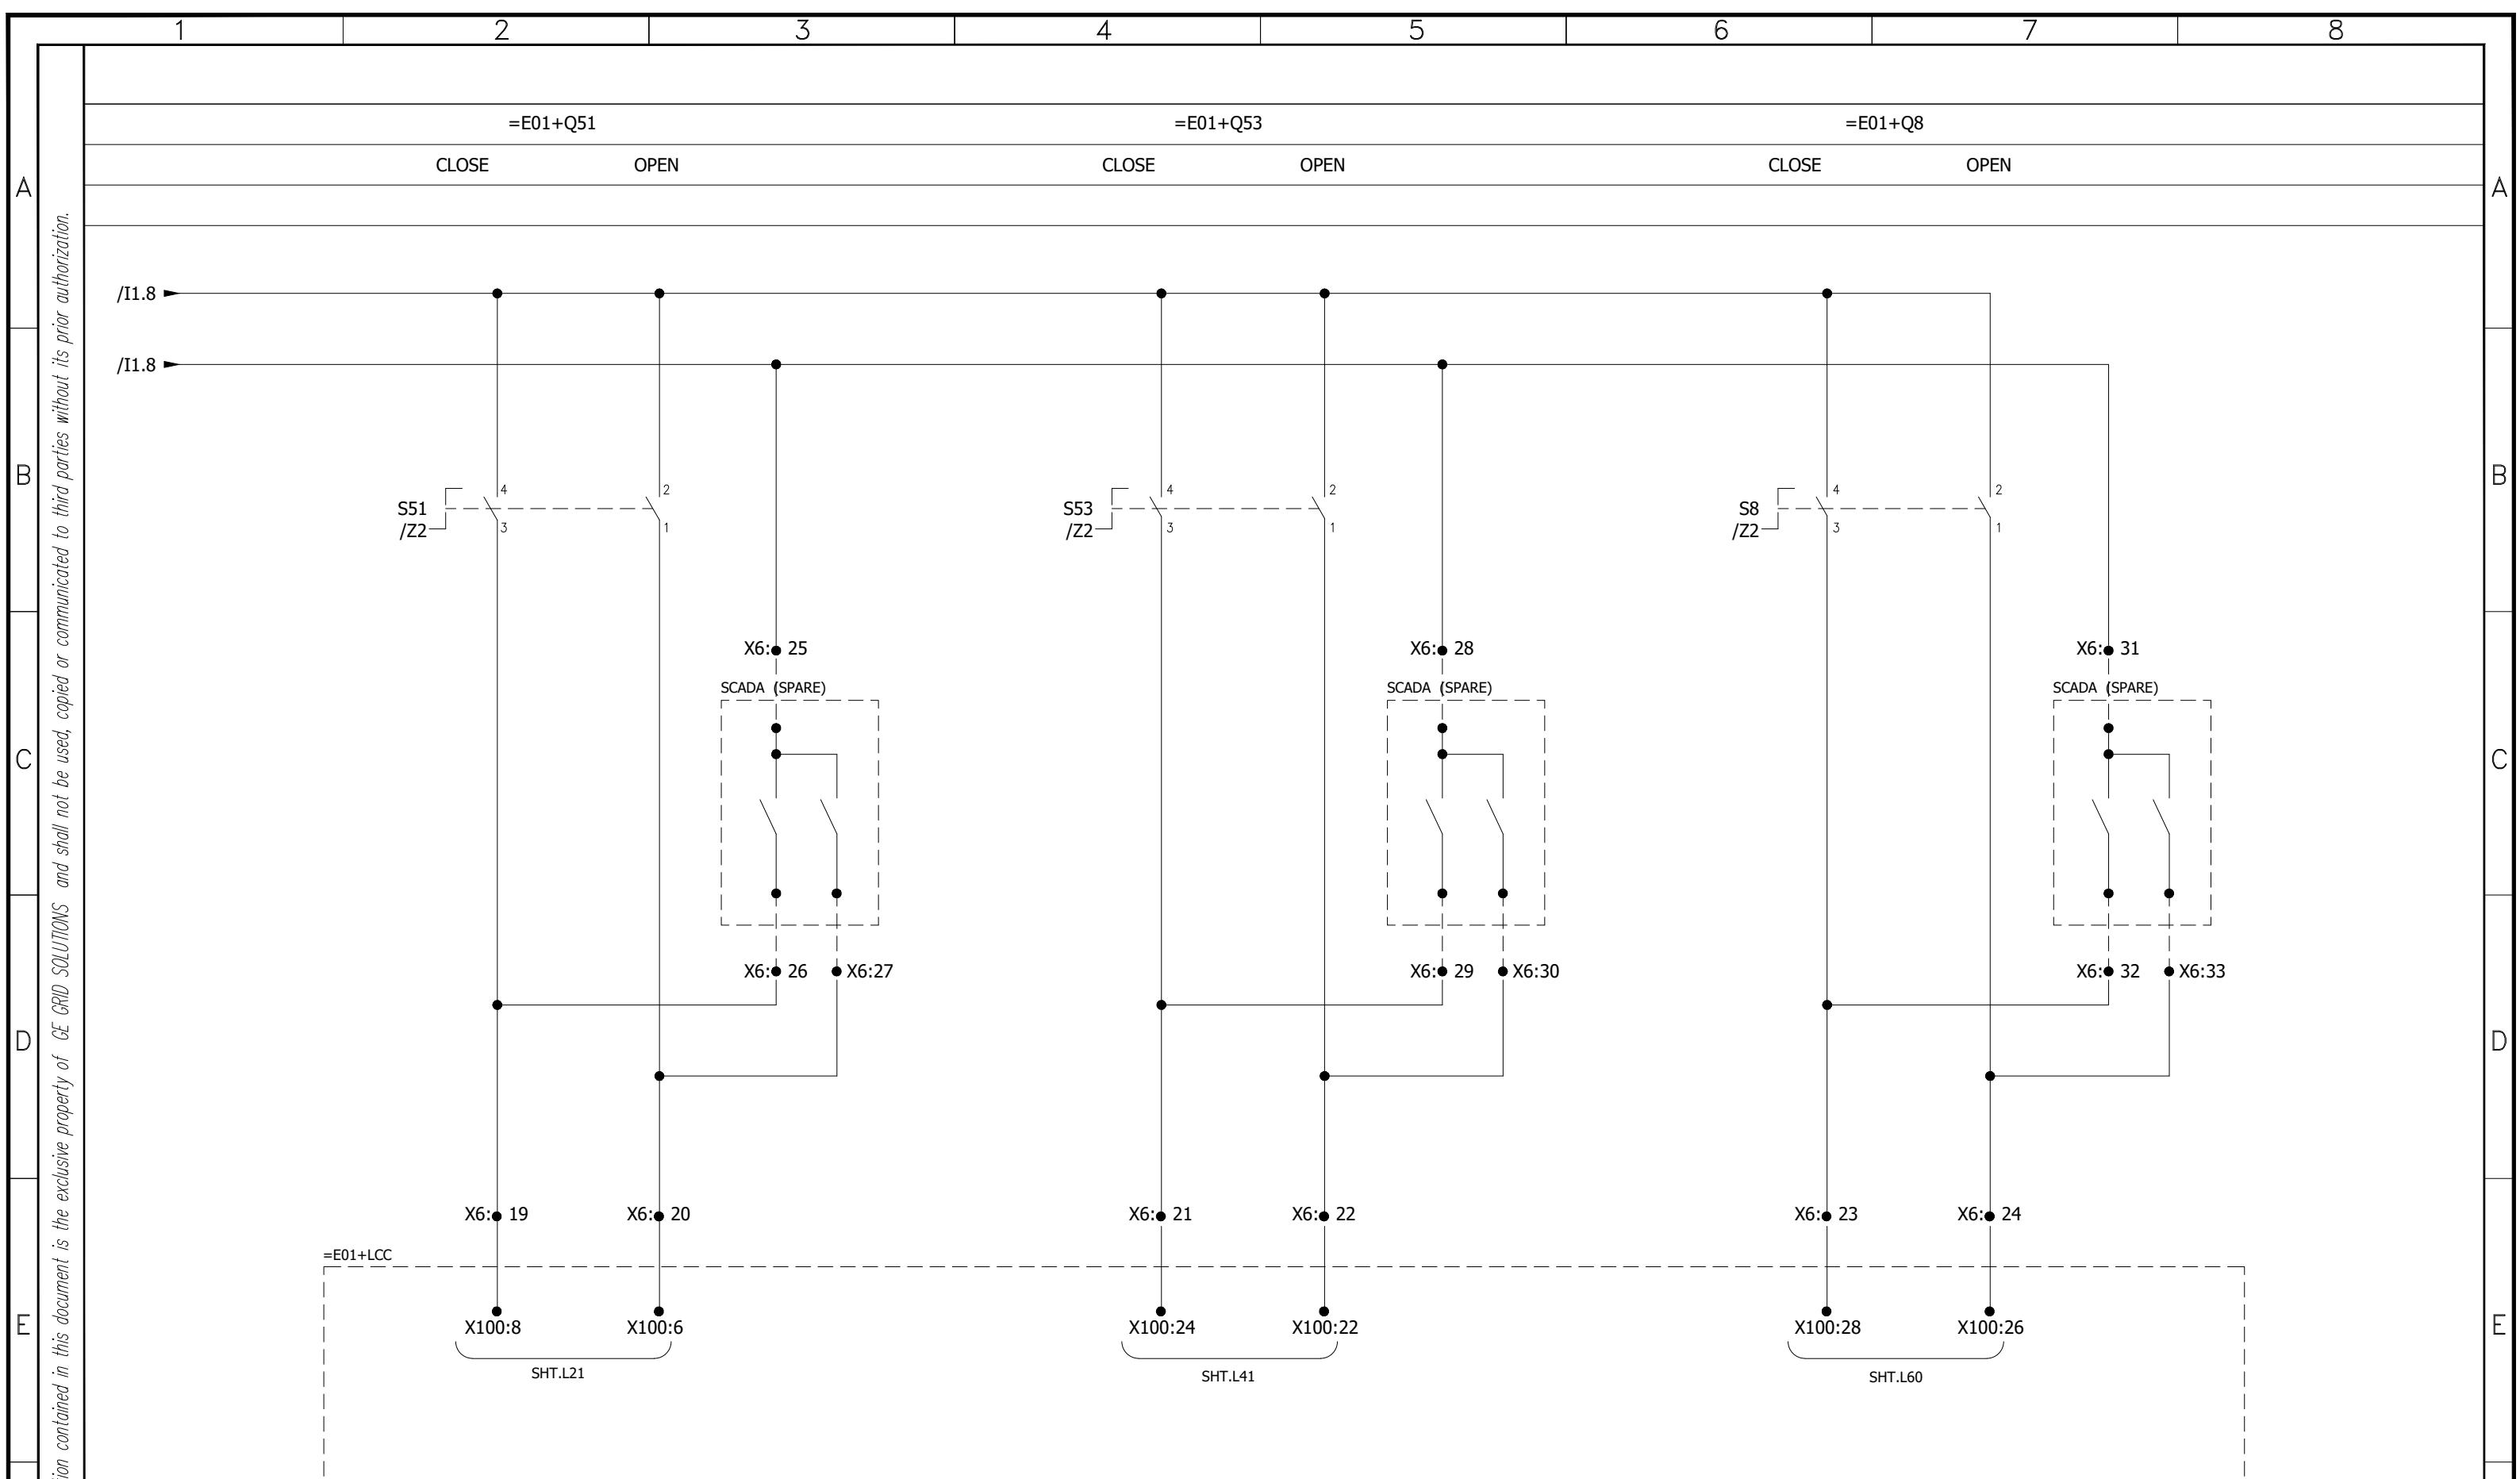



0	AS BUILT	19-10-2018	ASJ	Manufacturer EPESOL 71-B Garden Block, New Garden Town, Lahore, Pakistan	Contractor GE Grid Solutions A GE and Alstom joint venture	Client NATIONAL TRANSMISSION & DISPATCH COMPANY LIMITED (NTDC-WAPDA)	Project 220kV/132kV GIS SUBSTATION GHAZI ROAD, LAHORE	Title 132kV LINE CONTROL PANEL (=E01+CP31) DISCONNECTOR & EARTH SWITCH CONTROL	Drawing no. P60194-E-ELC-SC-002
REV.	DESCRIPTION	DATE	DRAWER						Project no. P-60194
									Sheet type I2
									Sheet no. 15

All information contained in this document is the exclusive property of GE GRID SOLUTIONS and shall not be used, copied or communicated to third parties without its prior authorization.

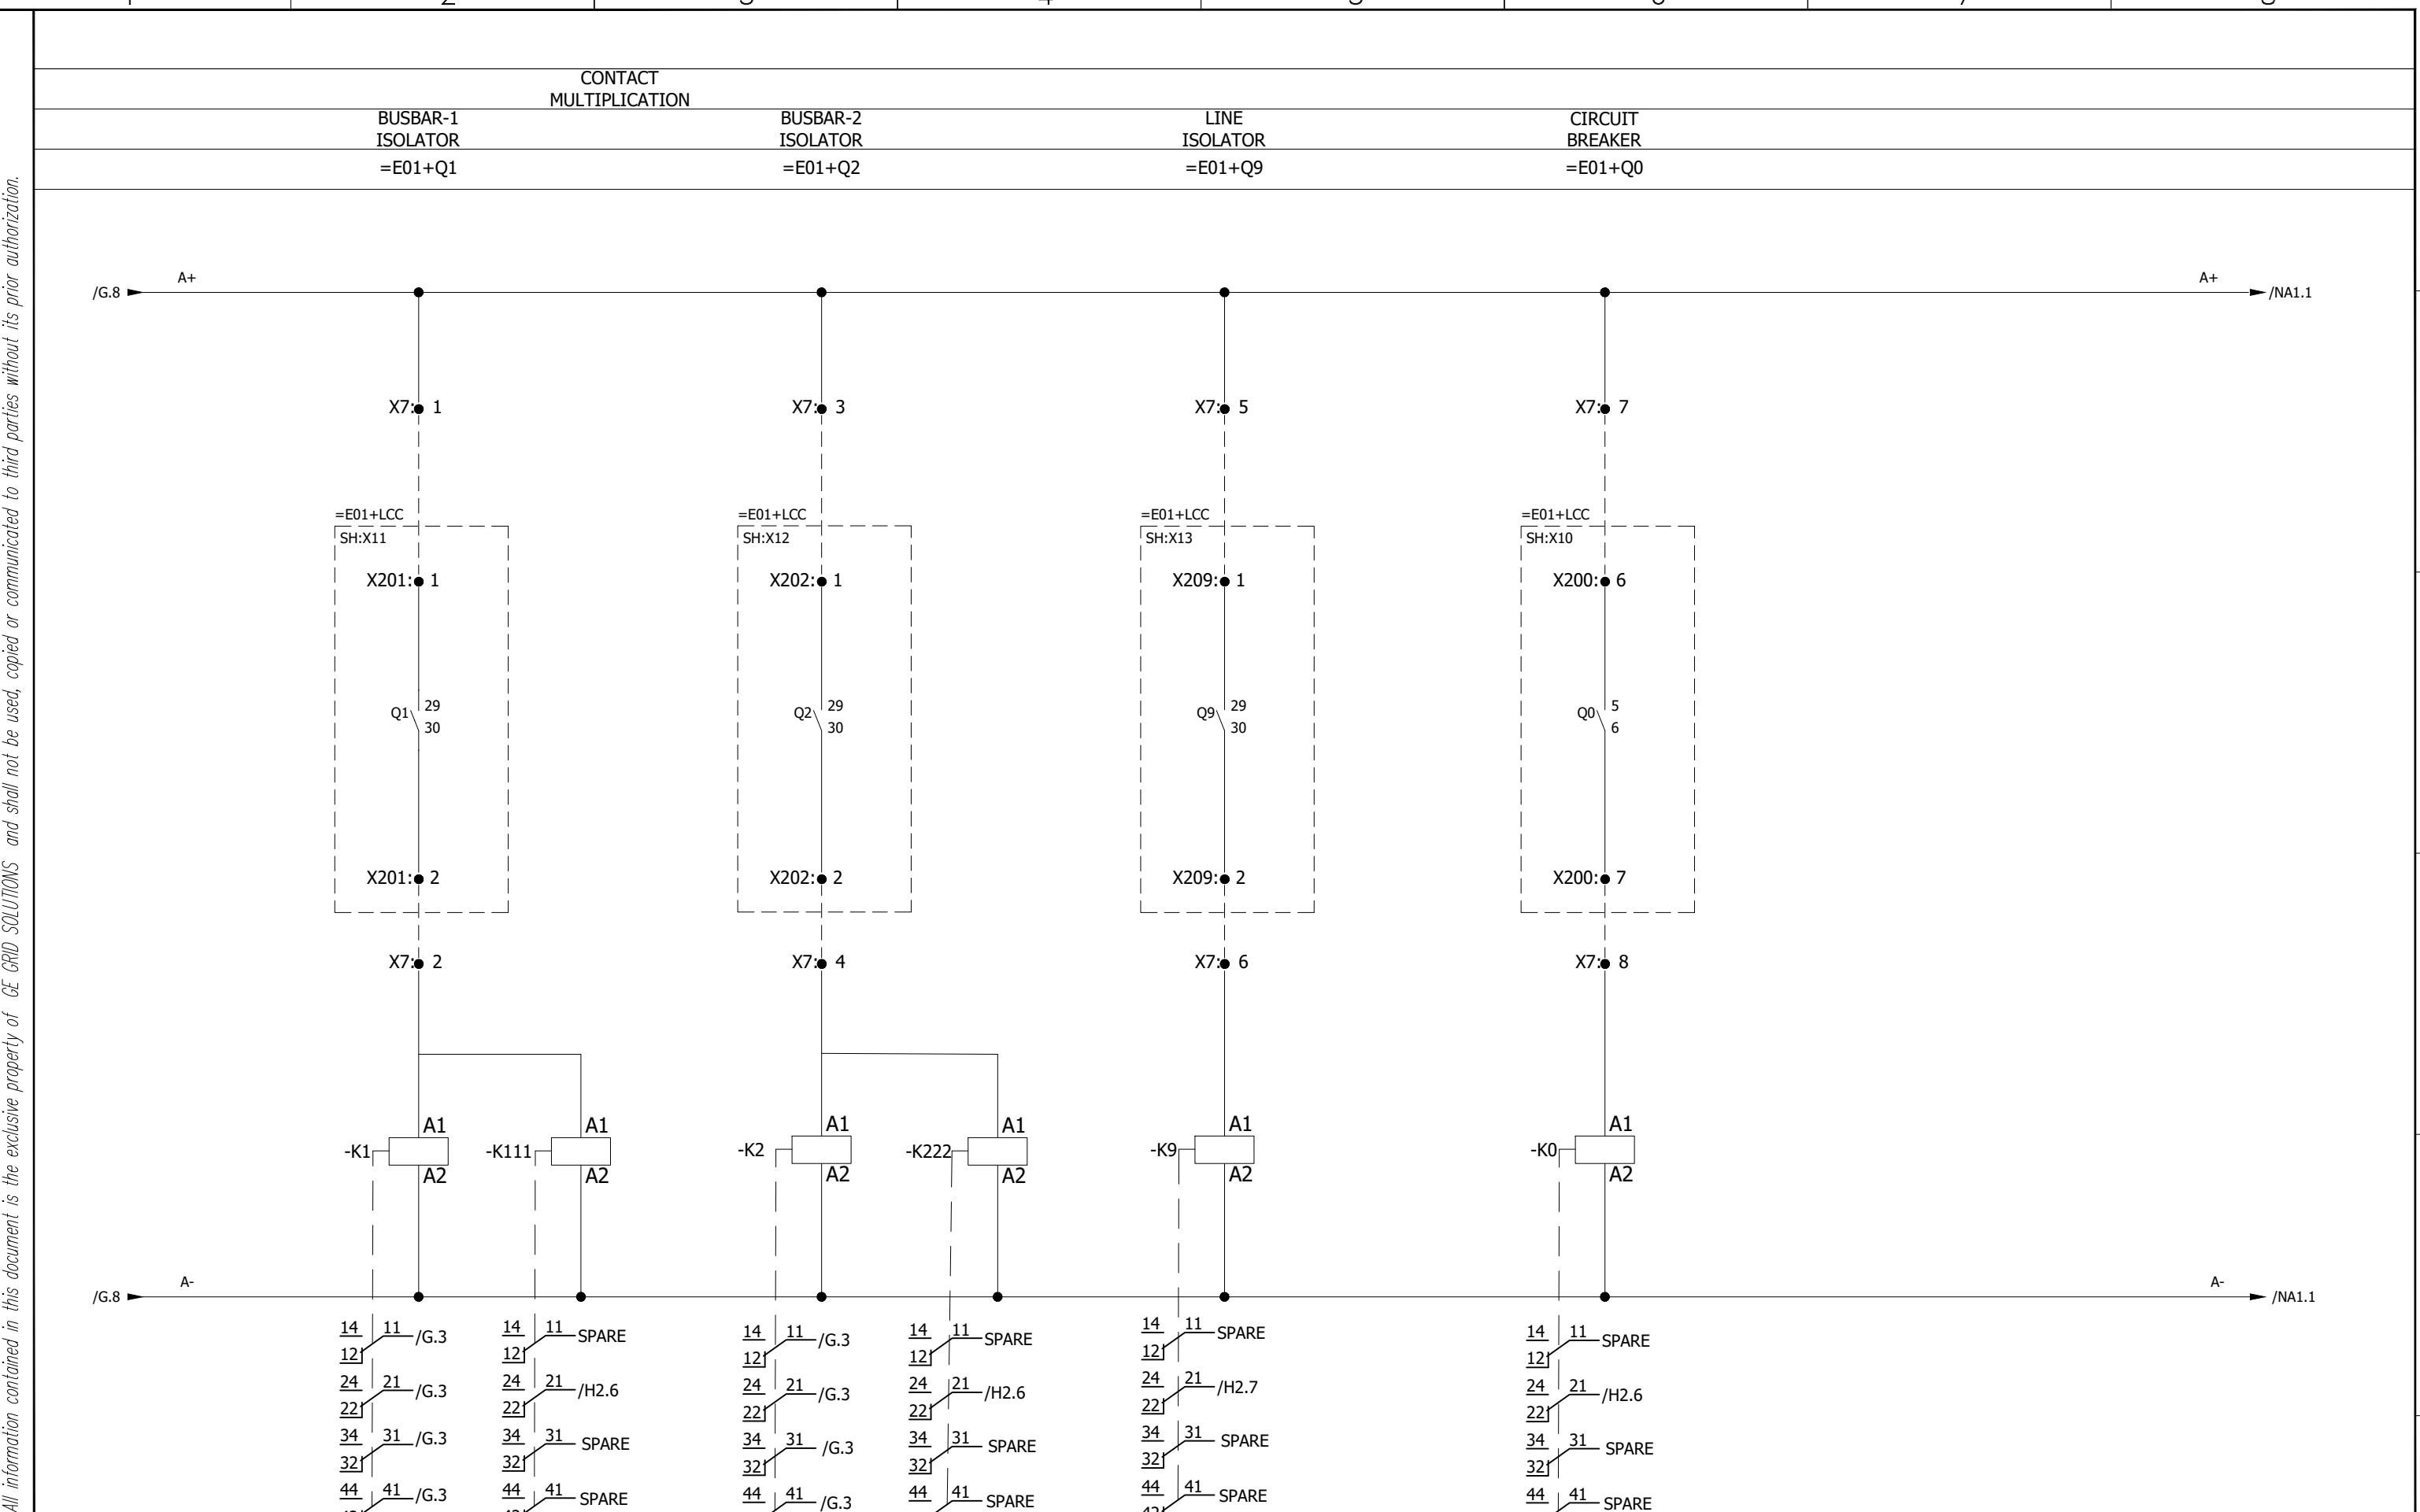


0	AS BUILT	19-10-2018	ASJ	Manufacturer	Contractor	Client	Project	Title	Drawing no.
REV.	DESCRIPTION	DATE	DRAWER	EPE SOL 71-B Garden Block, New Garden Town, Lahore, Pakistan	Grid Solutions A GE and Alstom joint venture	NATIONAL TRANSMISSION & DISPATCH COMPANY LIMITED (NTDC-WAPDA)	220kV/132kV GIS SUBSTATION GHAZI ROAD, LAHORE	132kV LINE CONTROL PANEL (=E01+CP31) CB/DISCONNECTOR CONTACT MULTIPLICATION	P60194-E-ELC-SC-002
									Project no. P-60194 Sheet type K1 Sheet no. 16

1	2	3	4	5	6	7	8
A	CONTACT MULTIPLICATION	POSITION	LONG SPRING CHARGING TIME	CONTROL SUPPLY MCB TRIPPED	GAS MONITOR MCB TRIPPED	CB TRIPPING 1 MCB TRIPPED	LIGHTING AC SUPPLY MCB TRIPPED
G21 ALARM 1	G11 ALARM 1	G1 LEVEL 1	G0 ALARM REPEAT ABNORMAL	DS/ES/HES OPERATION TIME ABNORMAL	SPRING DISCHARGED	DS/ES/HES MOTOR SUPPLY MCB TRIPPED	CB MOTOR THERMAL OVERLOAD
G22 LEVEL 1	G12 ALARM 1	G2 LEVEL 1	G0 LOCK		ALARM SUPPLY MCB TRIPPED	CB CLOSING MCB TRIPPED	CB TRIPPING 2 MCB TRIPPED
						CB MOTOR SUPPLY MCB TRIPPED	HEATING AC SUPPLY MCB TRIPPED
							IL SUPPLY MCB TRIPPED
							PANEL'S AC SUPPLY FAIL

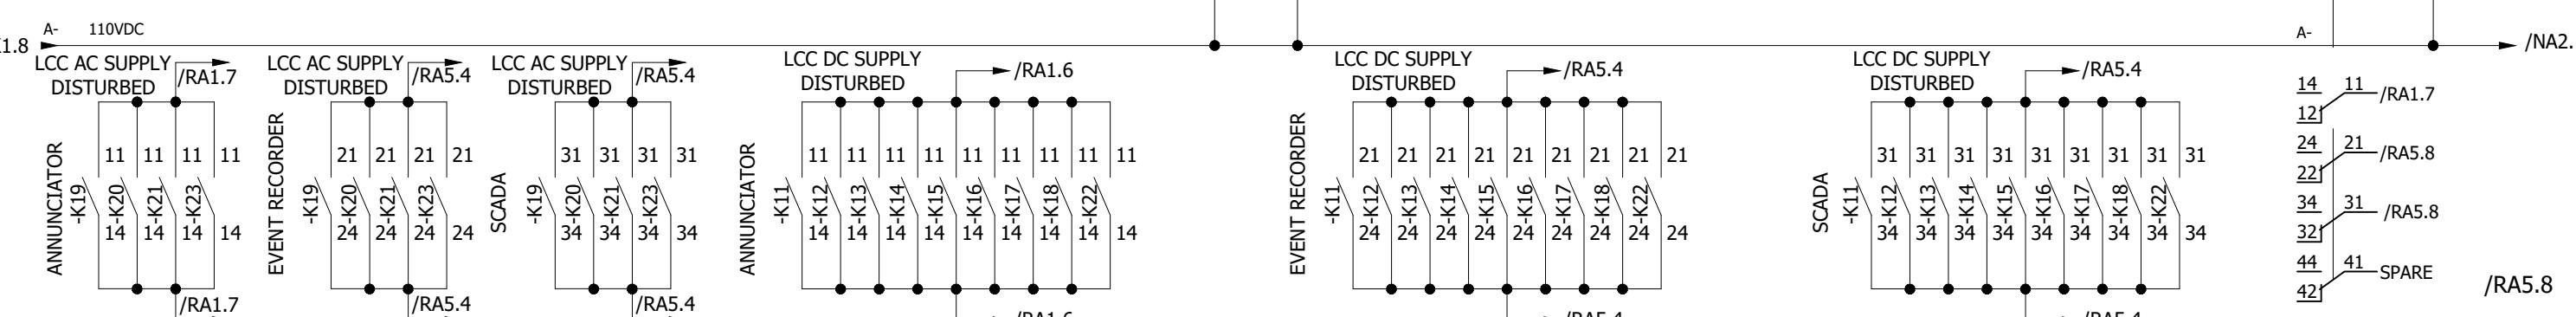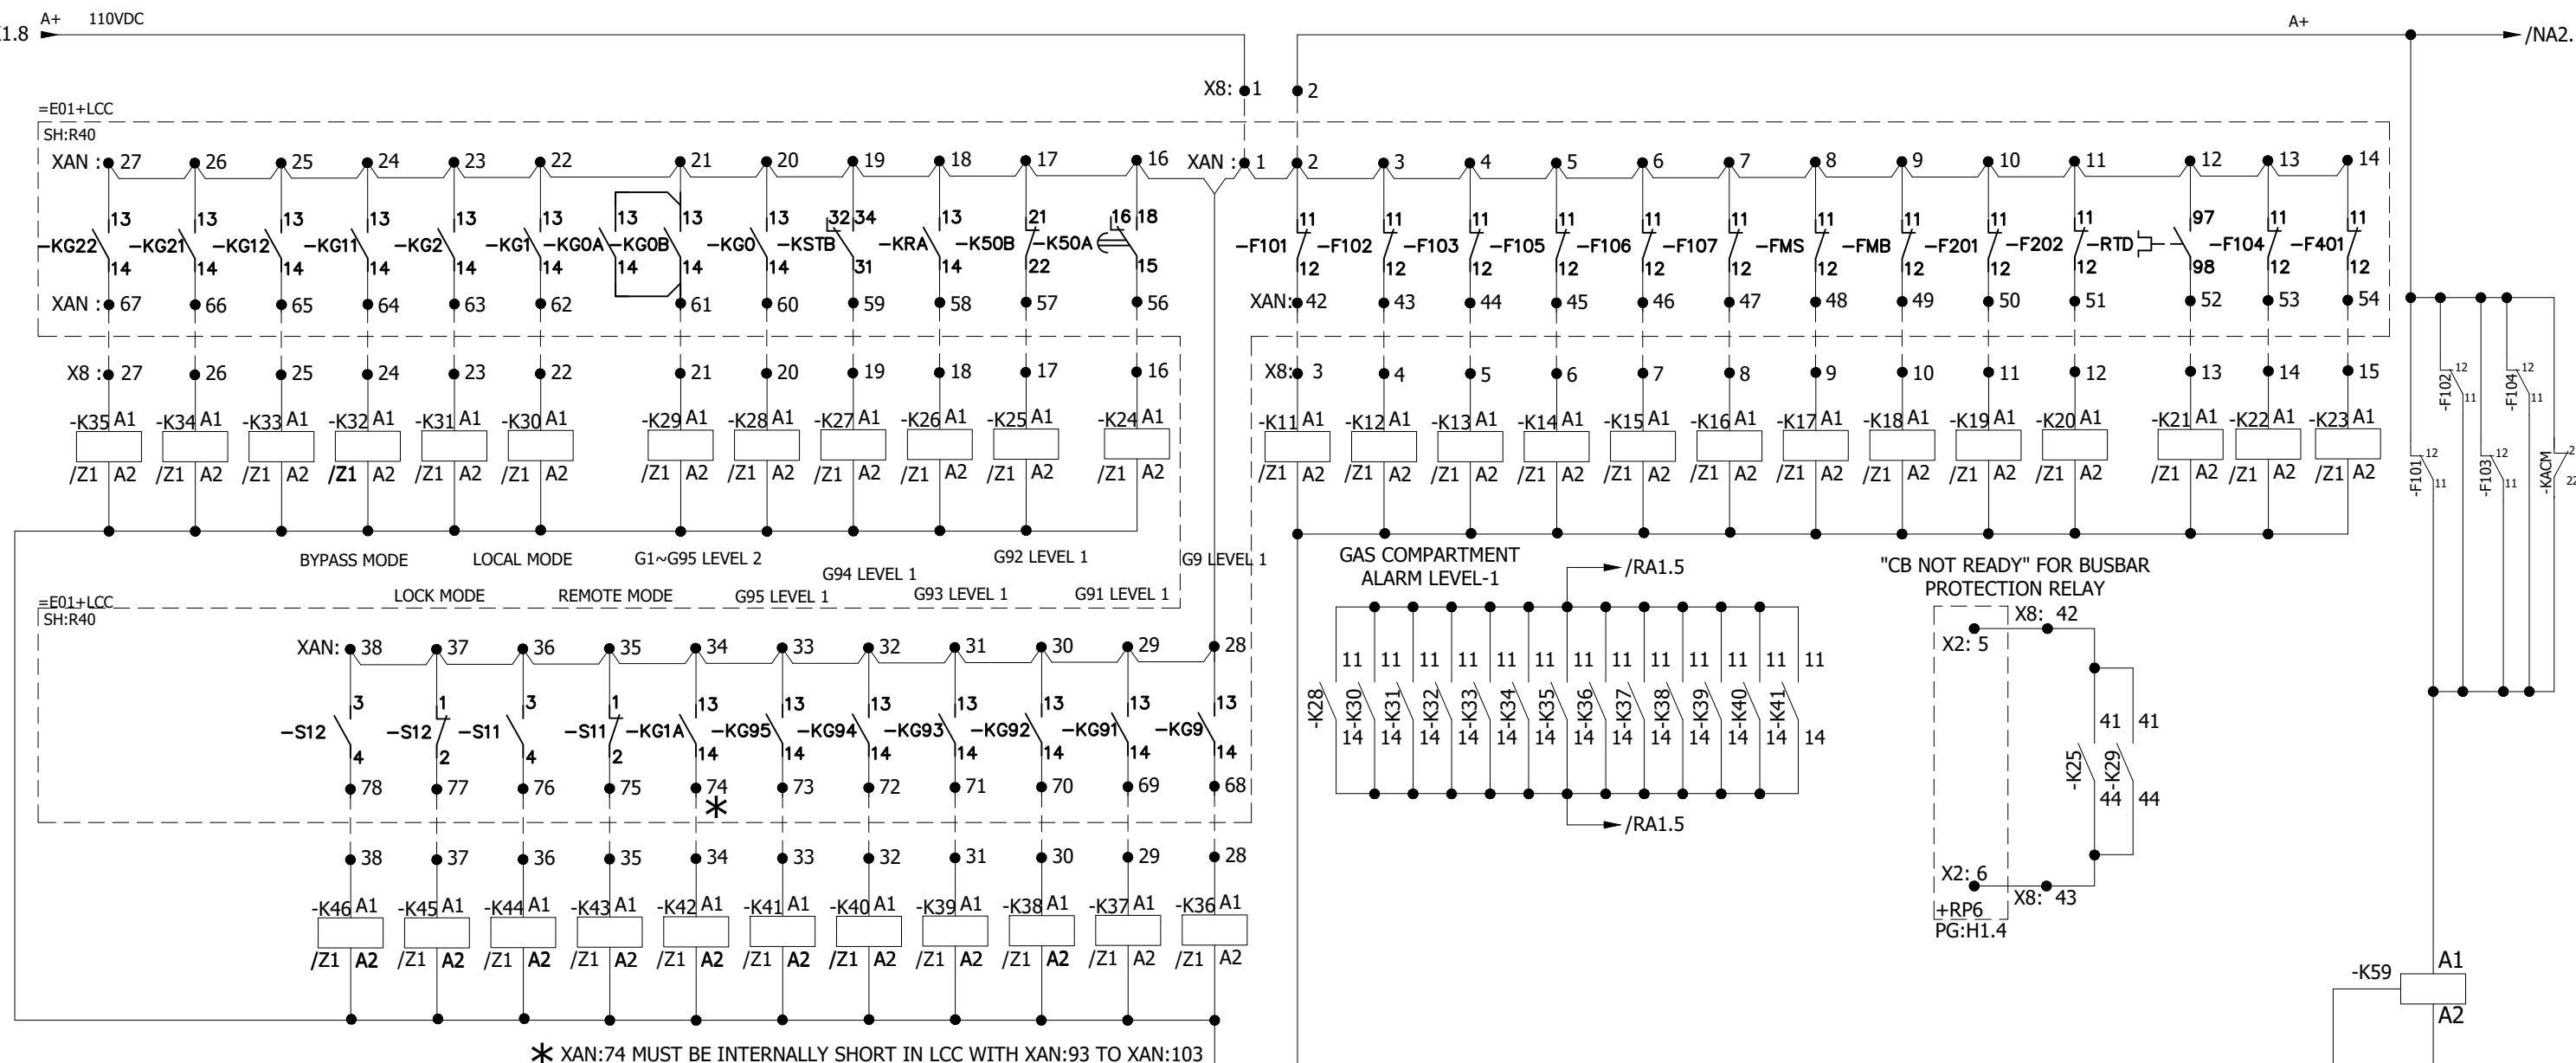

0	AS BUILT	19-10-2018	ASJ	Manufacturer	Contractor	Client	Project	Title	Drawing no.
				EPEPSOL 71-B Garden Block, New Garden Town, Lahore, Pakistan	Grid Solutions A GE and Alstom joint venture	NATIONAL TRANSMISSION & DISPATCH COMPANY LIMITED (NTDC-WAPDA)	220KV/132KV GIS SUBSTATION GHAZI ROAD, LAHORE	132KV LINE CONTROL PANEL (=E01+CP31) ALARM MULTIPLICATION	P-60194-E-ELC-SC-001
REV.	DESCRIPTION	DATE	DRAWER						Project no. P-60194 Sheet type NA1 Sheet no. 17

1 2 3 4 5 6 7 8

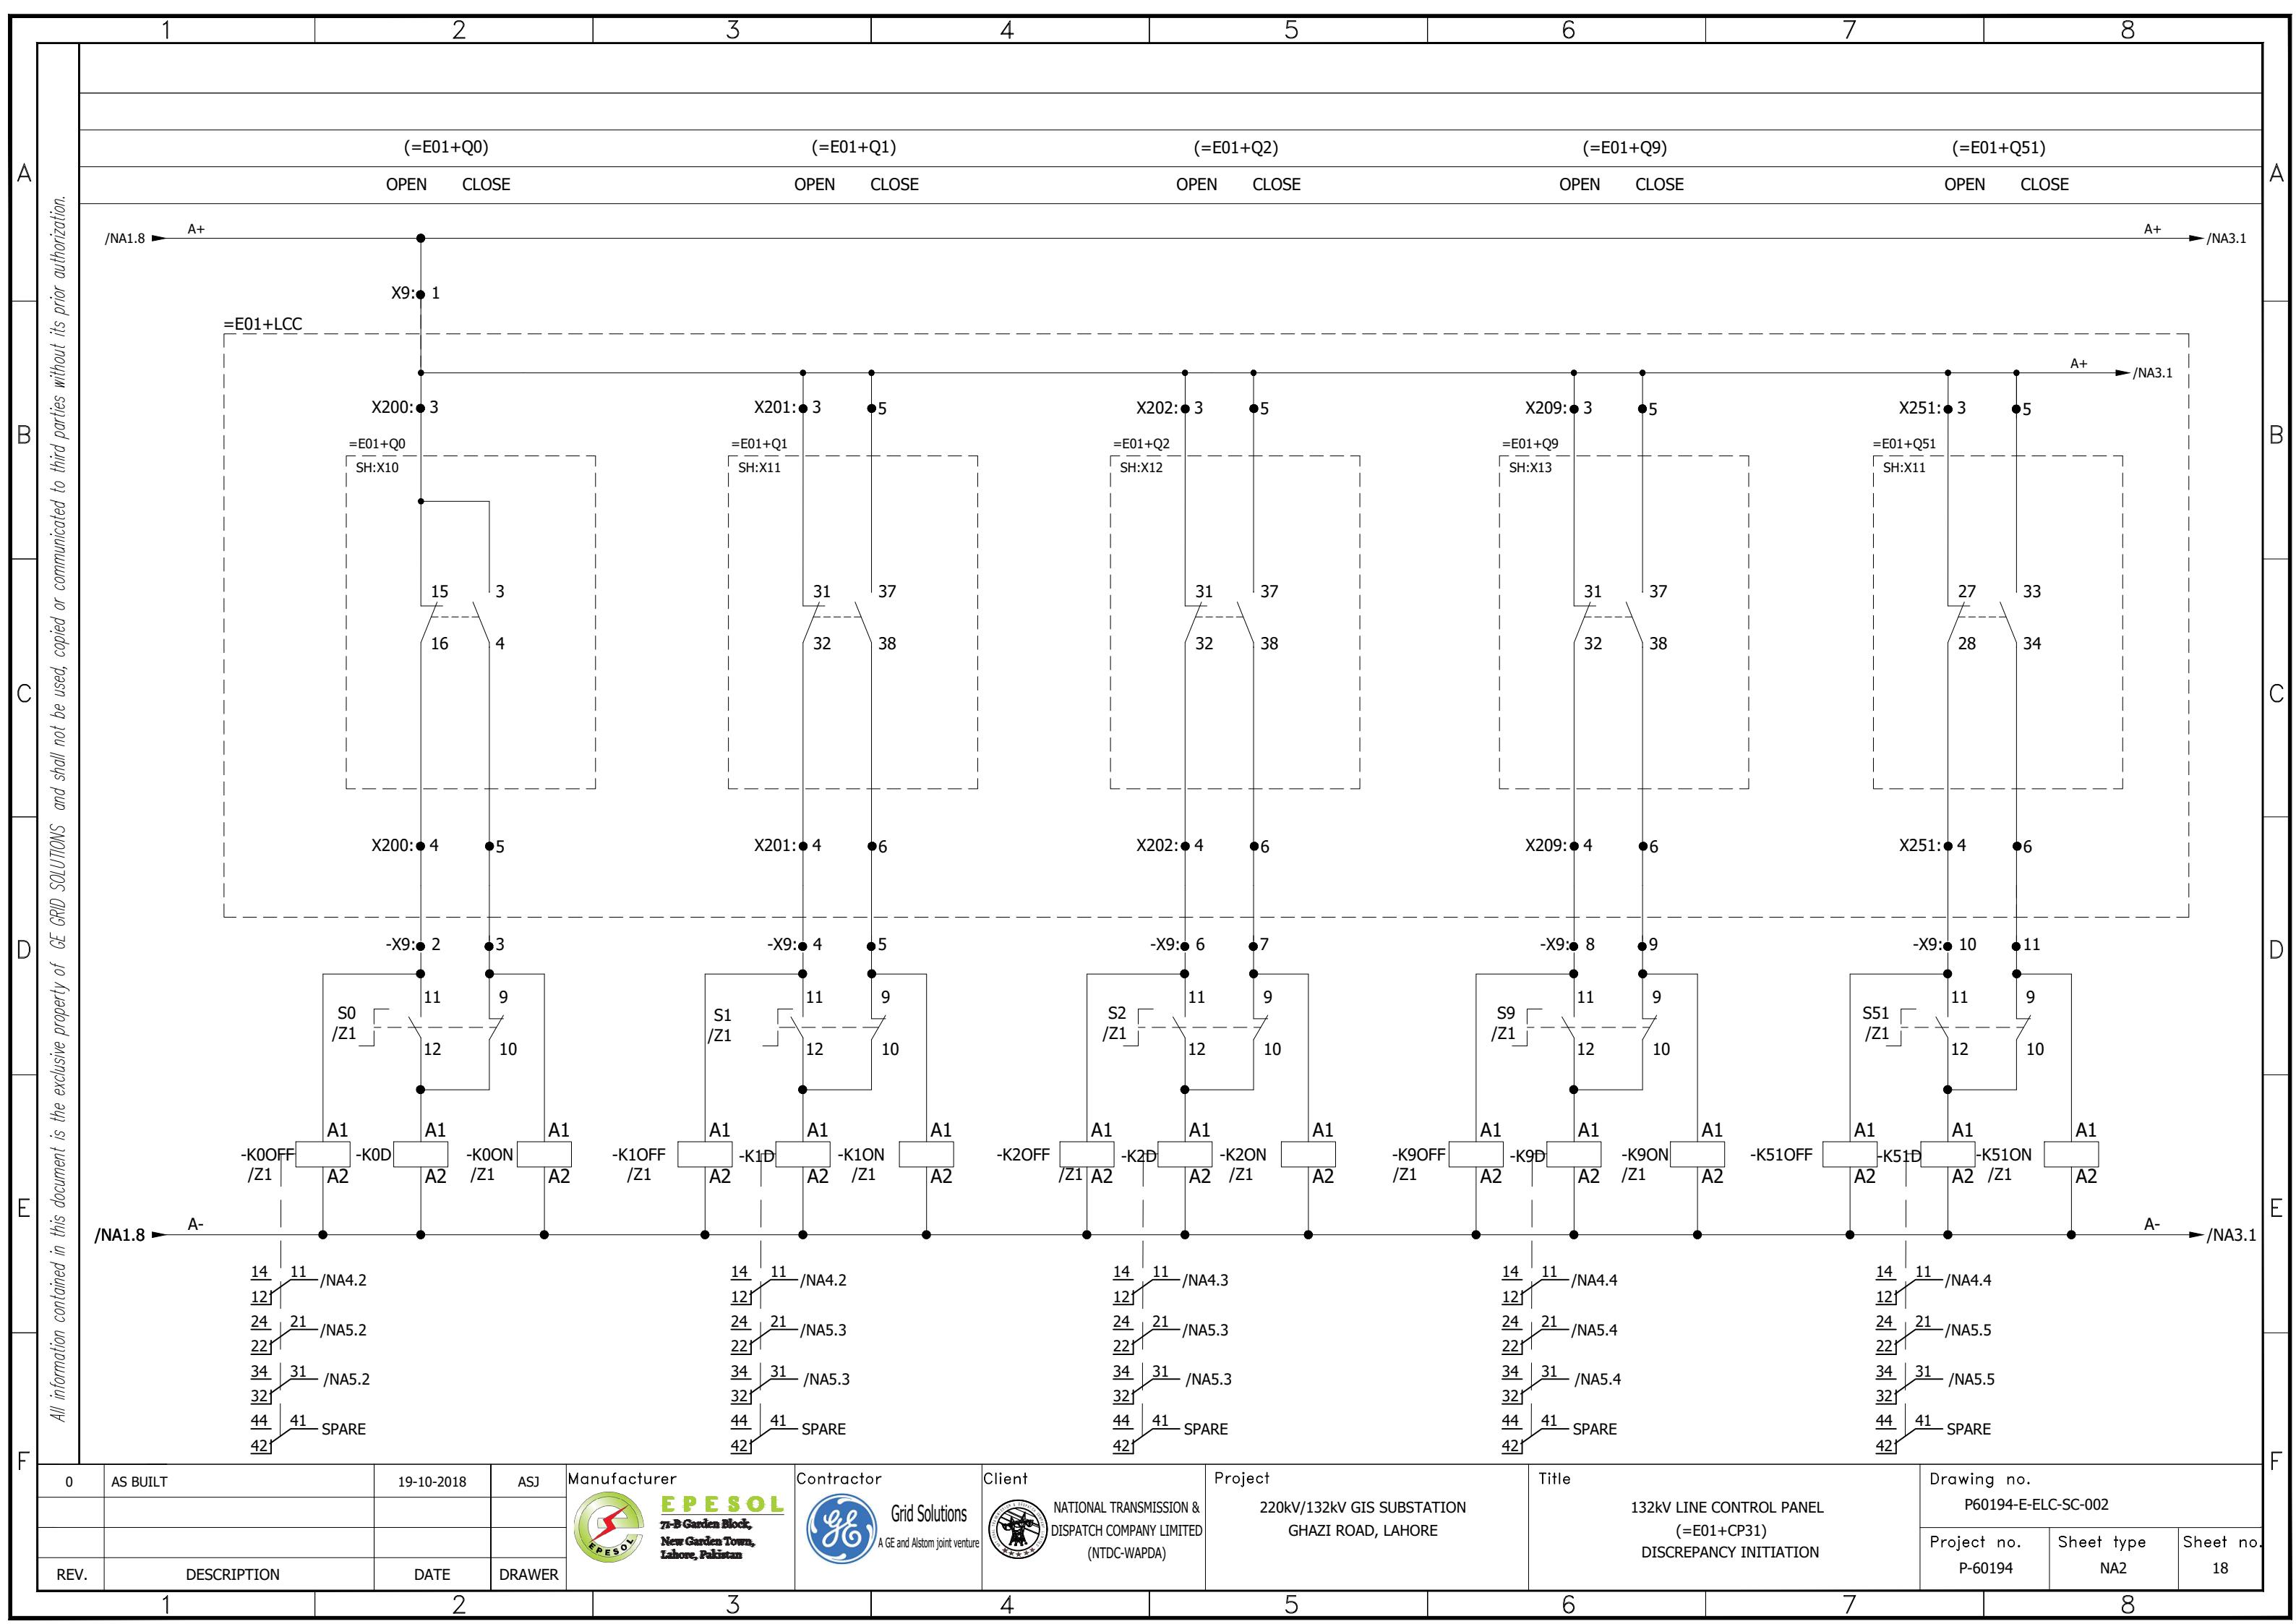

All information contained in this document is the exclusive property of GE GRID SOLUTIONS and shall not be used, copied or communicated to third parties without its prior authorization.

(-E01+Q53)

OPEN CLOSE

(-E01+Q8)



OPEN CLOSE

/NA2.8 A+

A+ /NA4.1

=E01+LCC

/NA2.8 A+

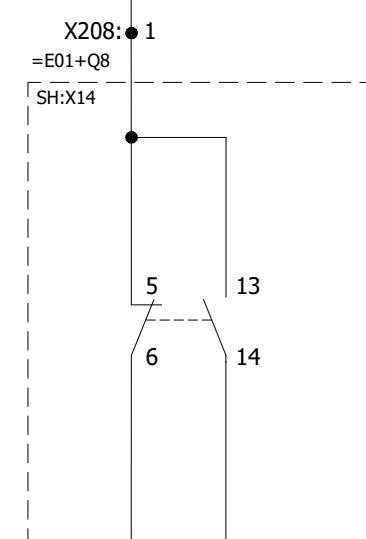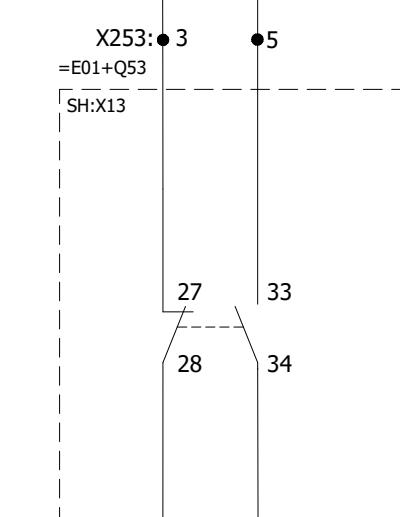

X253: 4

X9: 12

S53 /Z1

A1

-K53OFF /Z1

A2

-K53D

A2

-K53ON /Z1

A2

X208: 2

X9: 14

S8 /Z1

A1

-K8OFF /Z1

A2

-K8D

A2

-K8ON /Z1

A2

14
11 /NA4.5
121
24
21 /NA5.6
221
34
31 NA5.6
321
44
41 SPARE
421

14
11 /NA4.5
121
24
21 /NA5.7
221
34
31 /NA5.7
321
44
41 SPARE
421


/NA2.8 A-

A- /NA4.1

0	AS BUILT	19-10-2018	ASJ	Manufacturer  EPESOL 71-B Garden Block, New Garden Town, Lahore, Pakistan	Contractor  Grid Solutions A GE and Alstom joint venture	Client  NATIONAL TRANSMISSION & DISPATCH COMPANY LIMITED (NTDC-WAPDA)	Project 220KV/132KV GIS SUBSTATION GHAZI ROAD, LAHORE	Title 132KV LINE CONTROL PANEL (=E01+CP31) DISCREPANCY INITIATION	Drawing no. P60194-E-ELC-SC-002
REV.	DESCRIPTION	DATE	DRAWER						Project no. P-60194
									Sheet type NA3
									Sheet no. 19

1 2 3 4 5 6 7 8

OFF/ON OFF/ON OFF/ON OFF/ON OFF/ON OFF/ON OFF/ON CIRCUIT BREAKER
 (=E01+Q0) (=E01+Q1) (=E01+Q2) (=E01+Q9) (=E01+Q51) (=E01+Q53) (=E01+Q8) OPERATION COUNTER
 (-Q10)

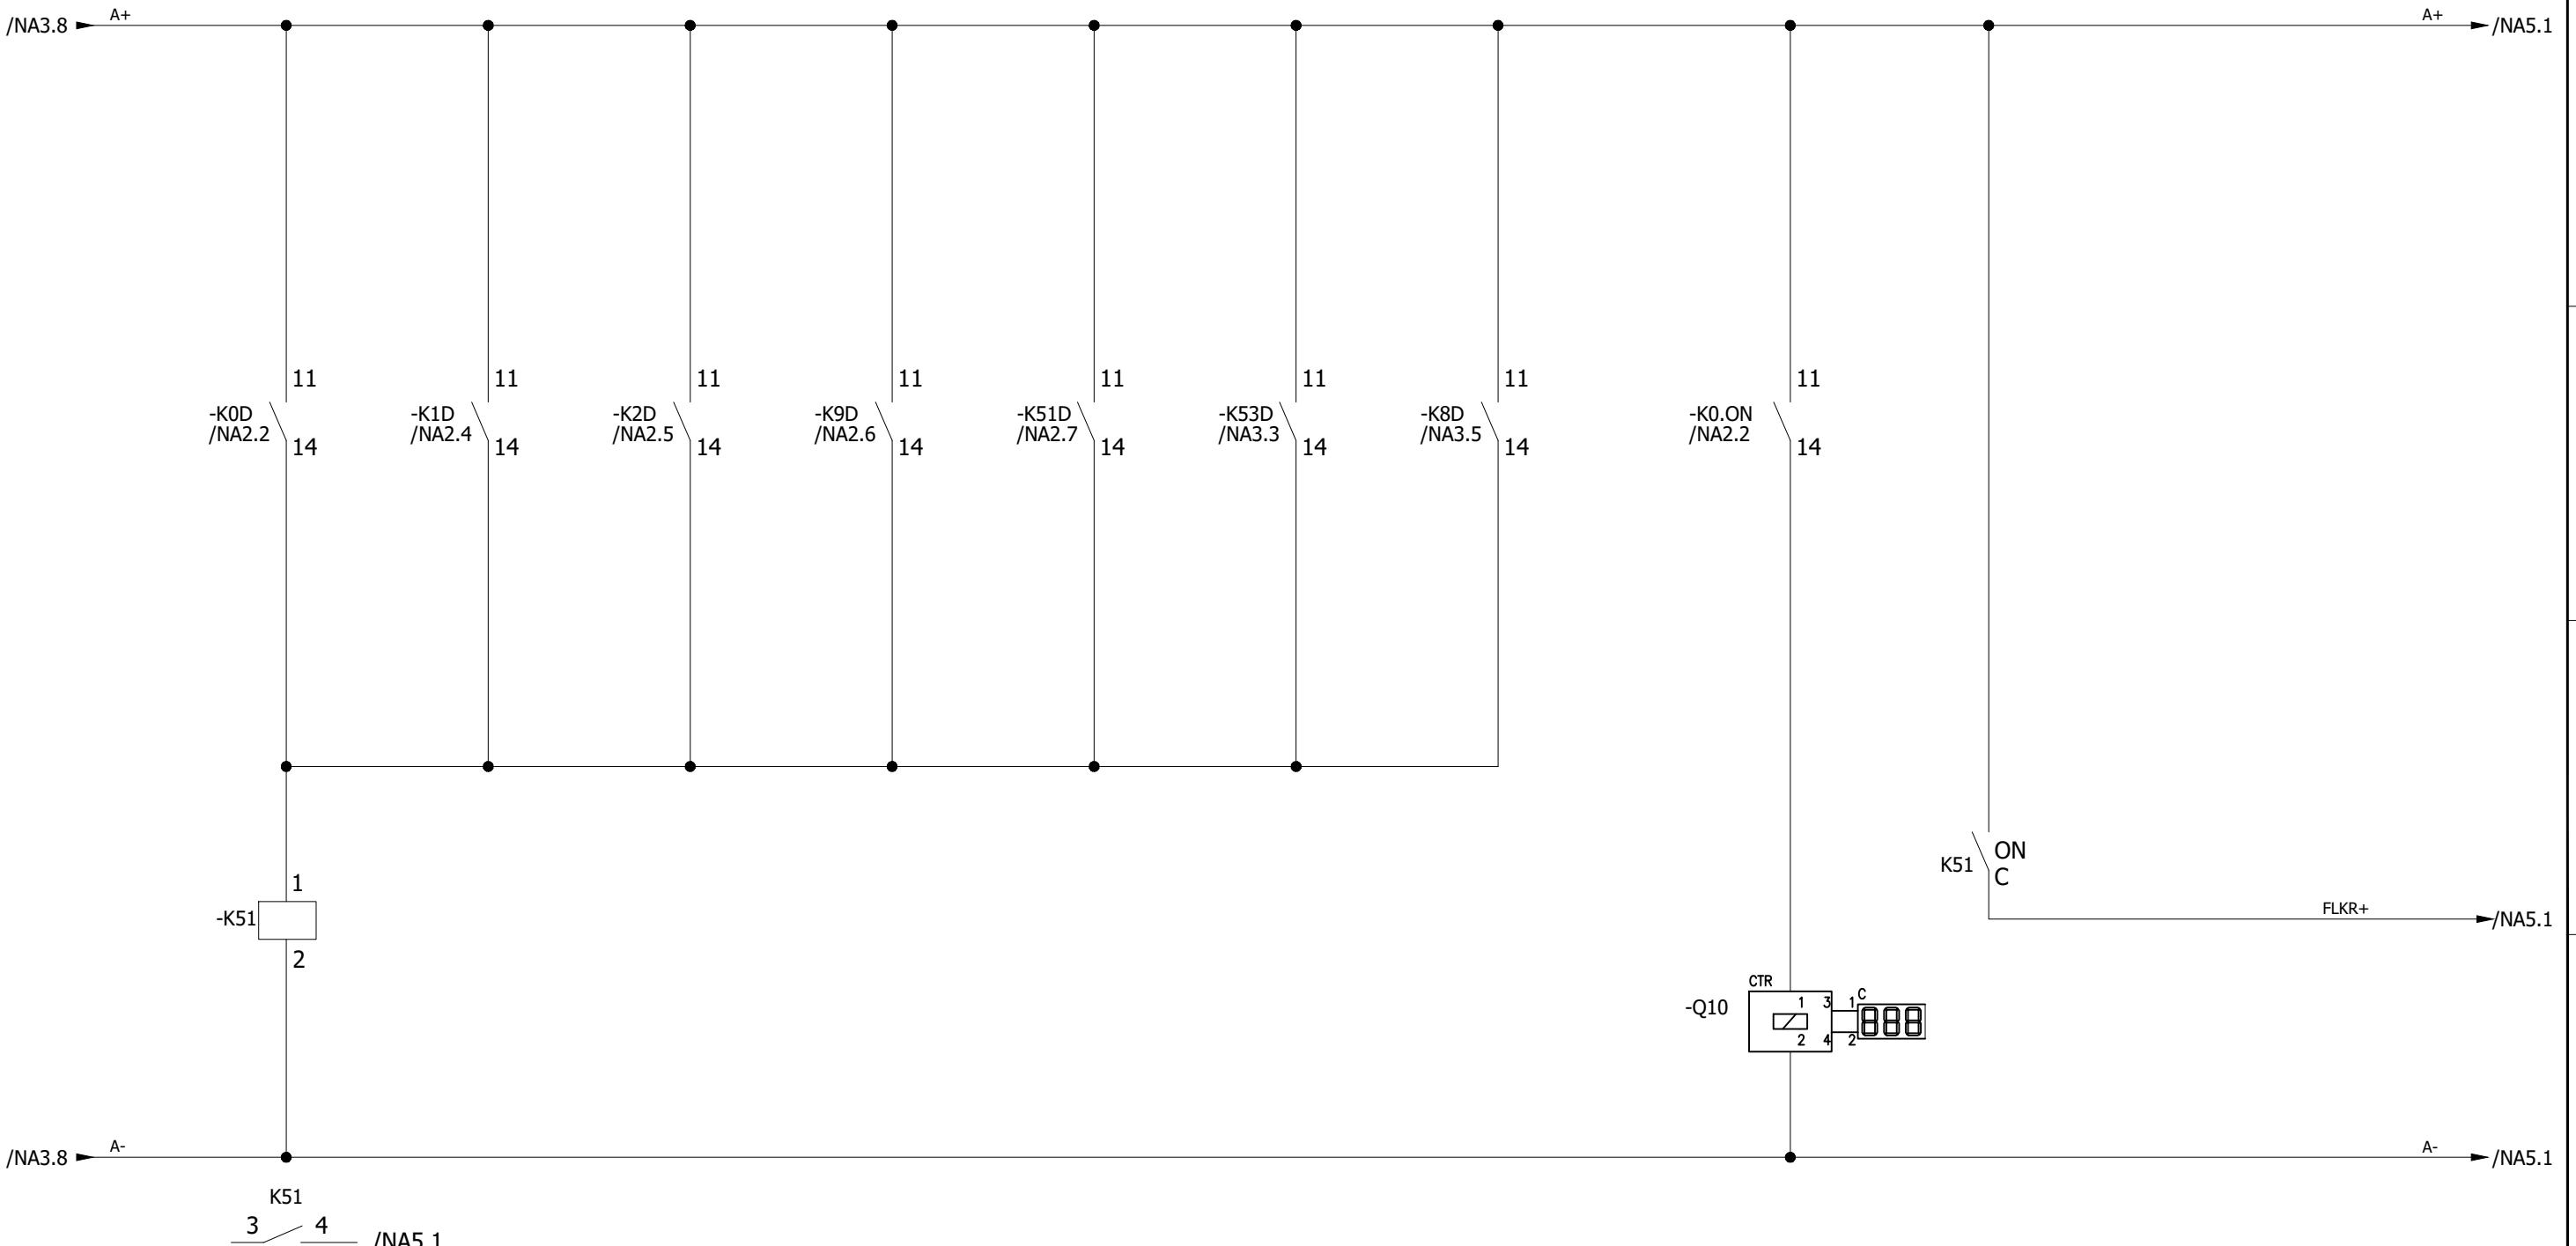

0	AS BUILT	19-10-2018	ASJ	Manufacturer  EPESOL 71-B Garden Block, New Garden Town, Lahore, Pakistan	Contractor  Grid Solutions A GE and Alstom joint venture	Client  NATIONAL TRANSMISSION & DISPATCH COMPANY LIMITED (NTDC-WAPDA)	Project 220kV/132kV GIS SUBSTATION GHAZI ROAD, LAHORE	Title 132kV LINE CONTROL PANEL (=E01+CP31) DISCREPANCY INITIATION	Drawing no. P60194-E-ELC-SC-002
REV.	DESCRIPTION	DATE	DRAWER						Project no. P-60194
									Sheet type NA4
									Sheet no. 20

1 2 3 4 5 6 7 8


1 2 3 4 5 6 7 8

All information contained in this document is the exclusive property of GE GRID SOLUTIONS and shall not be used, copied or communicated to third parties without its prior authorization.

(=E01+Q0) (=E01+Q1) (=E01+Q2) (=E01+Q9) (=E01+Q51) (=E01+Q53) (=E01+Q8)

A

A

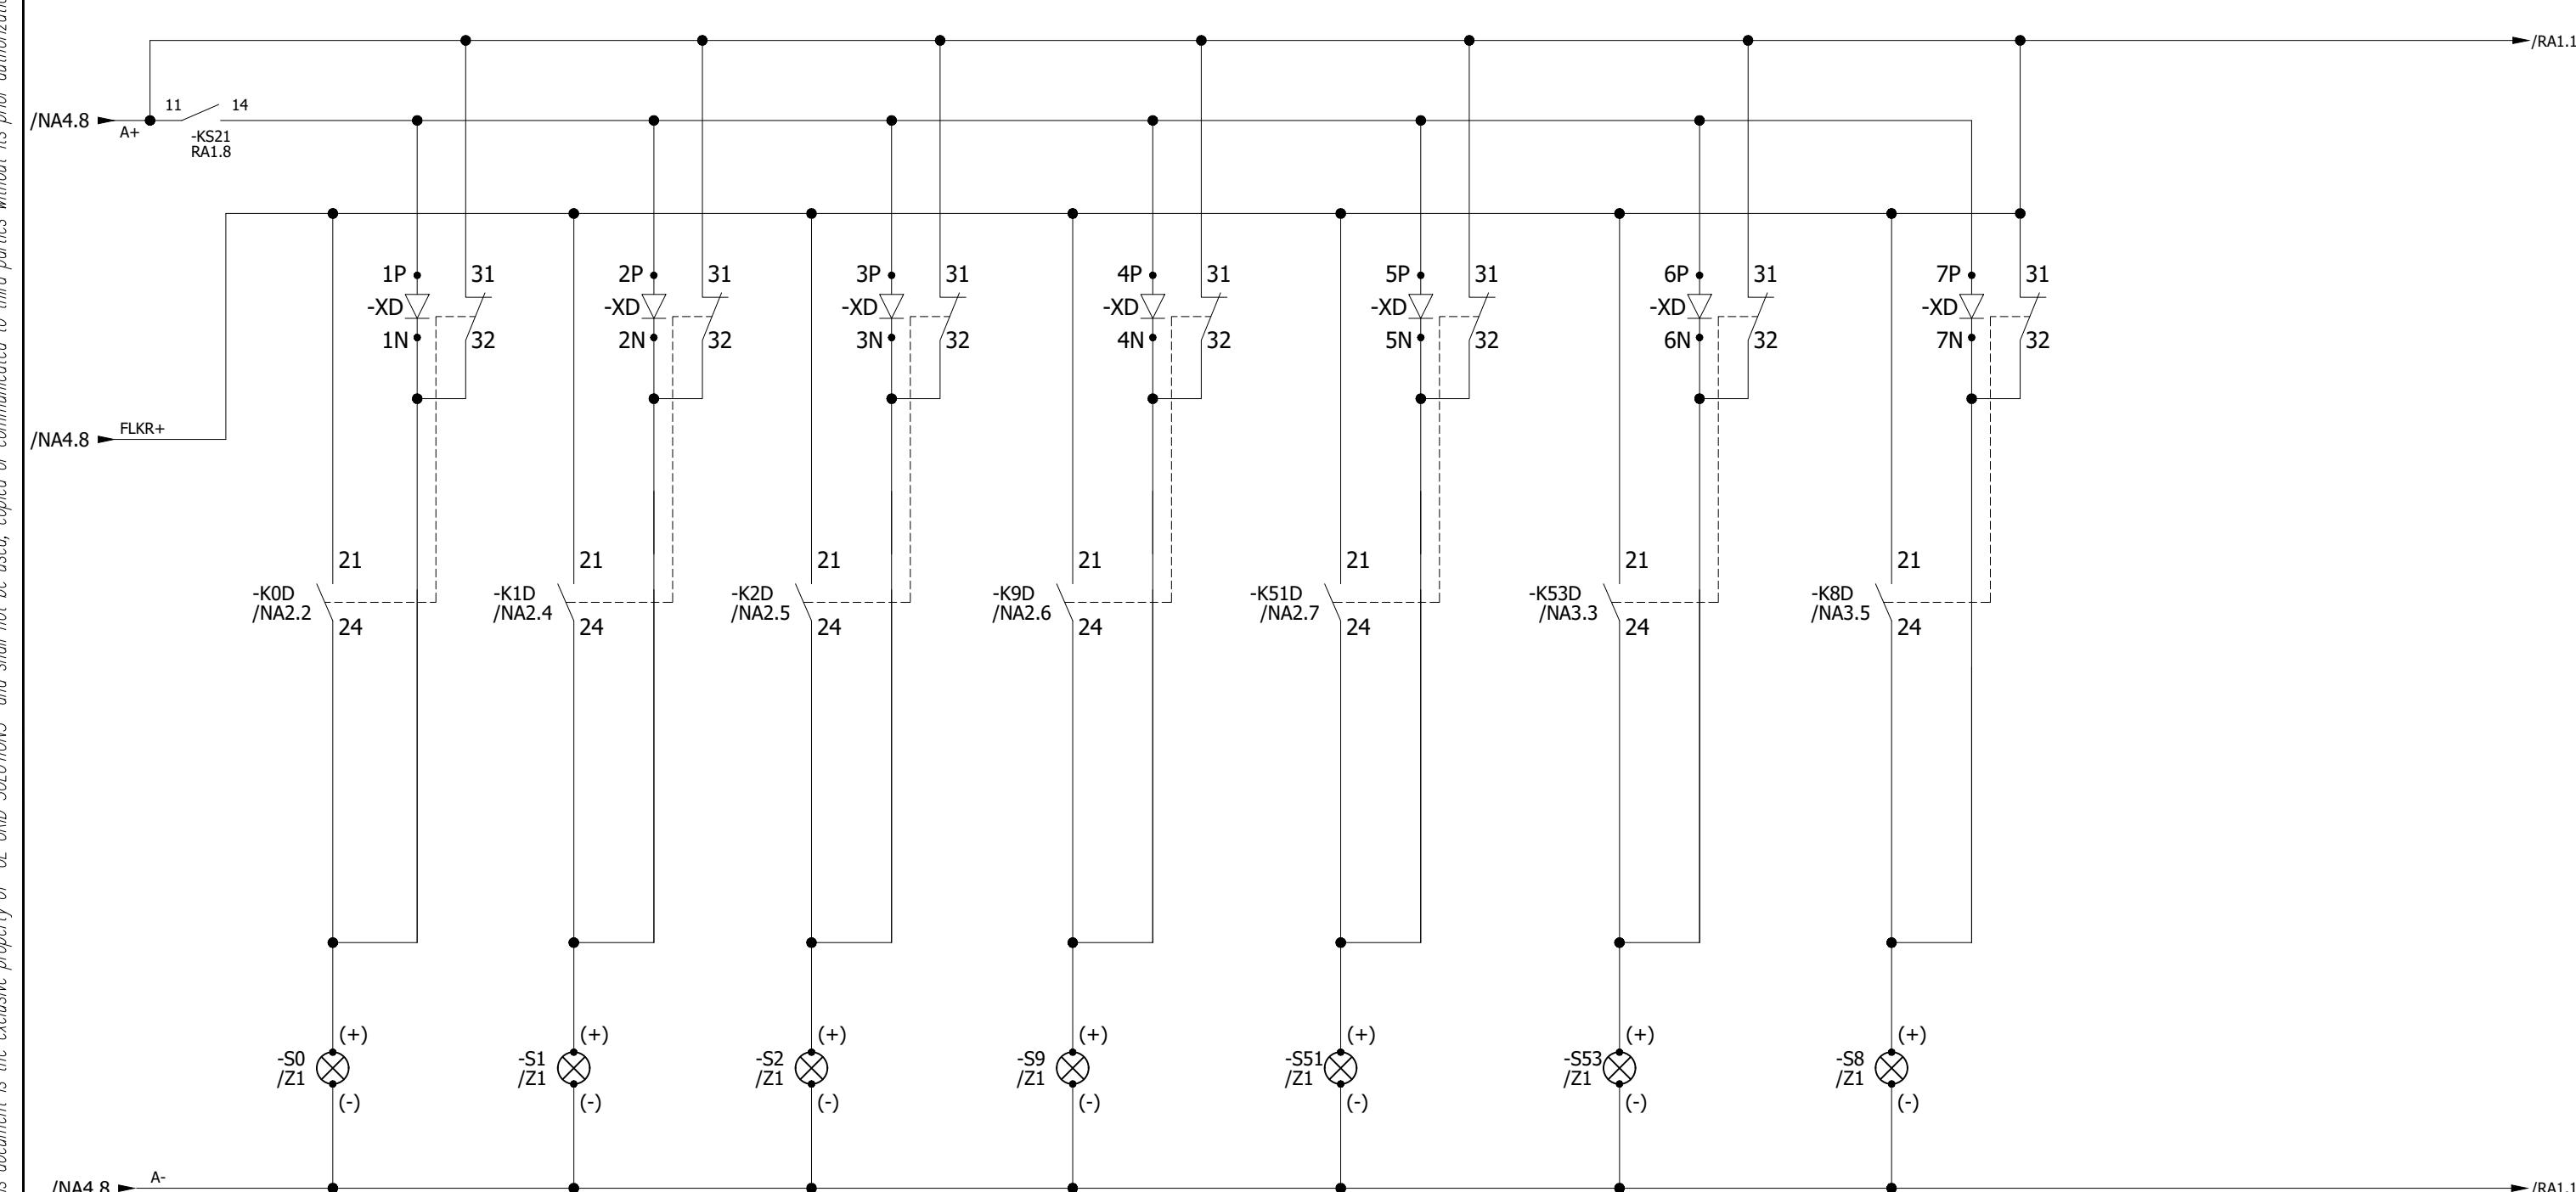


0	AS BUILT	19-10-2018	ASJ	Manufacturer E P E S O L 71-B Garden Block, New Garden Town, Lahore, Pakistan	Contractor Grid Solutions A GE and Alstom joint venture	Client NATIONAL TRANSMISSION & DISPATCH COMPANY LIMITED (NTDC-WAPDA)	Project 220kV/132kV GIS SUBSTATION GHAZI ROAD, LAHORE	Title 132kV LINE CONTROL PANEL (=E01+CP31) DISCREPANCY INDICATIONS	Drawing no. P60194-E-ELC-SC-002
									Project no. P-60194
REV.	DESCRIPTION	DATE	DRAWER						Sheet type NA5

1 2 3 4 5 6 7 8


LCC


SPRING DISCHARGED DS/ES/HES OPERATION LONG SPRING CHARGING TIME GAS COMPARTMENT ALARM LEVEL-1 GAS COMPARTMENT ALARM LEVEL-2 LCC BYPASS MODE LCC LOCAL MODE DC SUPPLY DISTURBED AC SUPPLY DISTURBED GO LOCK CONTROL PANEL AC SUPPLY FAILURE SPARE HOOTER

All information contained in this document is the exclusive property of GE GRID SOLUTIONS and shall not be used, copied or communicated to third parties without its prior authorization.

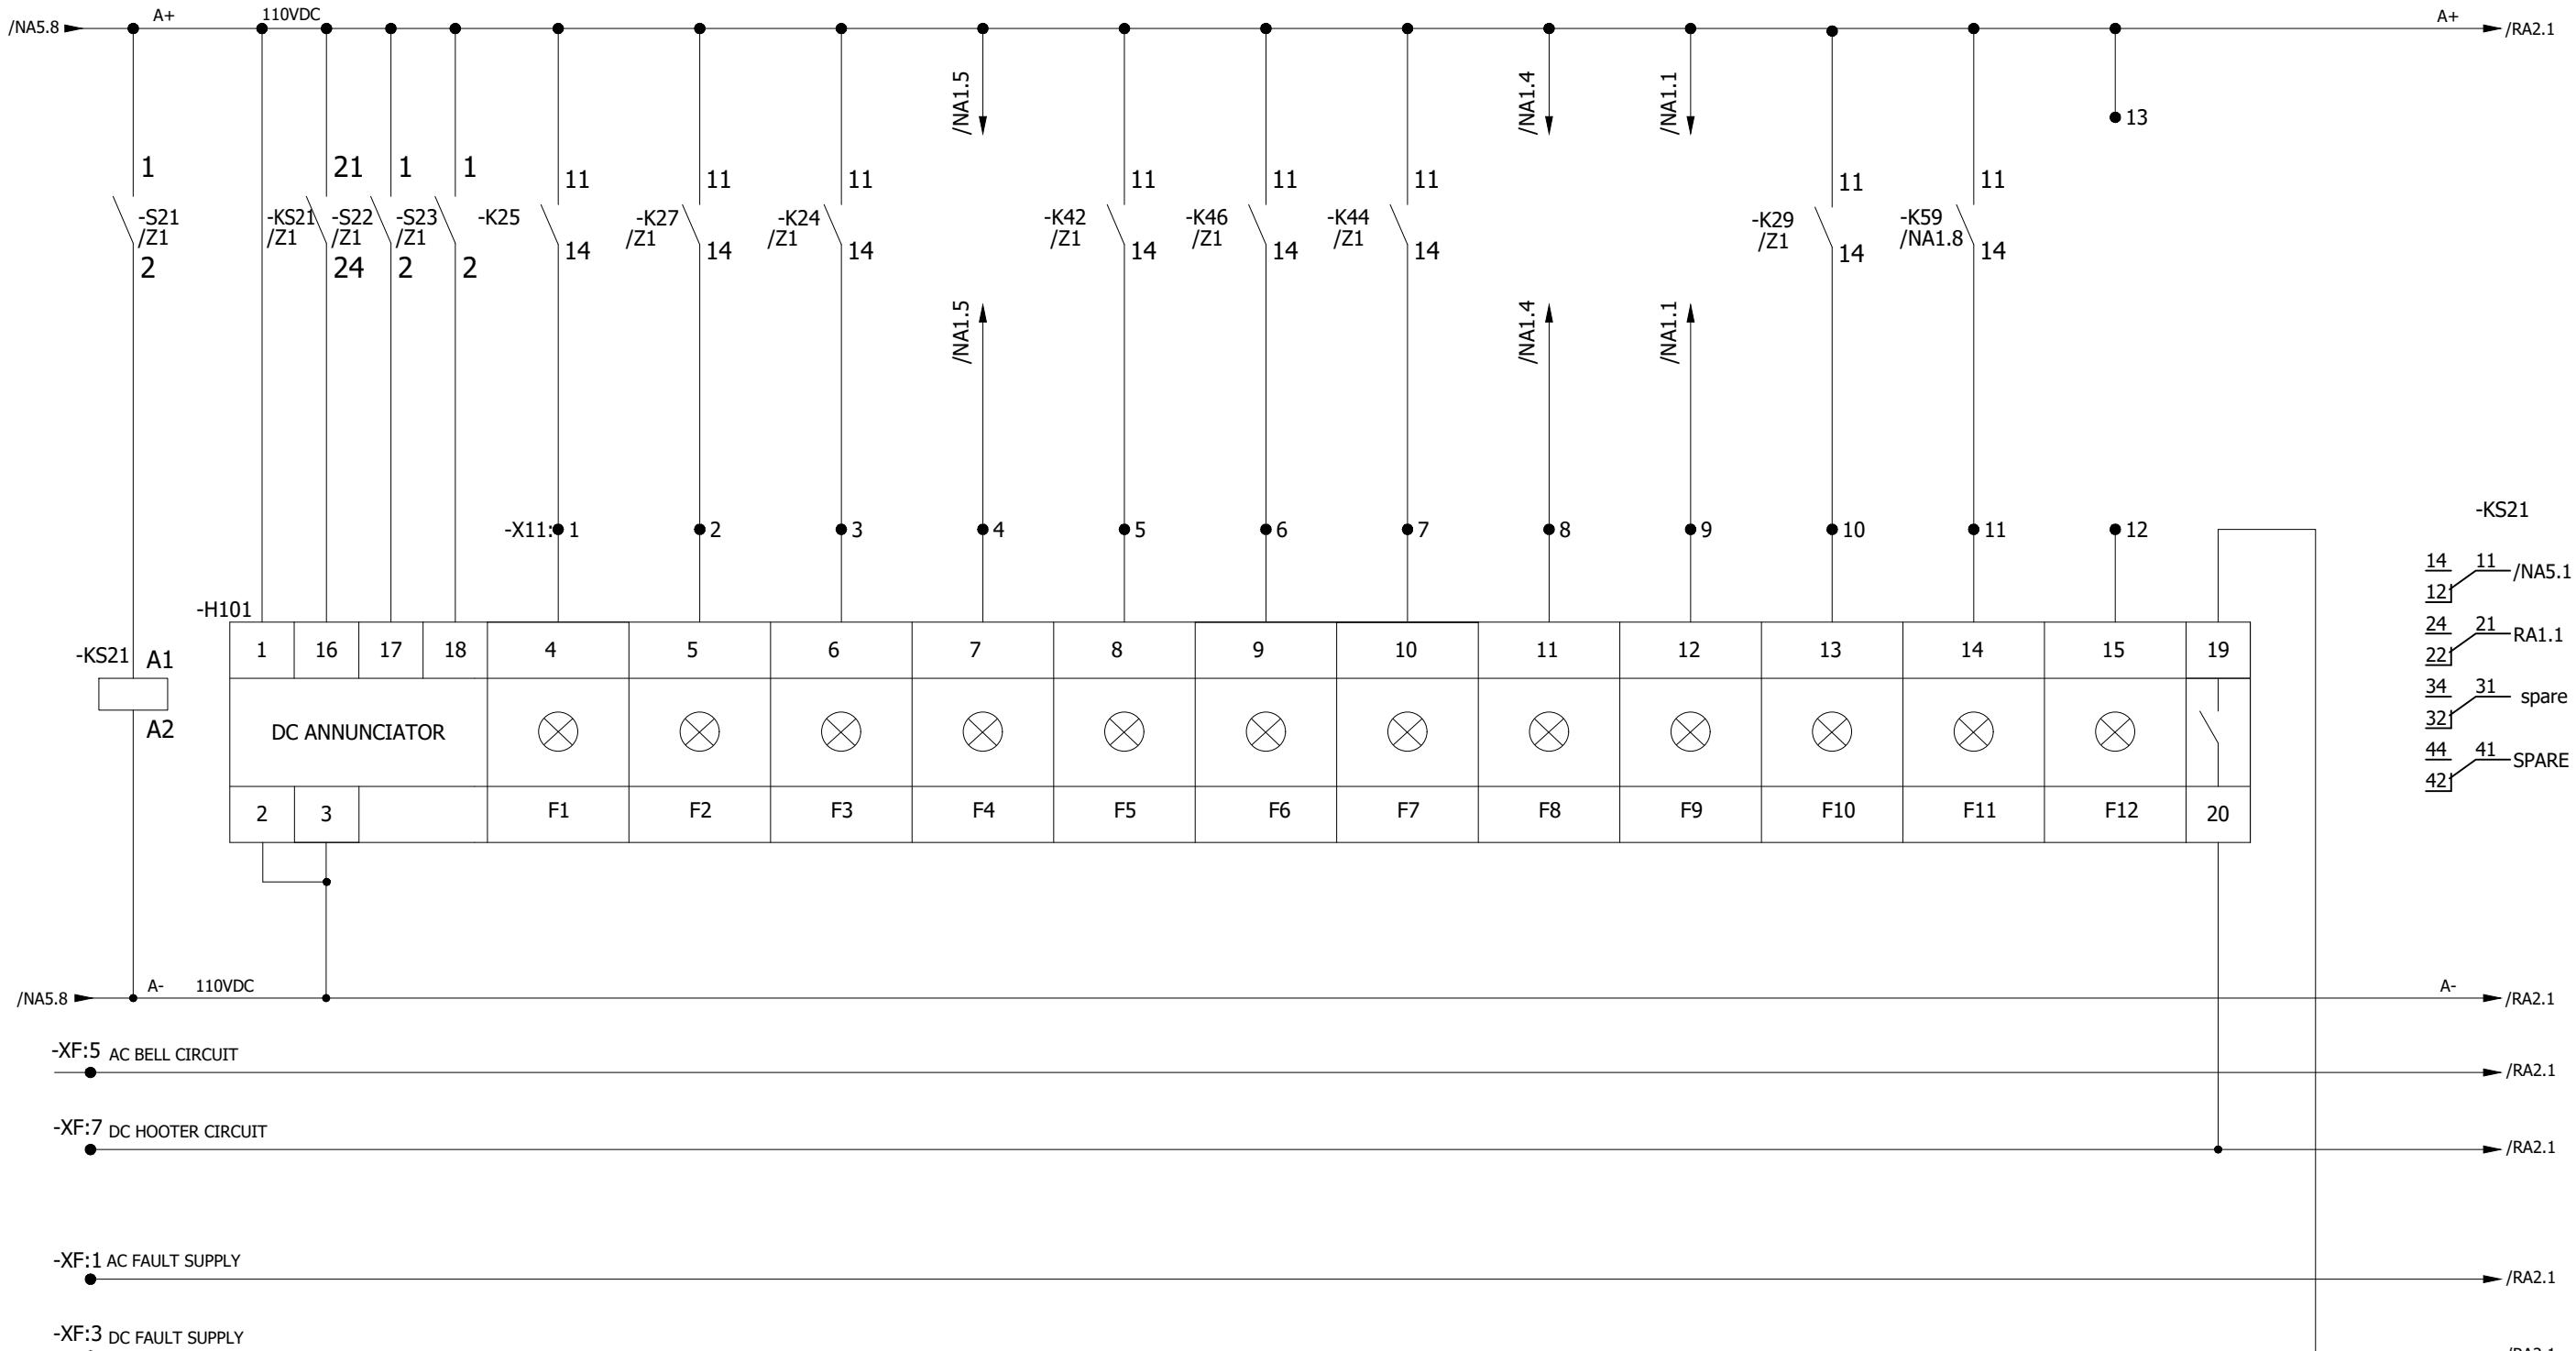


0	AS BUILT	19-10-2018	ASJ	Manufacturer EPE SOL 71-B Garden Block, New Garden Town, Lahore, Pakistan	Contractor Grid Solutions A GE and Alstom joint venture	Client NATIONAL TRANSMISSION & DISPATCH COMPANY LIMITED (NTDC-WAPDA)	Project 220kV/132kV GIS SUBSTATION GHAZI ROAD, LAHORE	Title 132kV LINE CONTROL PANEL (=E01+CP31) ANNUNCIATOR-1 CIRCUIT	Drawing no. P60194-E-ELC-SC-002
									Project no. P-60194
REV.	DESCRIPTION	DATE	DRAWER						Sheet type RA1

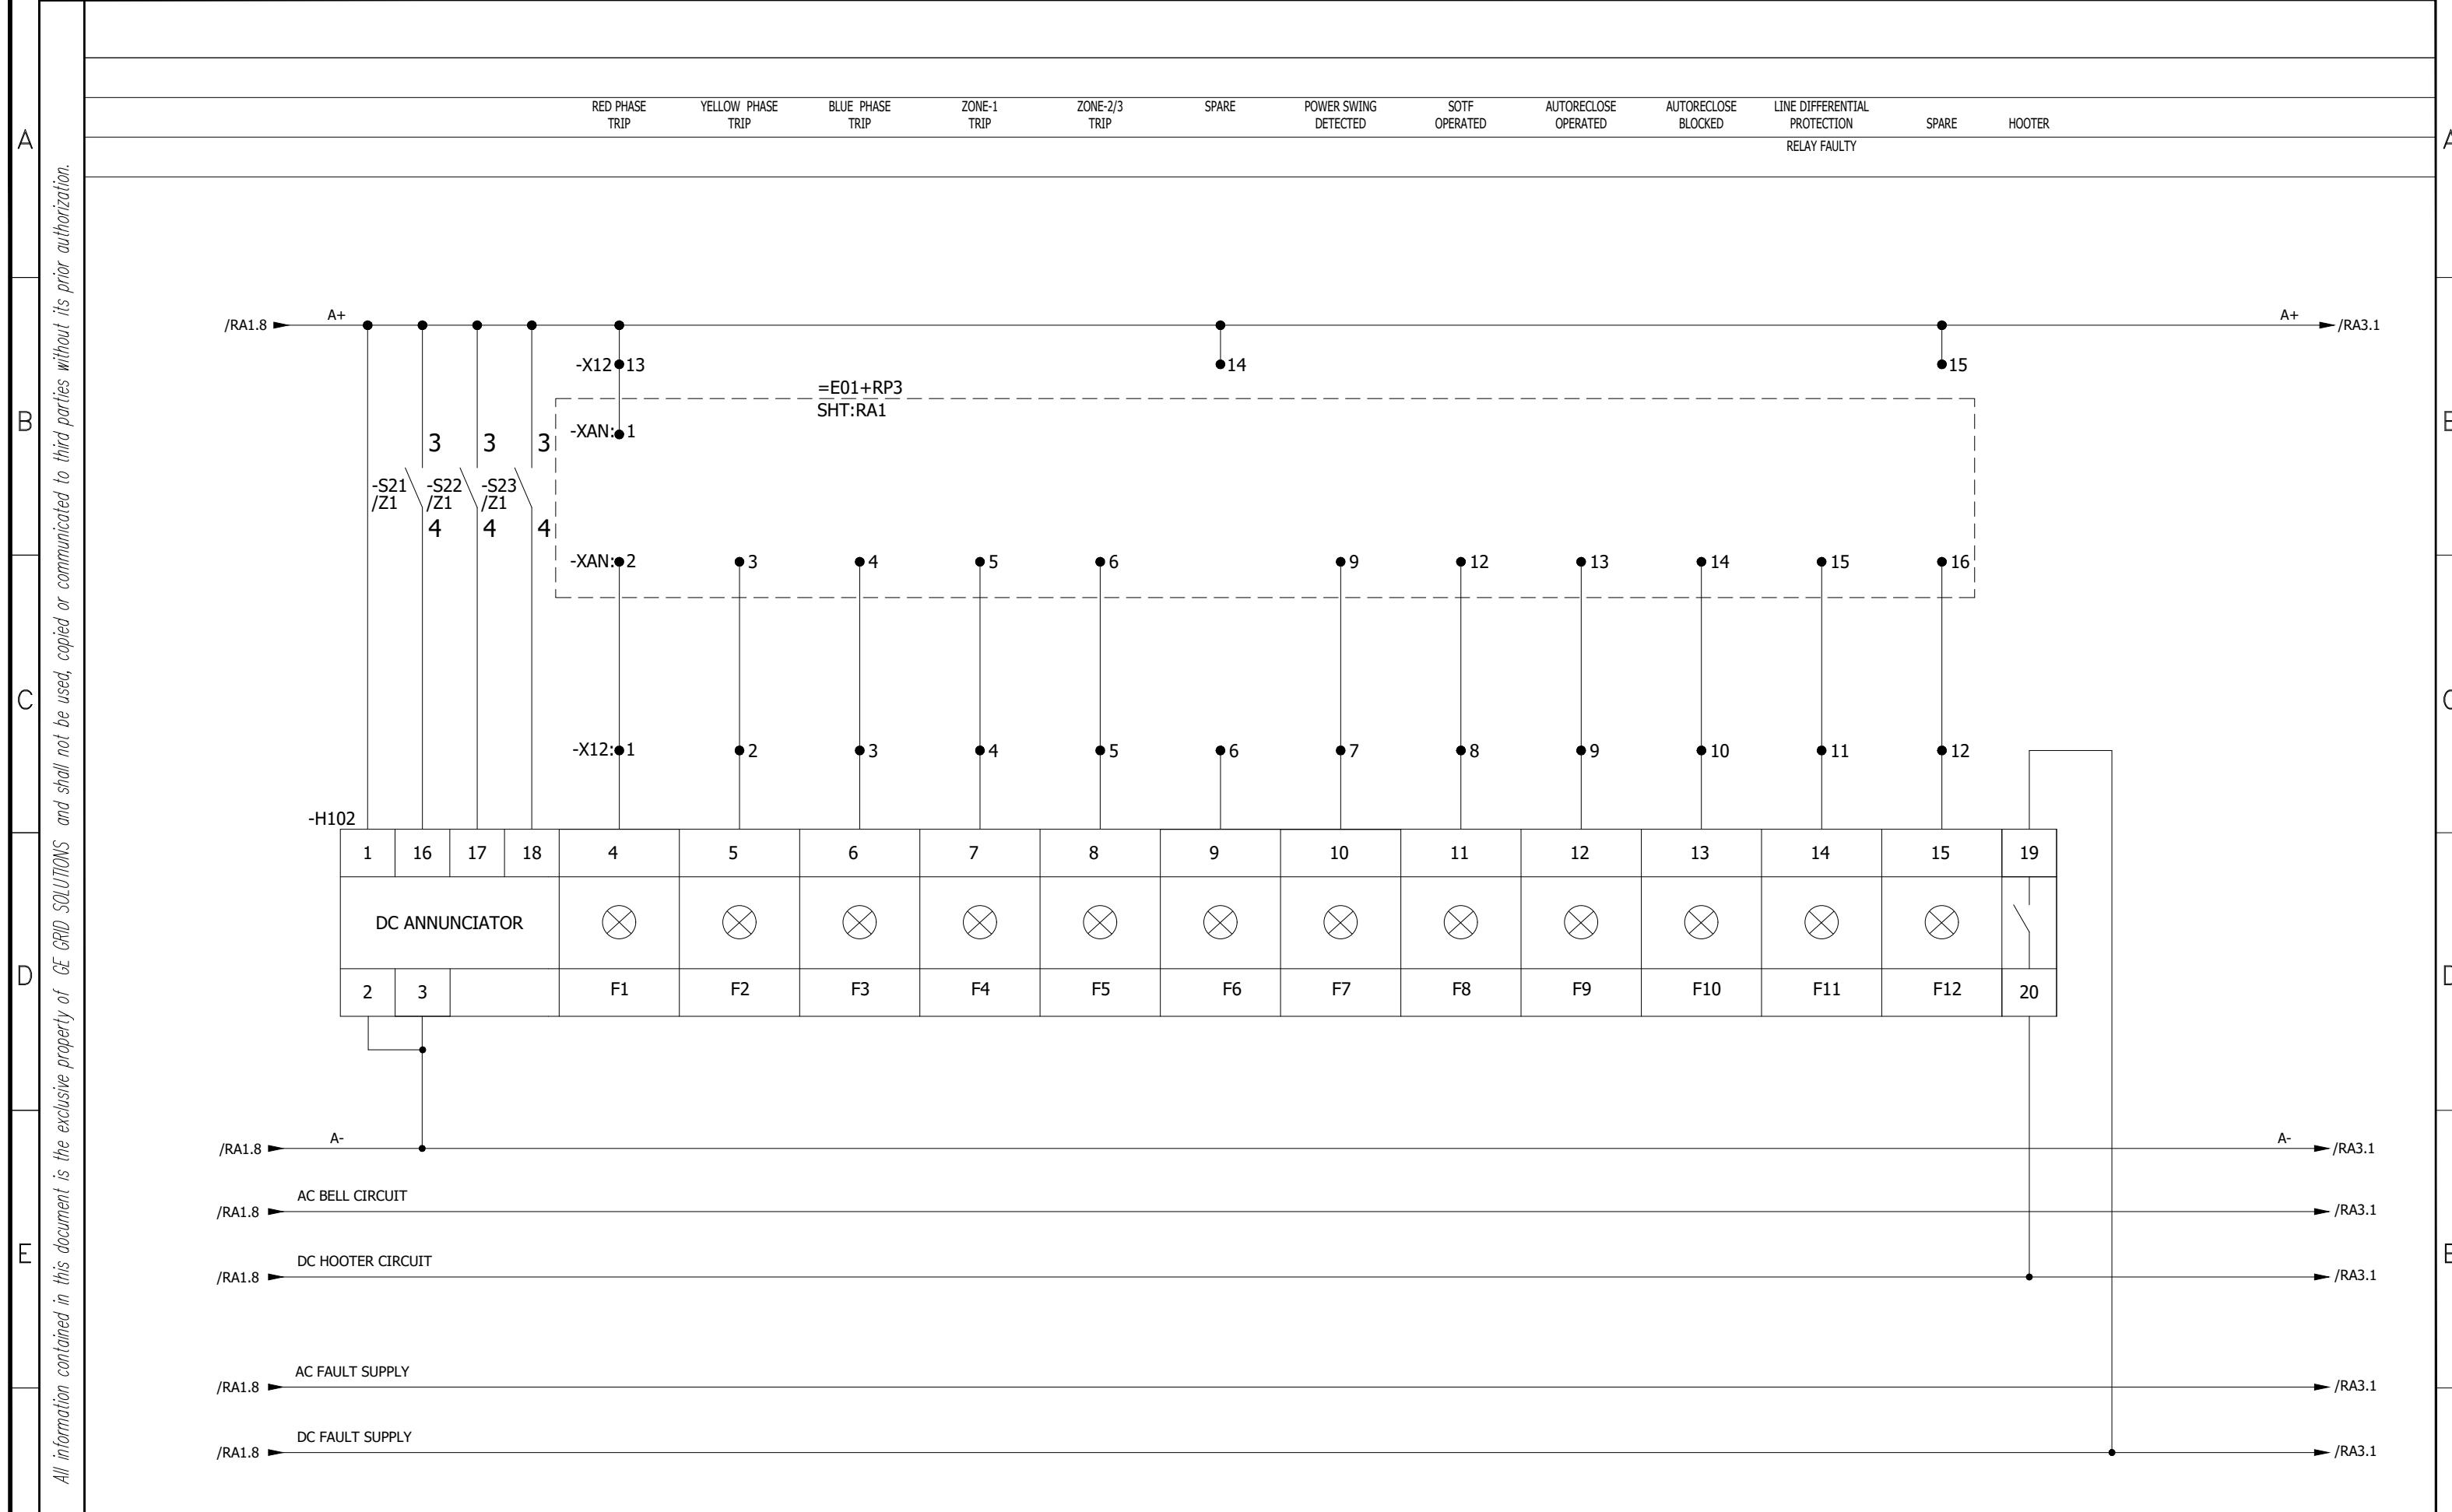

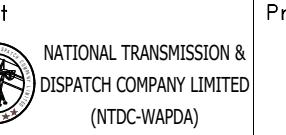
0	AS BUILT	19-10-2018	ASJ	Manufacturer  EPESOL 71-B Garden Block, New Garden Town, Lahore, Pakistan	Contractor  Grid Solutions A GE and Alstom joint venture	Client  NATIONAL TRANSMISSION & DISPATCH COMPANY LIMITED (NTDC-WAPDA)	Project 220kV/132kV GIS SUBSTATION GHAZI ROAD, LAHORE	Title 132kV LINE CONTROL PANEL (=E01+CP31) ANNUNCIATOR-2 CIRCUIT	Drawing no. P60194-E-ELC-SC-002
REV.	DESCRIPTION	DATE	DRAWER						Project no. P-60194
									Sheet type RA2
									Sheet no. 23

All information contained in this document is the exclusive property of GF GRID SOLUTIONS and shall not be used, copied or communicated to third parties without its prior authorization.

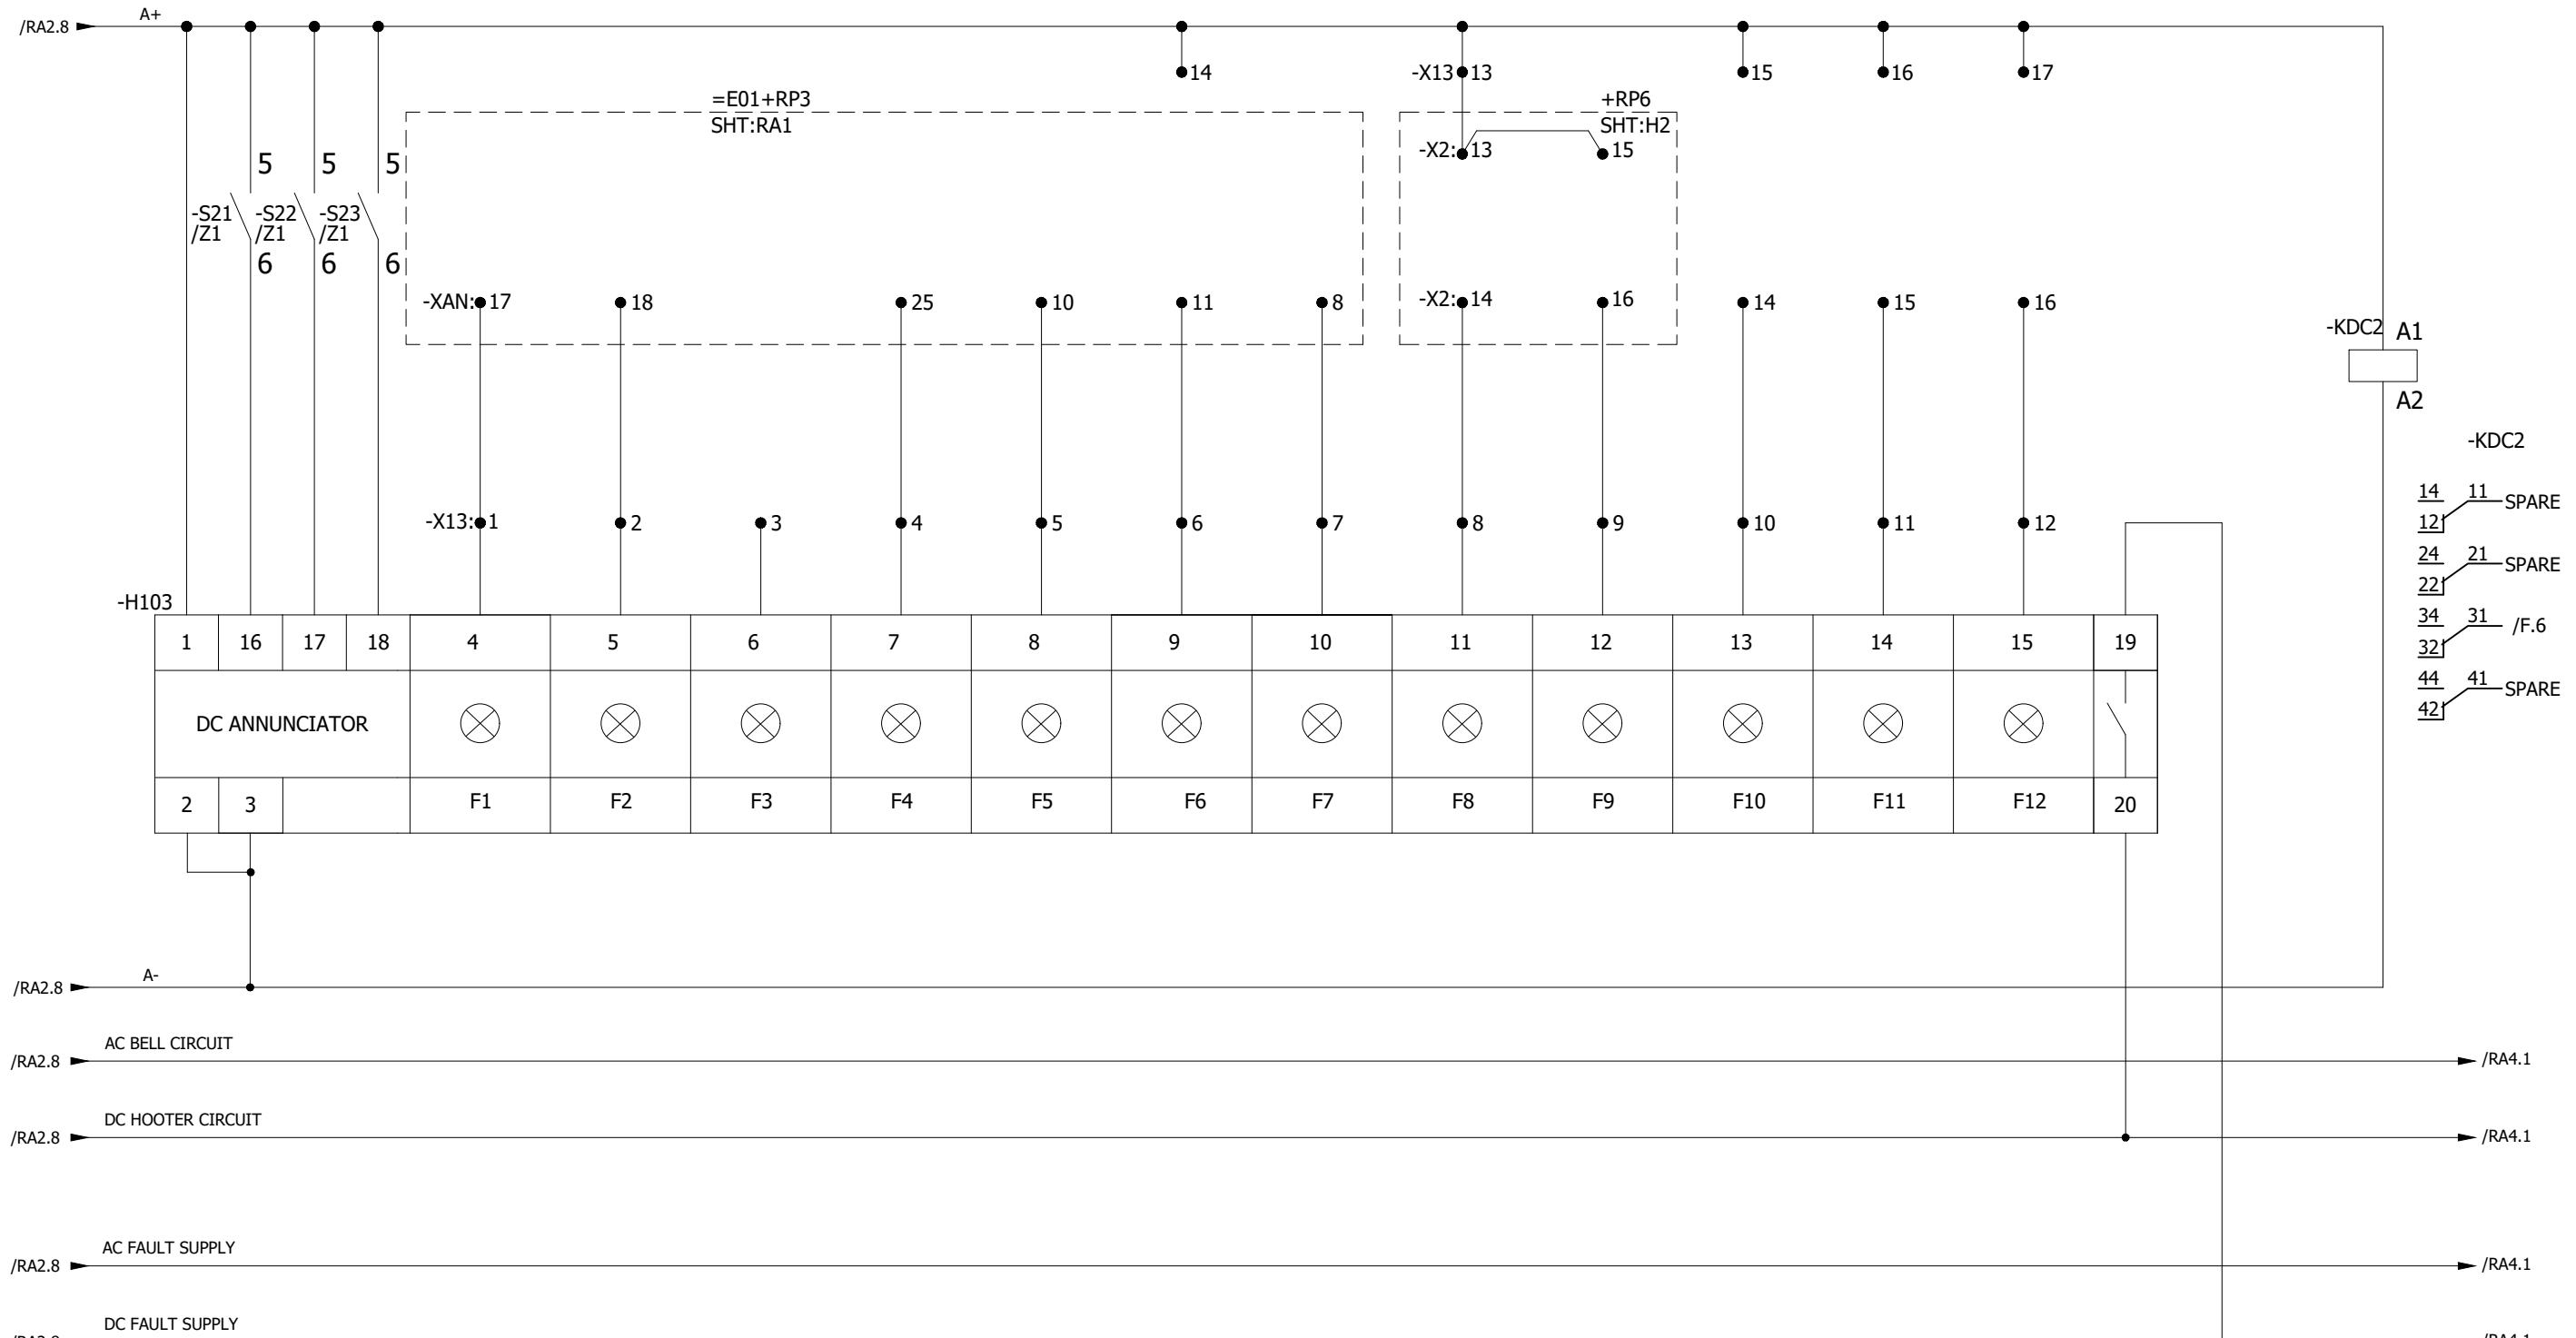

LINE RELAY PANEL
110VDC
CIRCUIT/SUPPLY FAULTY SPARE SPARE SPARE SPARE SPARE SPARE CONTROL PANEL
DC FAIL SPARE SPARE SPARE SPARE AC BELL


All information contained in this document is the exclusive property of GE GRID SOLUTIONS and shall not be used, copied or communicated to third parties without its prior authorization.

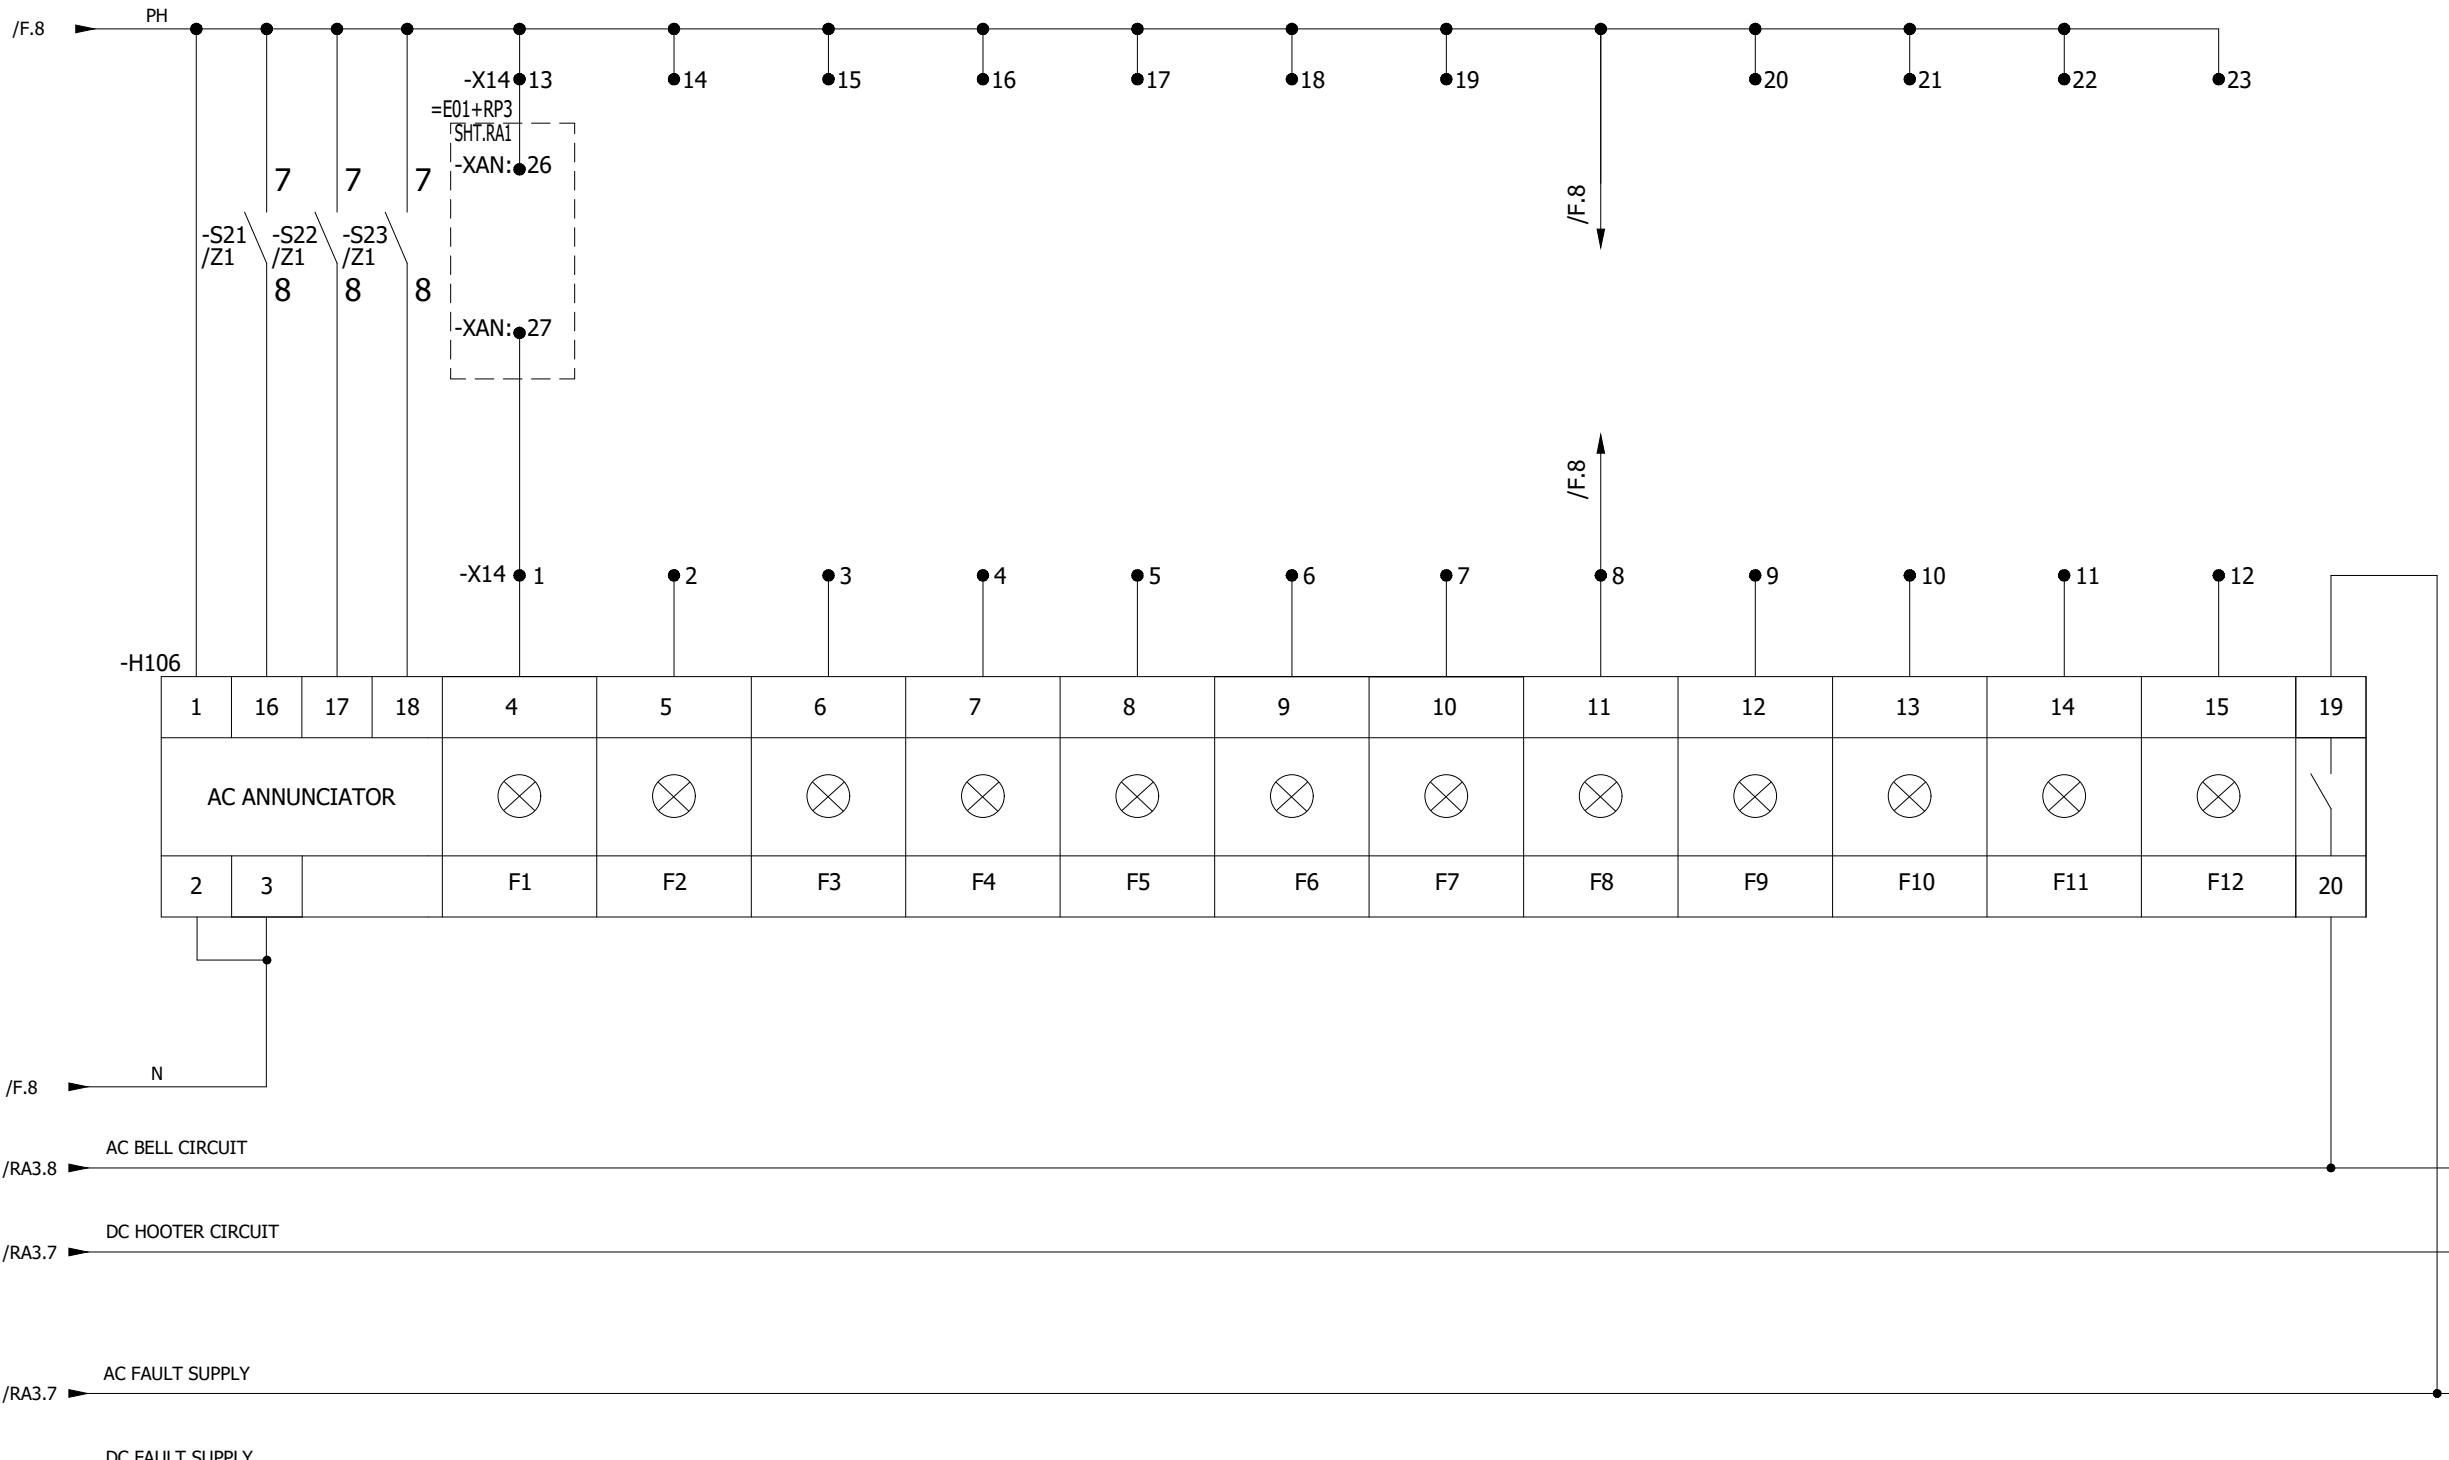

0	AS BUILT		19-10-2018	ASJ	Manufacturer  EPE SOL 71-B Garden Block, New Garden Town, Lahore, Pakistan	Contractor  Grid Solutions A GE and Alstom joint venture	Client  NATIONAL TRANSMISSION & DISPATCH COMPANY LIMITED (NTDC-WAPDA)	Project 220KV/132KV GIS SUBSTATION GHAZI ROAD, LAHORE	Title 132KV LINE CONTROL PANEL (=E01+CP31) ANNUNCIATOR-4 CIRCUIT	Drawing no. P60194-E-ELC-SC-002		
REV.	DESCRIPTION		DATE	DRAWER						Project no. P-60194	Sheet type RA4	Sheet no. 25
1	2	3	4	5	6	7	8	9	10	11	12	13


1 2 3 4 5 6 7 8

All information contained in this document is the exclusive property of GE GRID SOLUTIONS and shall not be used, copied or communicated to third parties without its prior authorization.

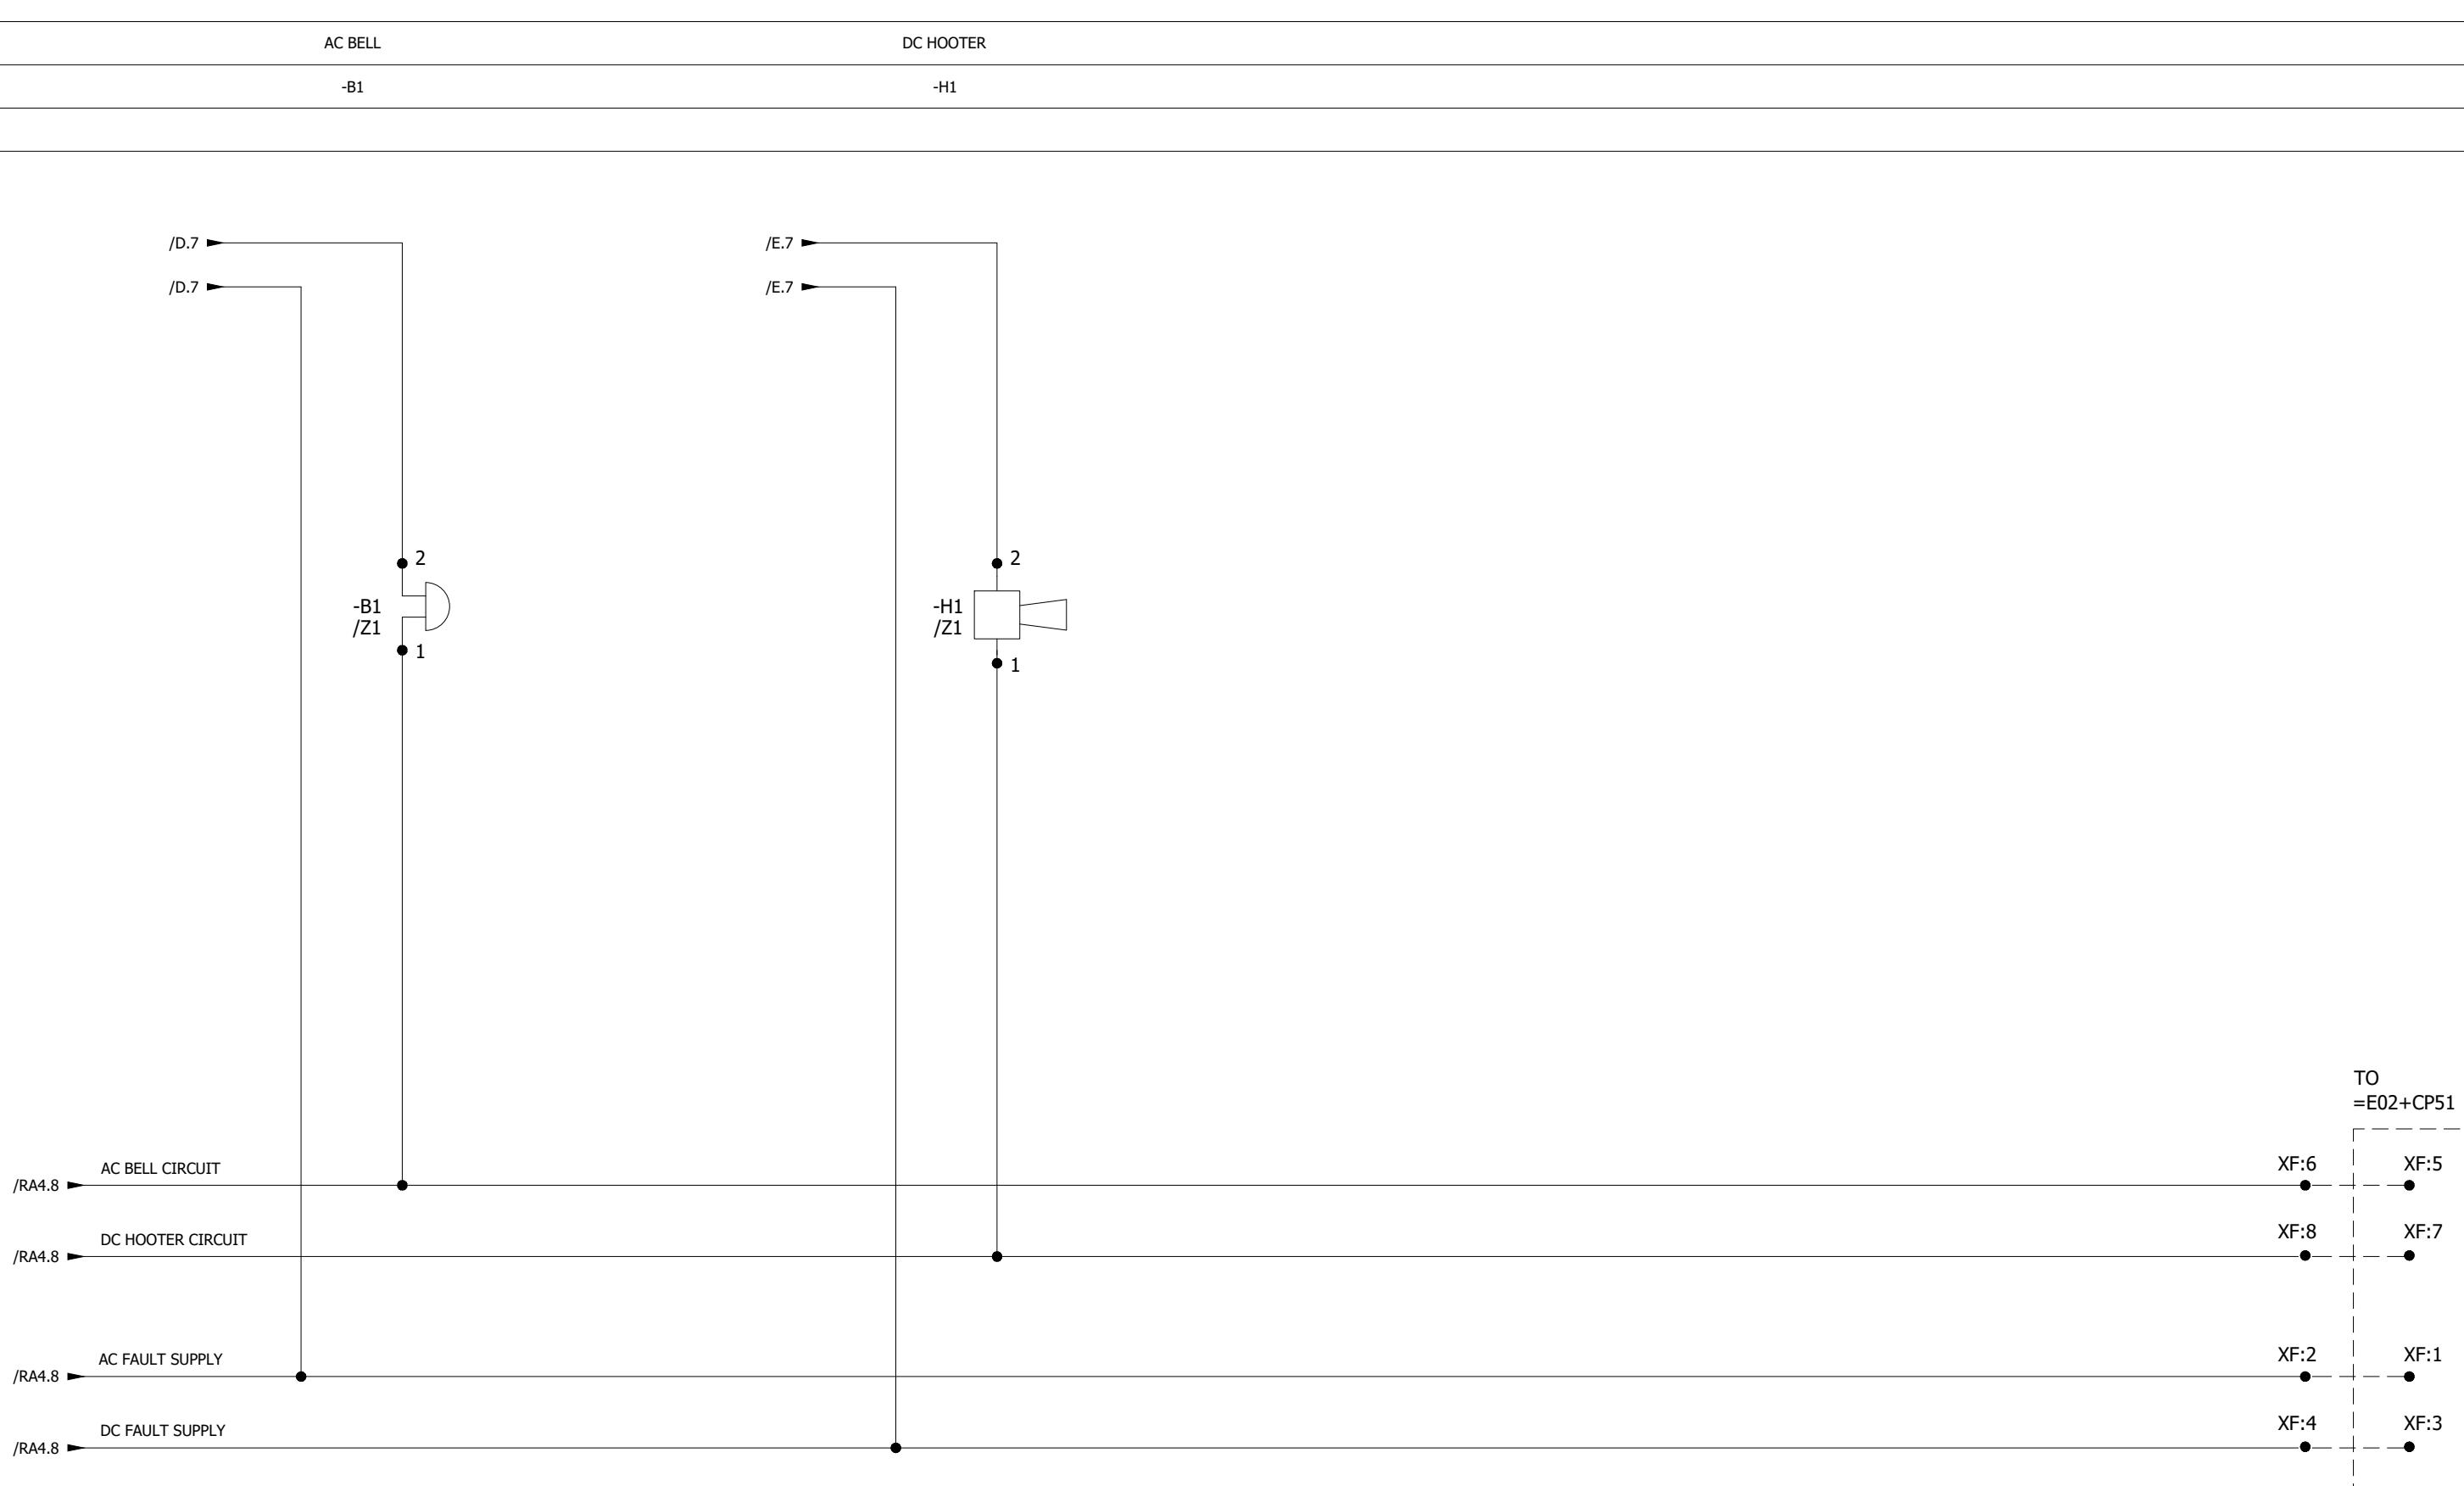


0	AS BUILT	19.10.2018	ASJ	Manufacturer  EPESOL 71-B Garden Block, New Garden Town, Lahore, Pakistan	Contractor  Grid Solutions A GE and Alstom joint venture	Client  NATIONAL TRANSMISSION & DISPATCH COMPANY LIMITED (NTDC-WAPDA)	Project 220kV/132kV GIS SUBSTATION GHAZI ROAD, LAHORE	Title 132kV LINE CONTROL PANEL (=E01+CP31) AC BELL & DC Hooter CIRCUIT	Drawing no.		
								P60194-E-ELC-SC-001			
								Project no. P-60194			
REV.	DESCRIPTION	DATE	DRAWER					Sheet type RA4-1			
								Sheet no. 26			

All information contained in this document is the exclusive property of GE GRID SOLUTIONS and shall not be used, copied or communicated to third parties without its prior authorization.

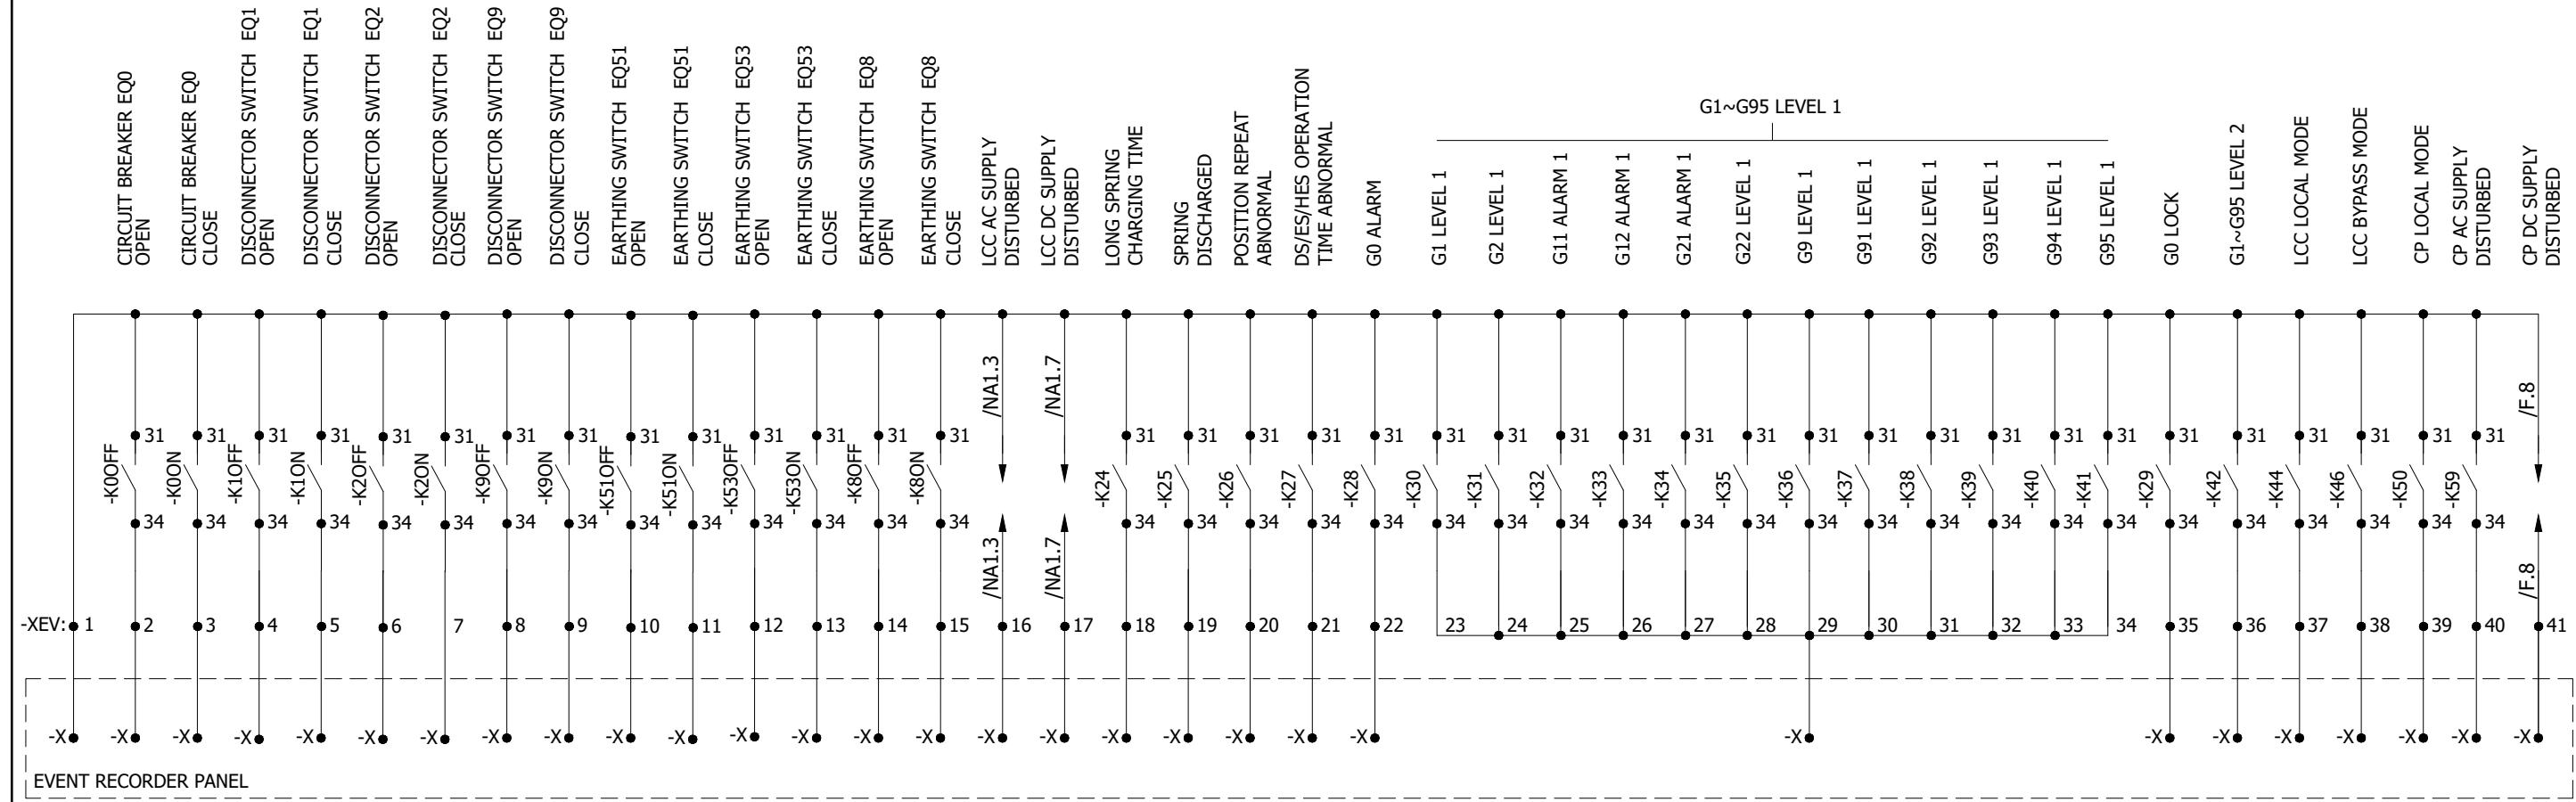

EVENT RECORDER PANEL

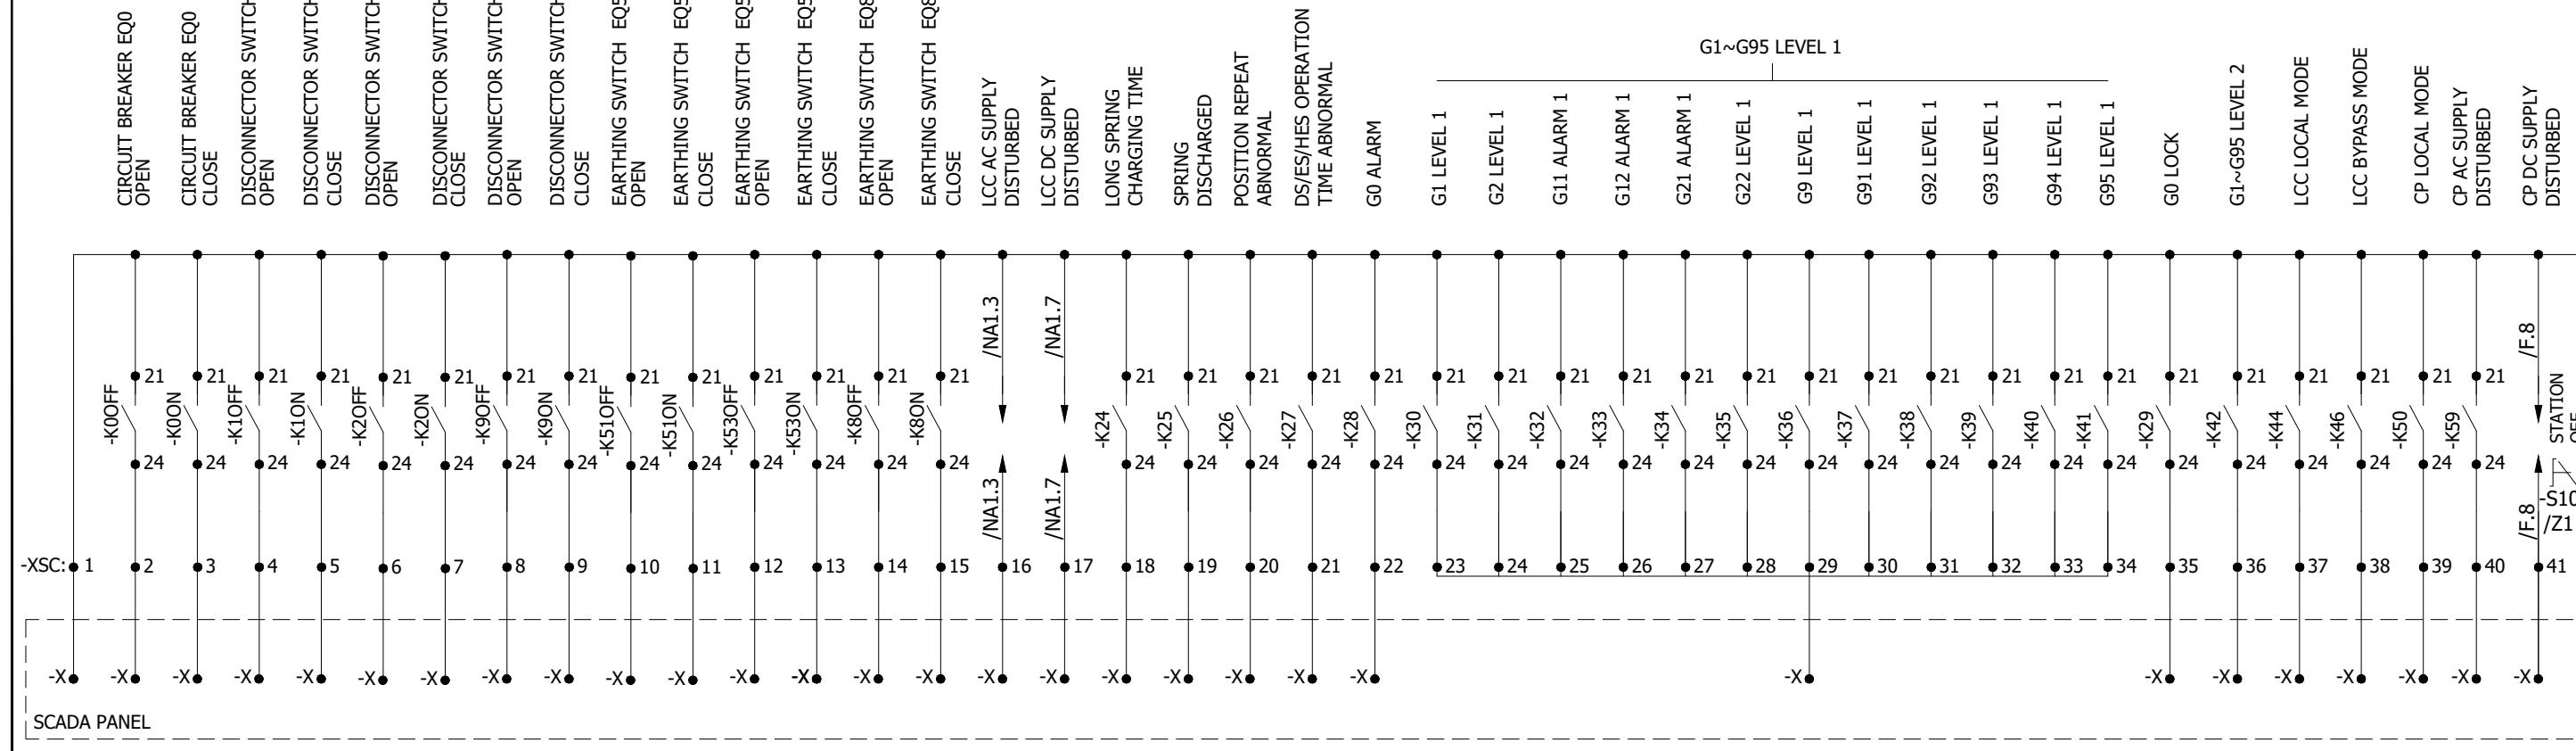

SCADA PANEL

0	AS BUILT		19.10.2018	ASJ	Manufacturer  EPESOL 71-B Garden Block, New Garden Town, Lahore, Pakistan	Contractor  Grid Solutions A GE and Alstom joint venture	Client  NATIONAL TRANSMISSION & DISPATCH COMPANY LIMITED (NTDC-WAPDA)	Project 220kV/132kV GIS SUBSTATION GHAZI ROAD, LAHORE	Title 132kV LINE CONTROL PANEL (=E01+CP31) SCADA & ER SIGNALS	Drawing no. P60194-E-ELC-SC-001		
REV.	DESCRIPTION		DATE	DRAWER						Project no. P-60194	Sheet type RA5	Sheet no. 27
1	CIRCUIT BREAKER EQ0 OPEN		CIRCUIT BREAKER EQ0 CLOSE		DISCONNECTOR SWITCH EQ1 OPEN		DISCONNECTOR SWITCH EQ1 CLOSE		DISCONNECTOR SWITCH EQ2 OPEN		DISCONNECTOR SWITCH EQ2 CLOSE	
2	DISCONNECTOR SWITCH EQ9 OPEN		DISCONNECTOR SWITCH EQ9 CLOSE		DISCONNECTOR SWITCH EQ9 OPEN		DISCONNECTOR SWITCH EQ9 CLOSE		EARTHING SWITCH EQ51 OPEN		EARTHING SWITCH EQ51 CLOSE	
3	EARTHING SWITCH EQ53 OPEN		EARTHING SWITCH EQ53 CLOSE		EARTHING SWITCH EQ8 OPEN		EARTHING SWITCH EQ8 CLOSE		LCC AC SUPPLY DISTURBED		LCC DC SUPPLY DISTURBED	
4	LONG SPRING CHARGING TIME		SPRING DISCHARGED		POSITION REPEAT ABNORMAL		DS/ES/HES OPERATION TIME ABNORMAL		GO ALARM		G1 LEVEL 1	
5	G1~G95 LEVEL 1		G2 LEVEL 1		G11 ALARM 1		G12 ALARM 1		G21 LEVEL 1		G91 LEVEL 1	
6	G92 LEVEL 1		G93 LEVEL 1		G94 LEVEL 1		G95 LEVEL 1		G91 LEVEL 1		G92 LEVEL 1	
7	G93 LEVEL 1		G94 LEVEL 1		G95 LEVEL 1		G91 LEVEL 1		G92 LEVEL 1		G93 LEVEL 1	
8	G94 LEVEL 1		G95 LEVEL 1		GO LOCK		G1~G95 LEVEL 2		LCC LOCAL MODE		LCC BYPASS MODE	
	LCC LOCAL MODE		CP AC SUPPLY DISTURBED		CP DC SUPPLY DISTURBED		CP LOCAL MODE		CP AC SUPPLY DISTURBED		CP DC SUPPLY DISTURBED	

1

2

3

4

5

6

7

8

All information contained in this document is the exclusive property of GE GRID SOLUTIONS and shall not be used, copied or communicated to third parties without its prior authorization.

	A1	12	14	22	24	32	34	42	44
-K11	NA1.5	NA1.3	NA1.5	NA1.6					
-K12	NA1.5	NA1.3	NA1.5	NA1.6					
-K13	NA1.5	NA1.3	NA1.5	NA1.7					
-K14	NA1.5	NA1.4	NA1.5	NA1.7					
-K15	NA1.6	NA1.4	NA1.5	NA1.7					
-K16	NA1.6	NA1.4	NA1.5	NA1.7					
-K17	NA1.6	NA1.4	NA1.5	NA1.7					
-K18	NA1.6	NA1.4	NA1.6	NA1.7					
-K19	NA1.7	NA1.1	NA1.2	NA1.3					
-K20	NA1.7	NA1.1	NA1.2	NA1.3					
-K21	NA1.7	NA1.1	NA1.2	NA1.3					
-K24	NA1.4	RA1.4	RA5.4	RA5.4					
-K25	NA1.4	RA1.3	RA5.4	RA5.4	NA1.7				
-K26	NA1.4		RA5.4	RA5.4					
-K27	NA1.3	RA1.4	RA5.5	RA5.5					
-K28	NA1.3	NA1.5	RA5.5	RA5.5					
-K29	NA1.3	RA1.7	RA5.7	RA5.7	NA1.7				
-K30	NA1.2	NA1.5	RA5.5	RA5.5					
-K31	NA1.2	NA1.5	RA5.5	RA5.5					
-K32	NA1.2	NA1.5	RA5.5	RA5.5					
-K33	NA1.1	NA1.5	RA5.6	RA5.5					
-K35	NA1.1	NA1.6	RA5.6	RA5.6					
-K36	NA1.4	NA1.6	RA5.6	RA5.6					
-K37	NA1.4	NA1.6	RA5.6	RA5.6					
-K42	NA1.3	RA1.5	RA5.7	RA5.7					
-K43	NA1.3	RA5.8							
-K44	NA1.2	RA1.6	RA5.7	RA5.7					
-K45	NA1.2								
-K46	NA1.2	RA1.5	RA5.8	RA5.7					
-K50	H1.2		RA5.8	RA5.8					
-K0OFF	NA2.2		RA5.1	RA5.1					
-K0ON	NA2.3	NA4.6	RA5.1	RA5.1					
-K1OFF	NA2.3		RA5.2	RA5.2					
-K1ON	NA2.4		RA5.2	RA5.2					
-K2OFF	NA2.5		RA5.2	RA5.2					
-K2ON	NA2.6		RA5.2	RA5.2					
-K9OFF	NA2.6		RA5.3	RA5.2					
-K9ON	NA2.7		RA5.3	RA5.3					
-K51OFF	NA2.7		RA5.3	RA5.3					
-K51ON	NA2.8		RA5.3	RA5.3					
-K53OFF	NA3.3		RA5.3	RA5.3					
-K53ON	NA3.4		RA5.4	RA5.3					
-K8OFF	NA3.4		RA5.4	RA5.3					
-K8ON	NA3.5		RA5.4	RA5.4					
-K38	NA3.4	NA1.6	RA5.7	RA5.6					
-K39	NA3.4	NA1.6	RA5.7	RA5.7					
-K40	NA3.4	NA1.6	RA5.7	RA5.7					
-K41	NA3.5	NA1.6	RA5.7	RA5.7					

3



4

5


6

7


8

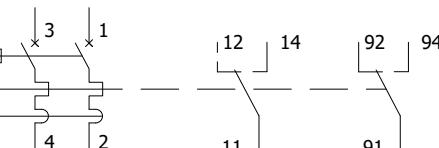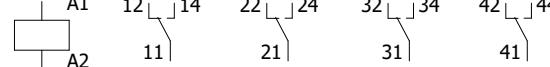

-F101	D.2	NA1.8	
-F102	D.4	NA1.8	
-F103	D.6	NA1.8	

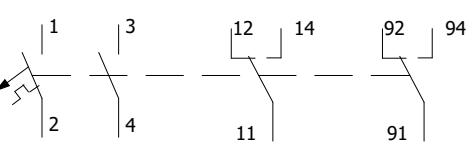

-F201	E.5	F.3	
-F202	E.6	F.5	

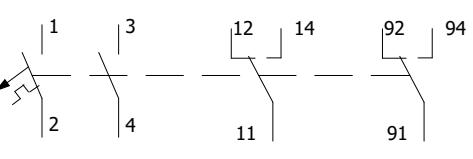

-B100	D.4	
-------	-----	--

COM
NC

-S100	D.3	
-------	-----	--

1
3
2
4


-X100	D.7	
-------	-----	--

L
N

-R100	D.5	
-------	-----	--


+ 1
3
- 2
4

-K51	NA4.2	
------	-------	--

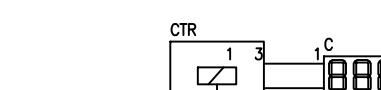

-Q10	NA4.6	
------	-------	--

(+)
(-)

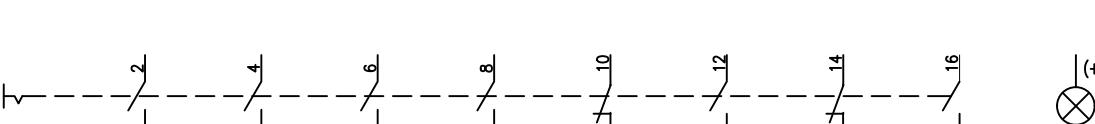

-S0	H1.7	H1.4		NA2.2	NA5.1			NA5.2
-S1	I1.2	I1.3		NA2.4	NA5.2			NA5.2
-S2	I1.4	I1.5		NA2.5	NA5.3			NA5.3
-S9	I1.7	I1.7		NA2.6	NA5.3			NA5.3
-S51	I2.2	I2.3		NA3.1	NA5.5			NA5.5
-S53	I2.4	I2.5		NA3.3	NA5.5			NA5.5
-S8	I2.6	I1.7		NA3.4	NA5.6			NA5.6

T

F

E

F

E

